



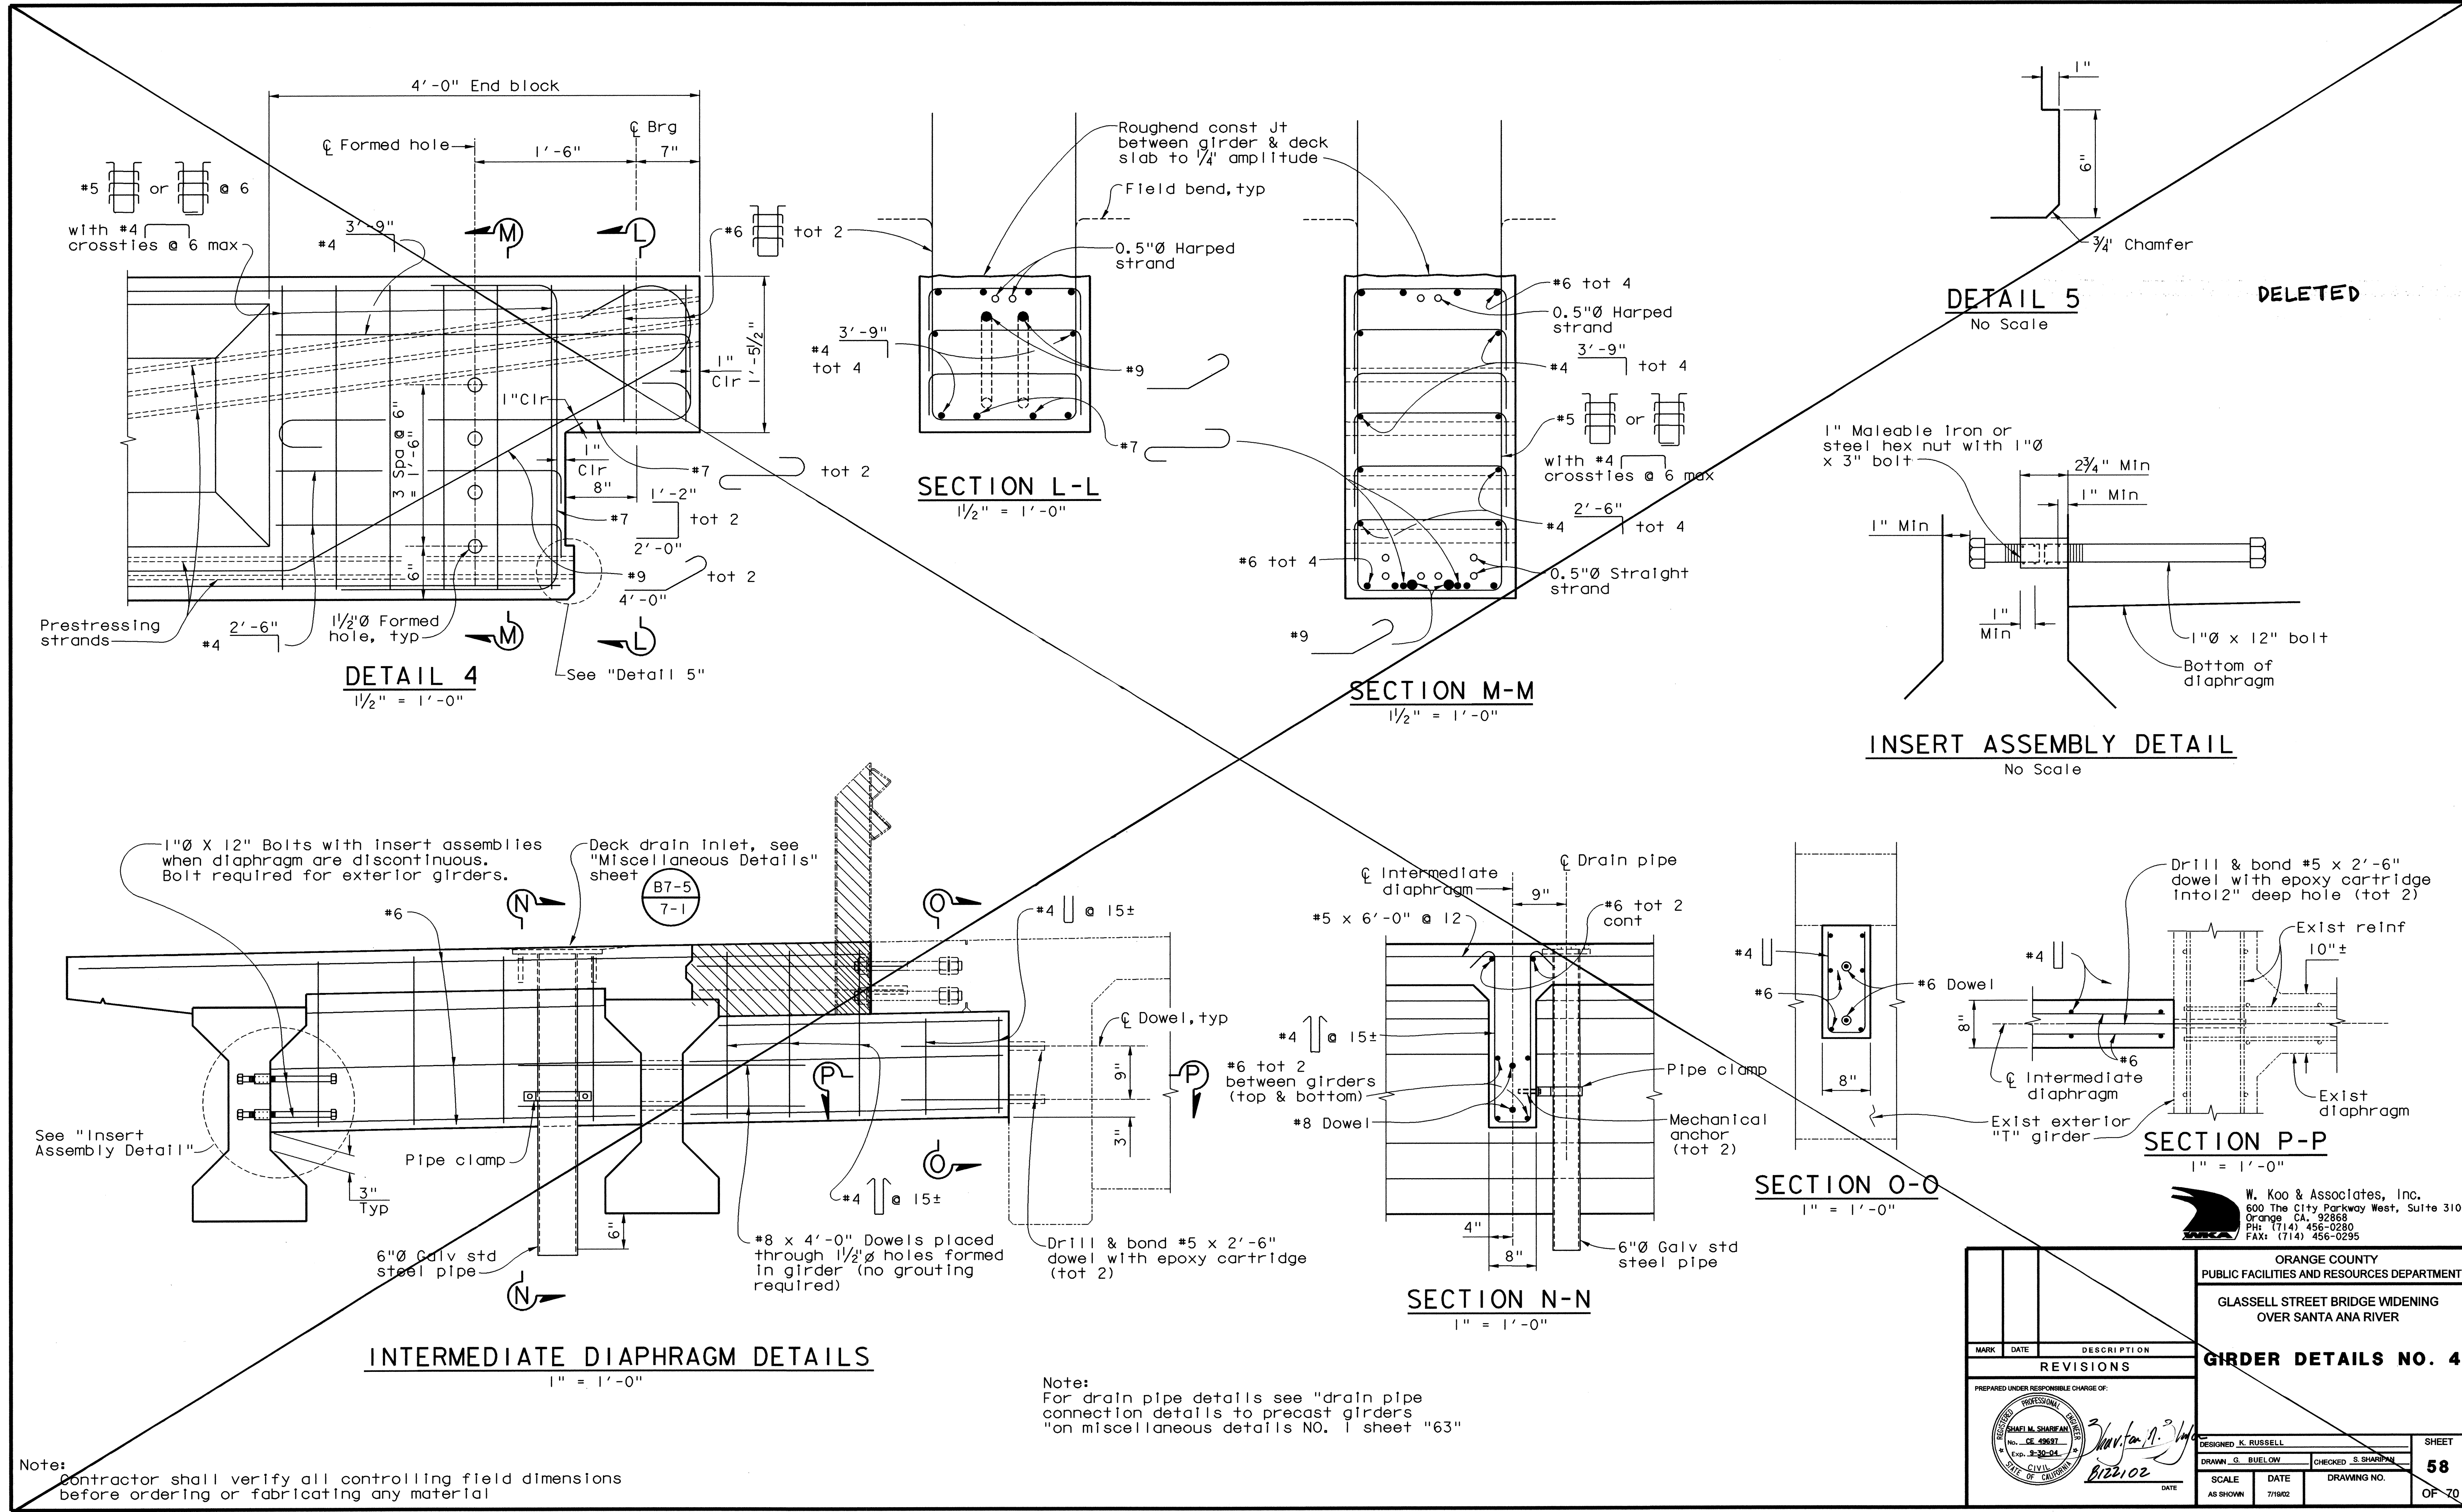

DETAIL 5
No Scale

DELETED

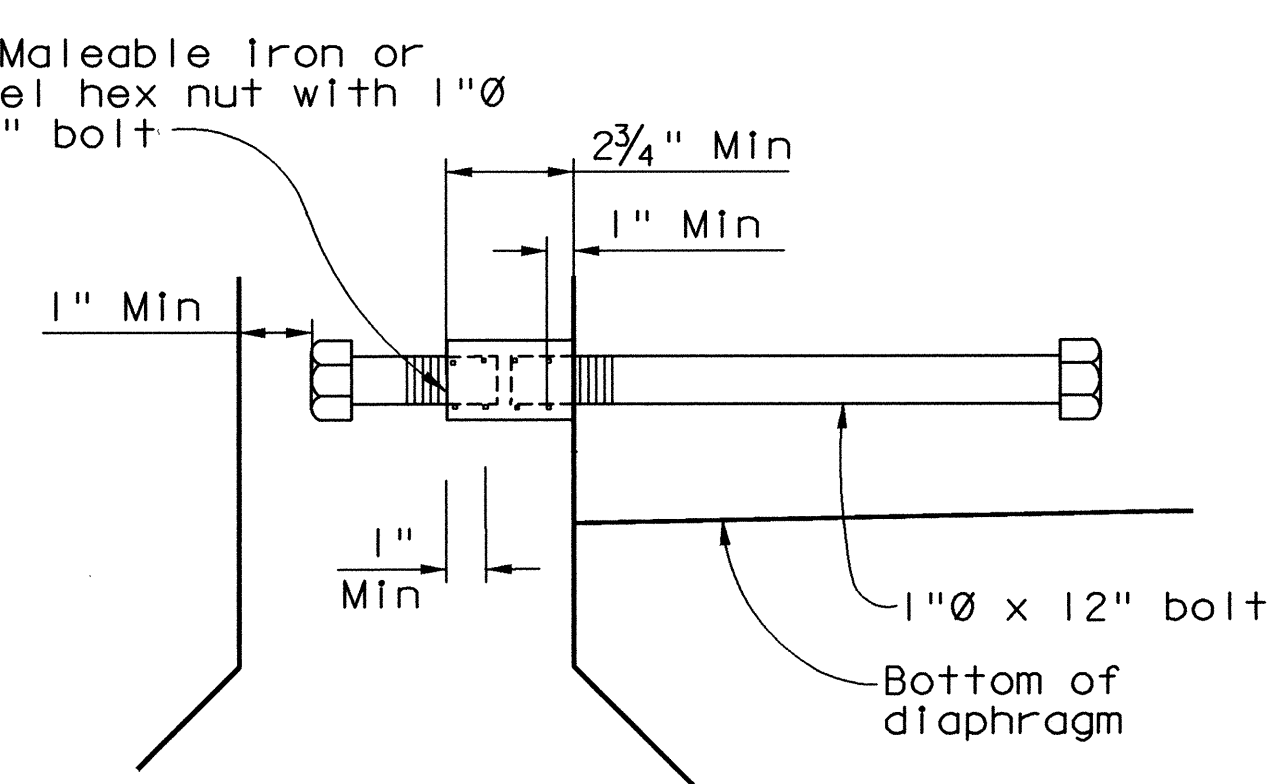

INSERT ASSEMBLY DETAIL
No Scale

SECTION O-O
1" = 1'-0"

SECTION P-P
1" = 1'-0"

SECTION N-N
1" = 1'-0"

INTERMEDIATE DIAPHRAGM DETAILS
1" = 1'-0"

Note: Contractor shall verify all controlling field dimensions before ordering or fabricating any material

Note: For drain pipe details see "drain pipe connection details to precast girders" on miscellaneous details NO. 1 sheet "63"

ORANGE COUNTY PUBLIC FACILITIES AND RESOURCES DEPARTMENT	
GLASSELL STREET BRIDGE WIDENING OVER SANTA ANA RIVER	
GIRDER DETAILS NO. 4	
MARK	DATE
REVISIONS	
PREPARED UNDER RESPONSIBLE CHARGE OF:	
DESIGNED: K. RUSSELL	
DRAWN: G. BUELOW	
CHECKED: S. SHARIFAN	
SCALE: AS SHOWN	
DATE: 7/19/02	
DRAWING NO. 58	
SHEET OF 70	