




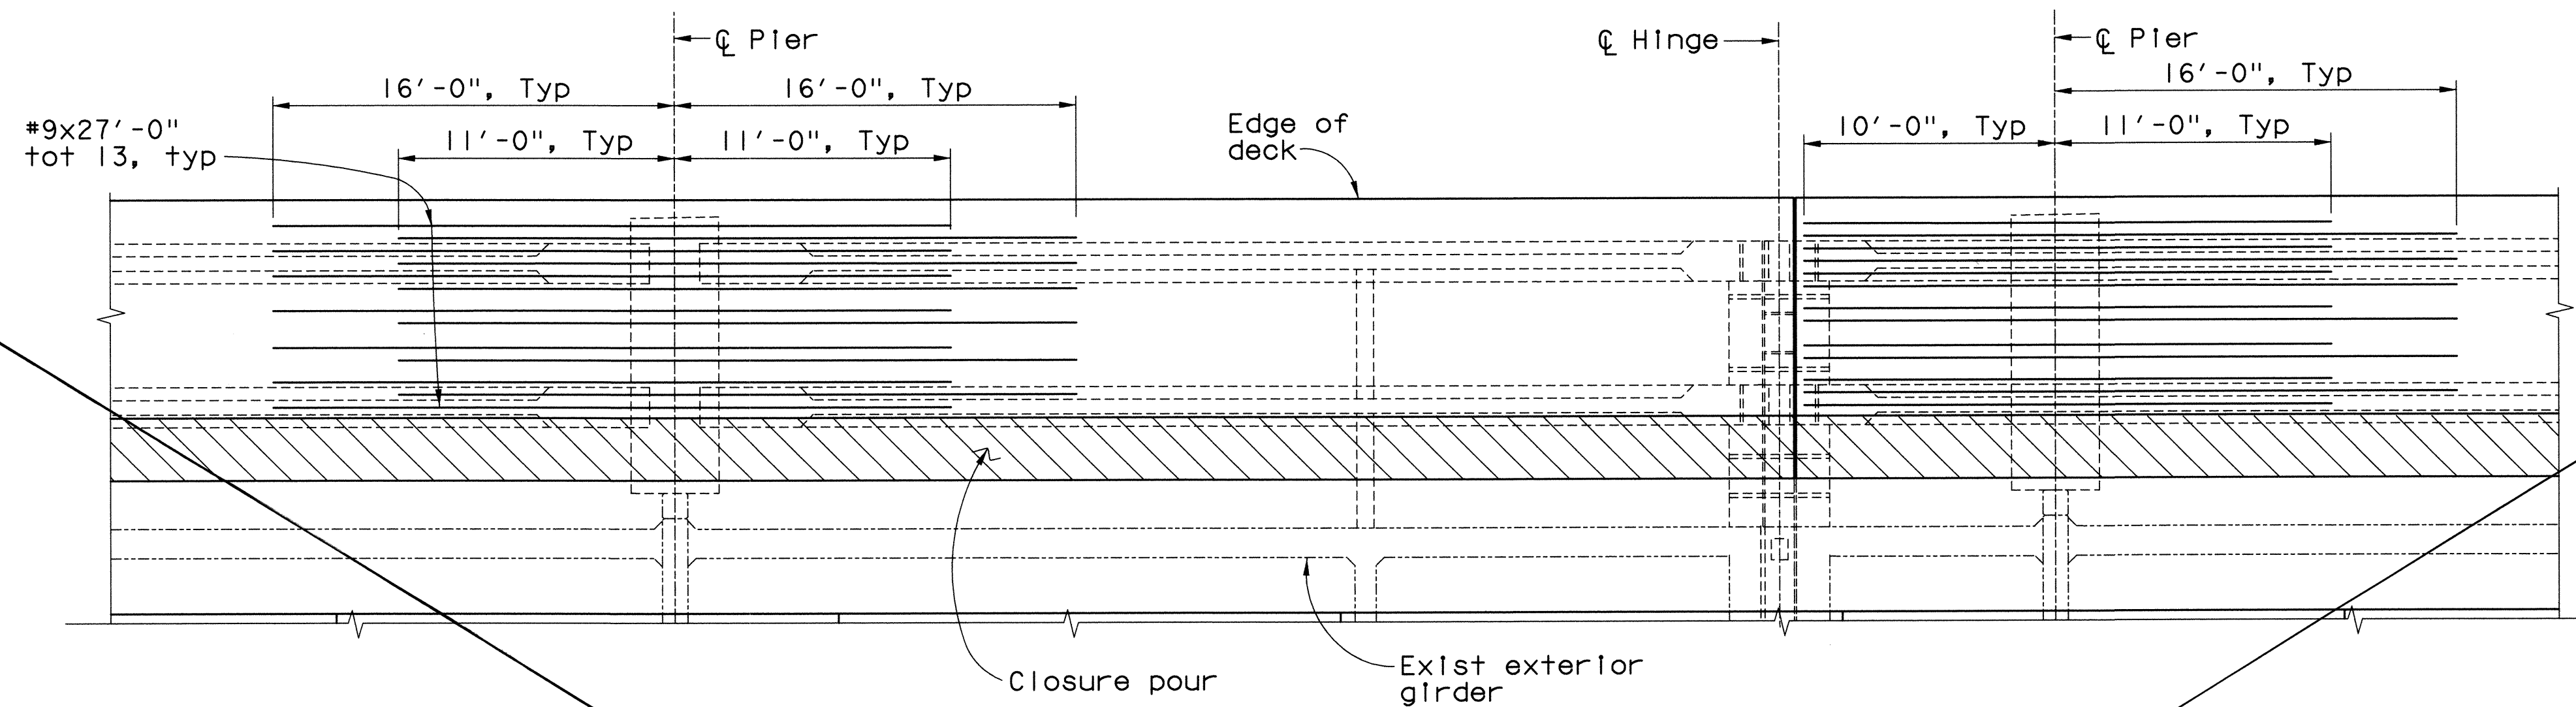

SUPERSEDED AND REPLACED BY SHEET 59R.

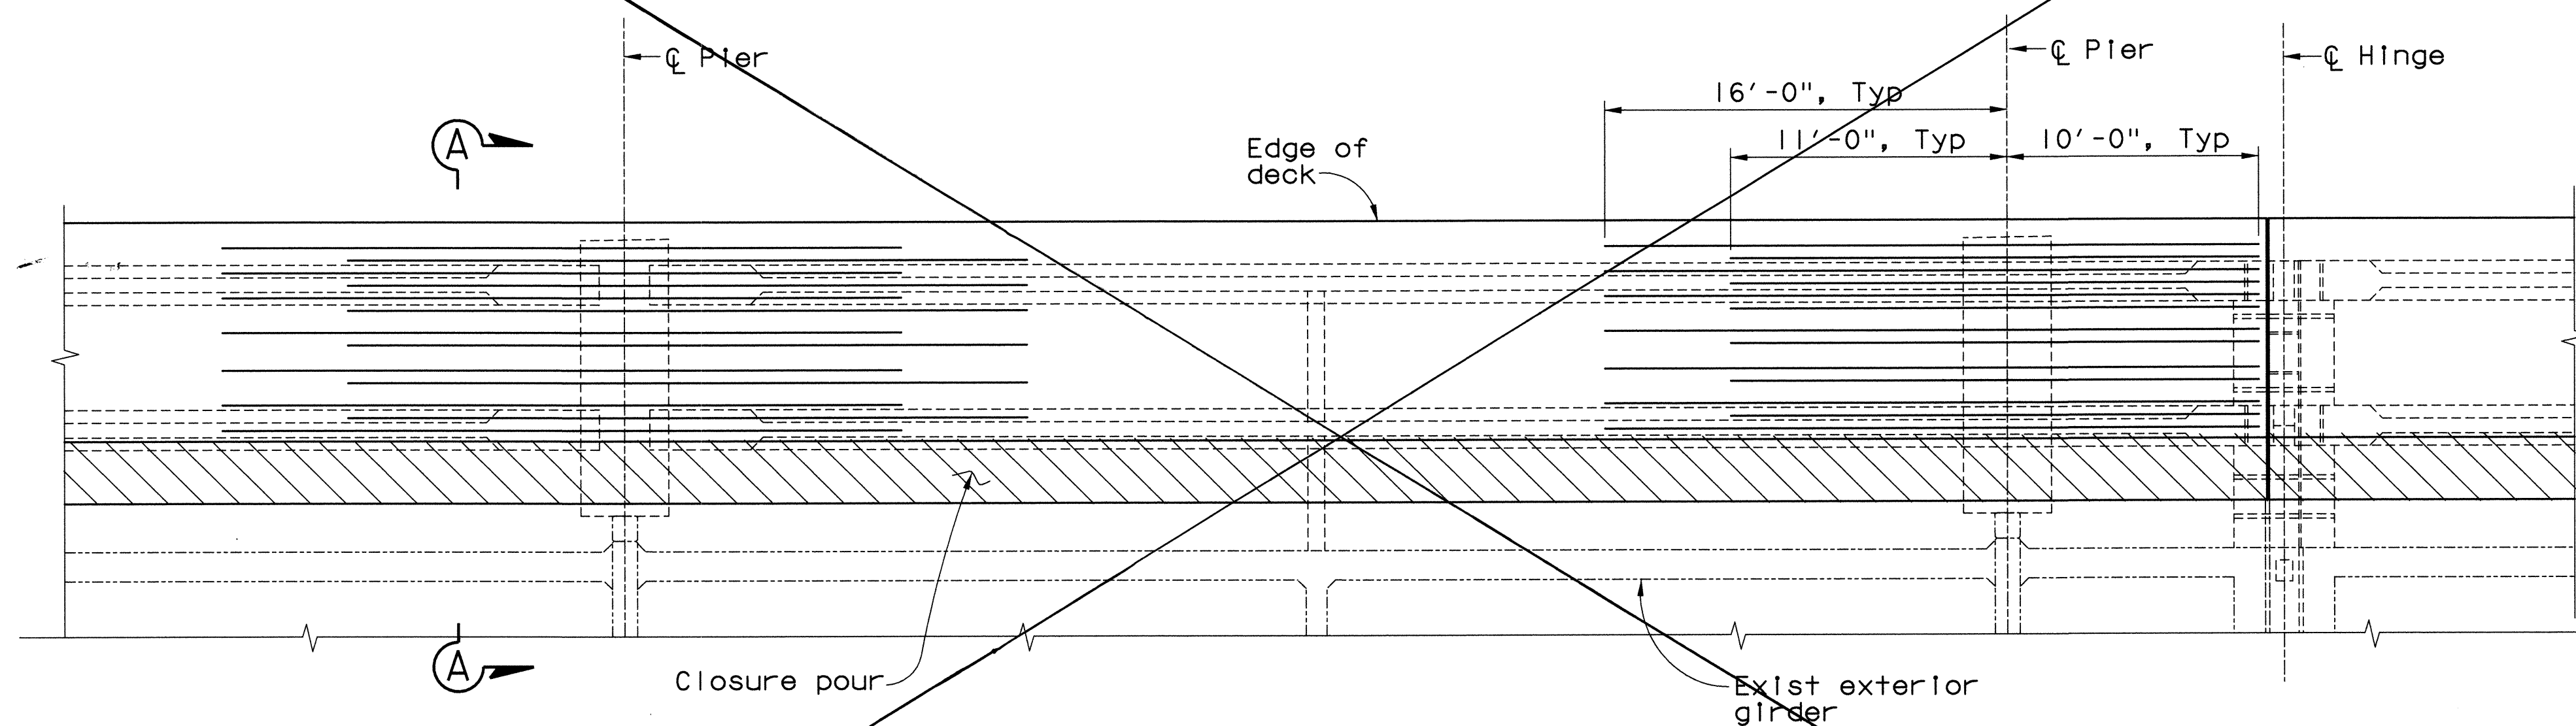

PART PLAN
No Scale

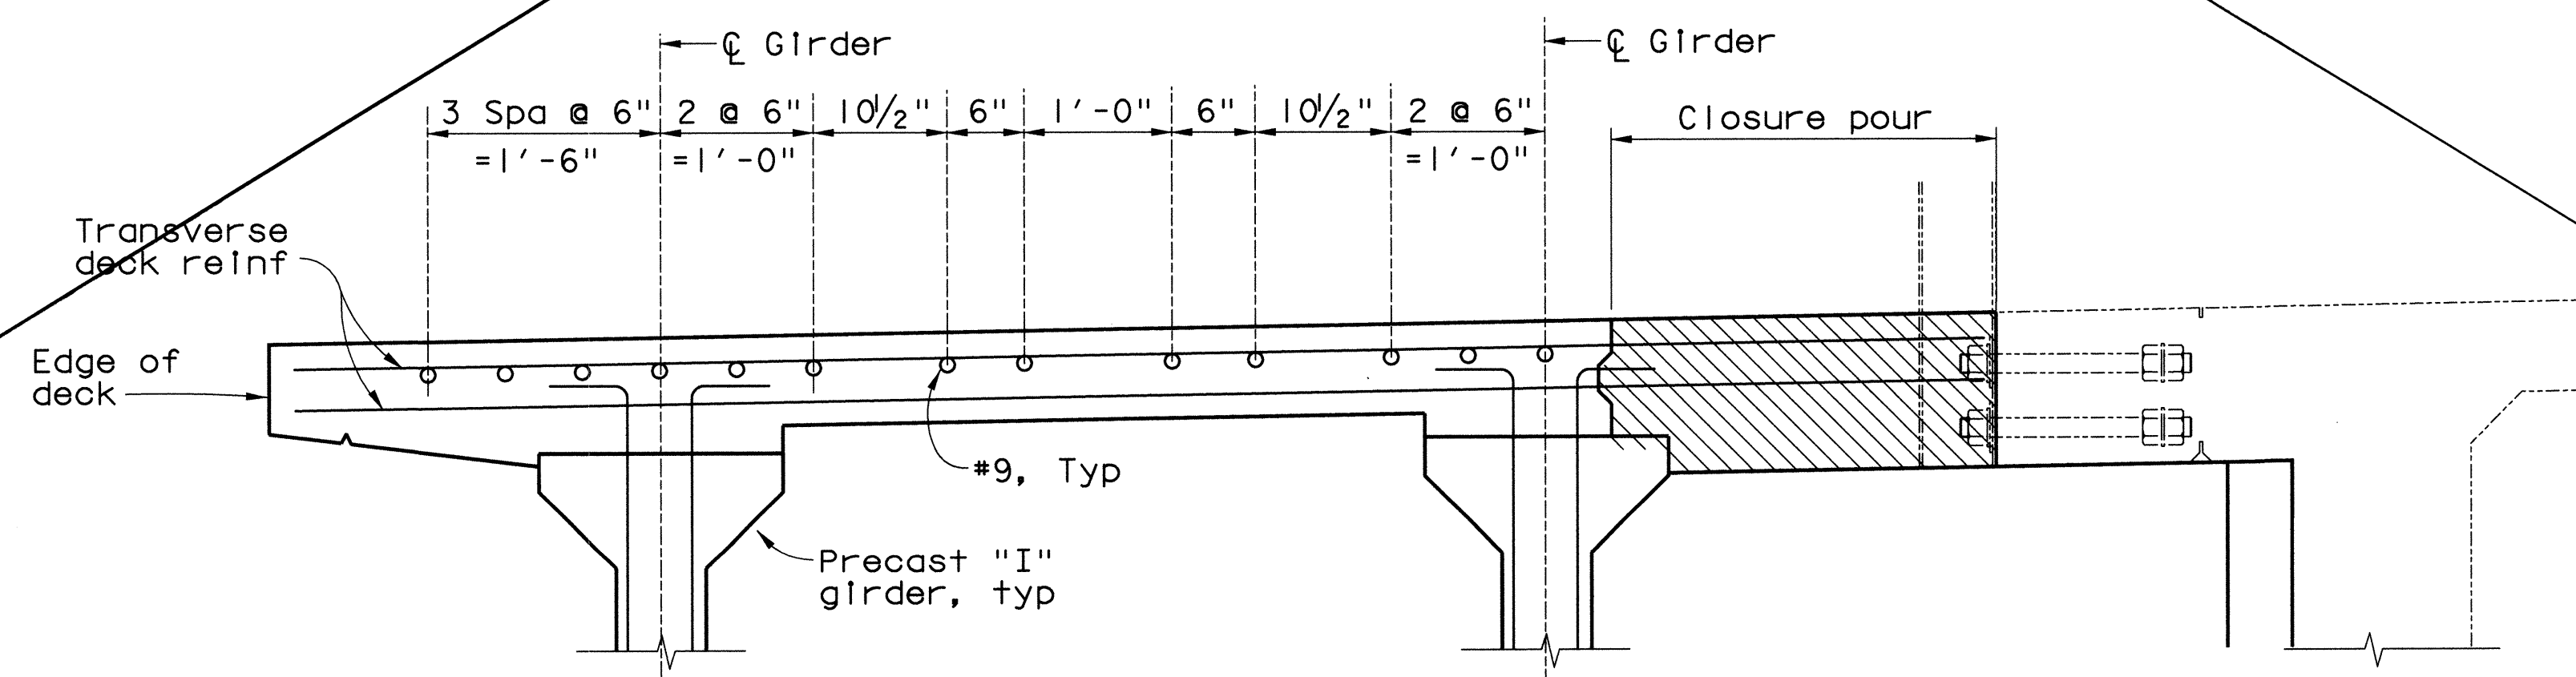

SECTION A-A
3/4" = 1'-0"

Note:
Not all reinf shown for clarity, see "Typical Section" sheet for details not shown

Note:
Contractor shall verify all controlling field dimensions before ordering or fabricating any material

W. Koo & Associates, Inc.
600 The City Parkway West, Suite 310
Orange, CA, 92668
PH: (714) 456-0280
FAX: (714) 456-0295

ORANGE COUNTY
PUBLIC FACILITIES AND RESOURCES DEPARTMENT

GLASSSELL STREET BRIDGE WIDENING
OVER SANTA ANA RIVER

**LONGITUDINAL DECK
REINFORCEMENT**

MARK	DATE	DESCRIPTION
REVISIONS		
PREPARED UNDER RESPONSIBLE CHARGE OF:		

DESIGNED: K. RUSSELL	SHEET
DRAWN: G. BUELOW	59
CHECKED: S. SHARFMAN	OF 70
SCALE: AS SHOWN	DATE: 7/19/02
DRAWING NO.	

Date Plotted: \$DATE\$

File Name: \$FILES\$

Border sheet last modified 08-Nov-1999