
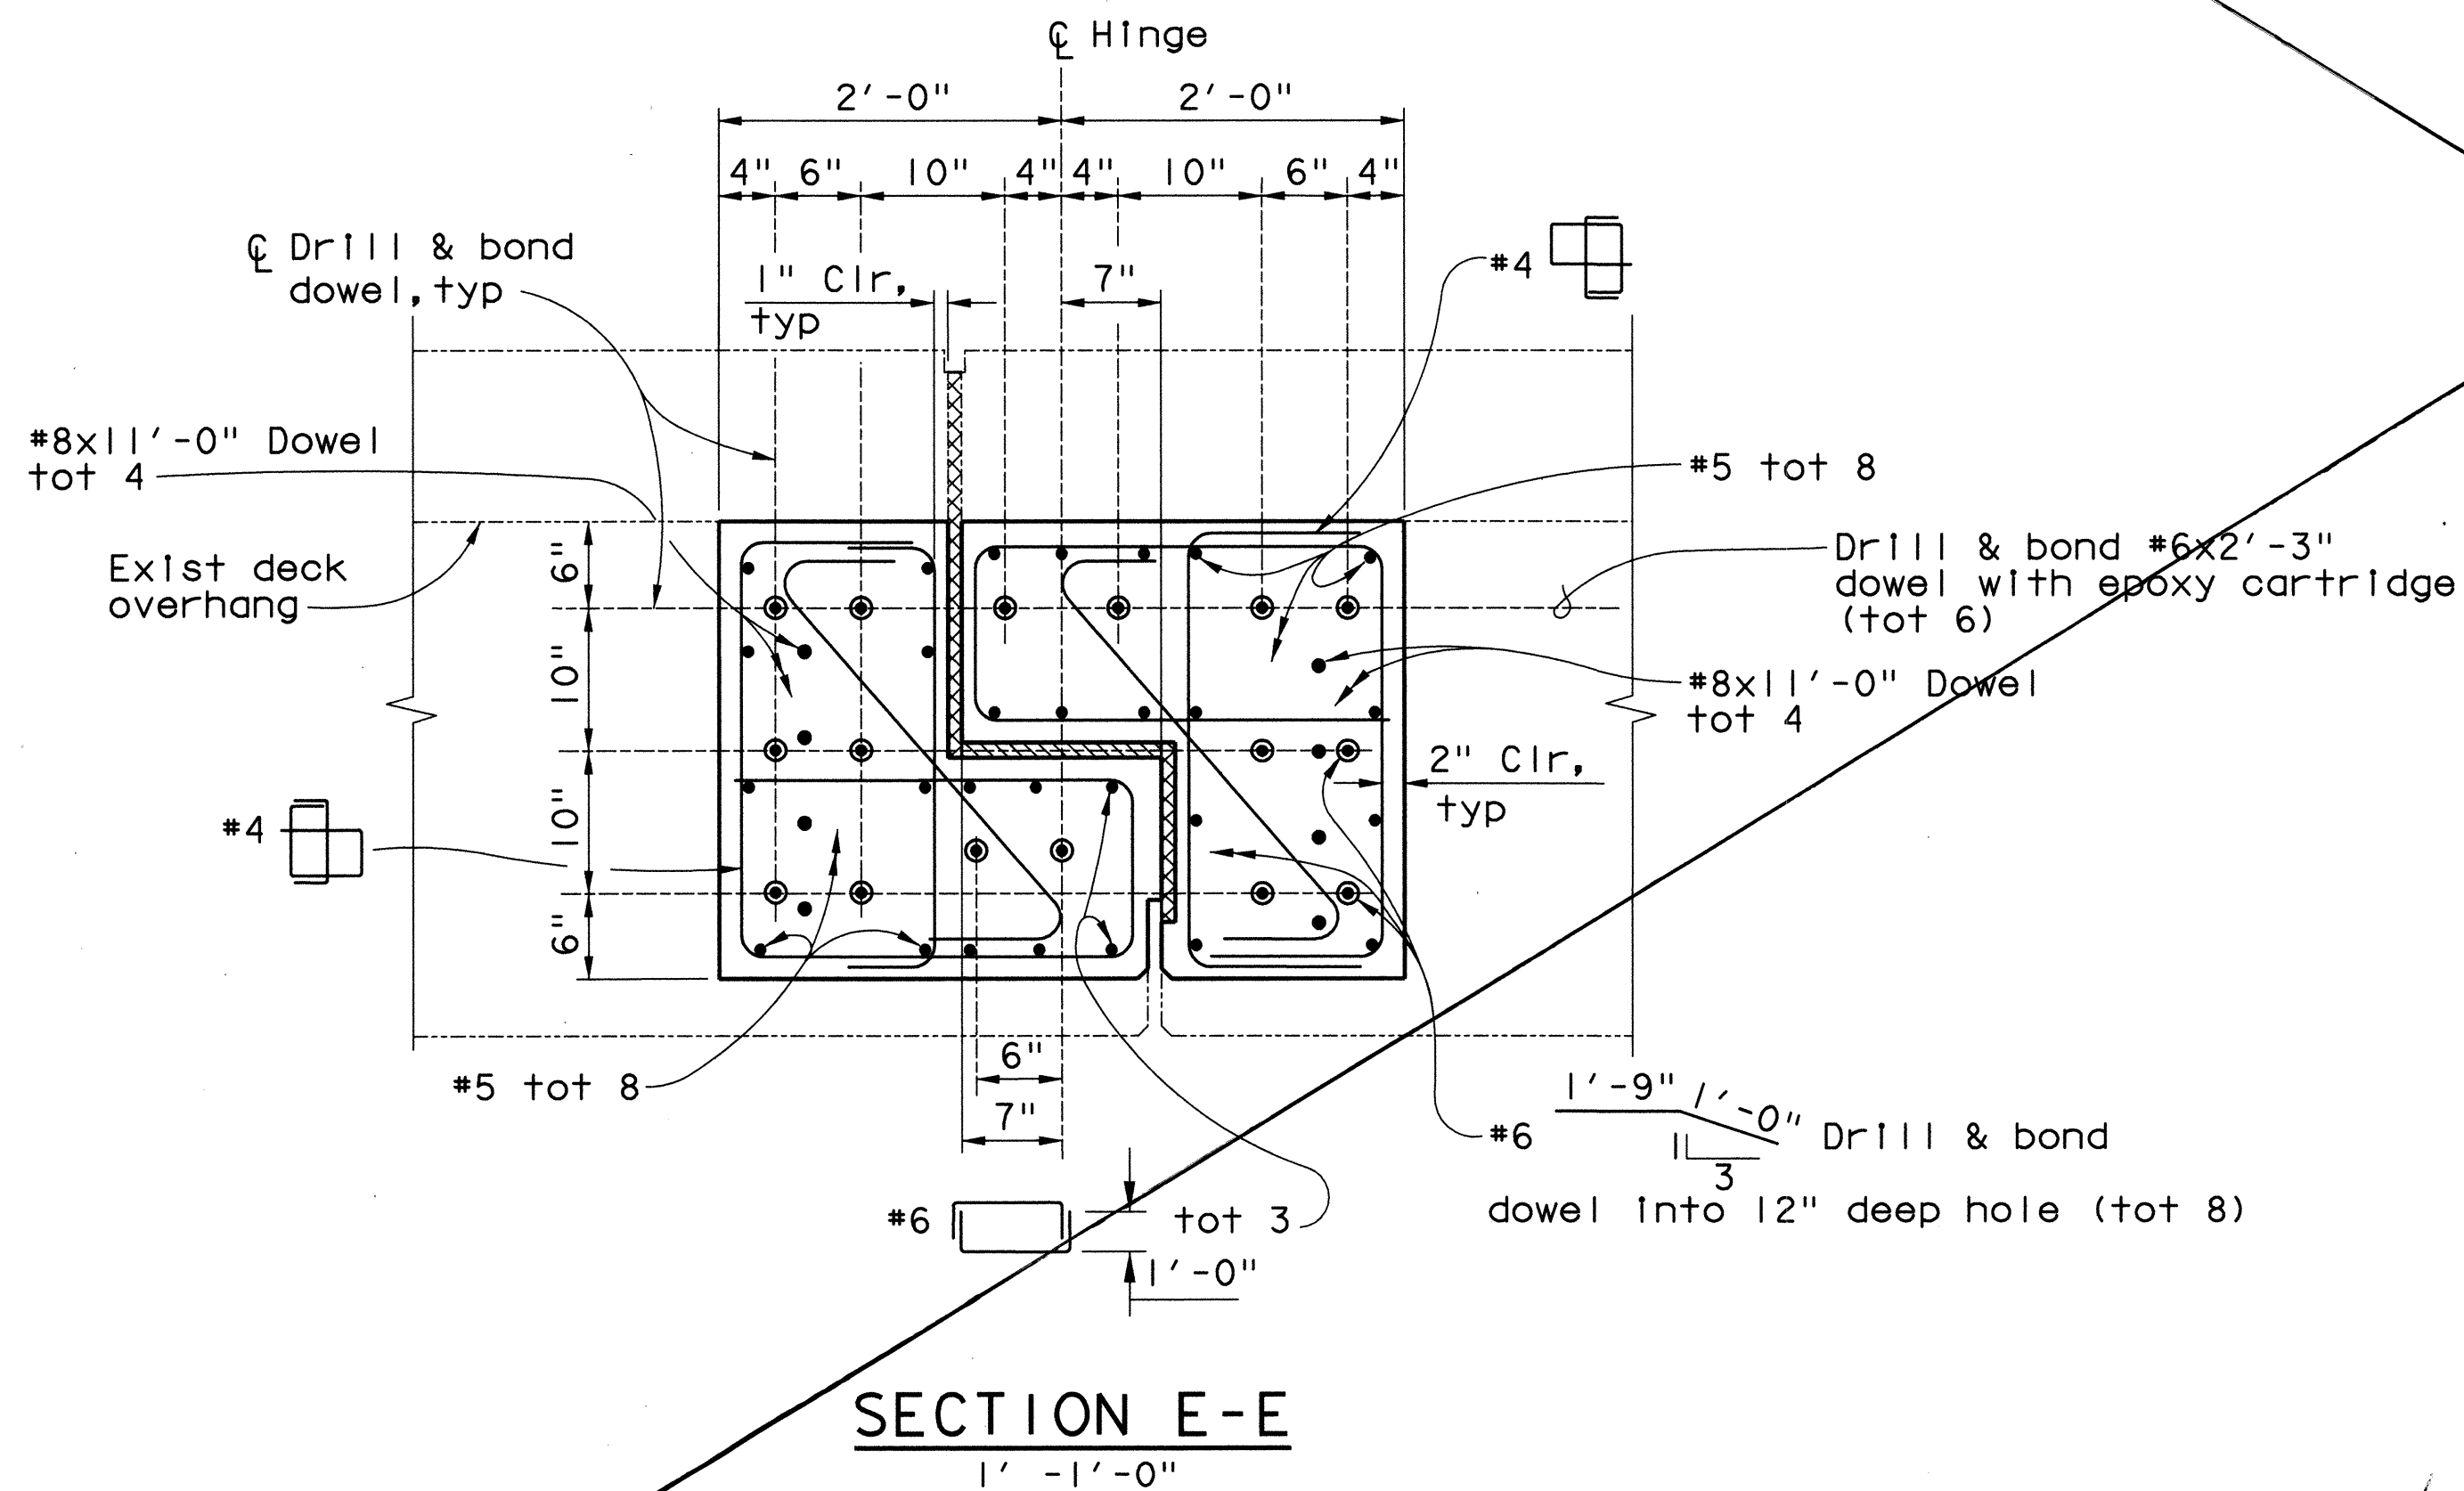
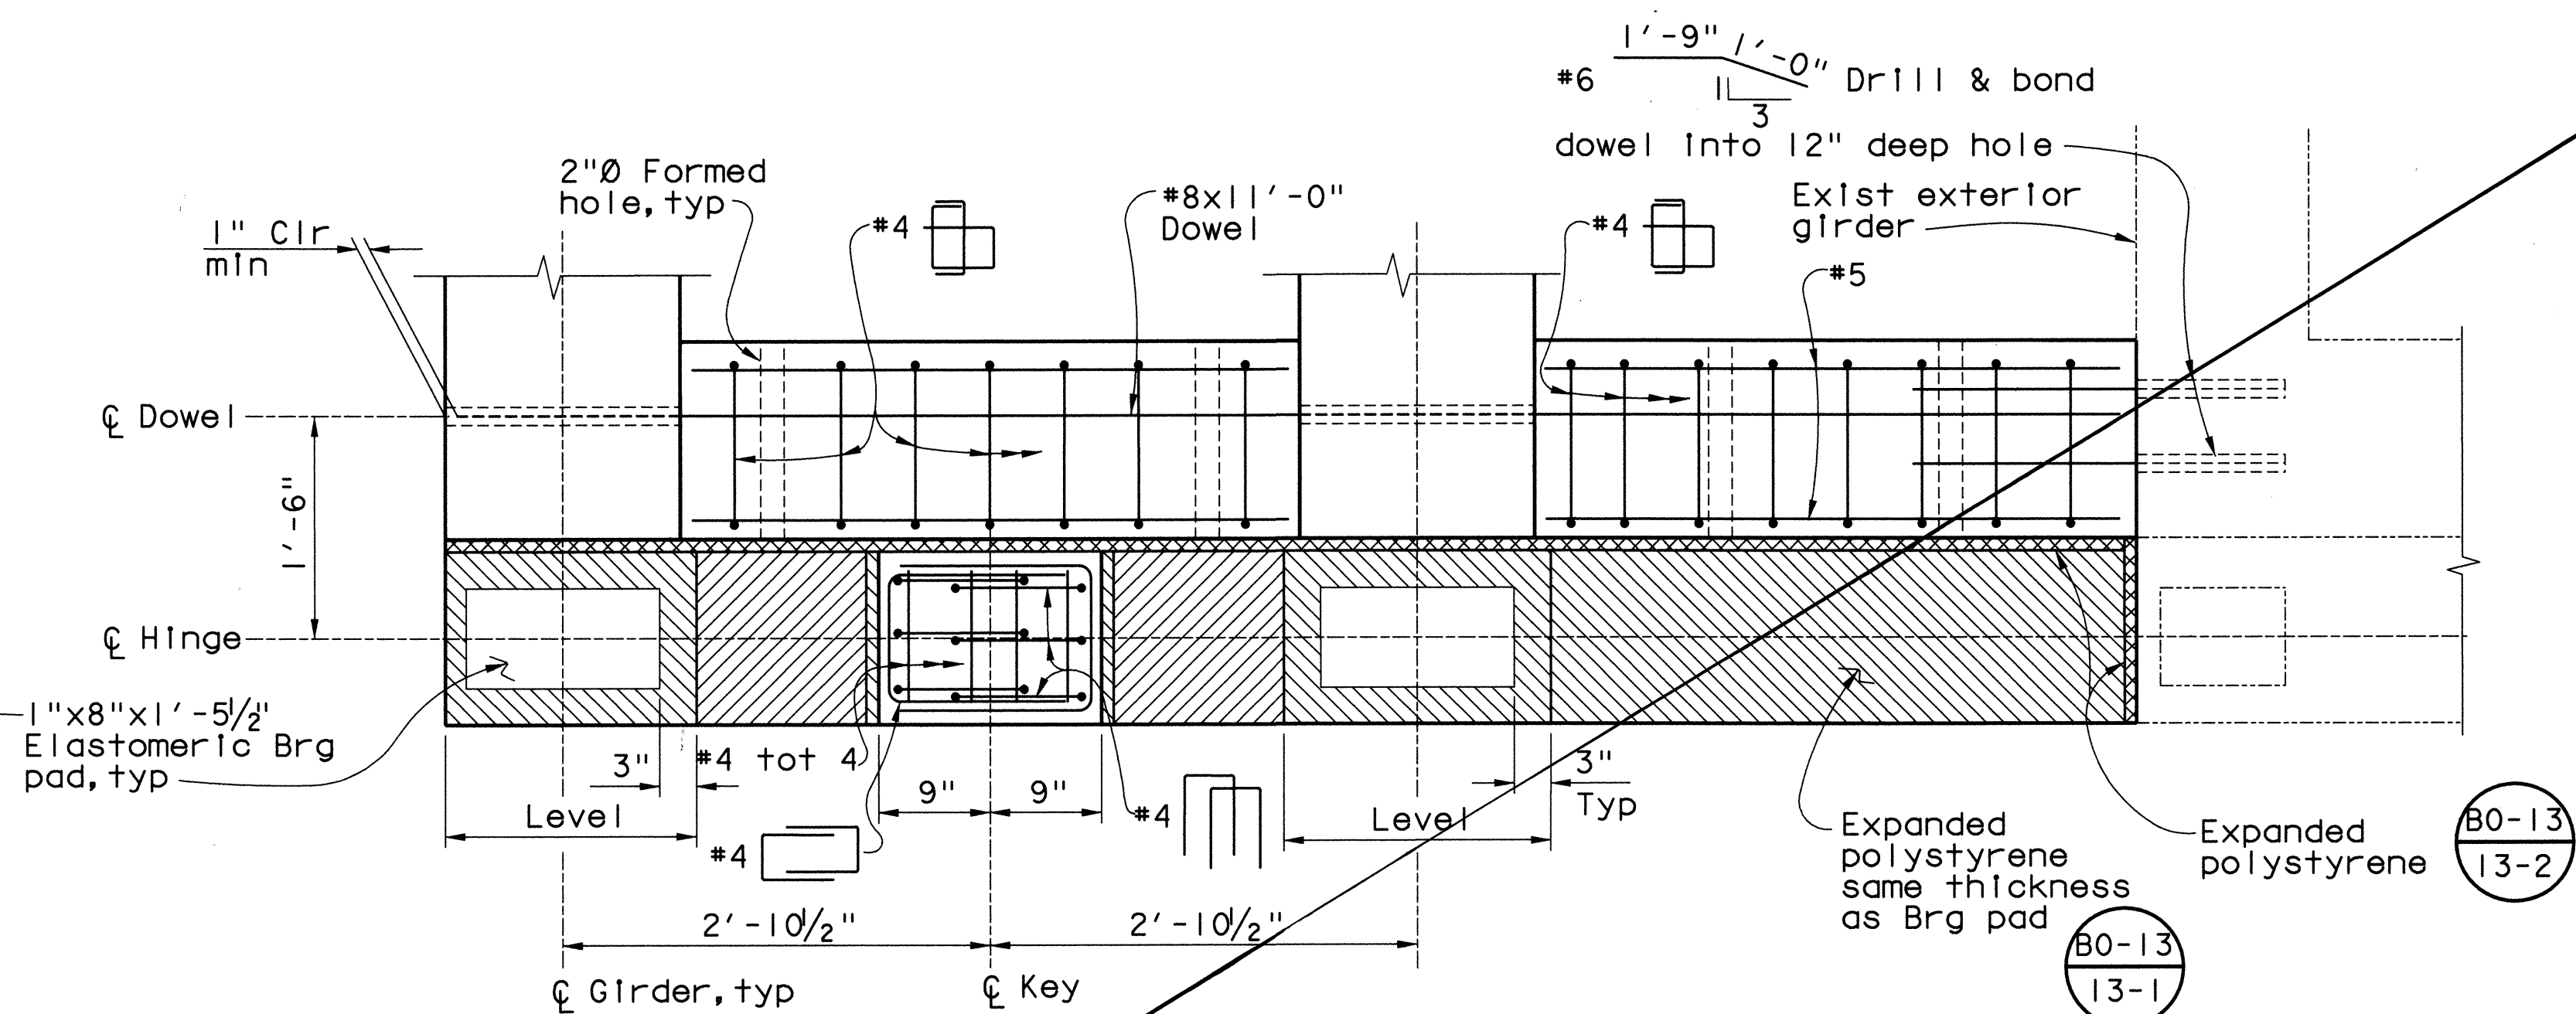


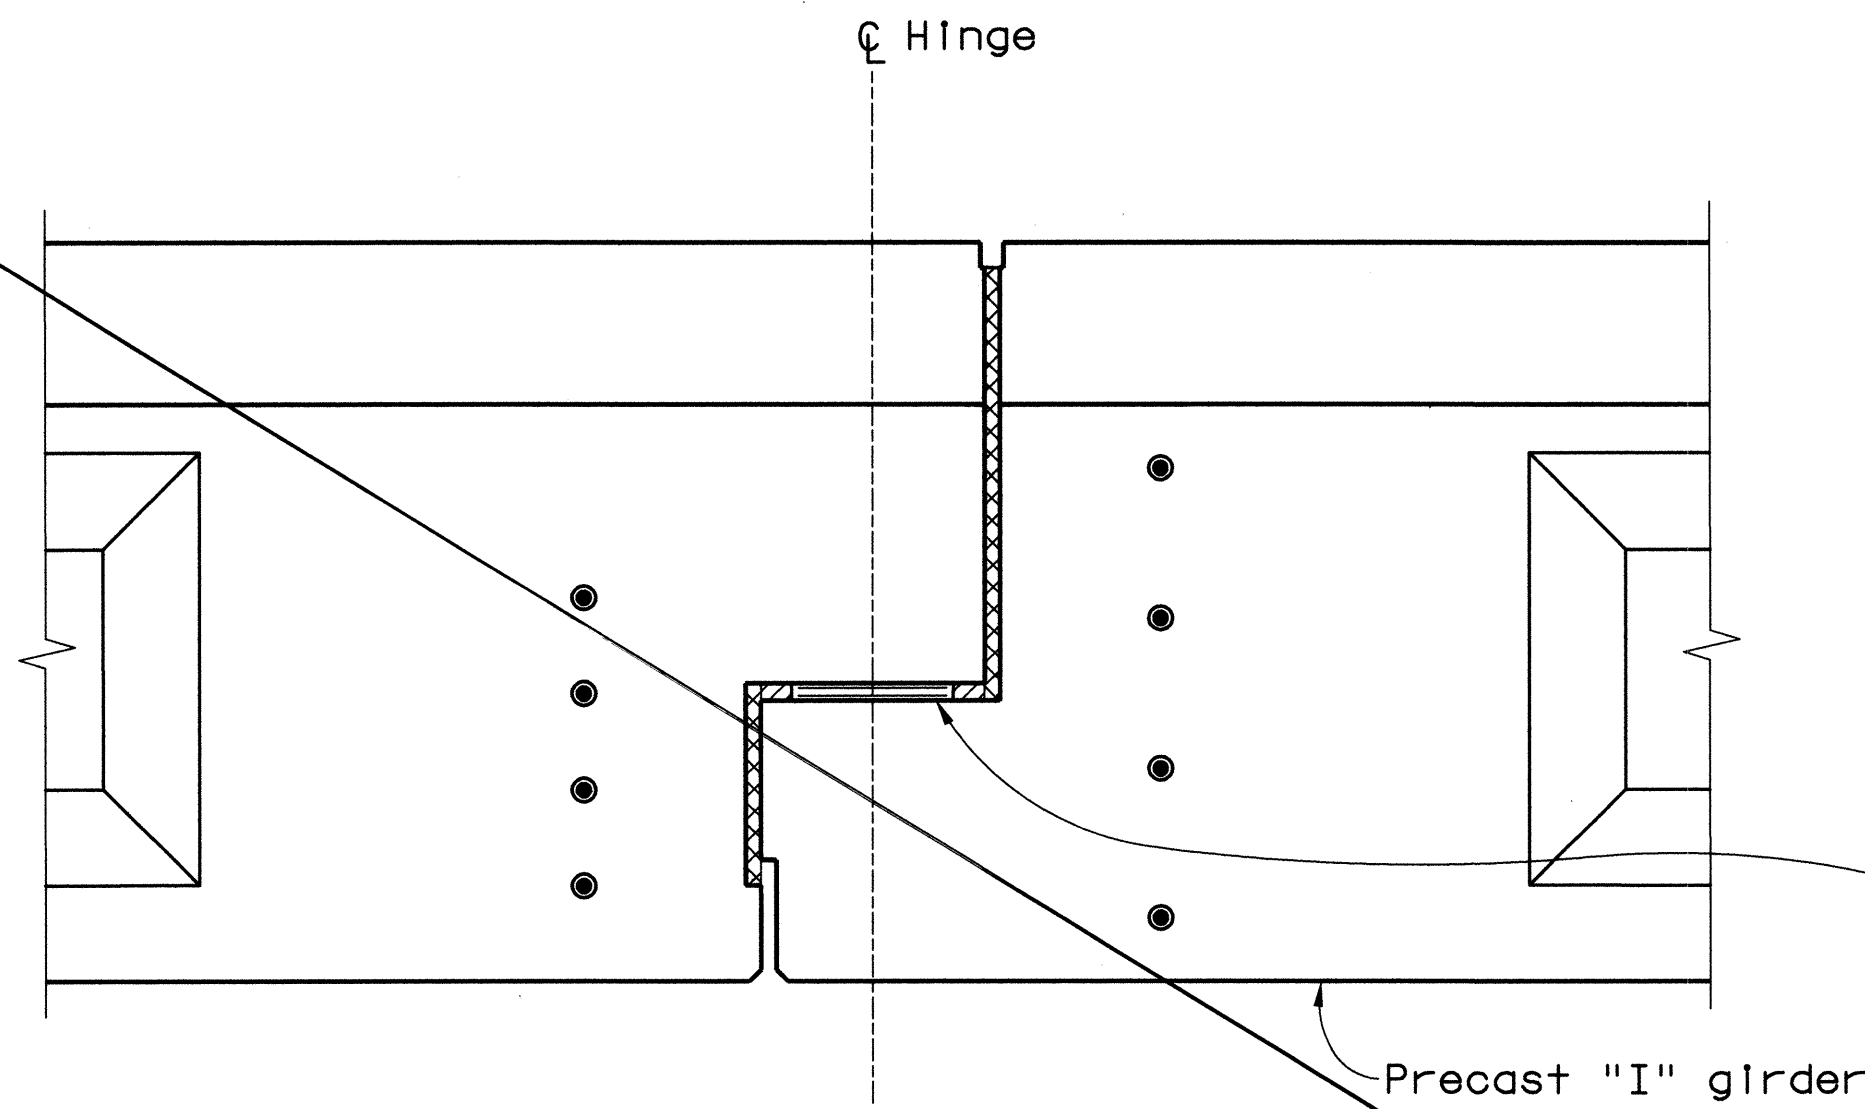

SUPERSEDED AND REPLACED BY SHEET GIR.

W. Koo & Associates, Inc.
600 The City Parkway West, Suite 310
Orange, CA 92668
PH: (714) 456-0280
FAX: (714) 456-0295

ORANGE COUNTY PUBLIC FACILITIES AND RESOURCES DEPARTMENT		GLASSELL STREET BRIDGE WIDENING OVER SANTA ANA RIVER		HINGE DETAILS NO. 2	
MARK	DATE	DESCRIPTION			
REVISIONS					
PREPARED UNDER RESPONSIBLE CHARGE OF:					
DESIGNED: K. RUSSELL		DRAWN: G. BUELOW		CHECKED: S. SHARIFAN	SHEET
SCALE	DATE	DRAWING NO.		61	
AS SHOWN	7/19/02			OF 70	

Note: Contractor shall verify all controlling field dimensions before ordering or fabricating any material

Date Plotted: 07/18/02

File Name: I:\010-14\glassell\gl_hd2.dgn

Border sheet last modified 09-Nov-1999