


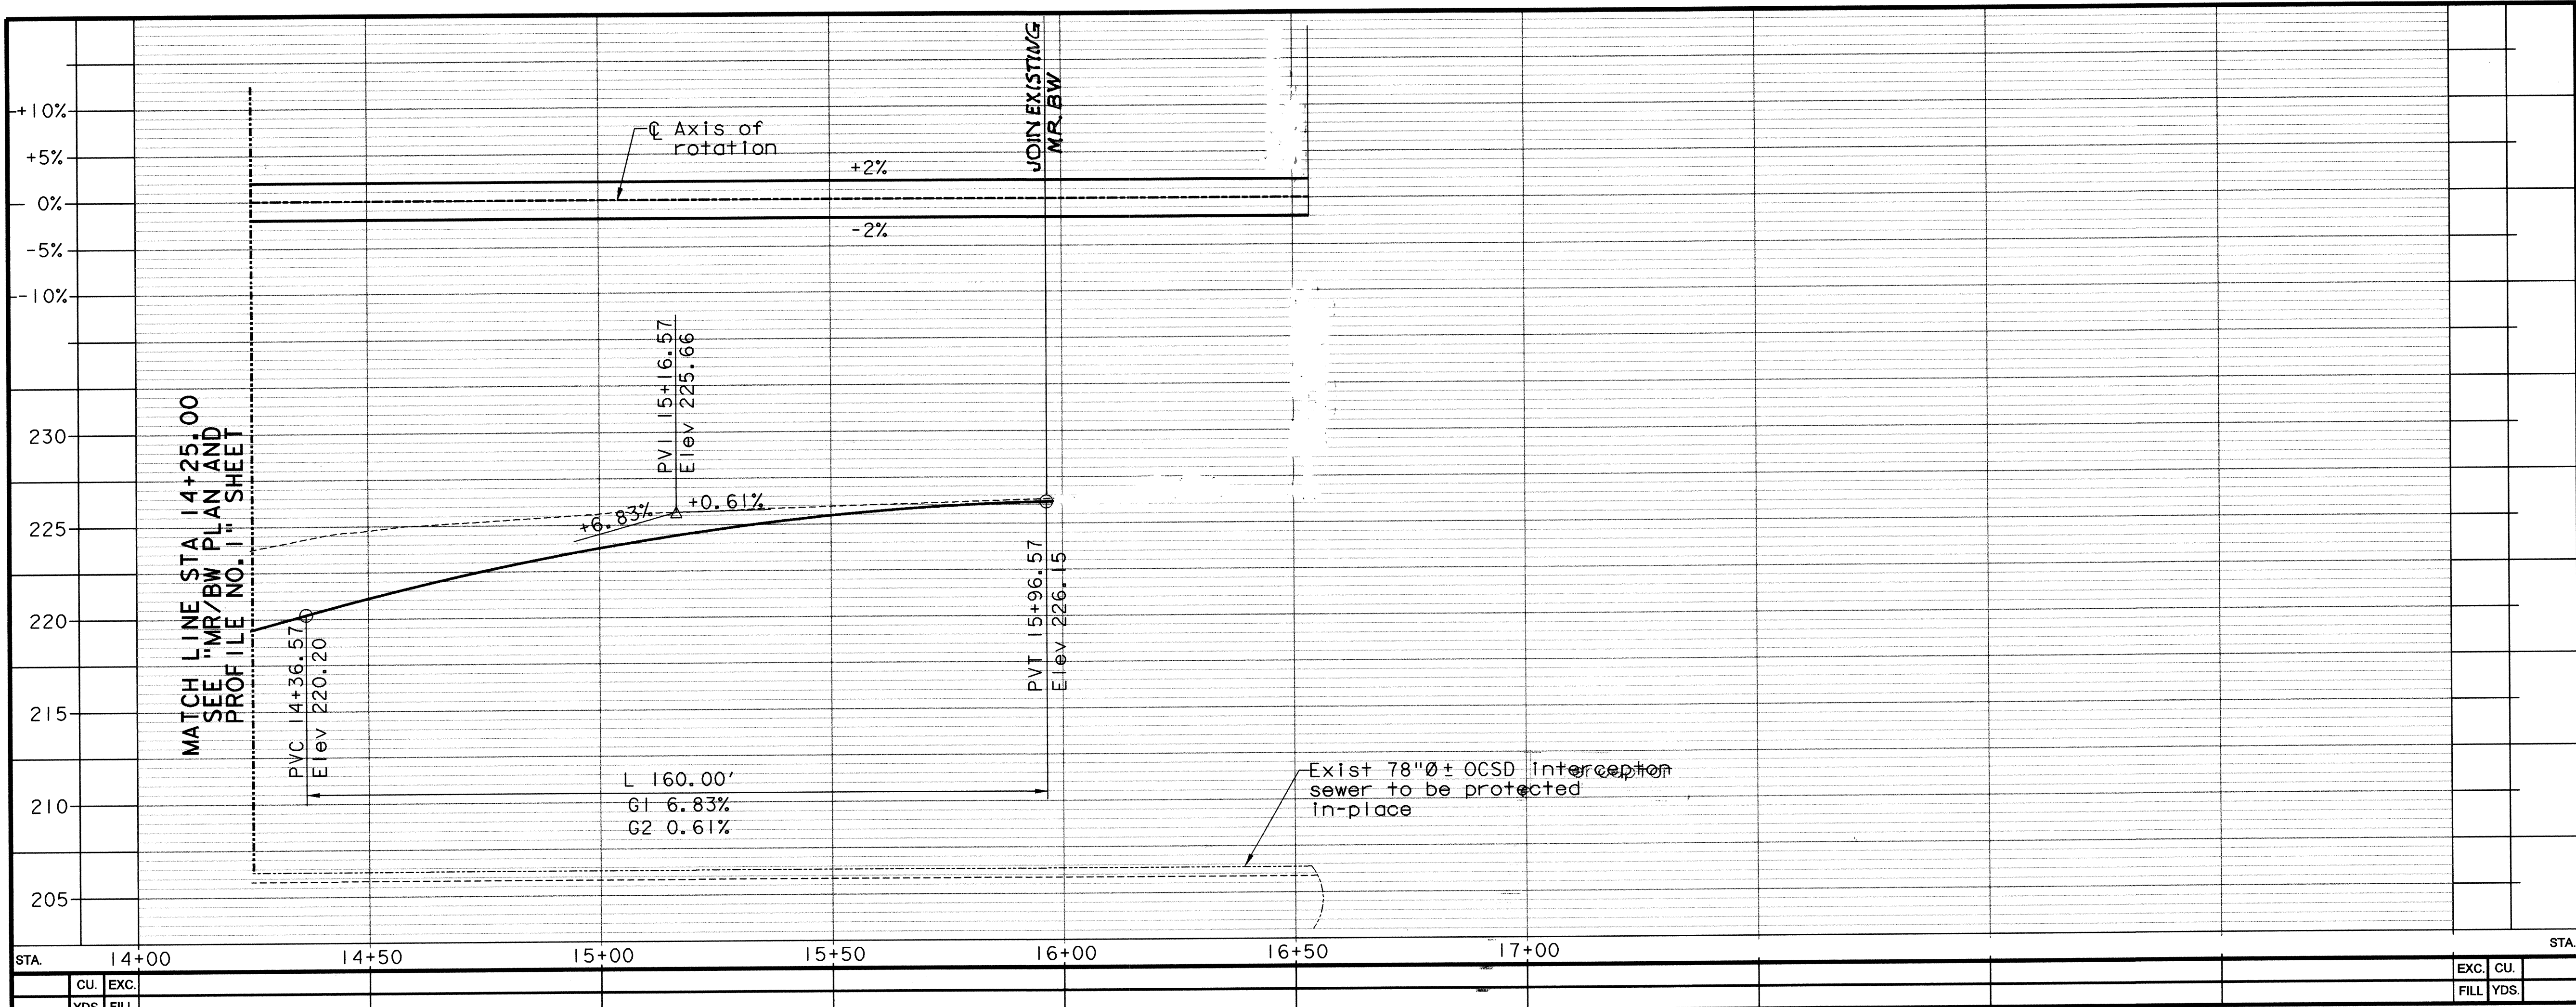


NOTES

- (XXX.XX) = EXIST. EL
 ① = PROTECT IN PLACE
 ② = DG RIDING & HIKING TRAIL - Exist access road (DG)
 ③ = AB LEVEE ROAD ACCESS

PROFILE

HORIZ: 1" = 20'
 VERT: 1" = 5'

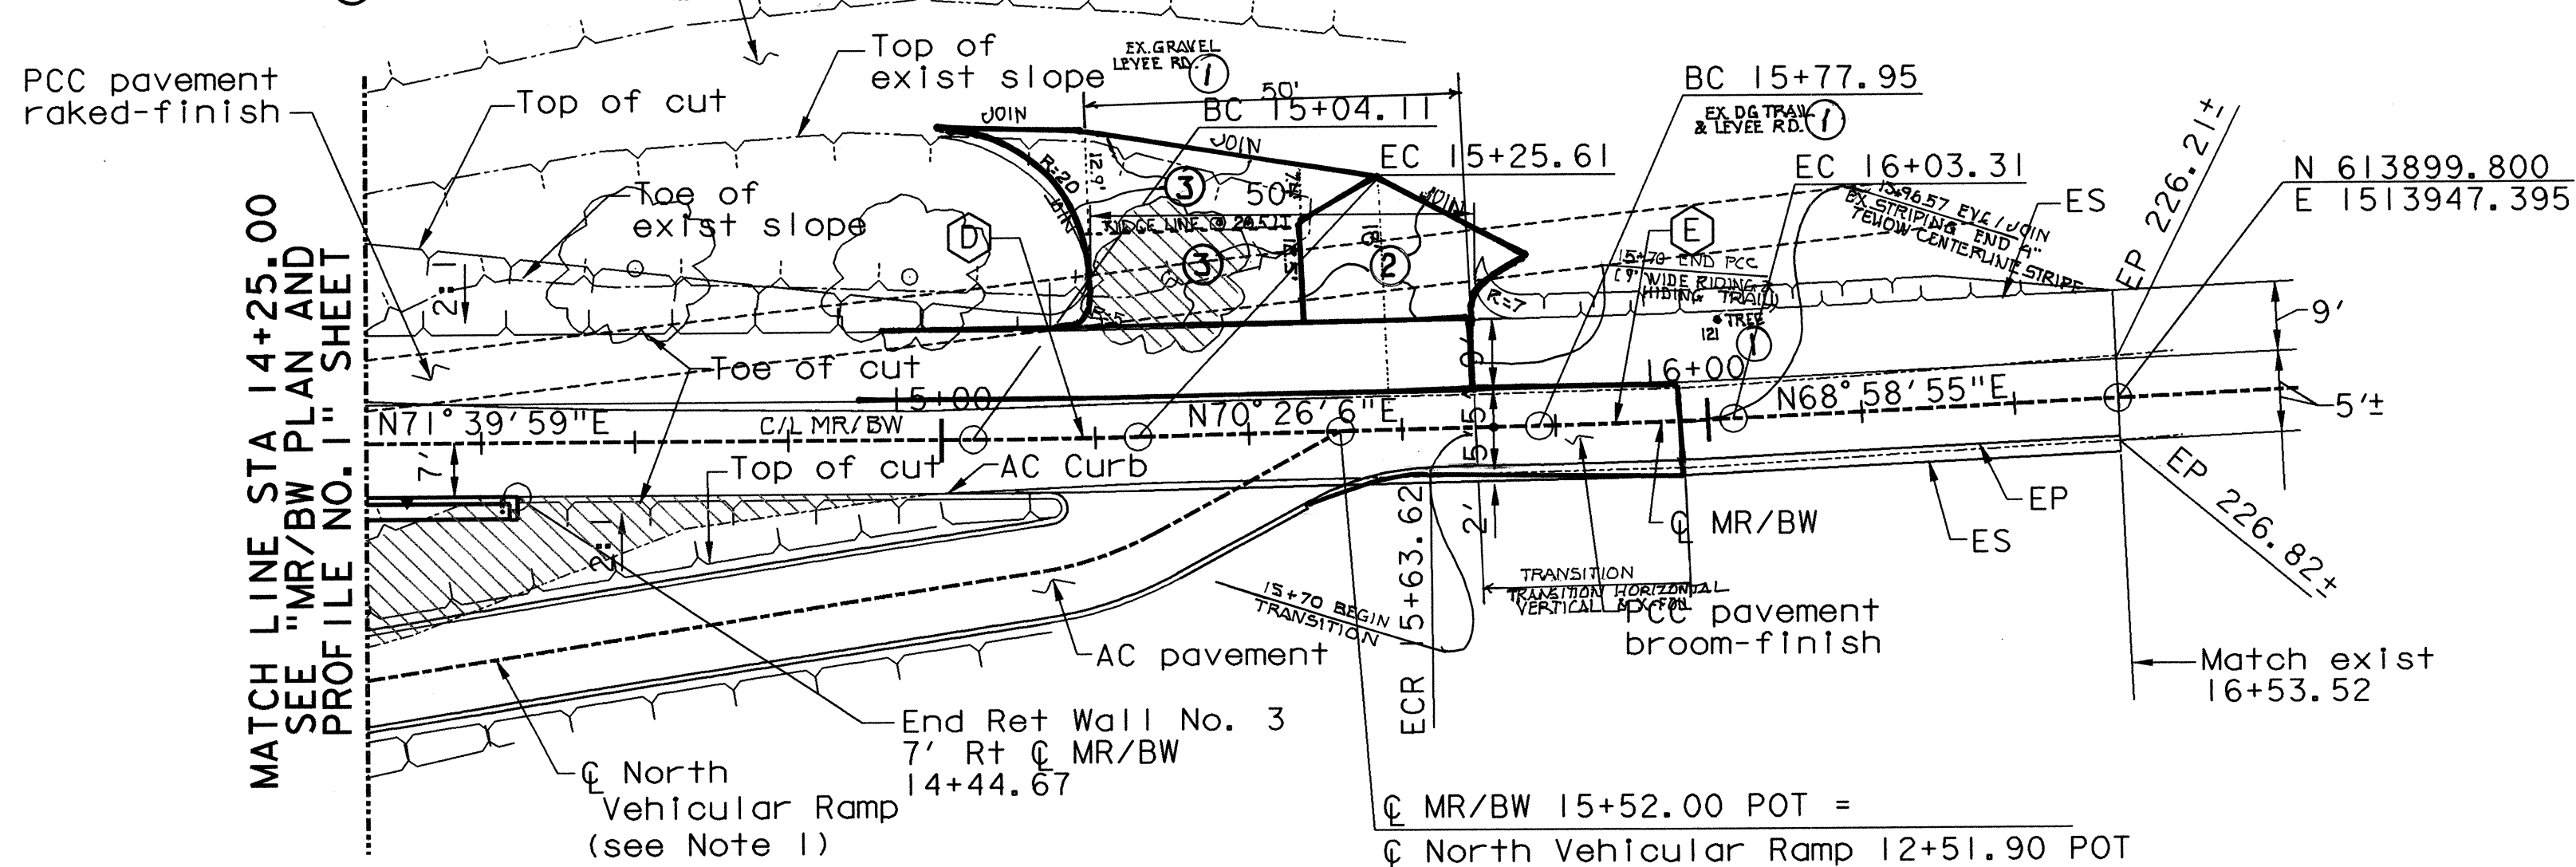

PLAN

1" = 20'

CURVE DATA

D
 R = 1000.00'
 Δ = 01°13'53"
 T = 10.75'
 L = 21.50'

E
 R = 1000.00'
 Δ = 01°27'11"
 T = 12.68'
 L = 25.36'

LEGEND

- Remove exist Riding & Hiking Trail & Vehicular Ramp
 Remove exist trees (BY OTHERS)

Note:

- See "North Vehicular Maintenance Ramp Plan and Profile" sheet for details not shown.
- For tree removal on North vehicular Maintenance Ramp, see "North Vehicular Maintenance Plan and Profile" sheet.



W. Koo & Associates, Inc.
 600 The City Parkway West, Suite 310
 Orange, CA 92668
 PH: (714) 456-0280
 FAX: (714) 456-0295

ORANGE COUNTY PUBLIC FACILITIES AND RESOURCES DEPARTMENT	
GLASSELL STREET BRIDGE WIDENING OVER SANTA ANA RIVER MAINTENANCE ROAD/ BIKEWAY (MR/BW) PLAN AND PROFILE NO. 2	
MARK	DATE
DESCRIPTION	
REVISIONS	
PREPARED UNDER RESPONSIBLE CHARGE OF:	
DESIGNED: G. BUELOW	CHECKED: S. SHARIFAN
DRAWN: G. BUELOW	DRAWING NO.
SCALE	DATE
AS SHOWN	7/19/02
SHEET 9 OF 70	