




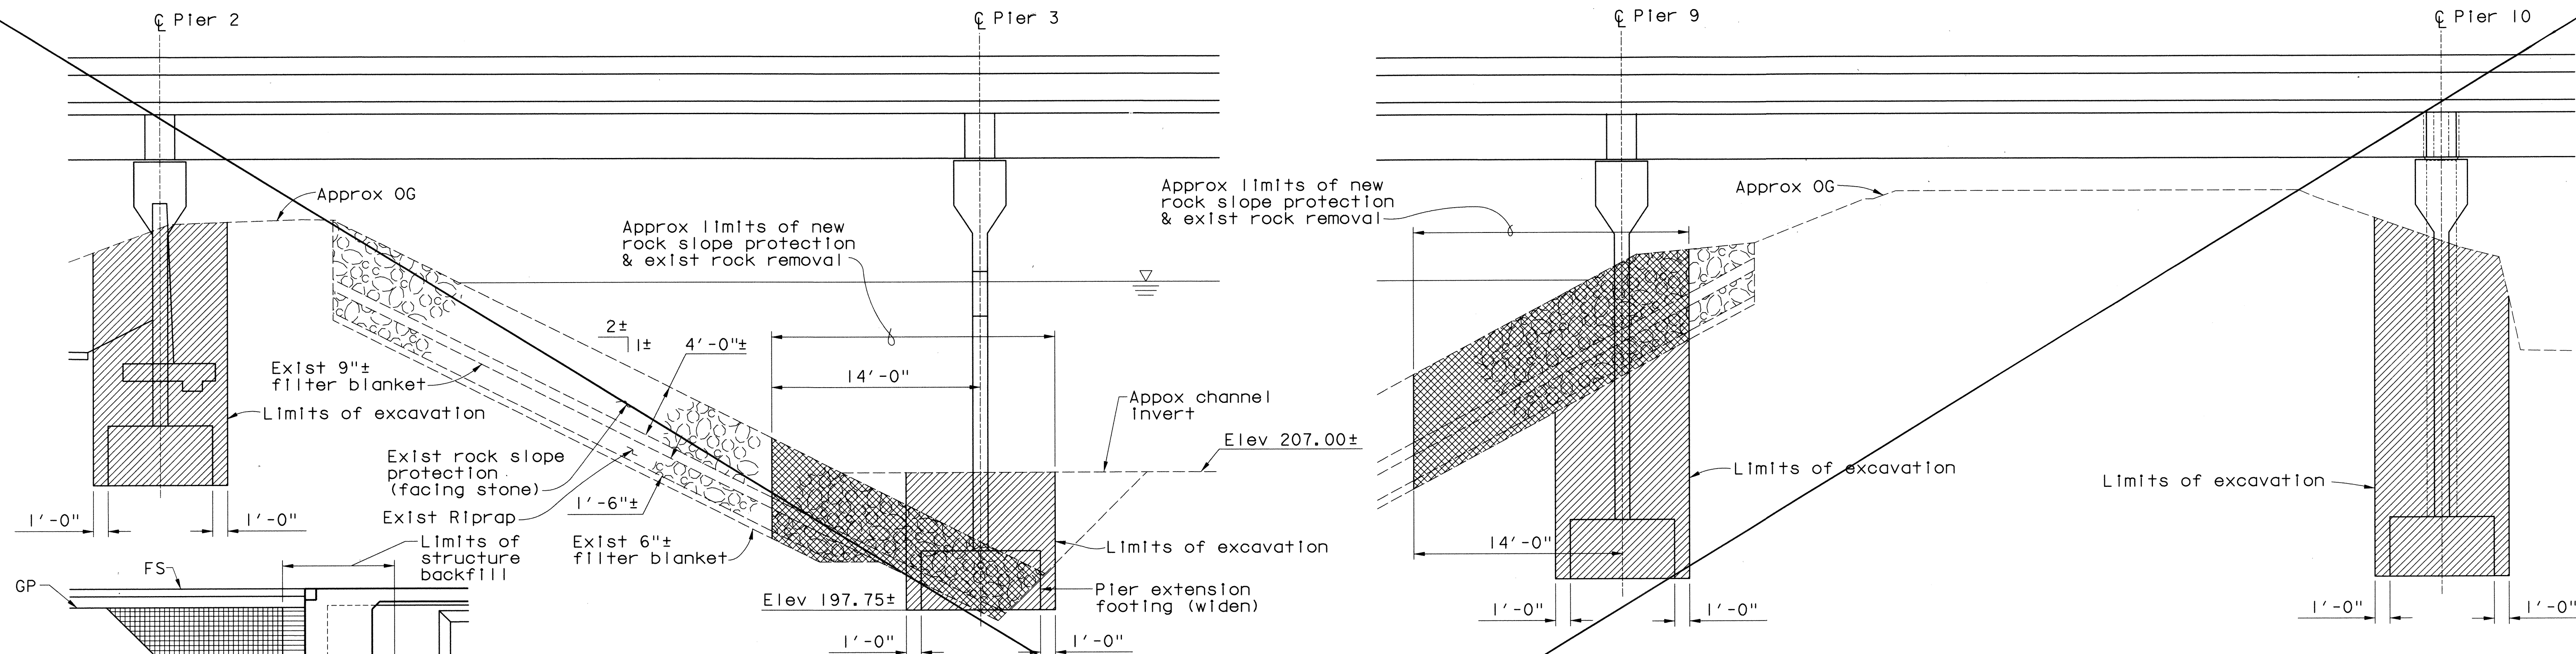

SUPERSEDED AND REPLACED BY SHEET 64R.

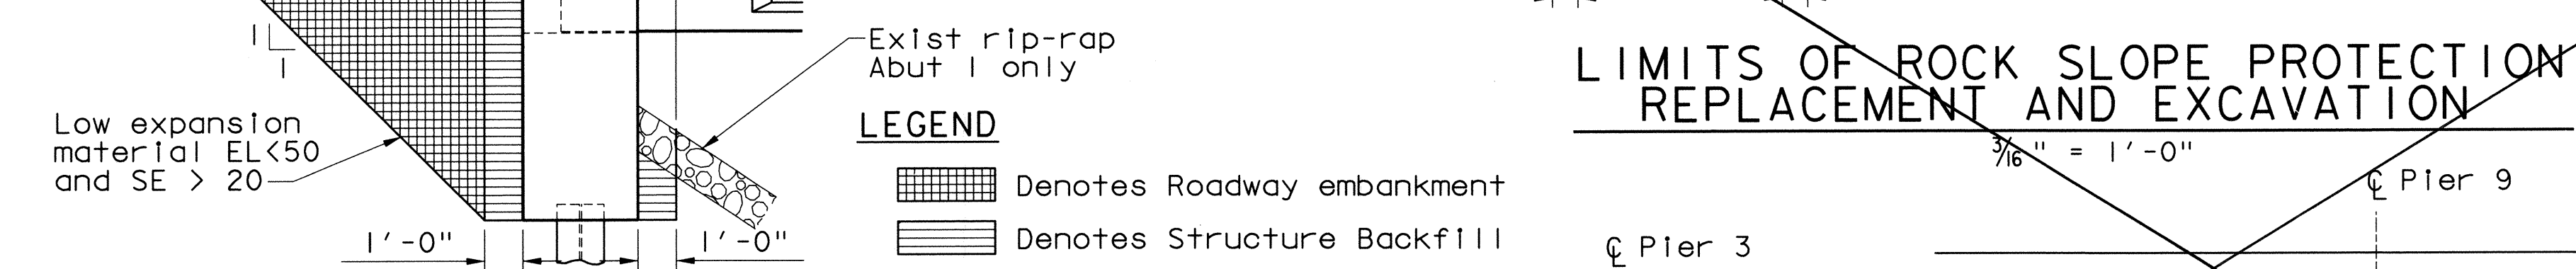

**LOW EXPANSION MATERIAL DETAIL**  
No Scale

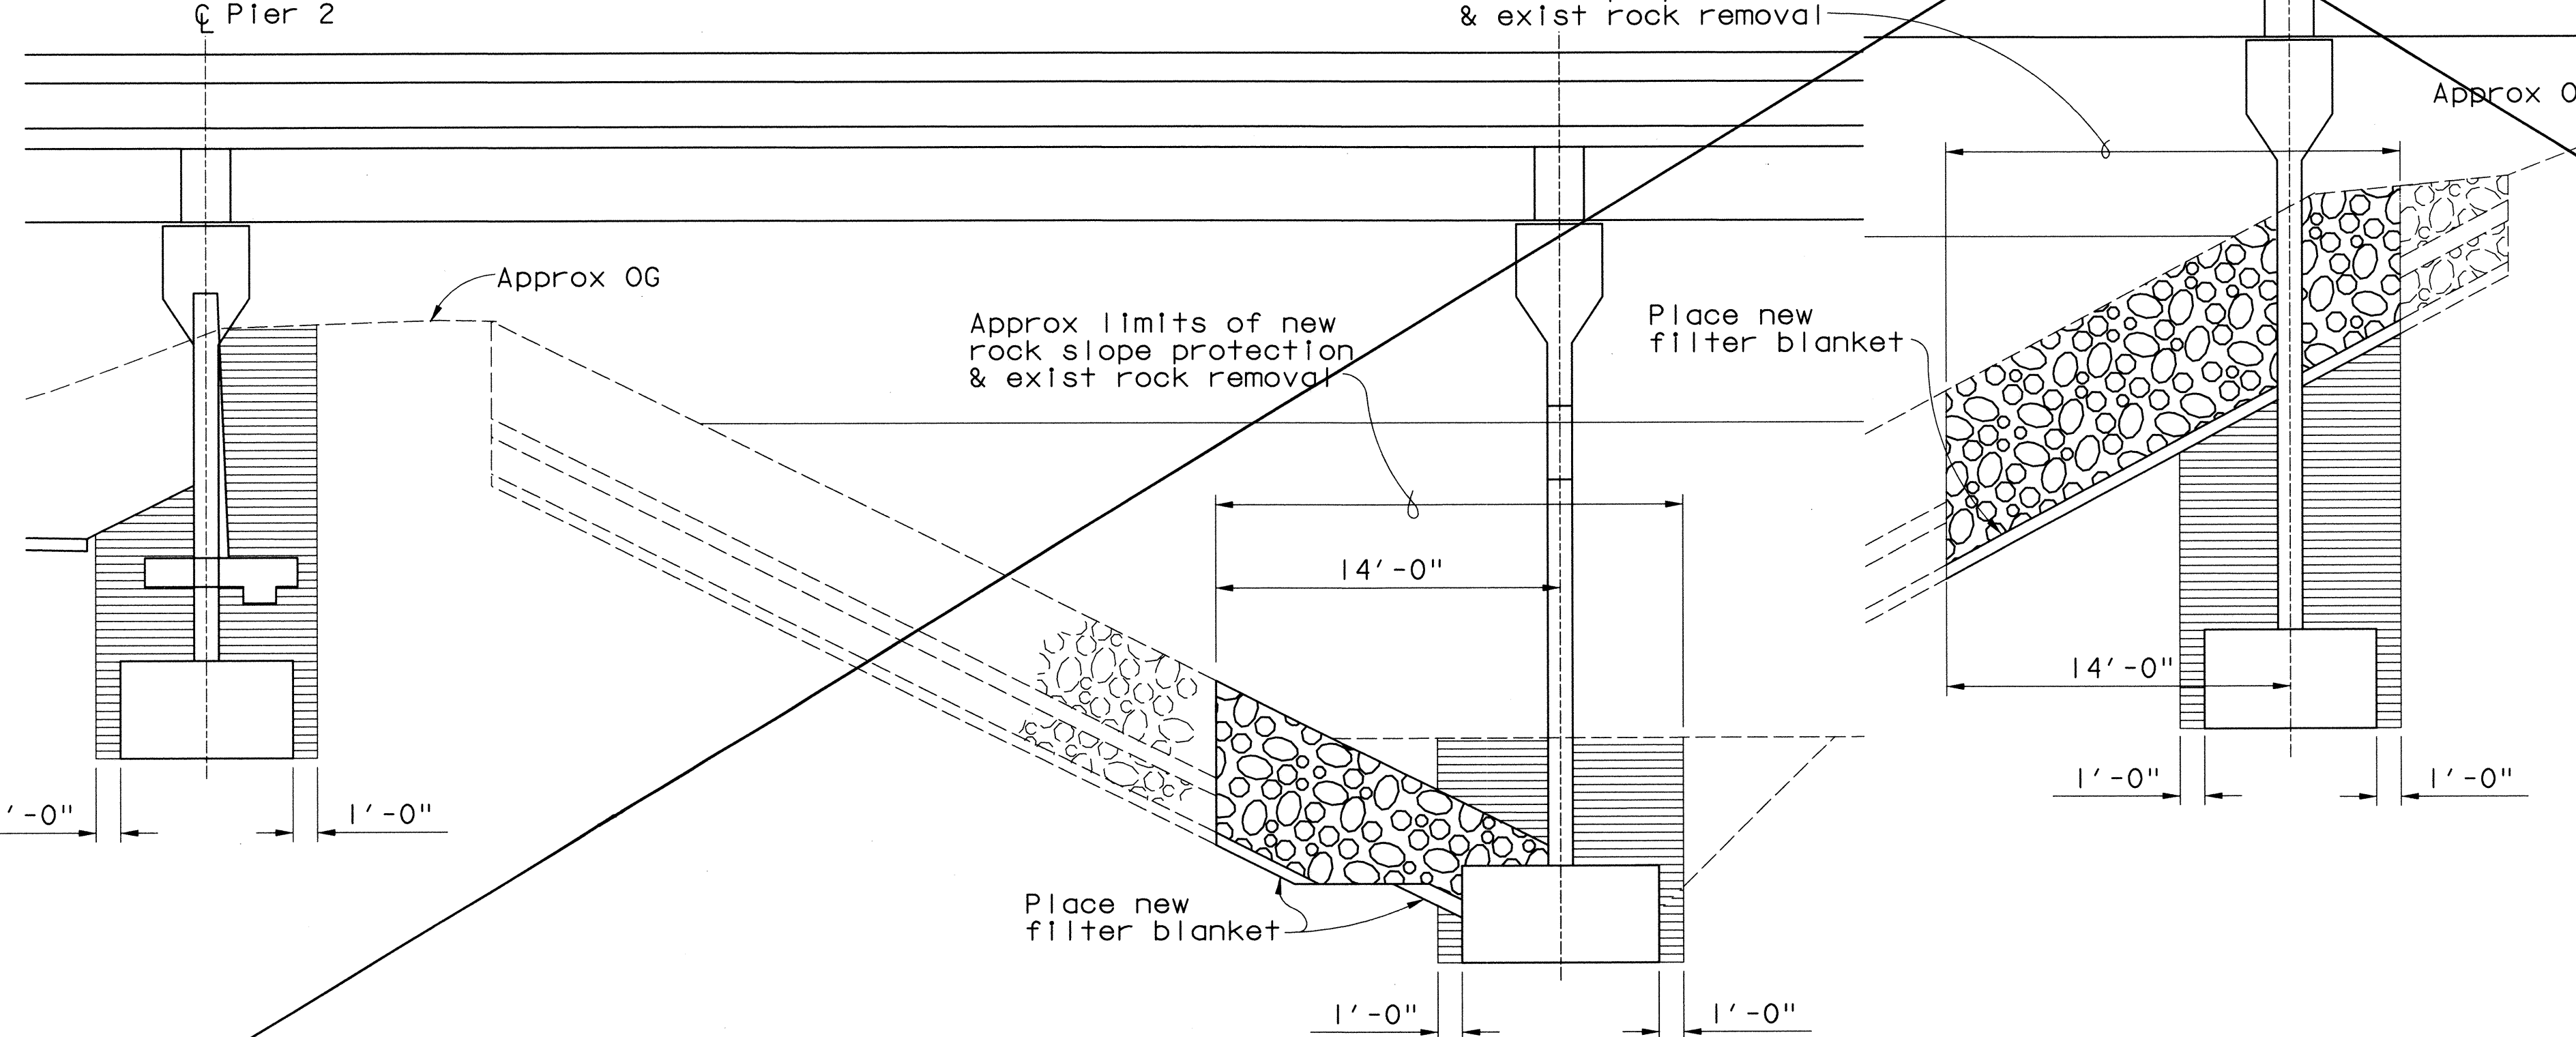

Note: Contractor shall verify all controlling field dimensions before ordering or fabricating any material

**LIMITS OF STRUCTURE BACKFILL**  
 $\frac{3}{16}'' = 1'-0''$

- LEGEND**
- Denotes Structure Excavation
  - Denotes Structure Backfill
  - Denotes Rock Slope Protection Removal

**ORANGE COUNTY**  
PUBLIC FACILITIES AND RESOURCES DEPARTMENT

**GLASSELL STREET BRIDGE WIDENING  
OVER SANTA ANA RIVER**

**MISCELLANEOUS  
DETAILS NO. 2**

DESIGNED: K. RUSSELL

DRAWN: G. BUELOW

CHECKED: S. SHARFAN

SCALE: AS SHOWN

DATE: 7/19/02

DRAWING NO. 64

OF 70

REVISIONS

| MARK | DATE    | DESCRIPTION     |
|------|---------|-----------------|
| 1    | 9/12/02 | 3/11/11.3/11/11 |

PREPARED UNDER RESPONSIBLE CHARGE OF:

SHAEL M. SHARFAN  
No. 48681  
Exp. 3-30-04  
STATE OF CALIFORNIA

W. Koo & Associates, Inc.  
600 The City Parkway West, Suite 310  
Orange, CA 92668  
PH: (714) 456-0280  
FAX: (714) 456-0295