
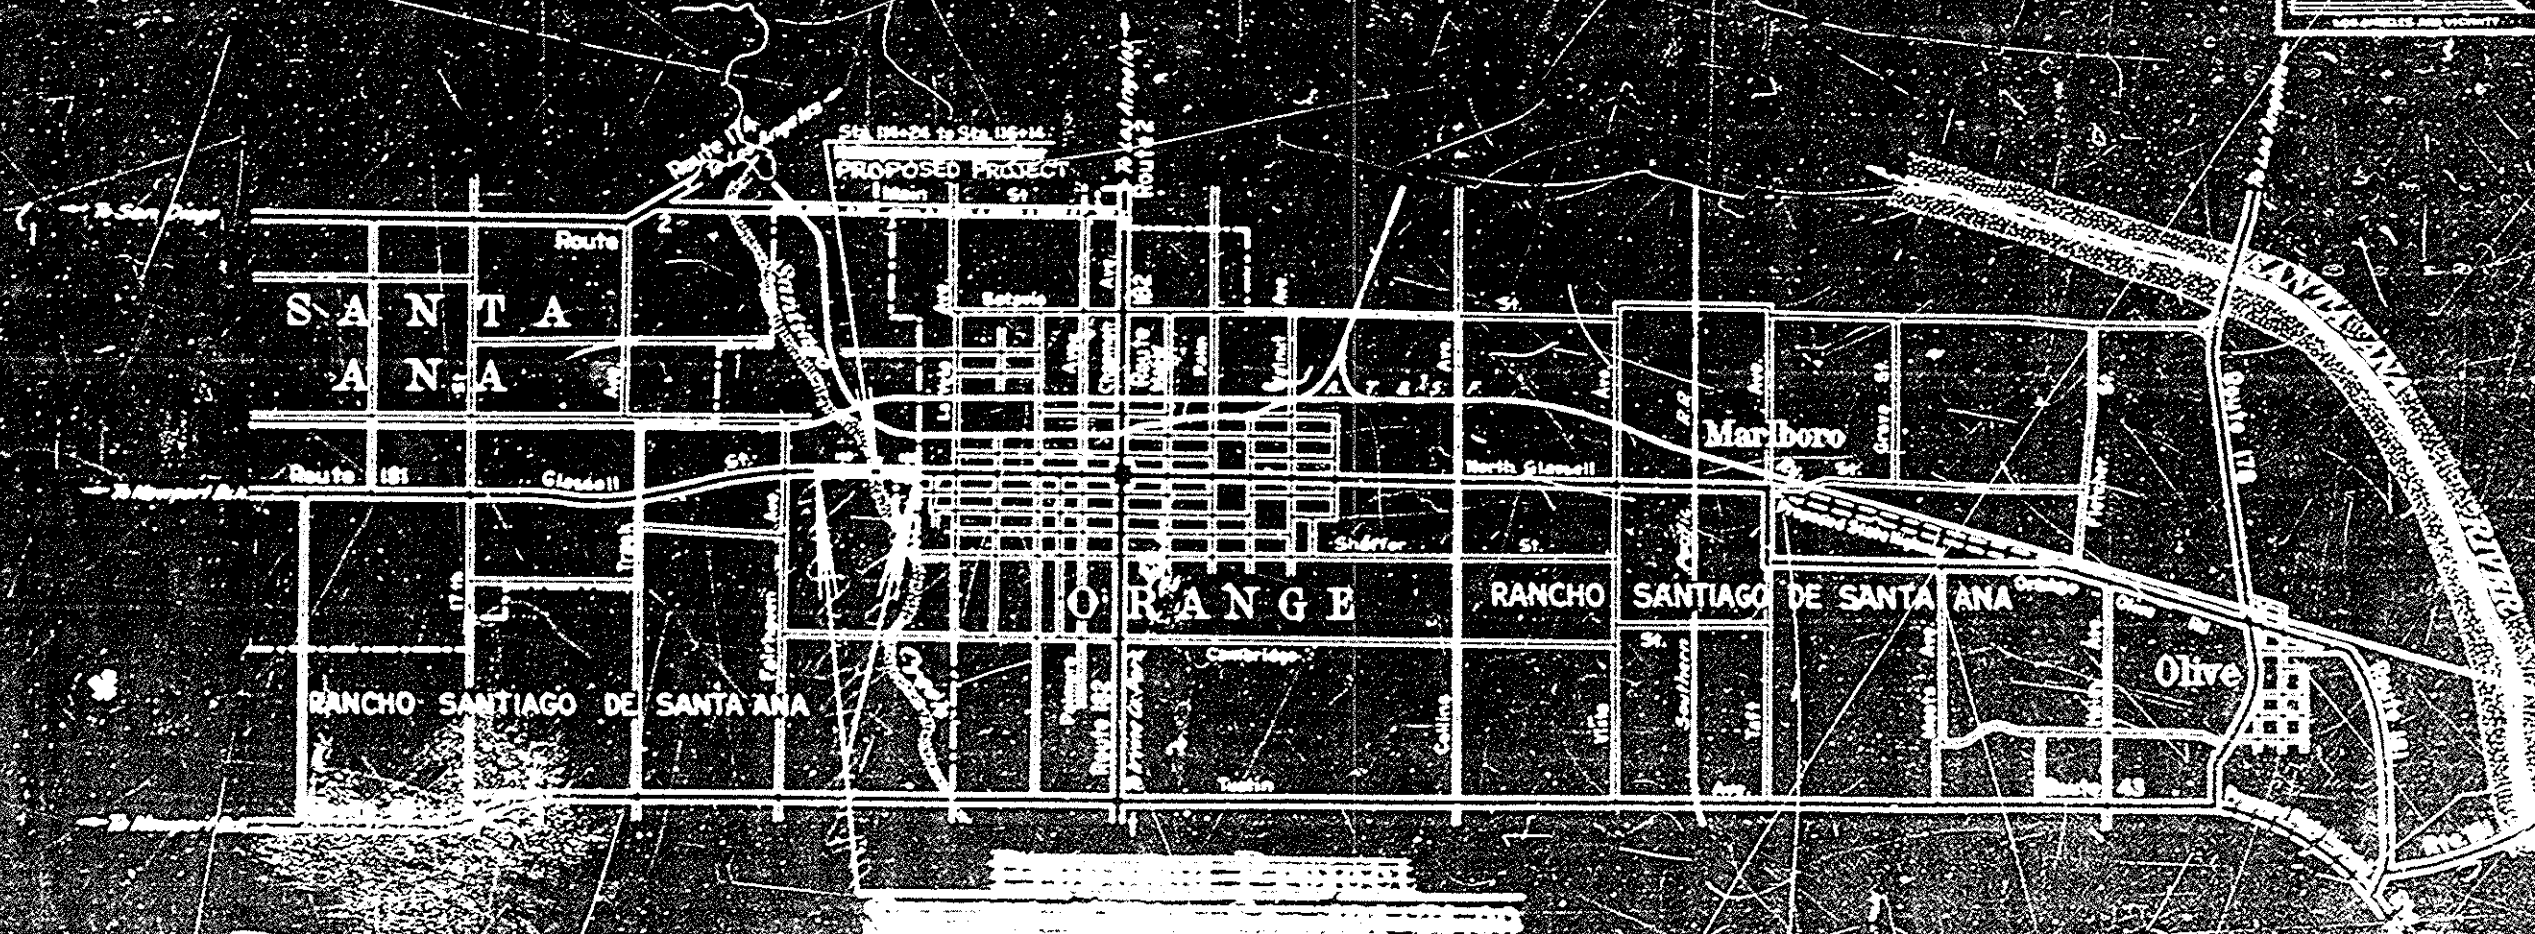


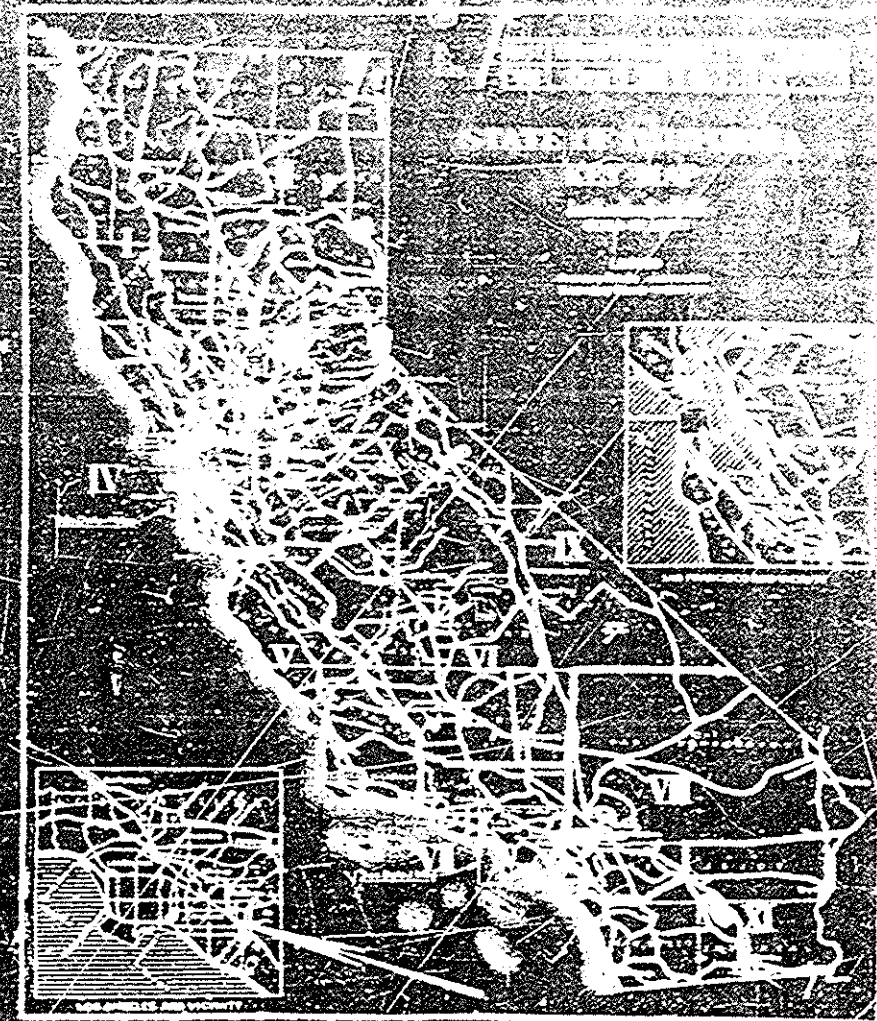

March 10, 1939

[illegible]

Brinkley Lake 20
Barrett and Lago Creek
Sheet 1 of 11
MED 225-1 Scale 1:20,000
Blueprint 1:10,000

[illegible]

14654 1939
GLASSELL ST. BR.
(SC-20) over Santiago Creek.
55C-16
Thomson 799-66