


BRIDGE DEPARTMENT

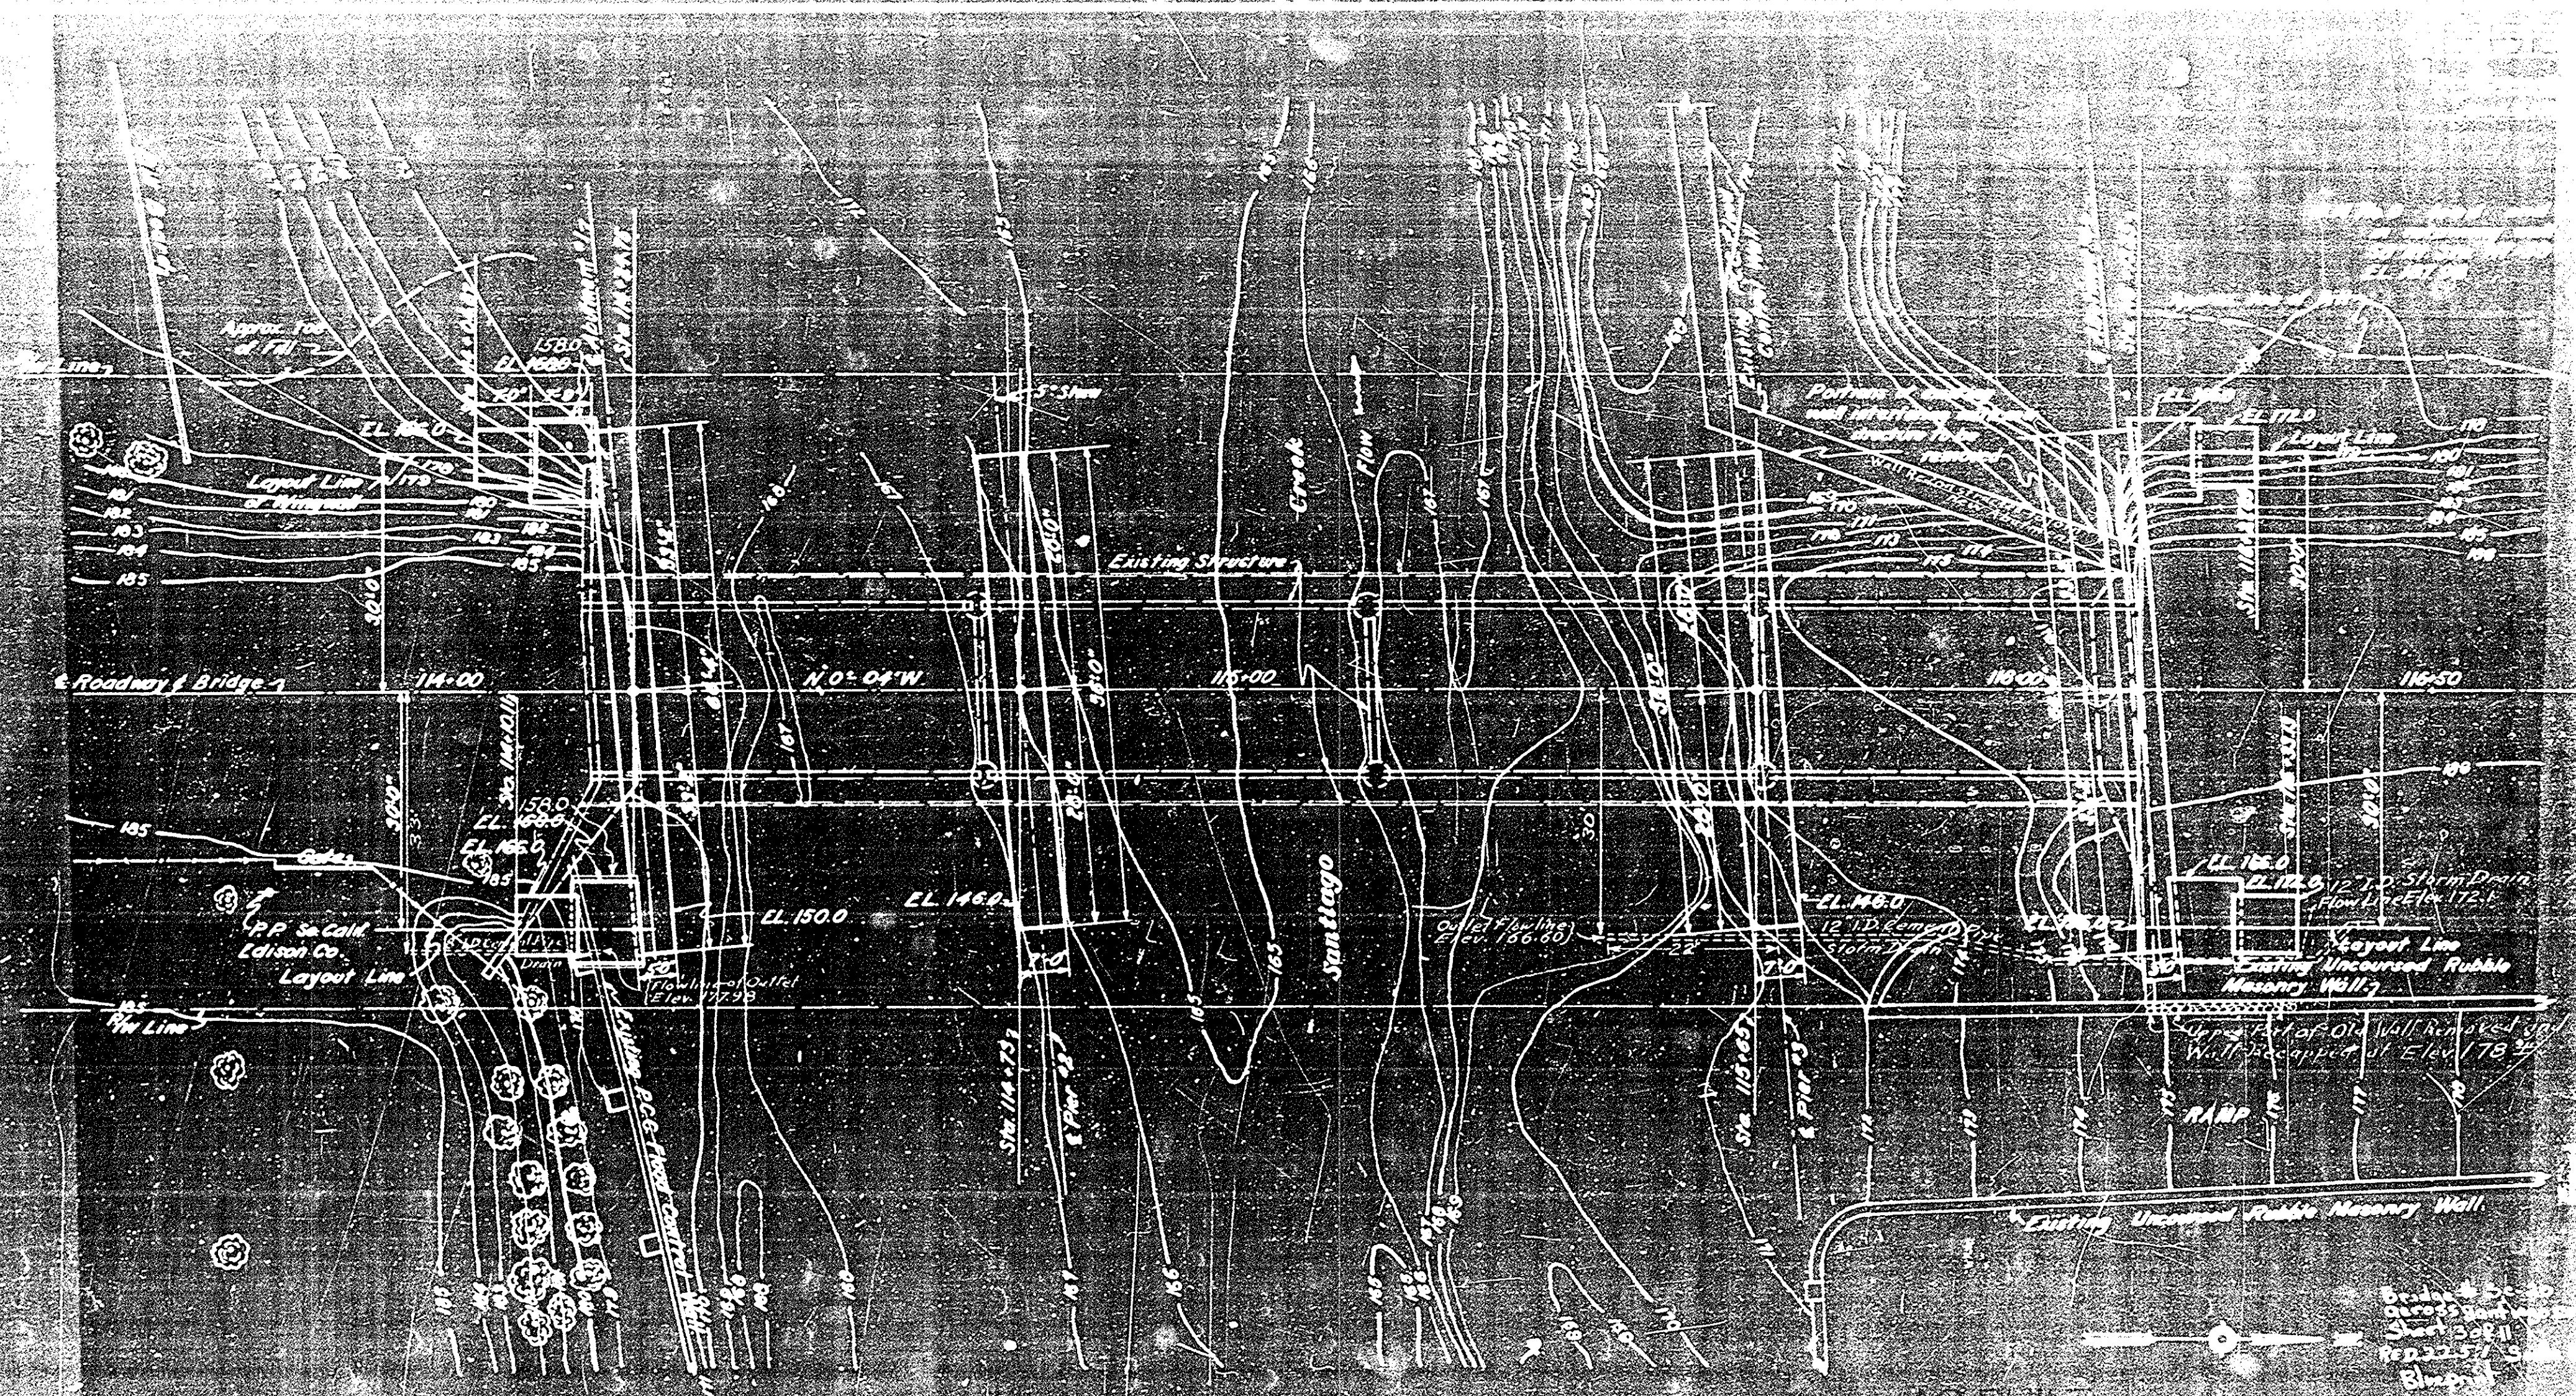

GENERAL NOTES

1. Plans and sections shall conform to the
Standard Specifications for the State of California
Department of Public Works, Division of Highways,
dated January 1935, and the Special Provisions
therein.
2. The Engineer's Office shall be responsible for the
accuracy of the data furnished by the contractor.
3. The contractor shall be responsible for the
accuracy of the data furnished by the contractor.

FOUNDATION PLAN

Scale 1" = 10'
All elevations shown are at bottom of footings.
Data by Contractor's Survey 4/2/37

Bridge & Structures
Department
San Francisco
California

APPROVED
JUL 1937