


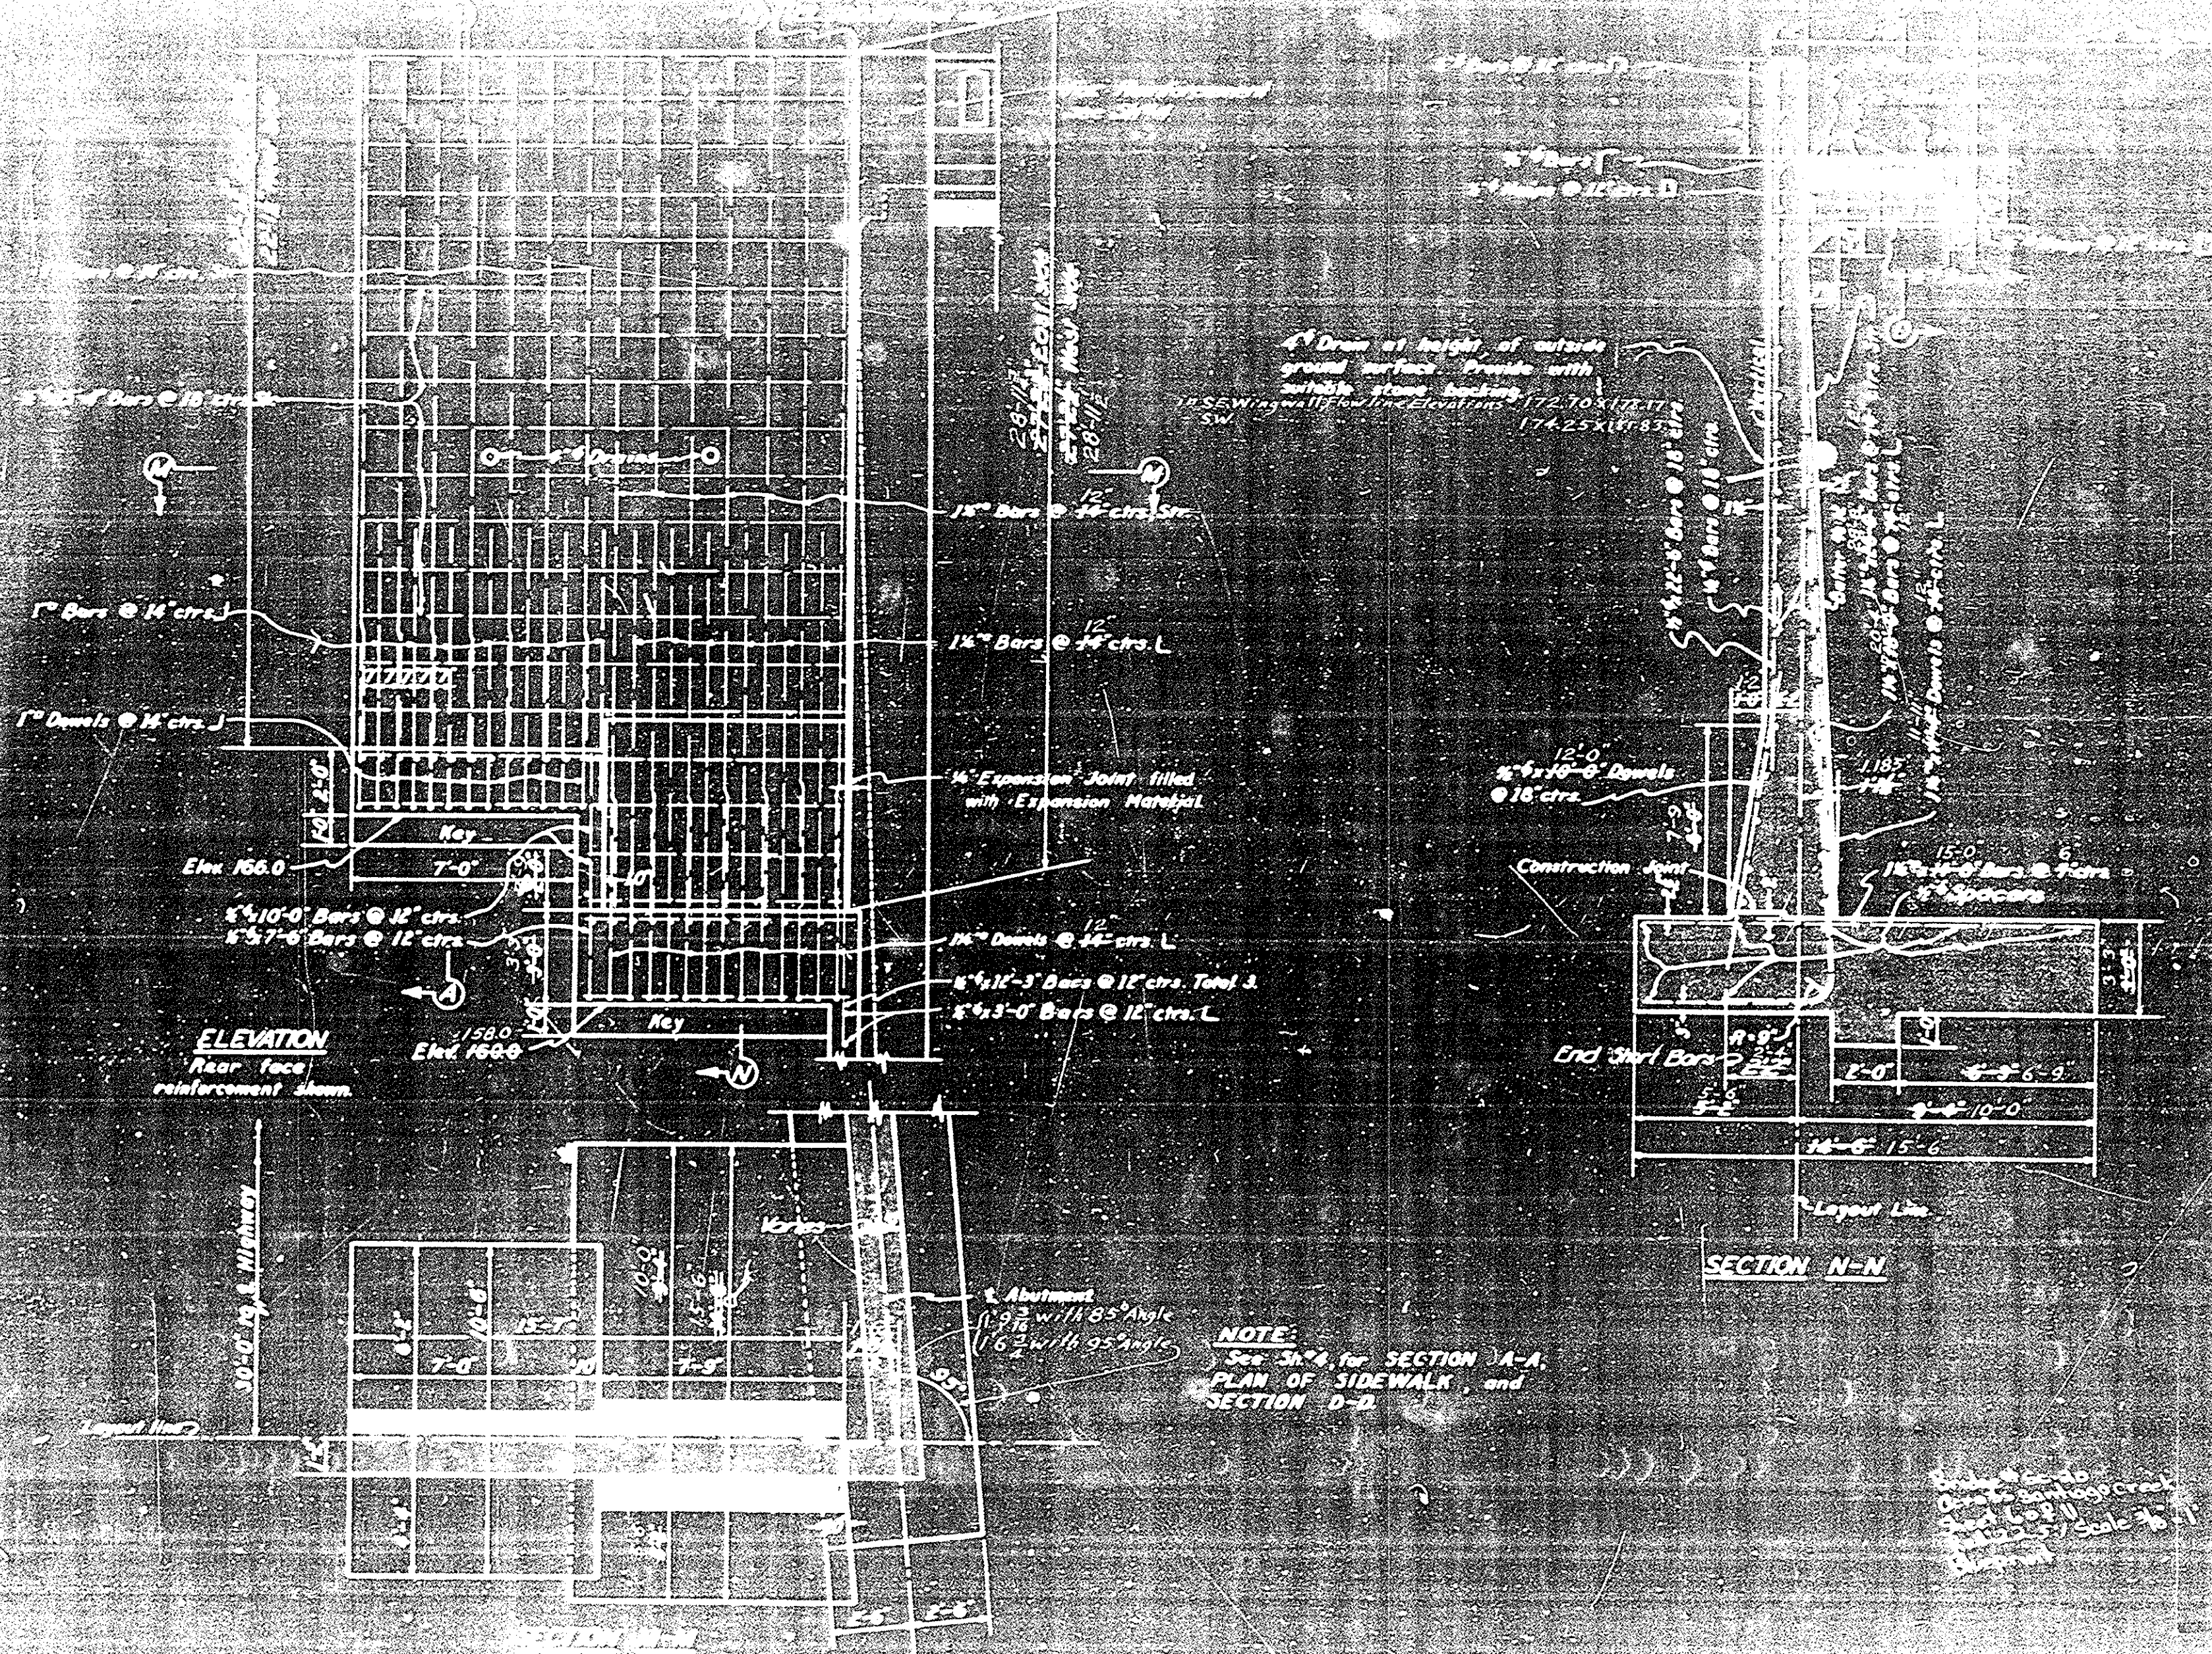

March 10, 1939

Bridge No. 40
Over the Loggocreek
East Log II
Date 5/1 Scale 30
1/2 inch