
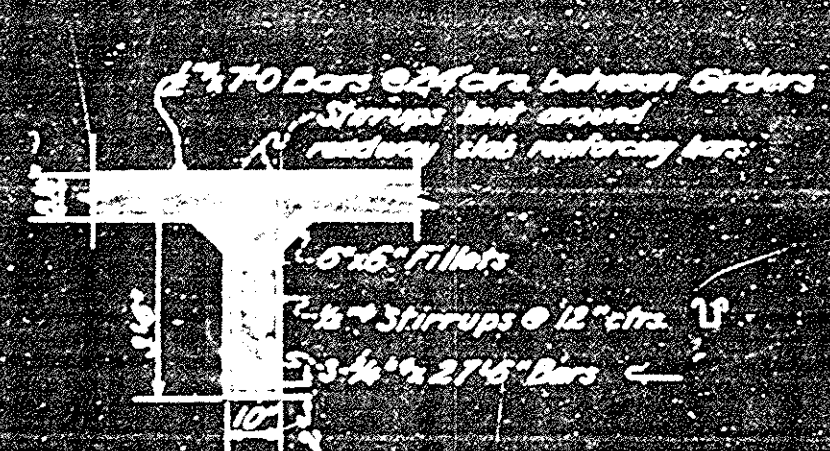


BRIDGE DEPARTMENT

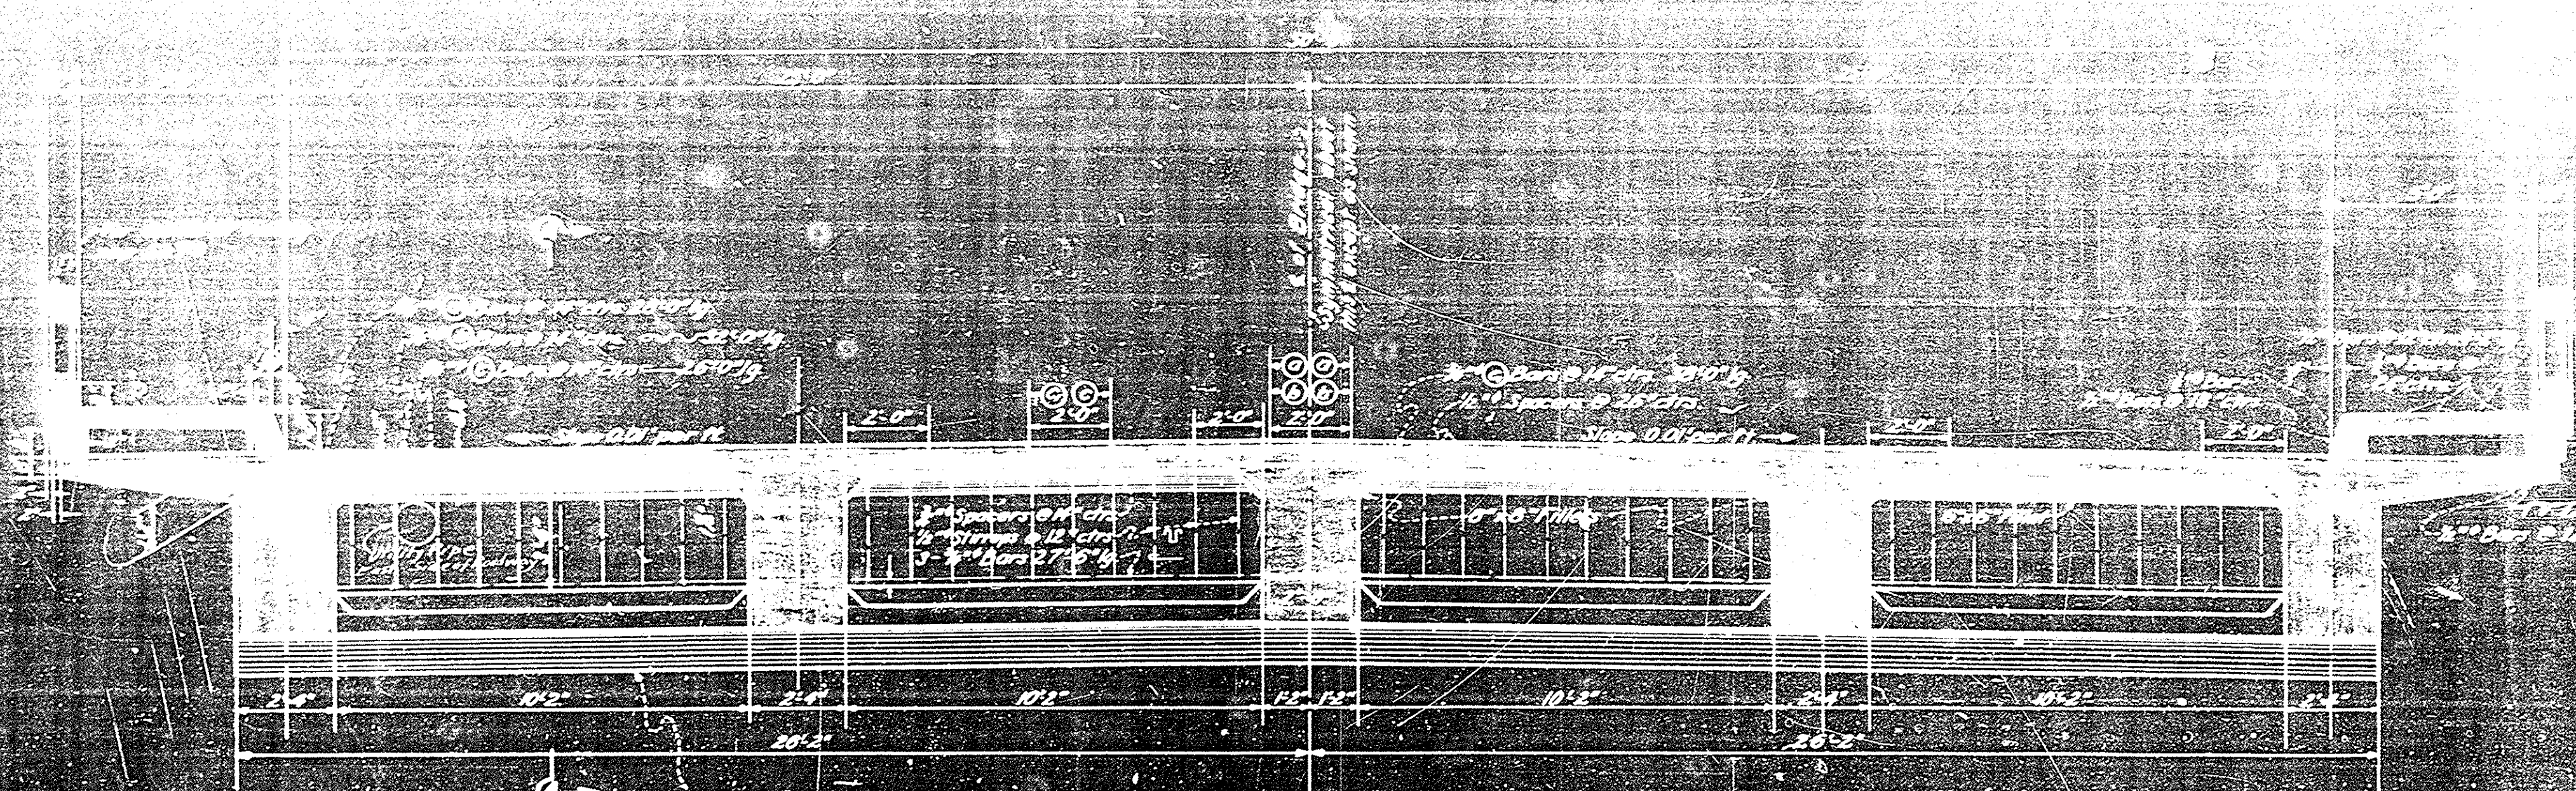

TYPICAL SECTION

J.C.M.
March 10, 1939

Bridge No. 20
Cross Section
Sheet 8 of 11
Ratio 5/8 Scale 1/2" = 1'-0"
Blueprint