

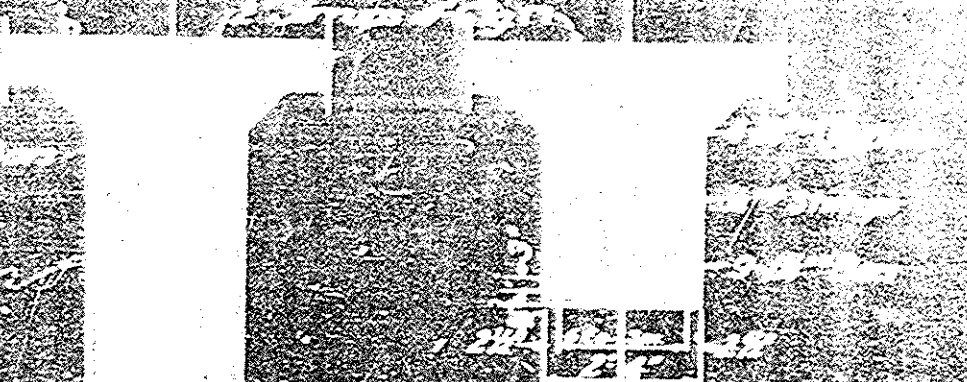



BRIDGE DEPARTMENT

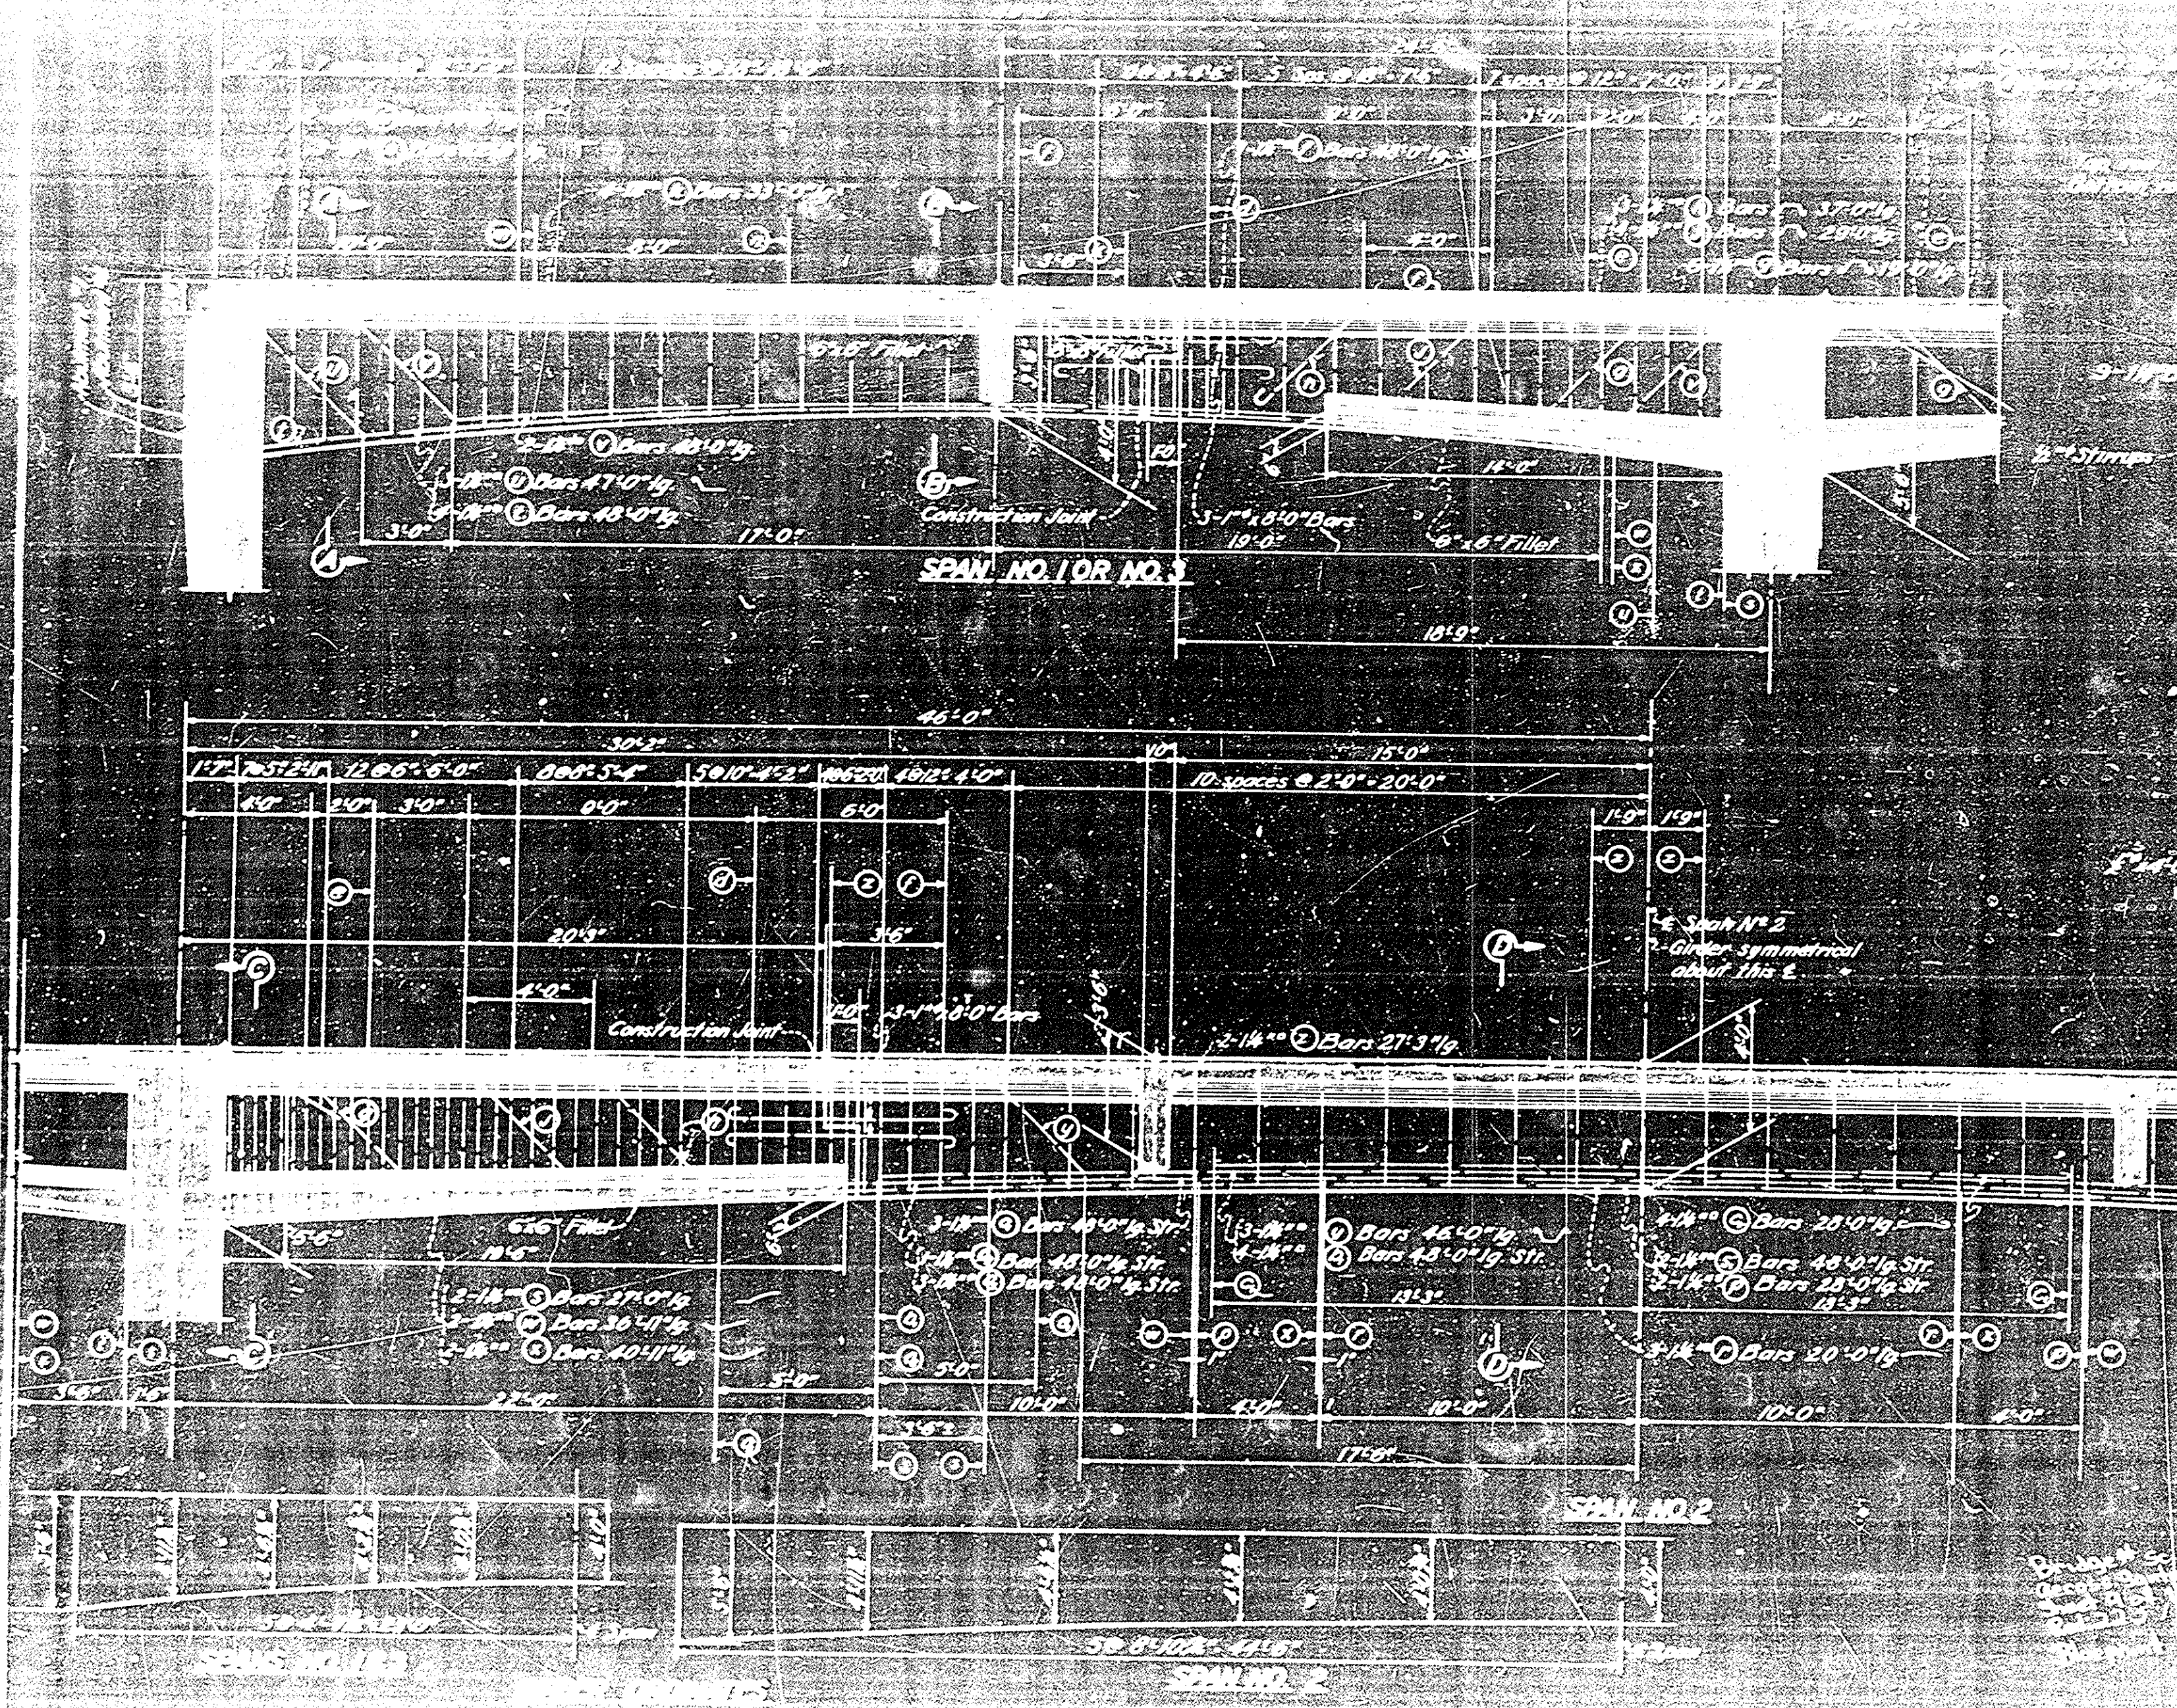


SECTION A-A
Scale 1/2" = 1'-0"

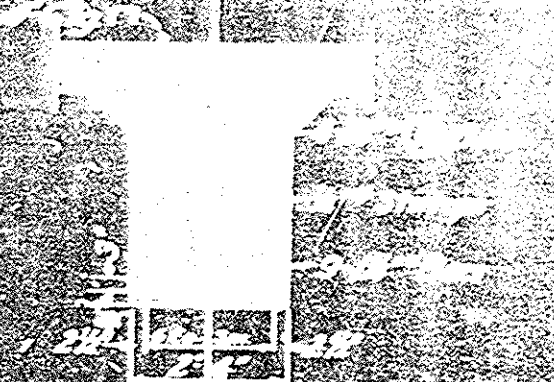

SECTION B-B
Scale 1/2" = 1'-0"

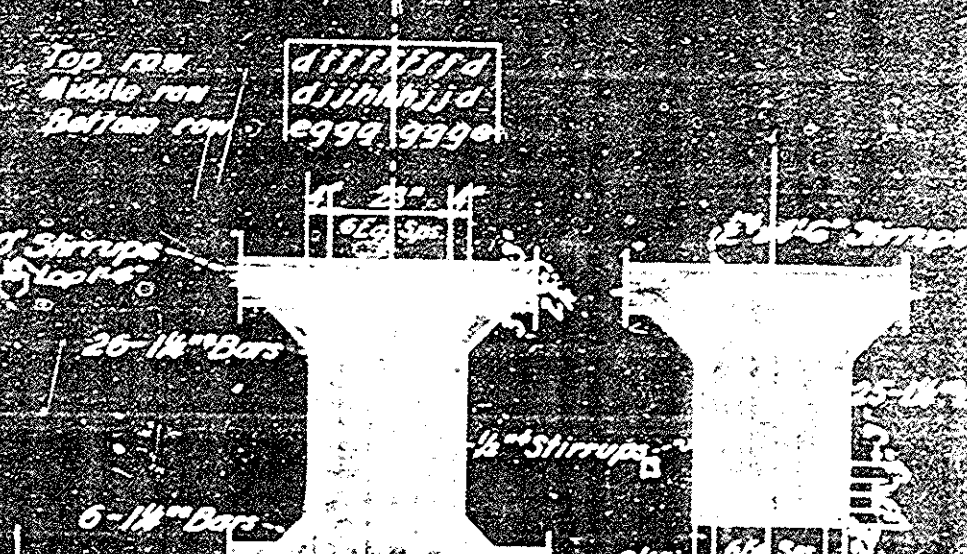

SECTION C-C
Scale 1/2" = 1'-0"

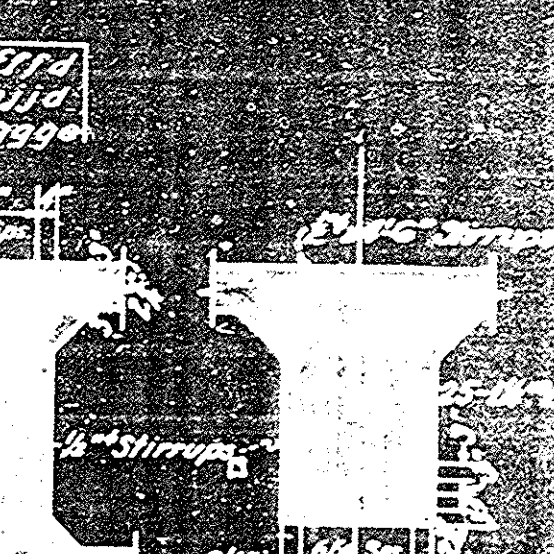

SECTION D-D
Scale 1/2" = 1'-0"

J.C.M.
March 10, 1939

BRIDGE DEPARTMENT
U.S. DEPARTMENT OF COMMERCE
BUREAU OF MARITIME SERVICE