



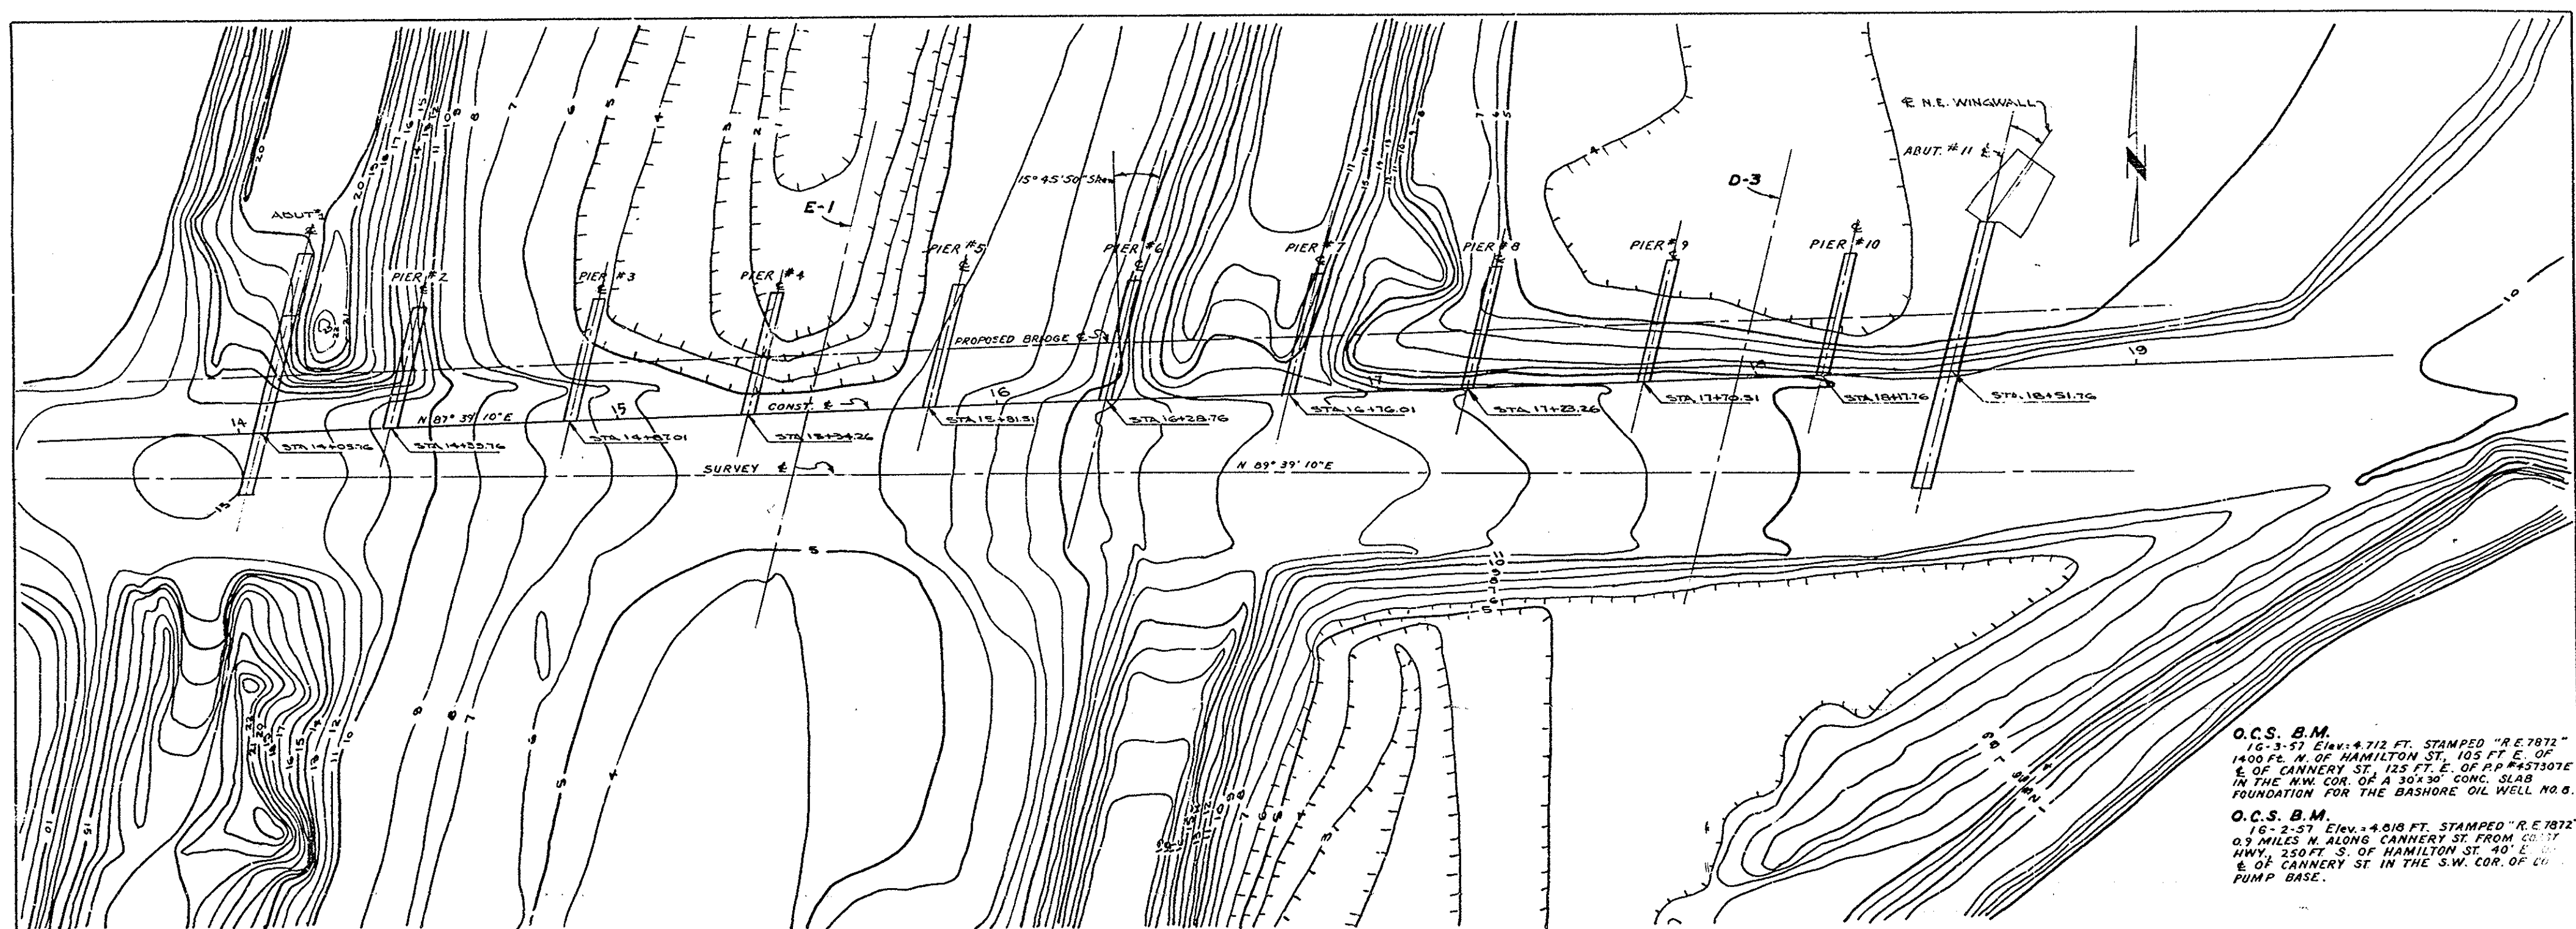

O.C.S. B.M.
16-3-57 Elev. 4.712 FT. STAMPED "R.E. 7872"
1400 FT. N. OF HAMILTON ST. 105 FT. E. OF
E. OF CANNERY ST. 125 FT. E. OF P.P. #457307E
IN THE N.W. COR. OF A 30x30' CONC. SLAB
FOUNDATION FOR THE BASHORE OIL WELL NO. 8.

O.C.S. B.M.
16-2-57 Elev. 4.818 FT. STAMPED "R.E. 7872"
0.9 MILES N. ALONG CANNERY ST. FROM COR. ST.
HWY. 250 FT. S. OF HAMILTON ST. 40' E. OF
E. OF CANNERY ST. IN THE S.W. COR. OF OIL
PUMP BASE.

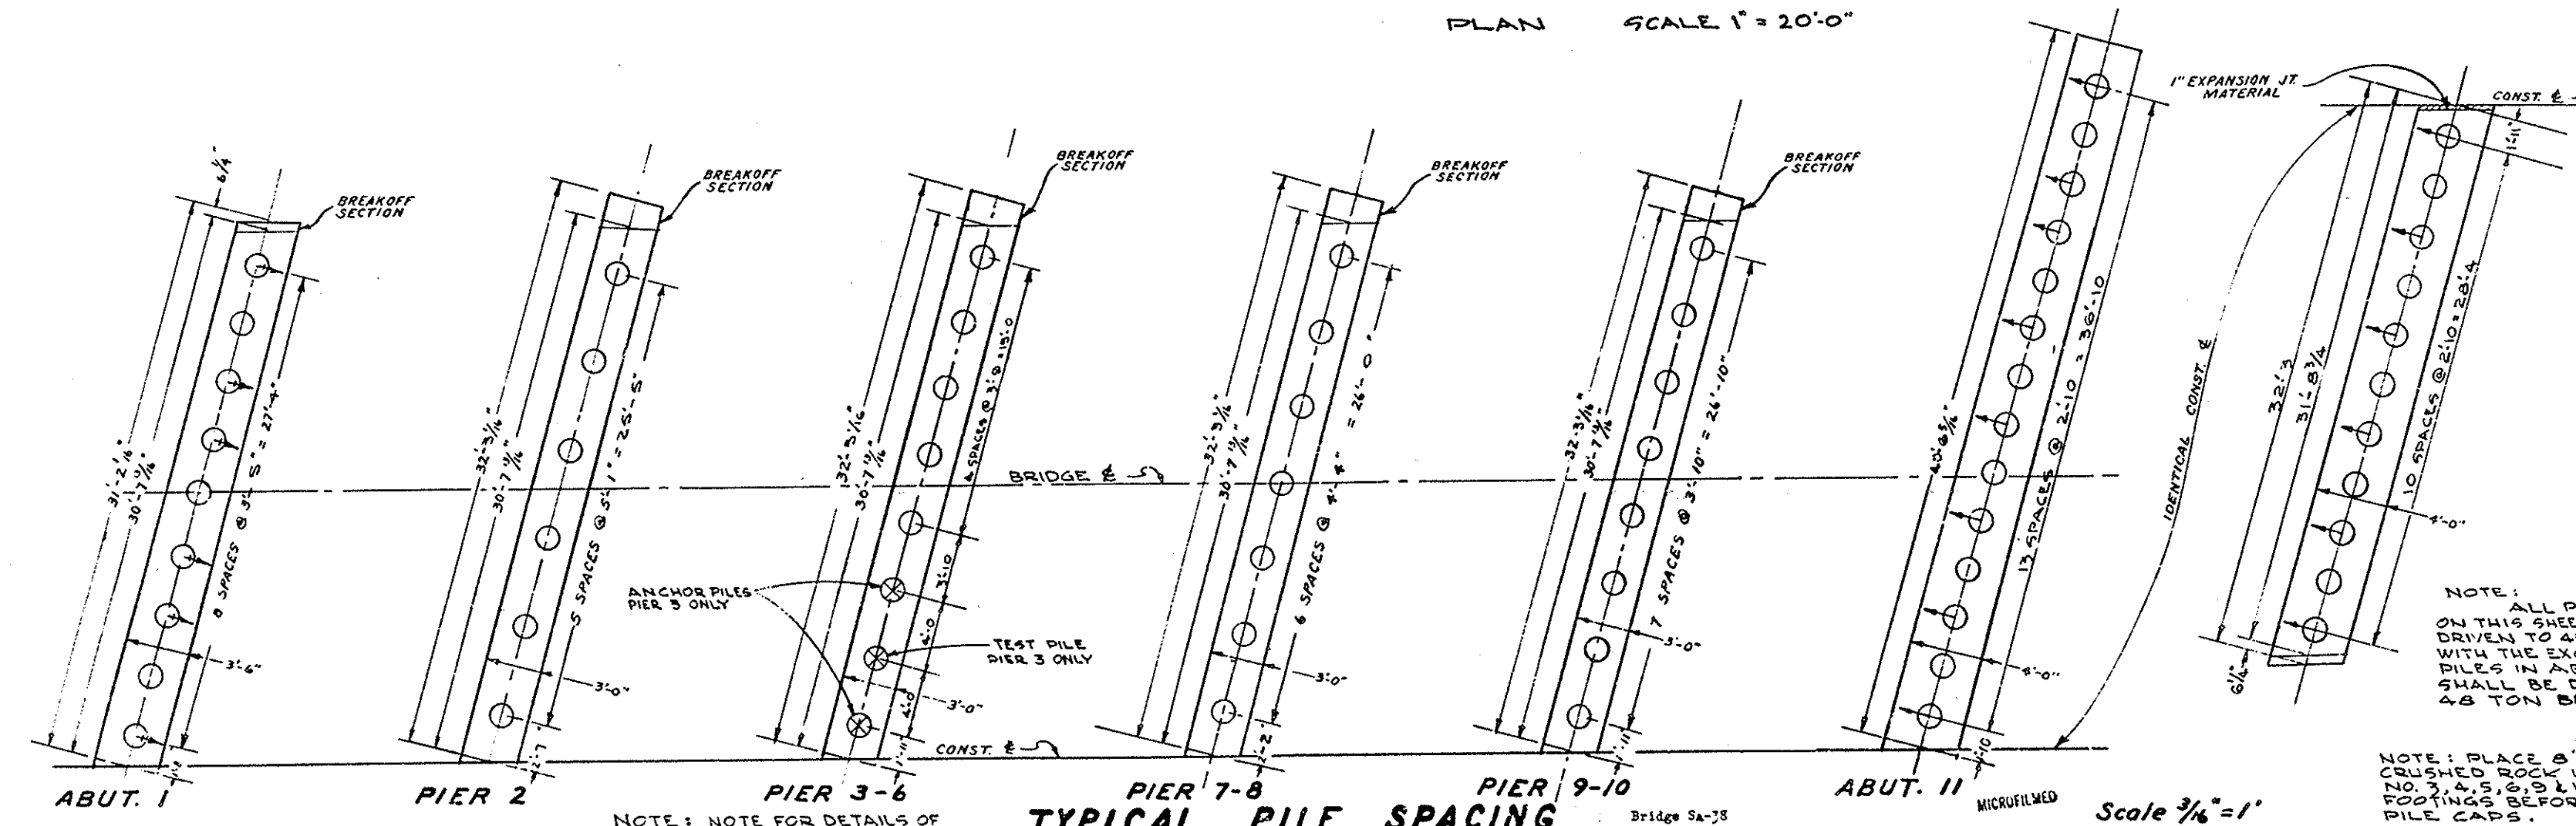

	Sta. @ Const. E.	Bottom Of Footing Elev.	Piles	Pile Cutoff Elev.	Min. Pile Tip Elev.
ABUT. I	14+05.76	+17.00	3 Vert.	+18.00	-32.00
			6 Batter	+18.00	-32.93
PIER 2	14+39.76	+9.00	6 Vert.	+10.00	-32.50
PIER 3	14+07.01	-0.50	8 Vert.	+0.50	-32.00
PIER 4	15+34.26	-0.50	8 Vert.	+0.50	-42.00
PIER 5	15+81.51	-0.50	8 Vert.	+0.50	-42.00
PIER 6	16+28.76	-0.50	8 Vert.	+0.50	-42.00
PIER 7	16+76.01	+15.00	7 Vert.	+16.00	-41.50
PIER 8	17+23.26	+11.00	7 Vert.	+12.00	-30.50
PIER 9	17+70.51	-2.30	8 Vert.	-1.50	-31.50
PIER 10	18+17.76	-2.30	8 Vert.	-1.50	-31.50
ABUT. II	18+51.76	+7.50	8 Batter	+8.50	-32.73
			5 Vert.	+8.50	-31.50
			6 Batter	+8.50	-32.73
S.E. 1/4 SEC. 9 ABUT. II	18+51.76	+7.50	5 Vert.	+8.50	-31.50
			6 Batter	+8.50	-32.73

NOTE: PILE SHOWN THUS ⊕ SIGNIFIES BATTER 1:4 AND DIRECTION OF BATTER

ORANGE COUNTY HIGHWAY DEPARTMENT

HAMILTON ST. BRIDGE

S.A.-38

FOUNDATION PLAN

SCALE: AS SHOWN SHEET NO. 38

Bridge Sa-38
Hamilton St.
Sheet 5 of 18
7/22/57 Scale As Shown
Liren

MICROFILMED
JUL 6 1960

Hamilton - Victoria Bridge
1959
As built