
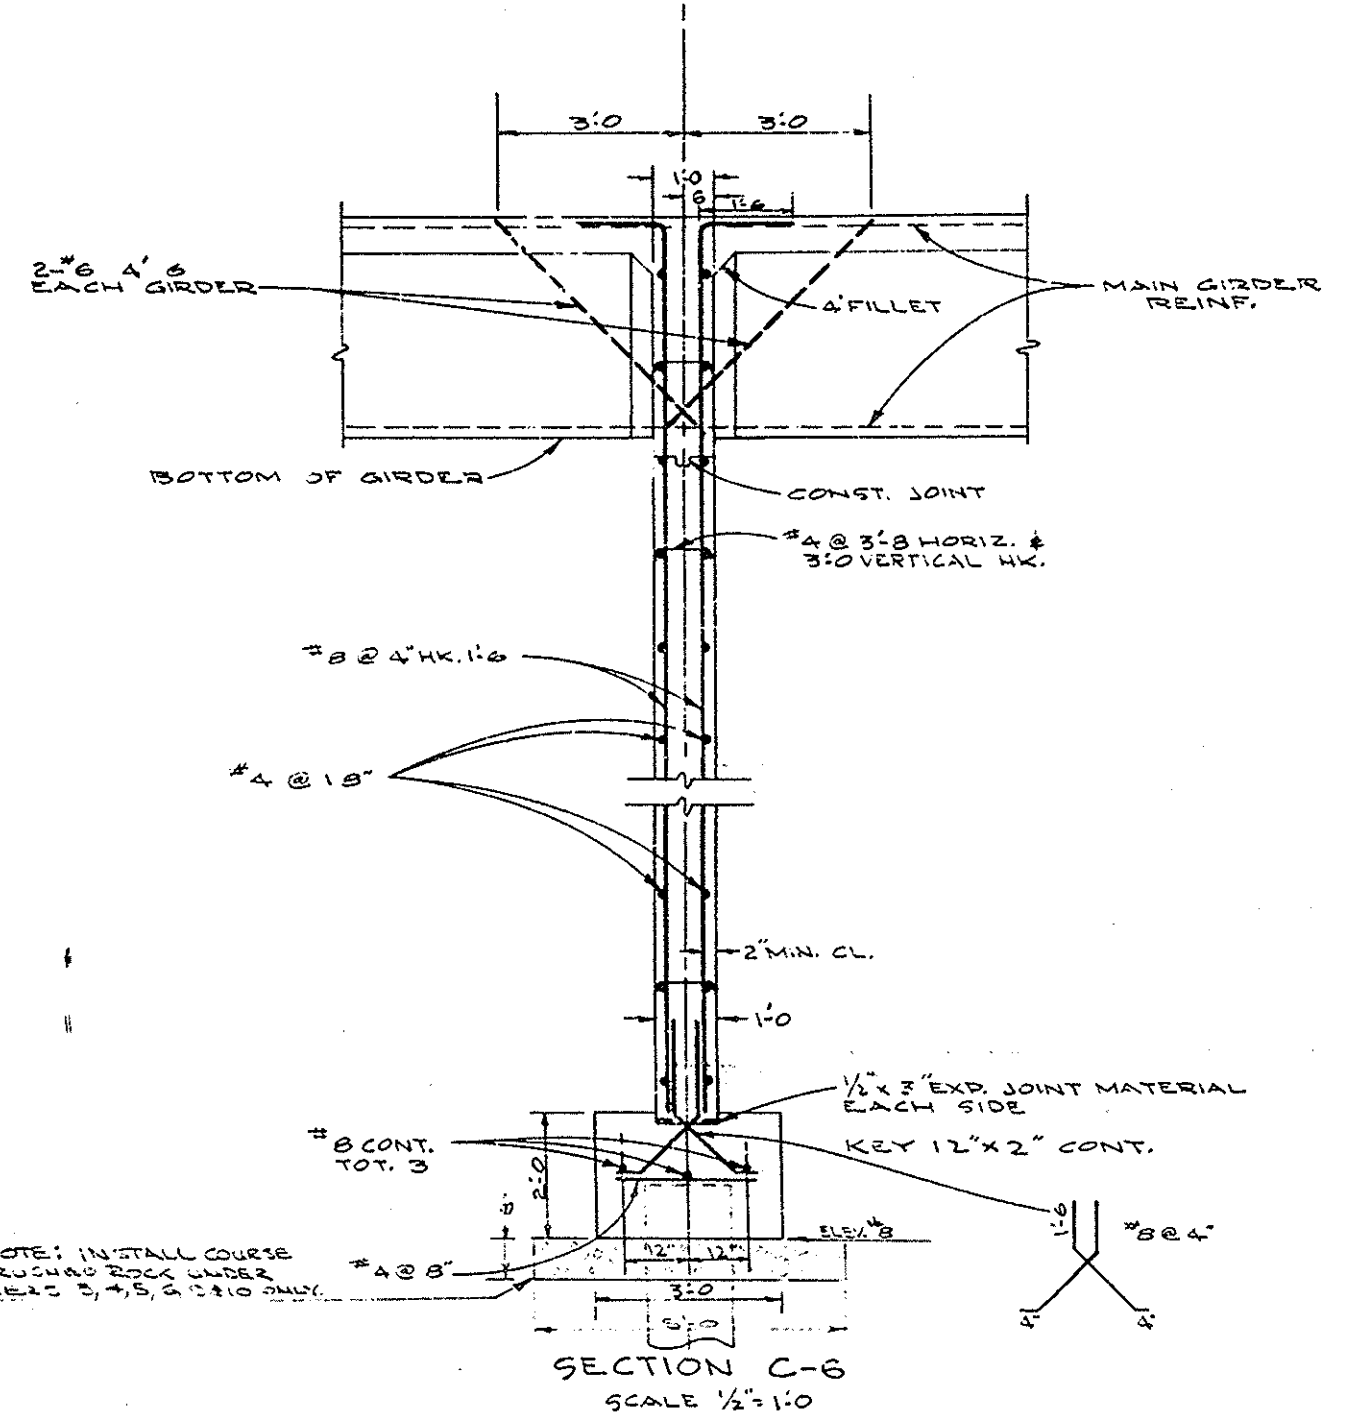
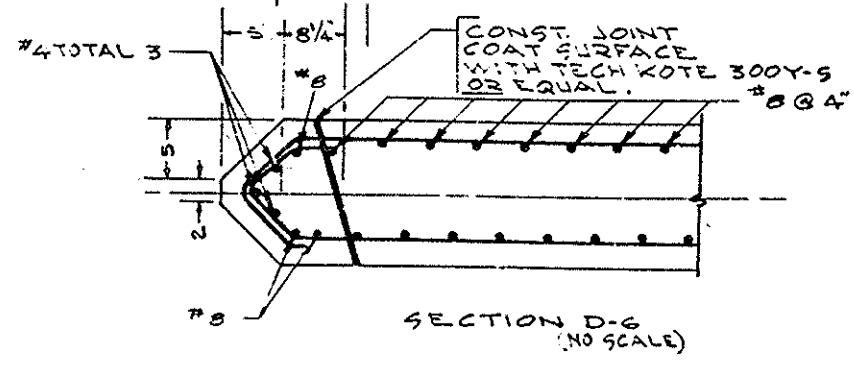
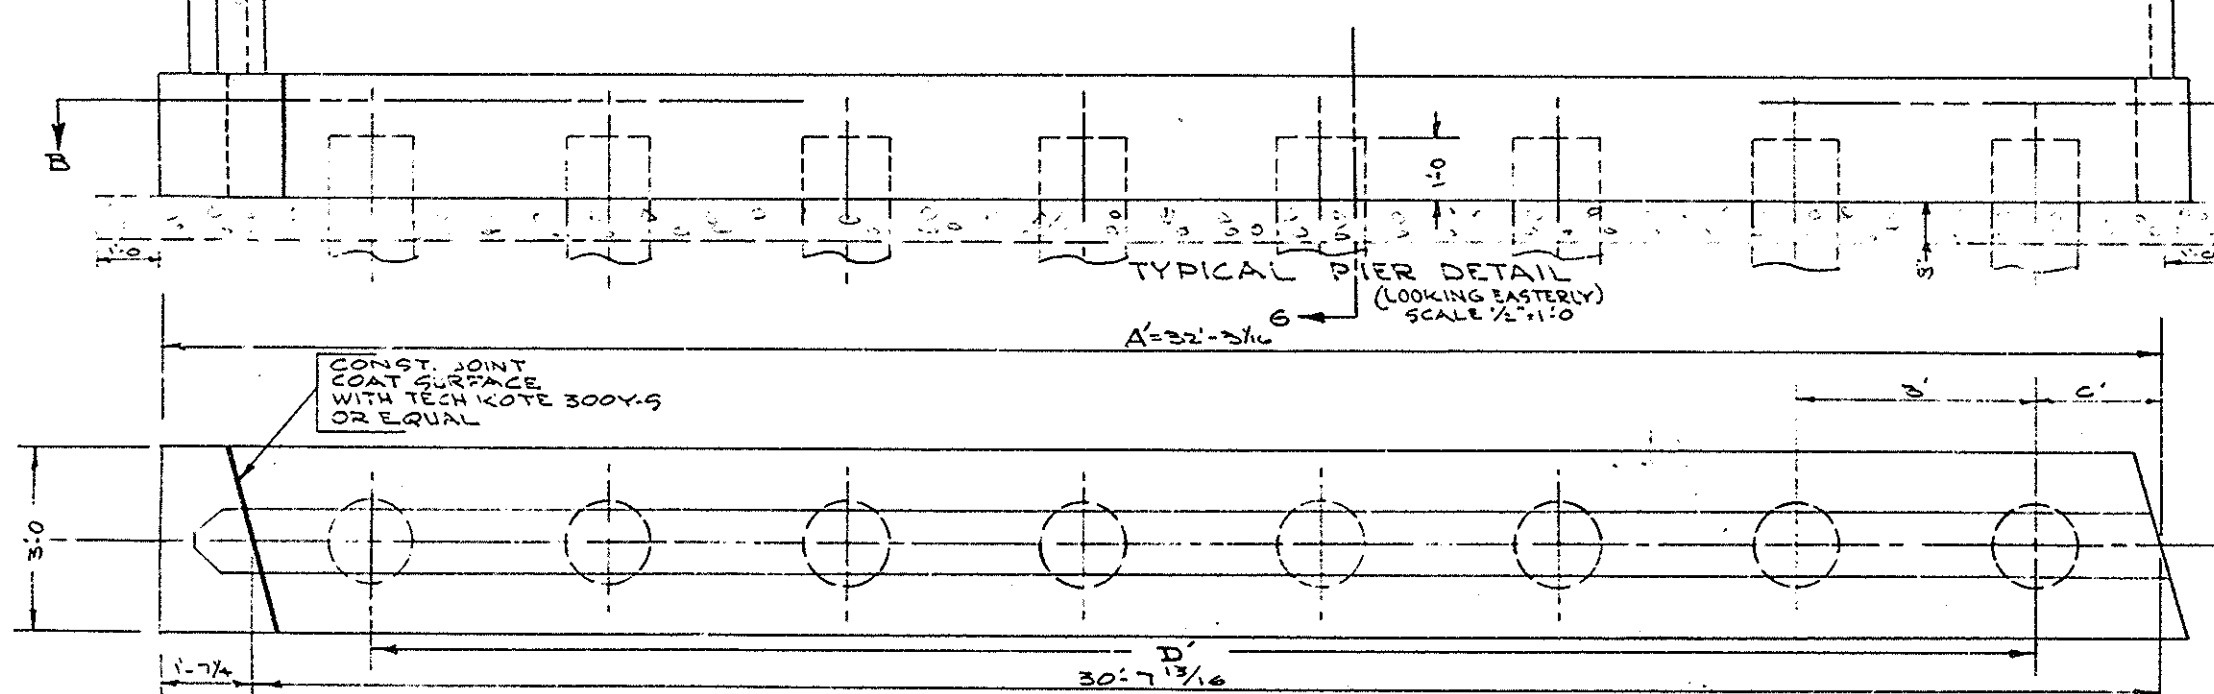
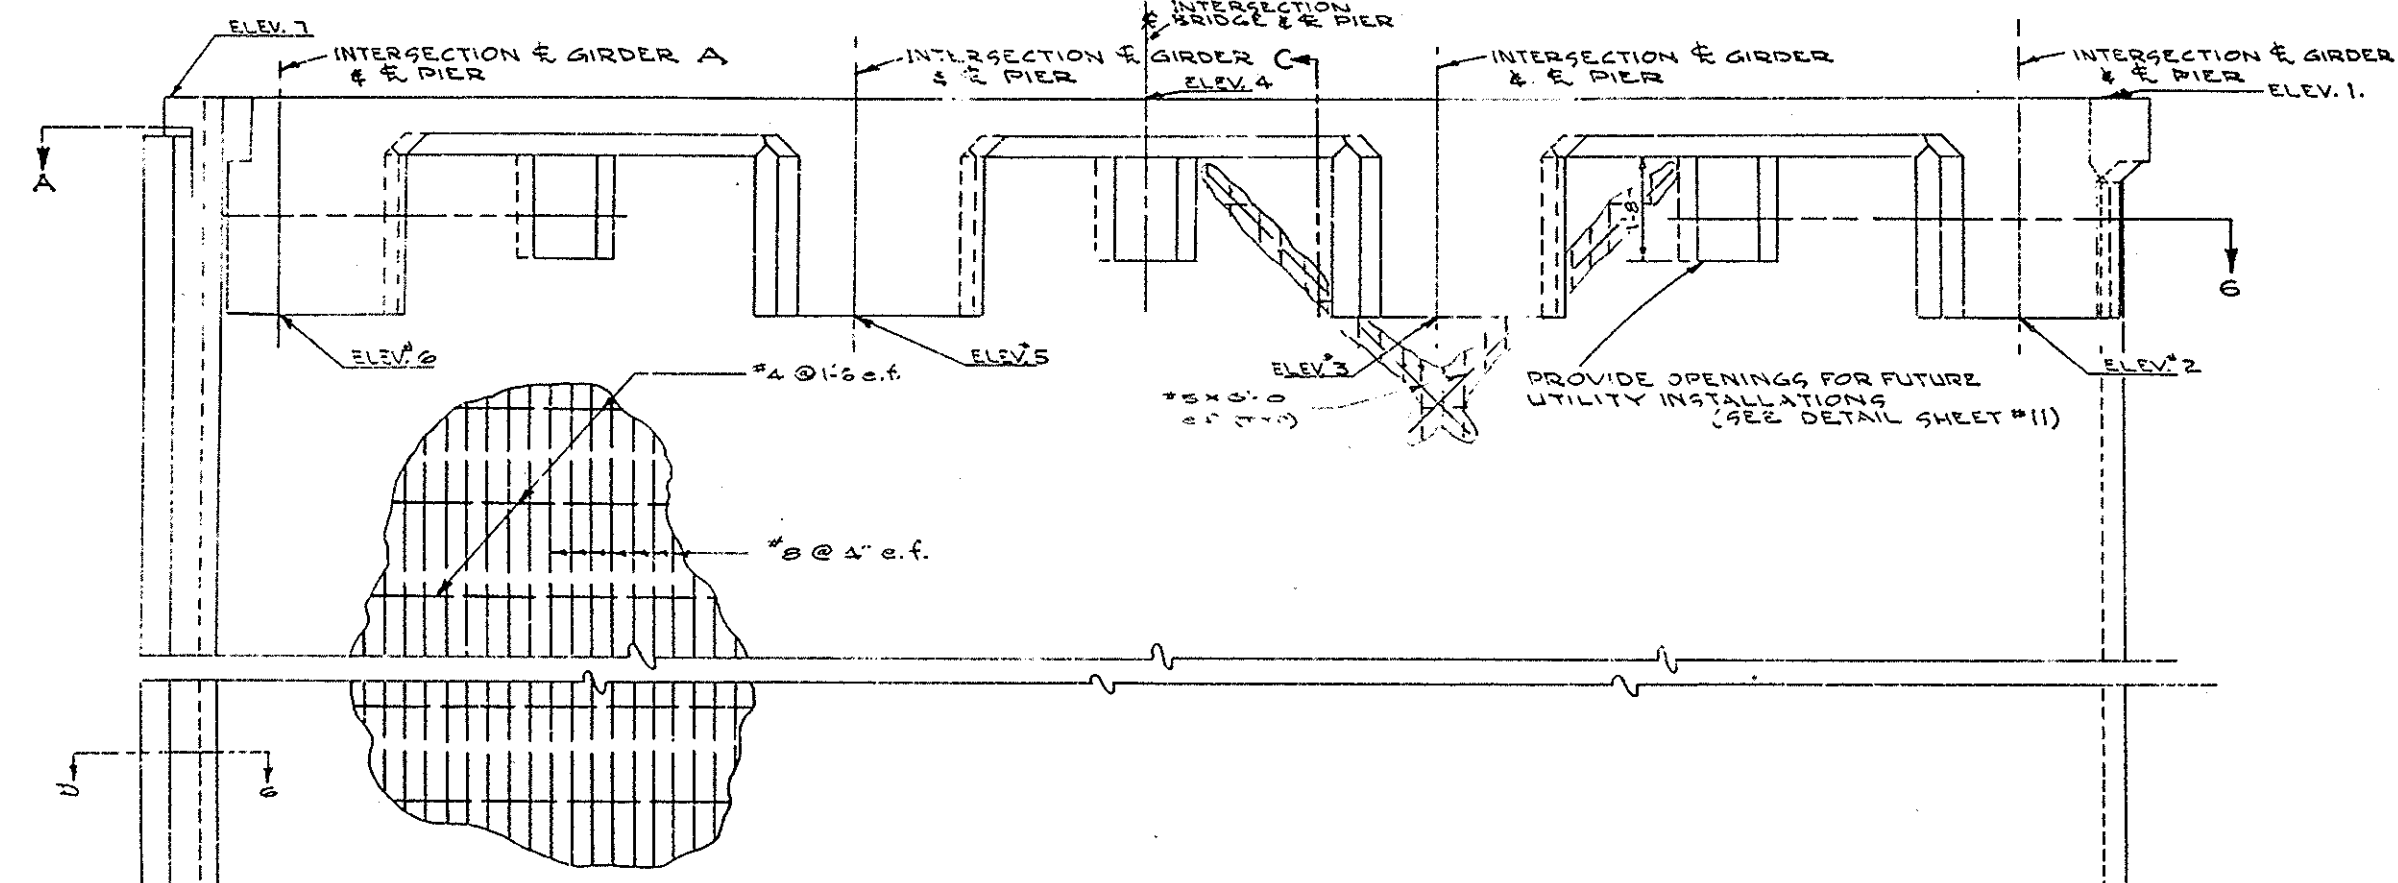


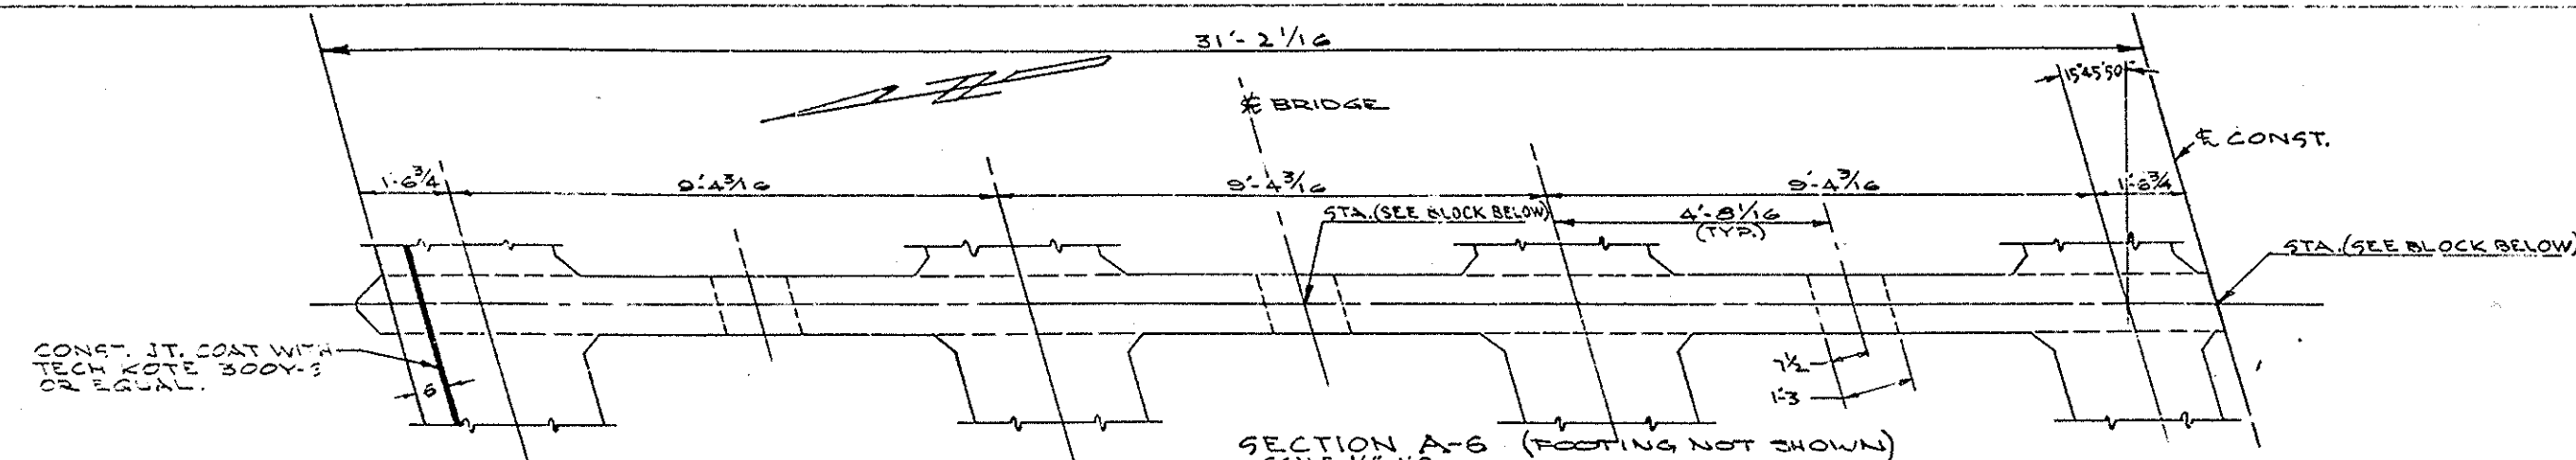

PIER	STA. @ BRIDGE	STA. @ CONST. E	ELEV. 1	ELEV. 2	ELEV. 3	ELEV. 4	ELEV. 5	ELEV. 6	ELEV. 7	ELEV. 8	NO. PILES	A'	B'	C'	D'
2	14+43.39	14+39.76	26.95	21.14	21.00	24.88	21.36	21.32	24.82	9.000	6	32.26	5'-1"	2'-7"	25'-5"
3	14+51.24	14+47.01	26.60	23.09	23.04	26.51	22.98	22.92	26.42	-0.500	8	32.26	3'-10"	1'-11"	26'-10"
4	15+38.49	15+34.26	21.96	24.44	24.372	27.34	24.30	24.23	27.72	-0.500	8	32.26	3'-10"	1'-11"	26'-10"
5	15+85.74	15+81.51	23.01	25.50	25.413	28.07	25.33	25.24	28.72	-0.500	8	32.26	3'-10"	1'-11"	26'-10"
6	16+32.99	16+28.76	29.78	26.26	26.16	29.61	24.06	23.95	29.44	-0.500	8	32.26	3'-10"	1'-11"	26'-10"
7	16+80.24	16+76.01	30.25	26.73	26.68	30.05	24.49	24.37	29.85	15.000	7	32.26	4'-4"	3'-2"	26'-0"
8	17+27.69	17+23.46	30.43	26.90	26.774	30.21	26.84	26.51	29.99	11.000	7	32.26	4'-4"	2'-2"	26'-0"
9	17+74.74	17+70.51	30.25	27.02	26.87	30.30	26.74	26.51	30.09	-2.500	4	32.26	3'-10"	1'-11"	26'-10"
10	18+21.99	18+17.76	30.62	27.09	26.96	30.42	26.83	26.70	30.18	-2.500	6	32.26	3'-10"	1'-11"	26'-10"

NOTE: FOR TEST PILE LOCATION AT PIER 3 SEE SHEET #2

ORANGE COUNTY HIGHWAY DEPARTMENT

HAMILTON ST. BRIDGE

1 A - 38

PIER DETAIL

ALL AS SHOWN

MICROFILMED

JUL 6 1960

Bridge SA-38

Hamilton St.

Sheet 8 of 18

REV 3/5/57 Scale As Shown

Pencil Yellow