


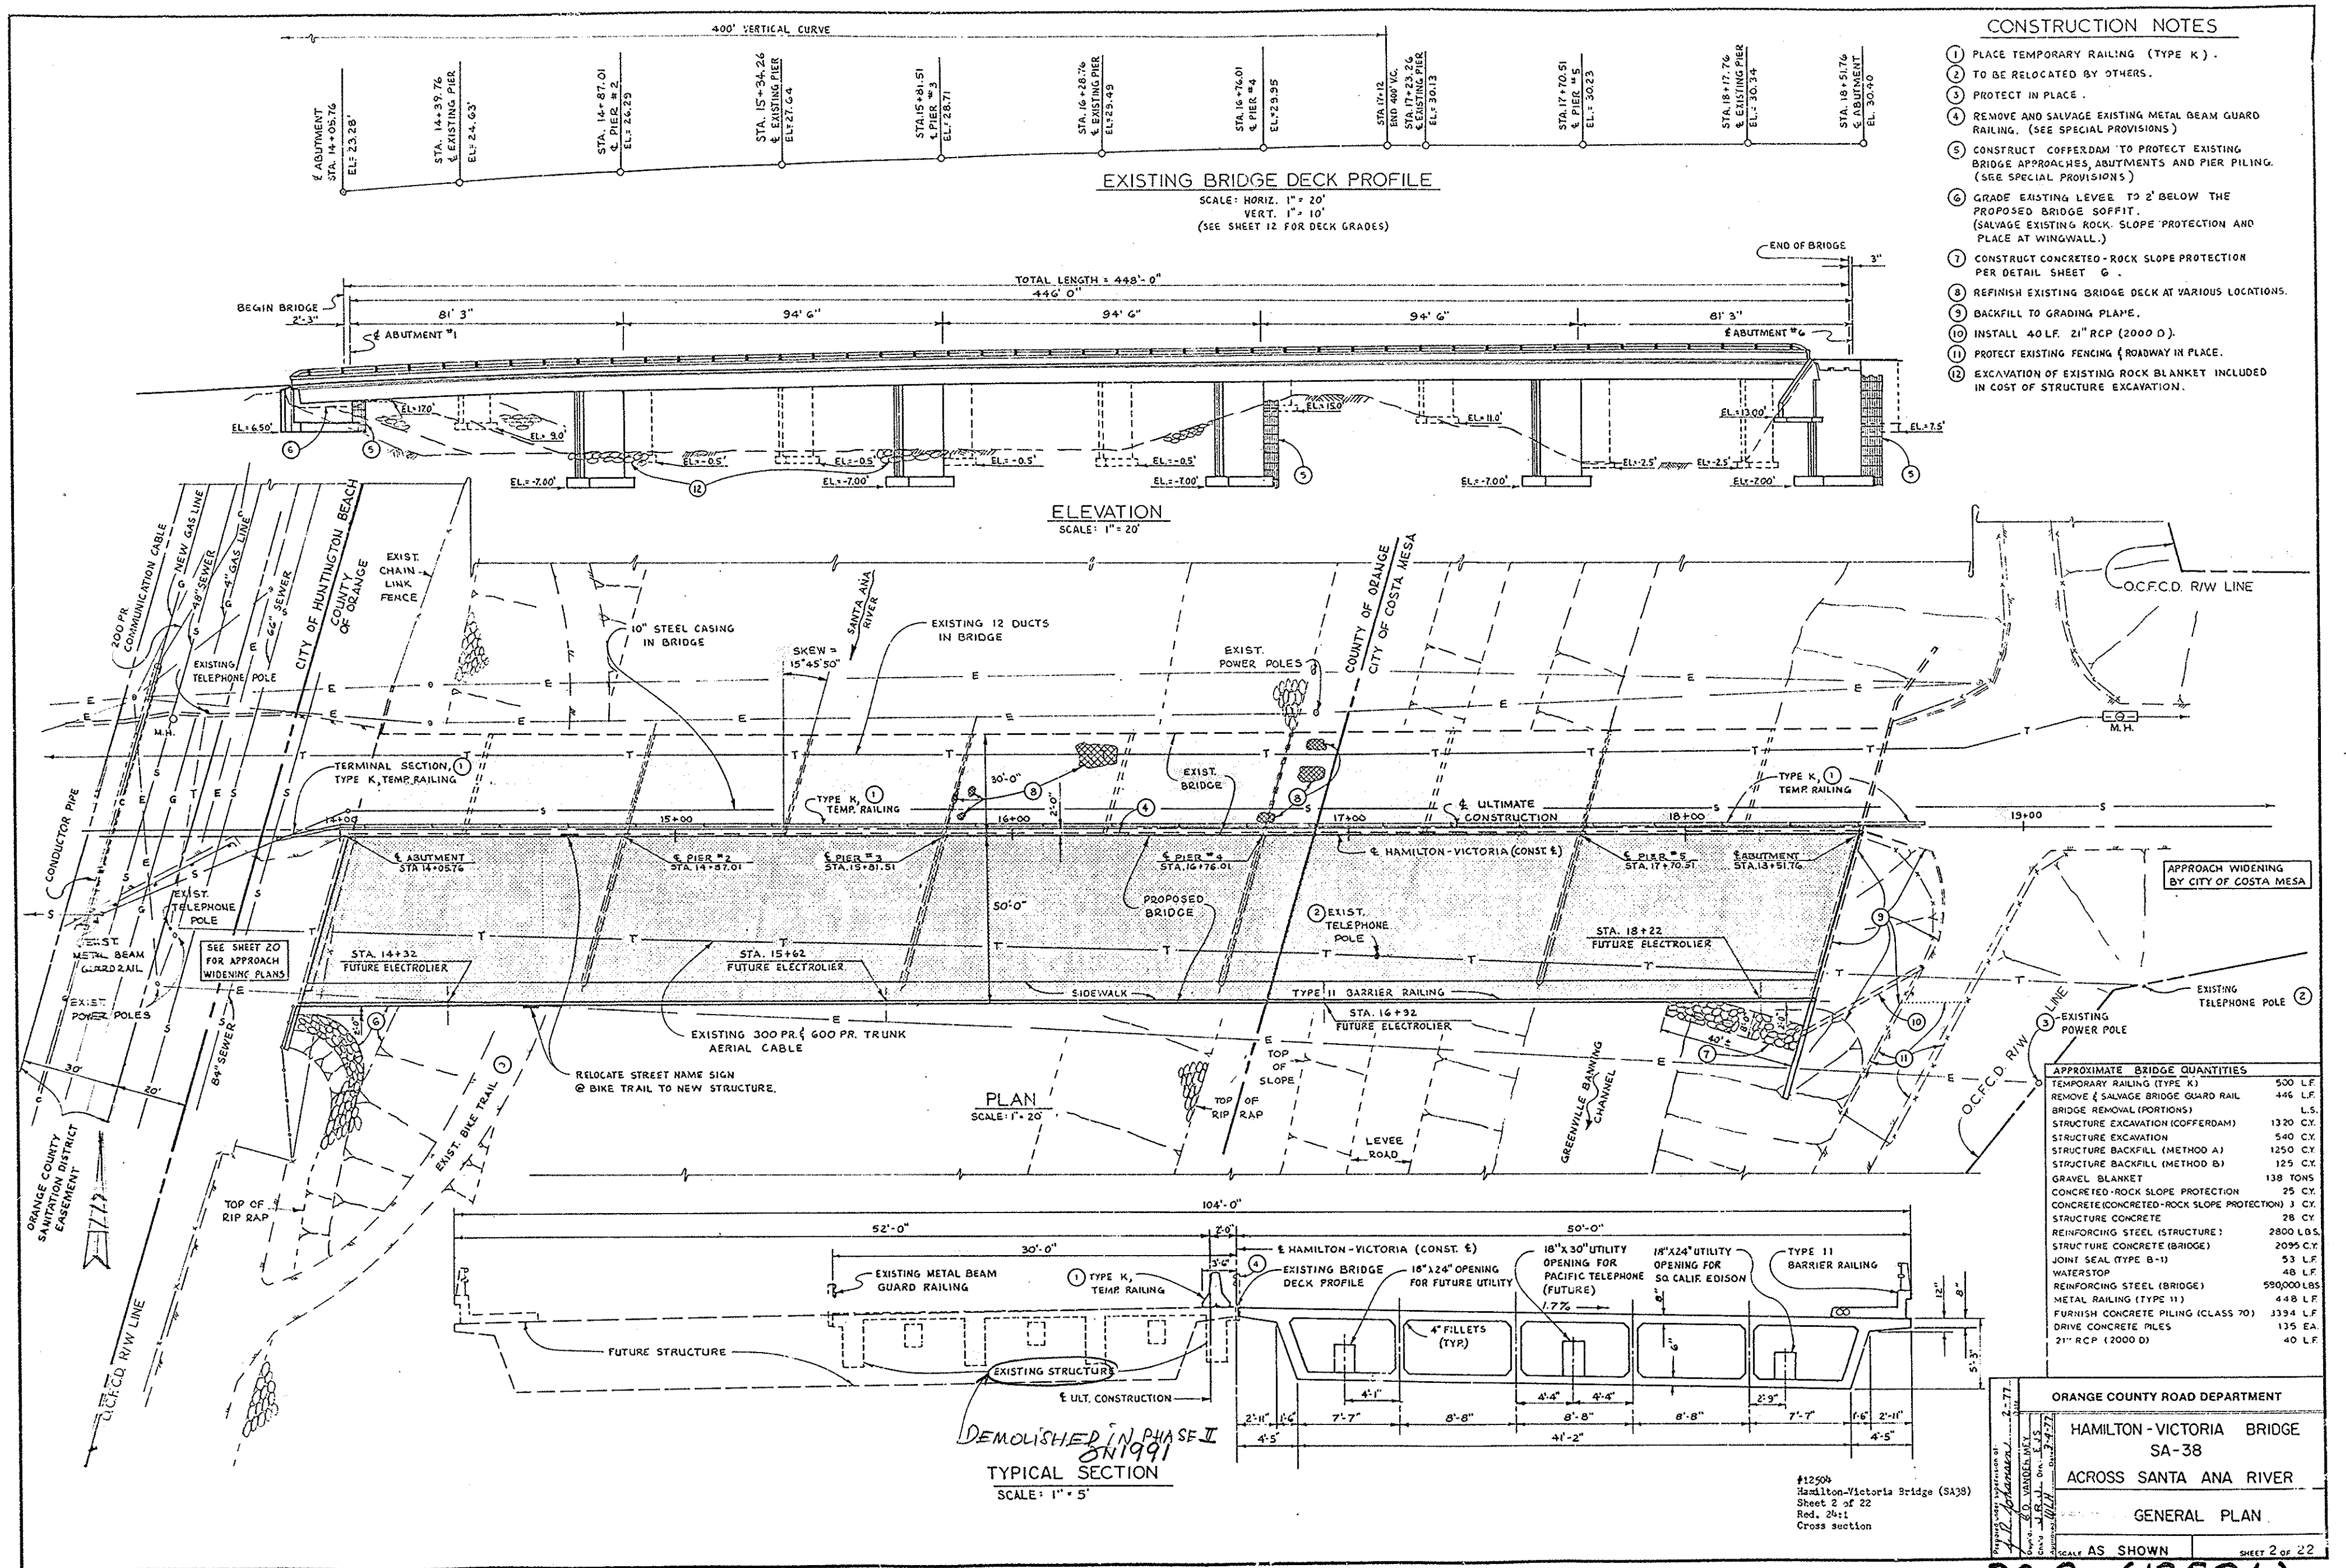

DR 8 (12504)