

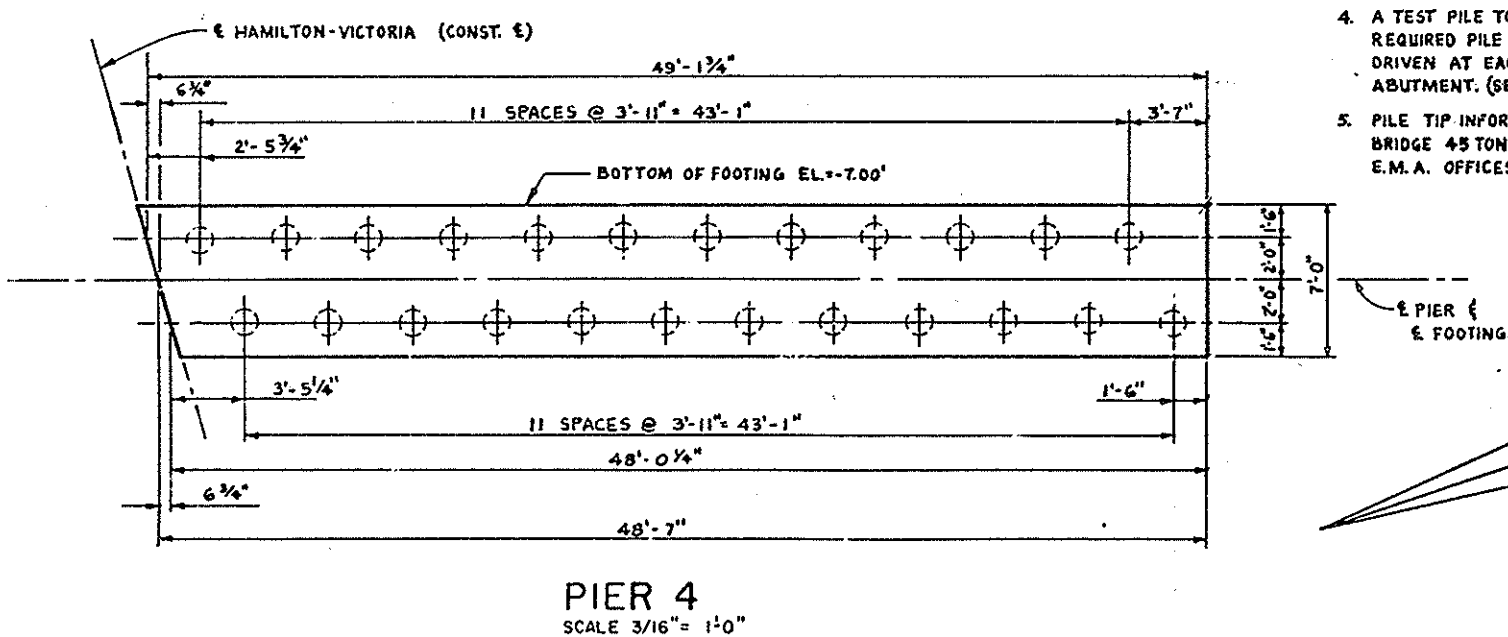
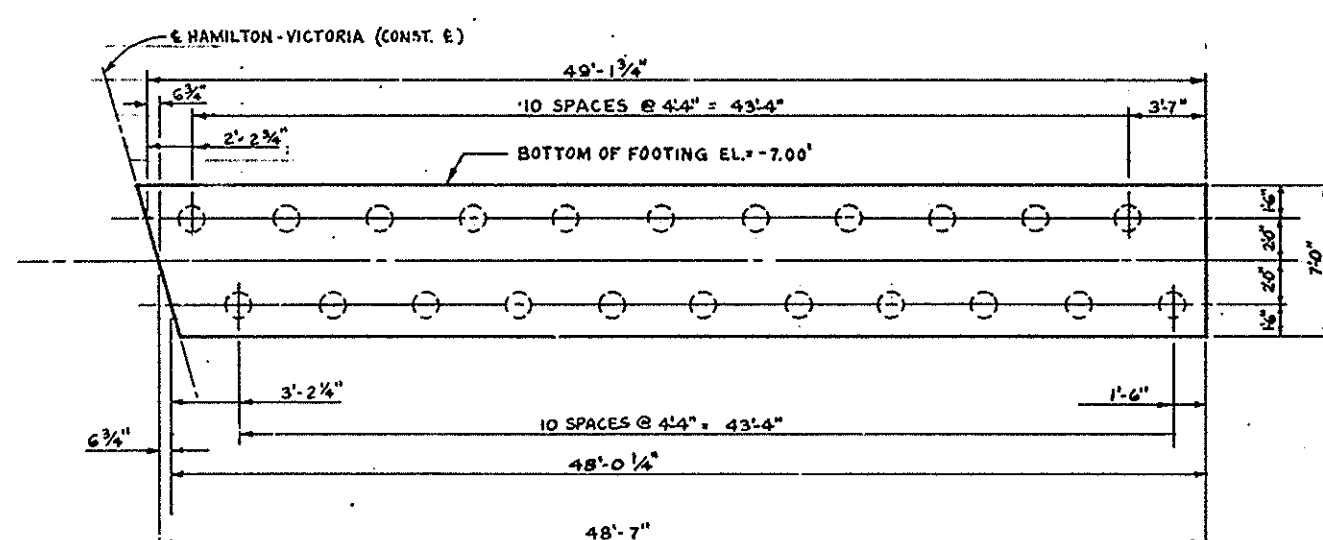
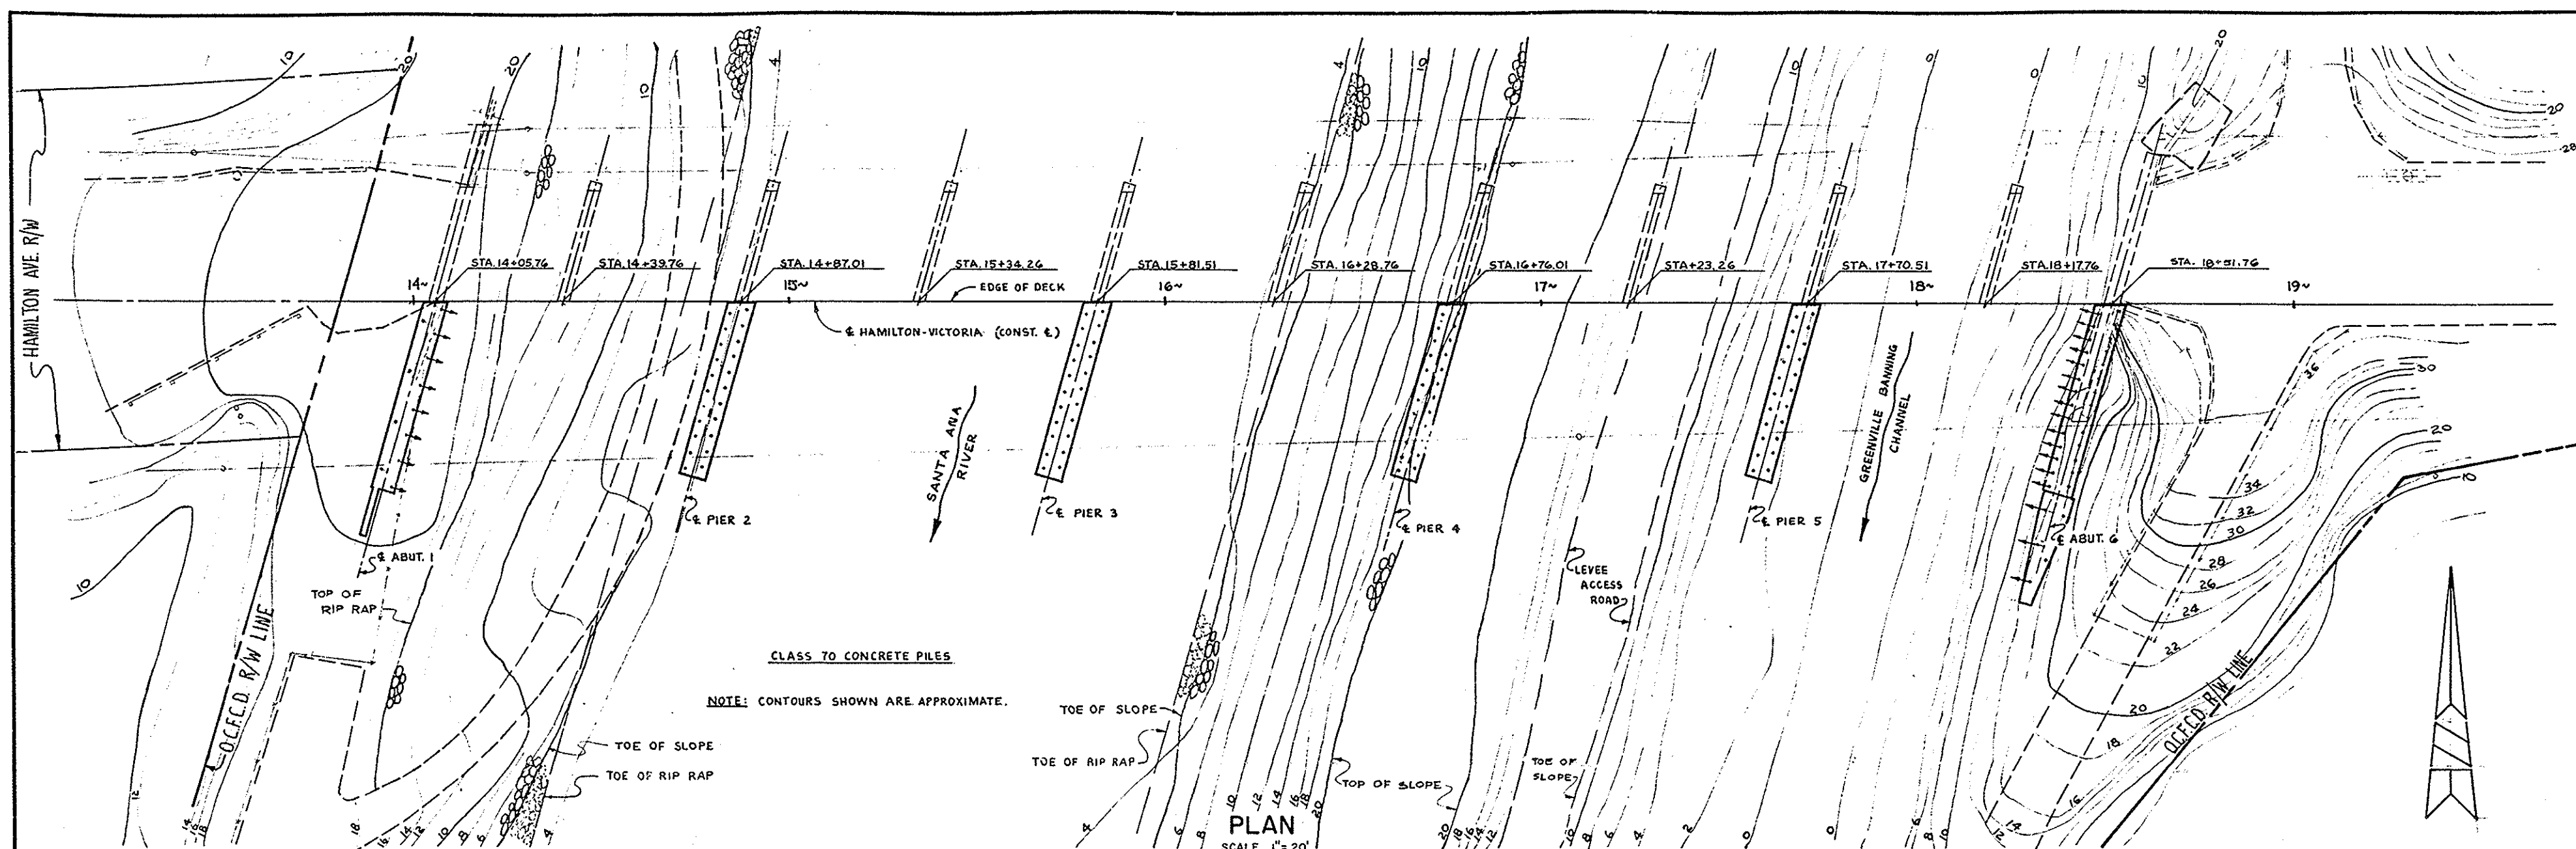


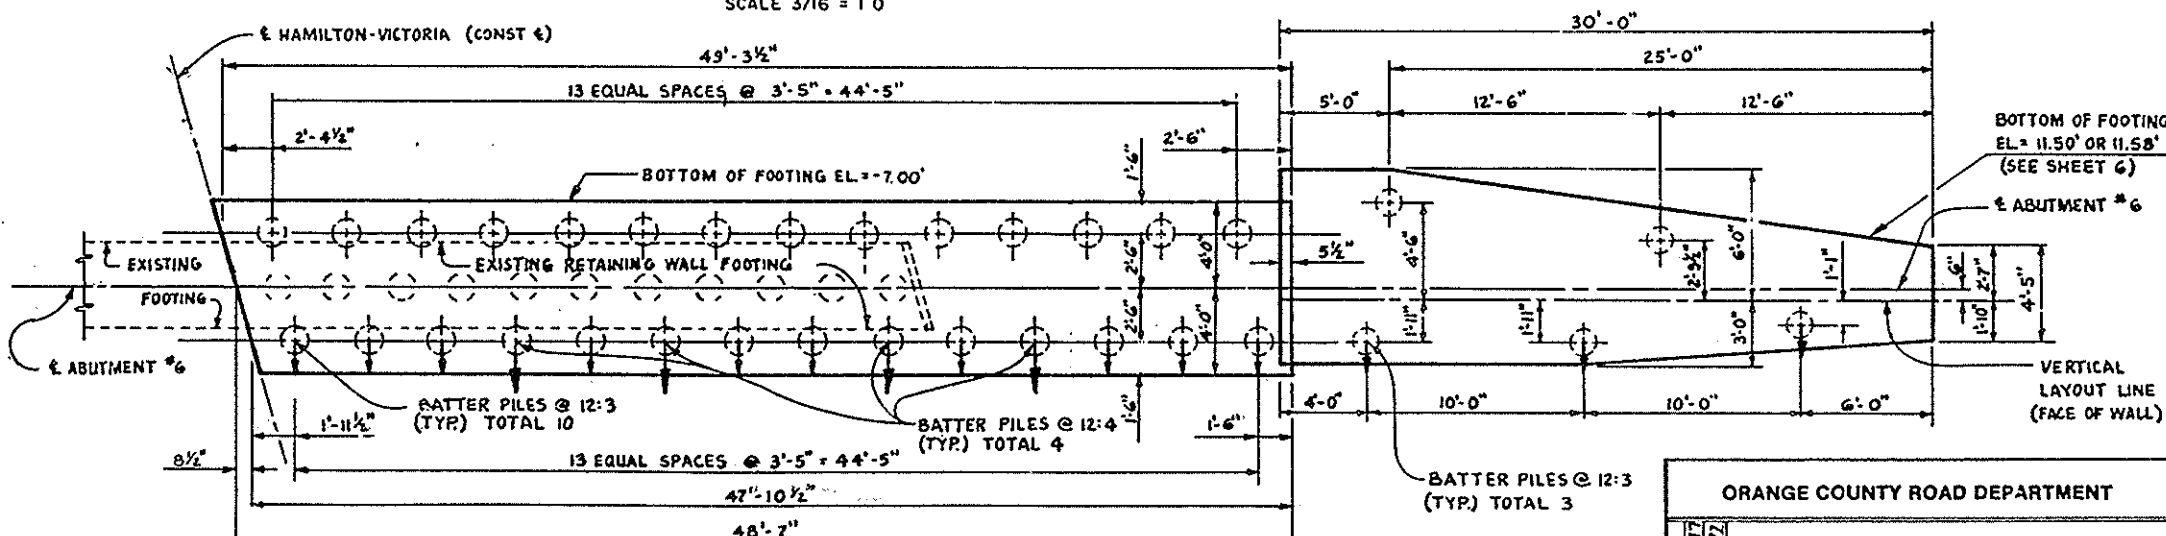

- NOTES:
1. CLASS TO CONCRETE PILES.
 2. MINIMUM PILE PENETRATION SHALL BE -30.00 FEET.
 3. IT IS ANTICIPATED THAT AIDS MAY BE REQUIRED IN ORDER TO ATTAIN MINIMUM PENETRATION. (SEE SPECIAL PROVISIONS)
 4. A TEST PILE TO DETERMINE REQUIRED PILE LENGTH WILL BE DRIVEN AT EACH PIER AND ABUTMENT. (SEE SPECIAL PROVISIONS)
 5. PILE TIP INFORMATION FOR THE EXISTING BRIDGE 45 TON PILES IS AVAILABLE AT E.M.A. OFFICES.

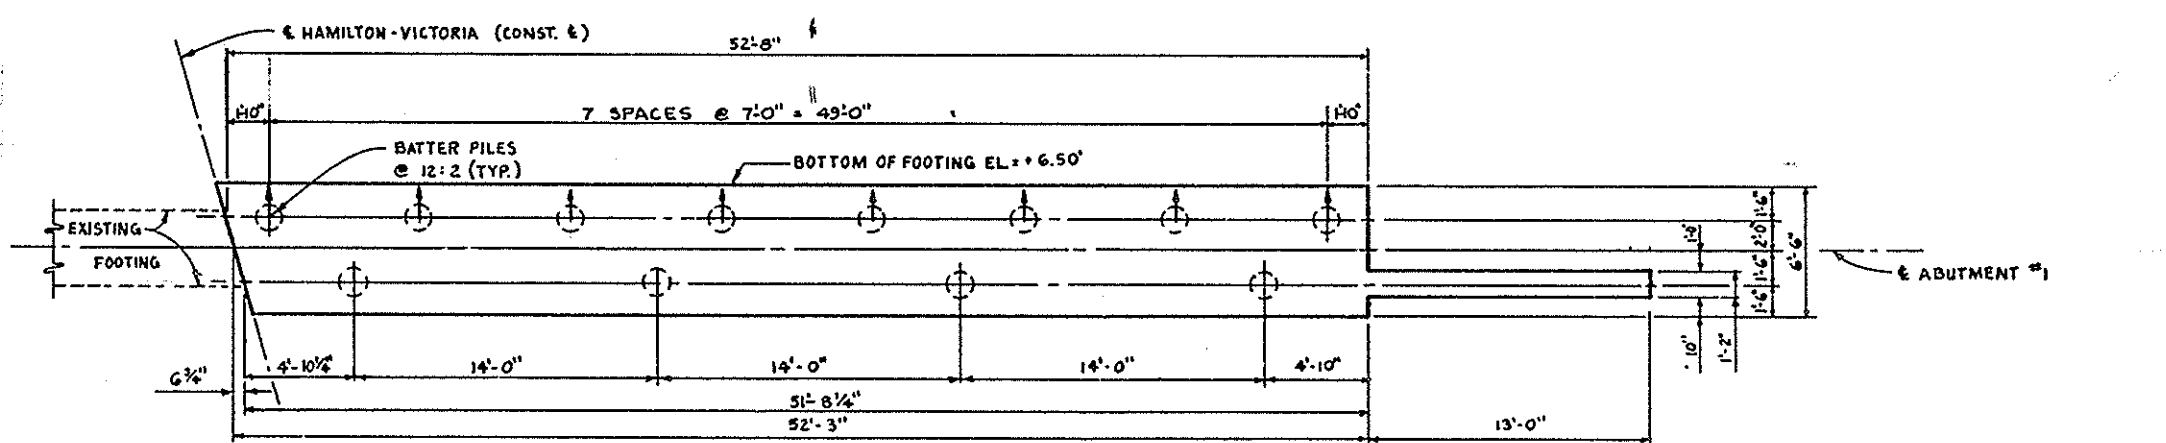

#12504
Hamilton-Victoria Bridge (SA38)
Sheet 3 of 22
Rev. 24:11
Cross section

ORANGE COUNTY ROAD DEPARTMENT	
HAMILTON - VICTORIA BRIDGE	SA-38
ACROSS SANTA ANA RIVER	
FOUNDATION PLAN	
AS SHOWN	SHEET 3 OF 22

DRB (12504)