

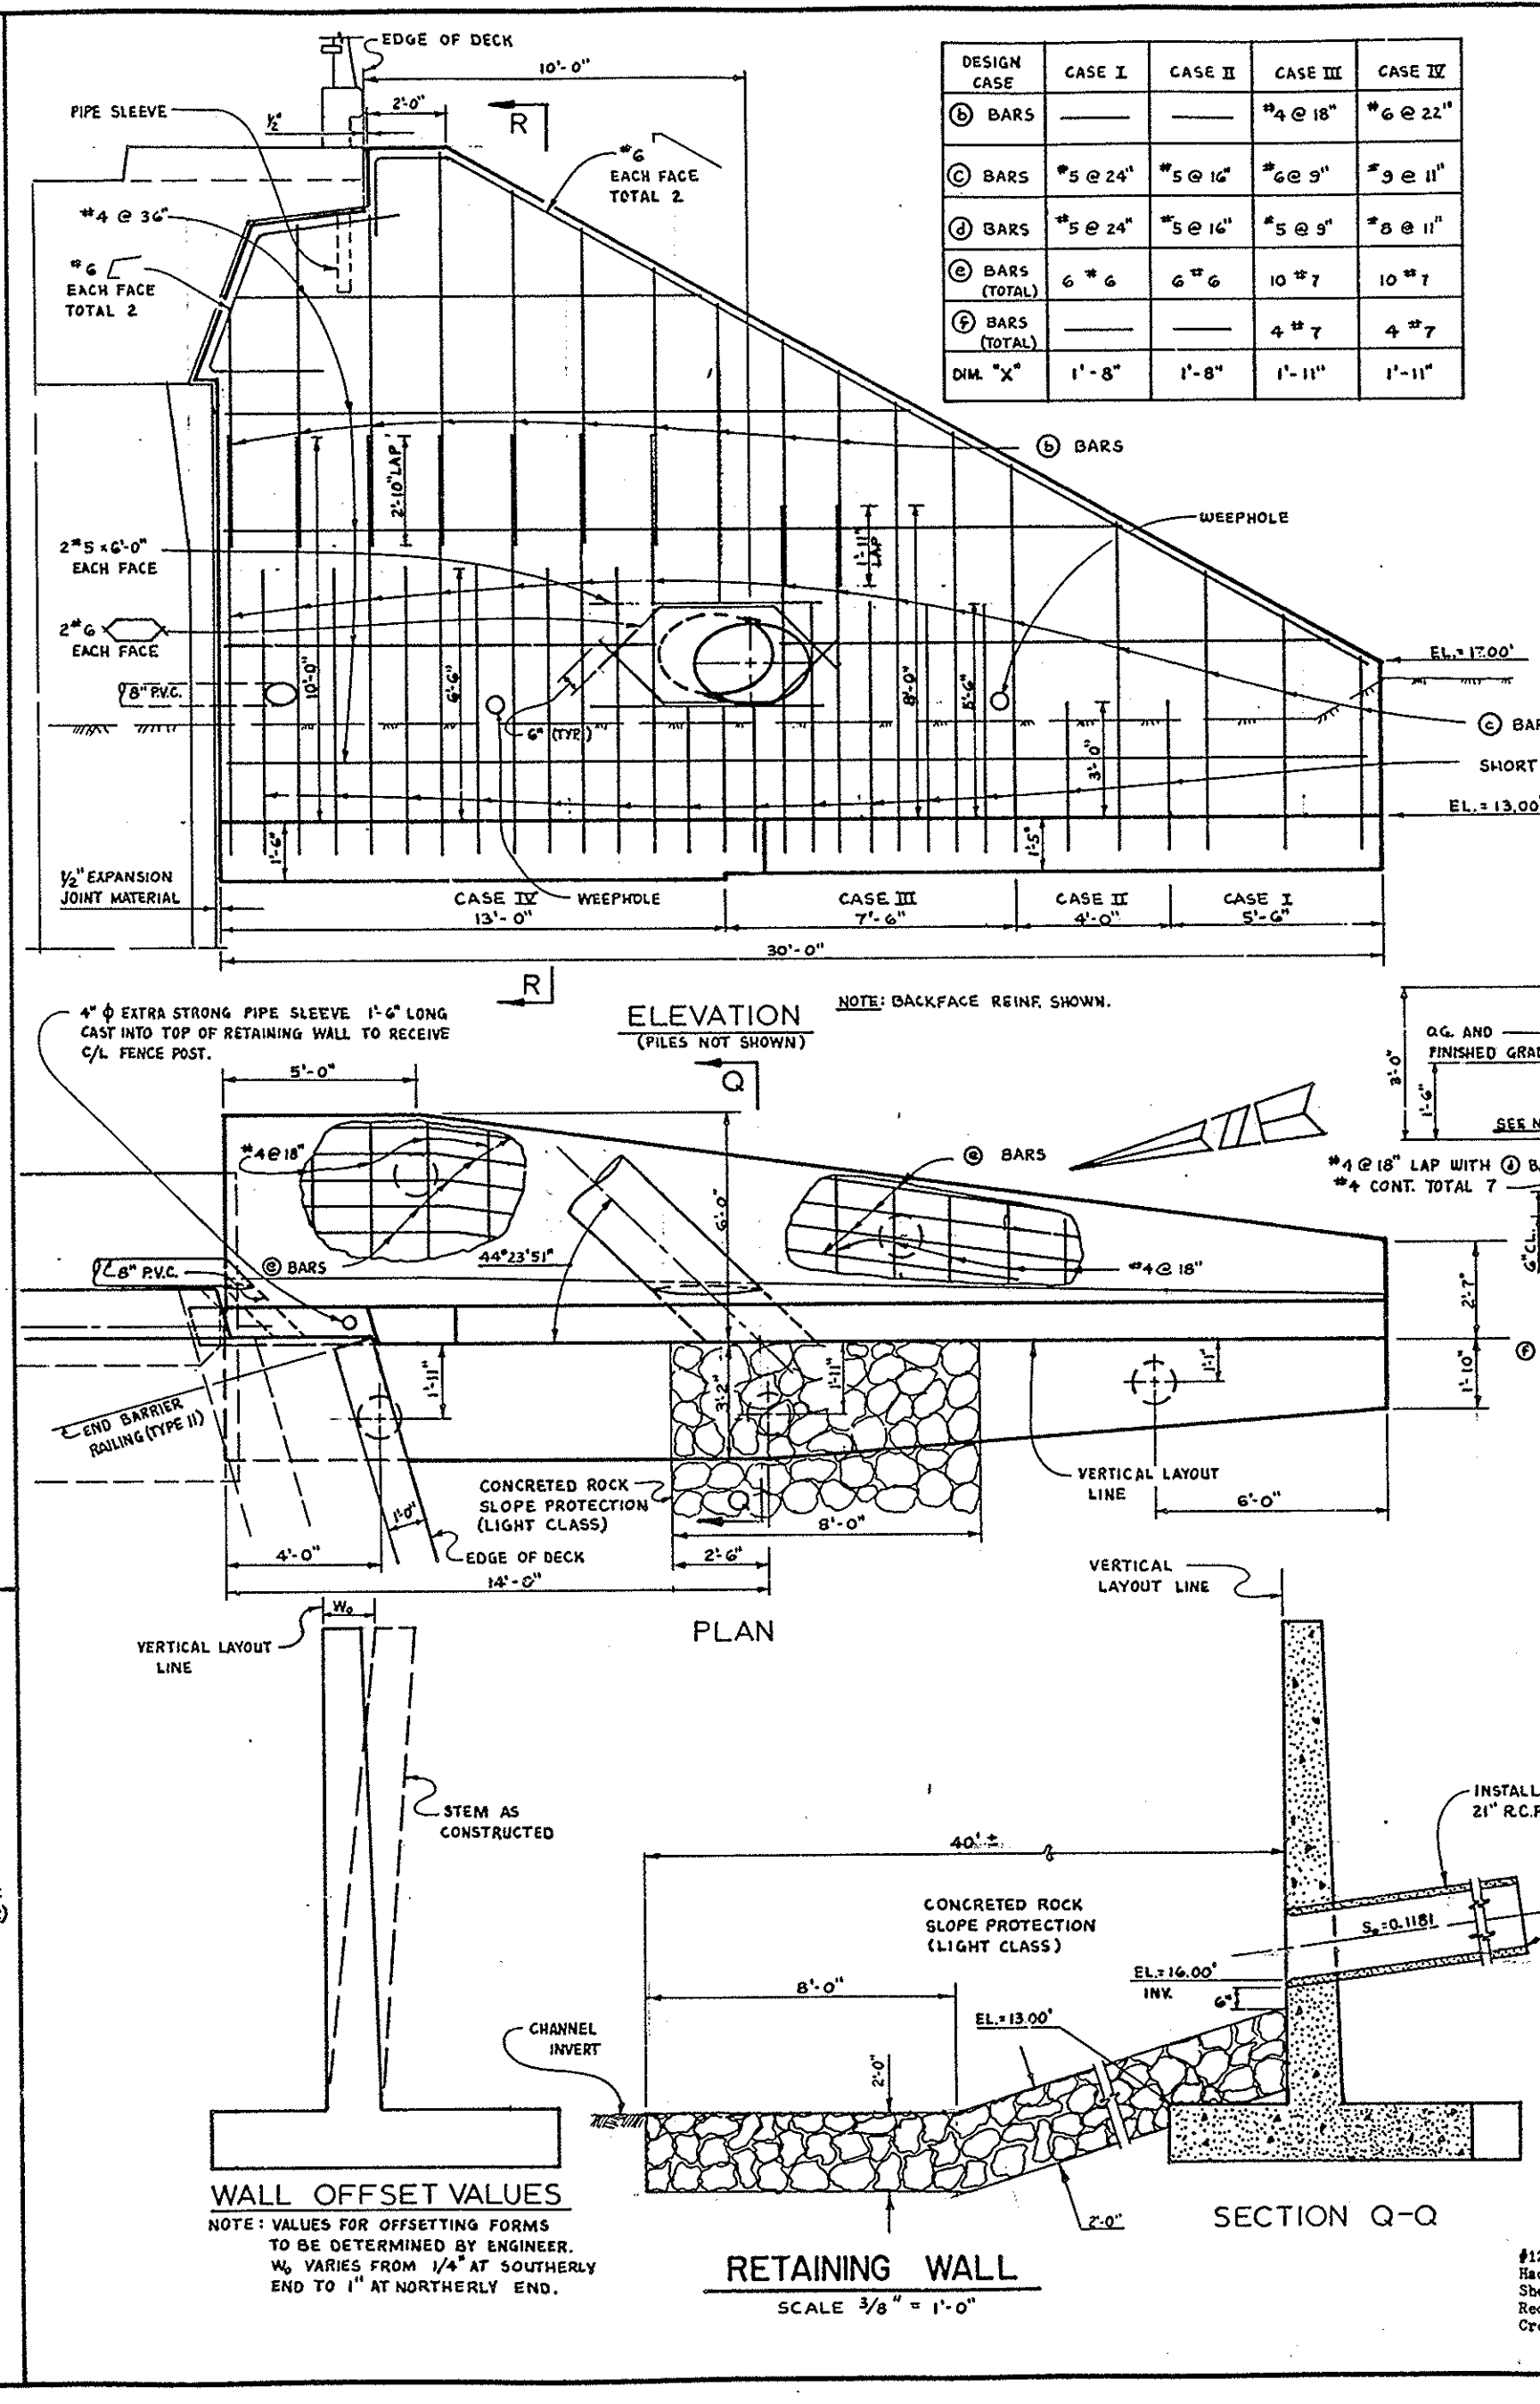


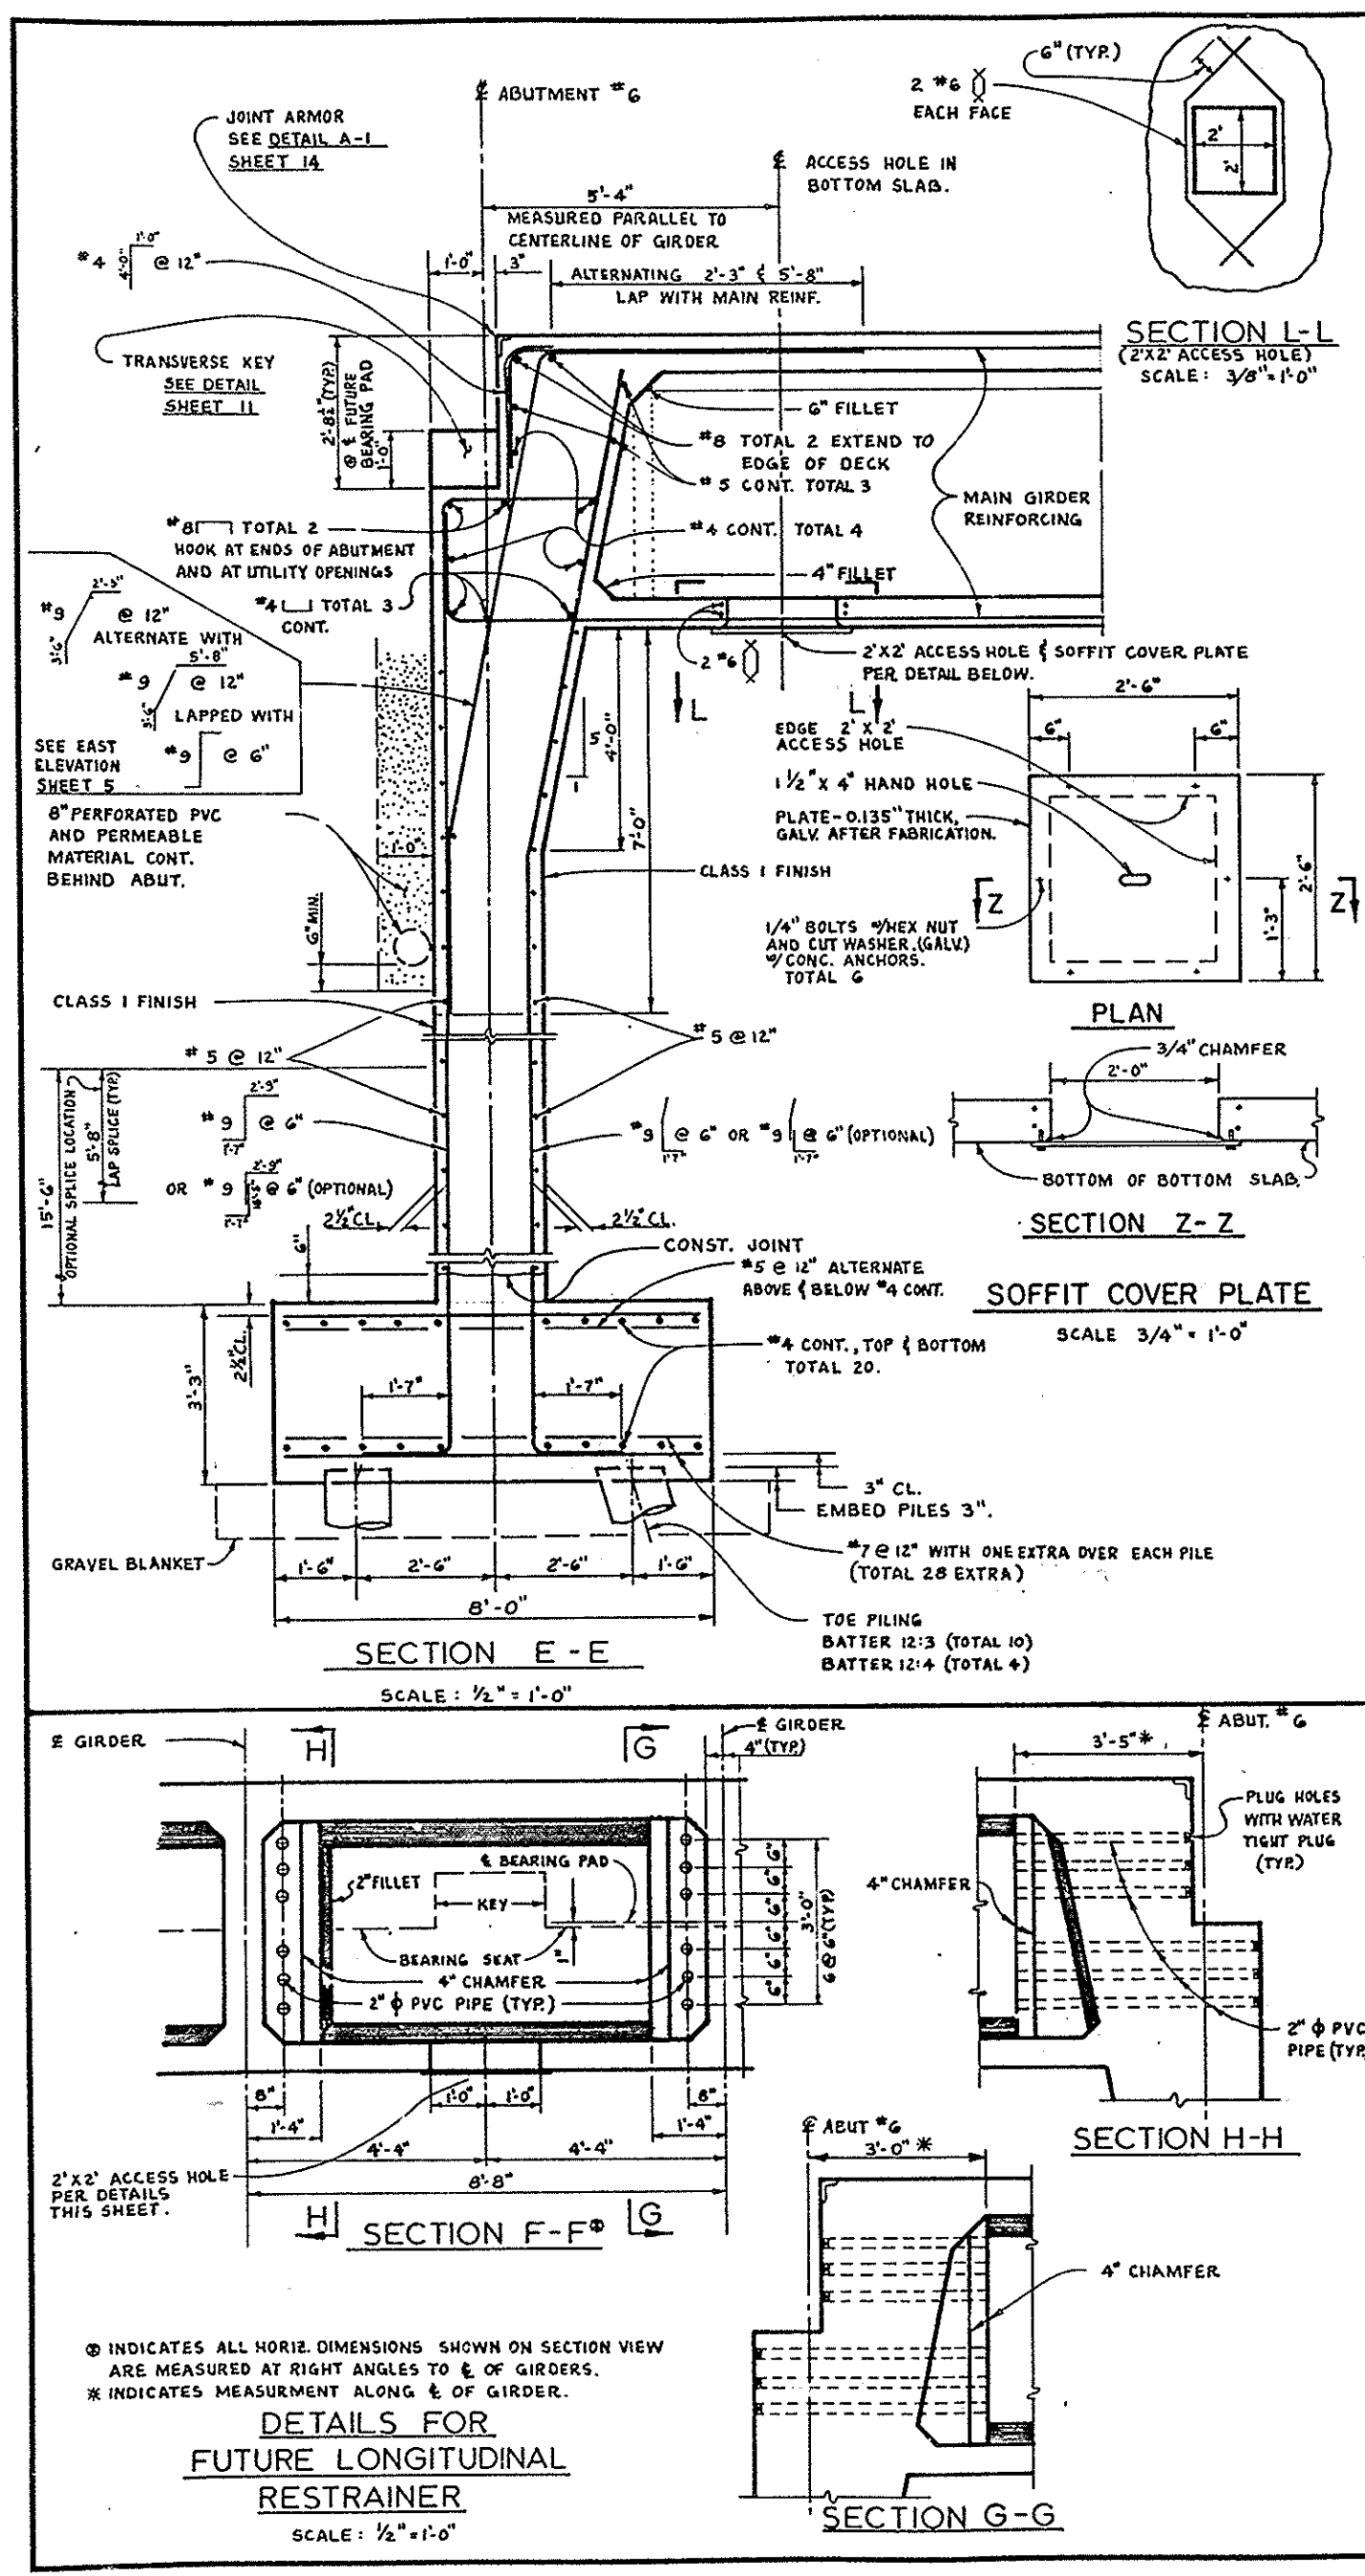

DESIGN CASE	CASE I	CASE II	CASE III	CASE IV
⊕ BARS	—	—	#4 @ 18"	#6 @ 22"
⊙ BARS	#5 @ 24"	#5 @ 16"	#6 @ 9"	#3 @ 11"
⊕ BARS	#5 @ 24"	#5 @ 16"	#5 @ 9"	#8 @ 11"
⊙ BARS (TOTAL)	6 #6	6 #6	10 #7	10 #7
⊕ BARS (TOTAL)	—	—	4 #7	4 #7
DIM. "X"	1'-8"	1'-8"	1'-11"	1'-11"

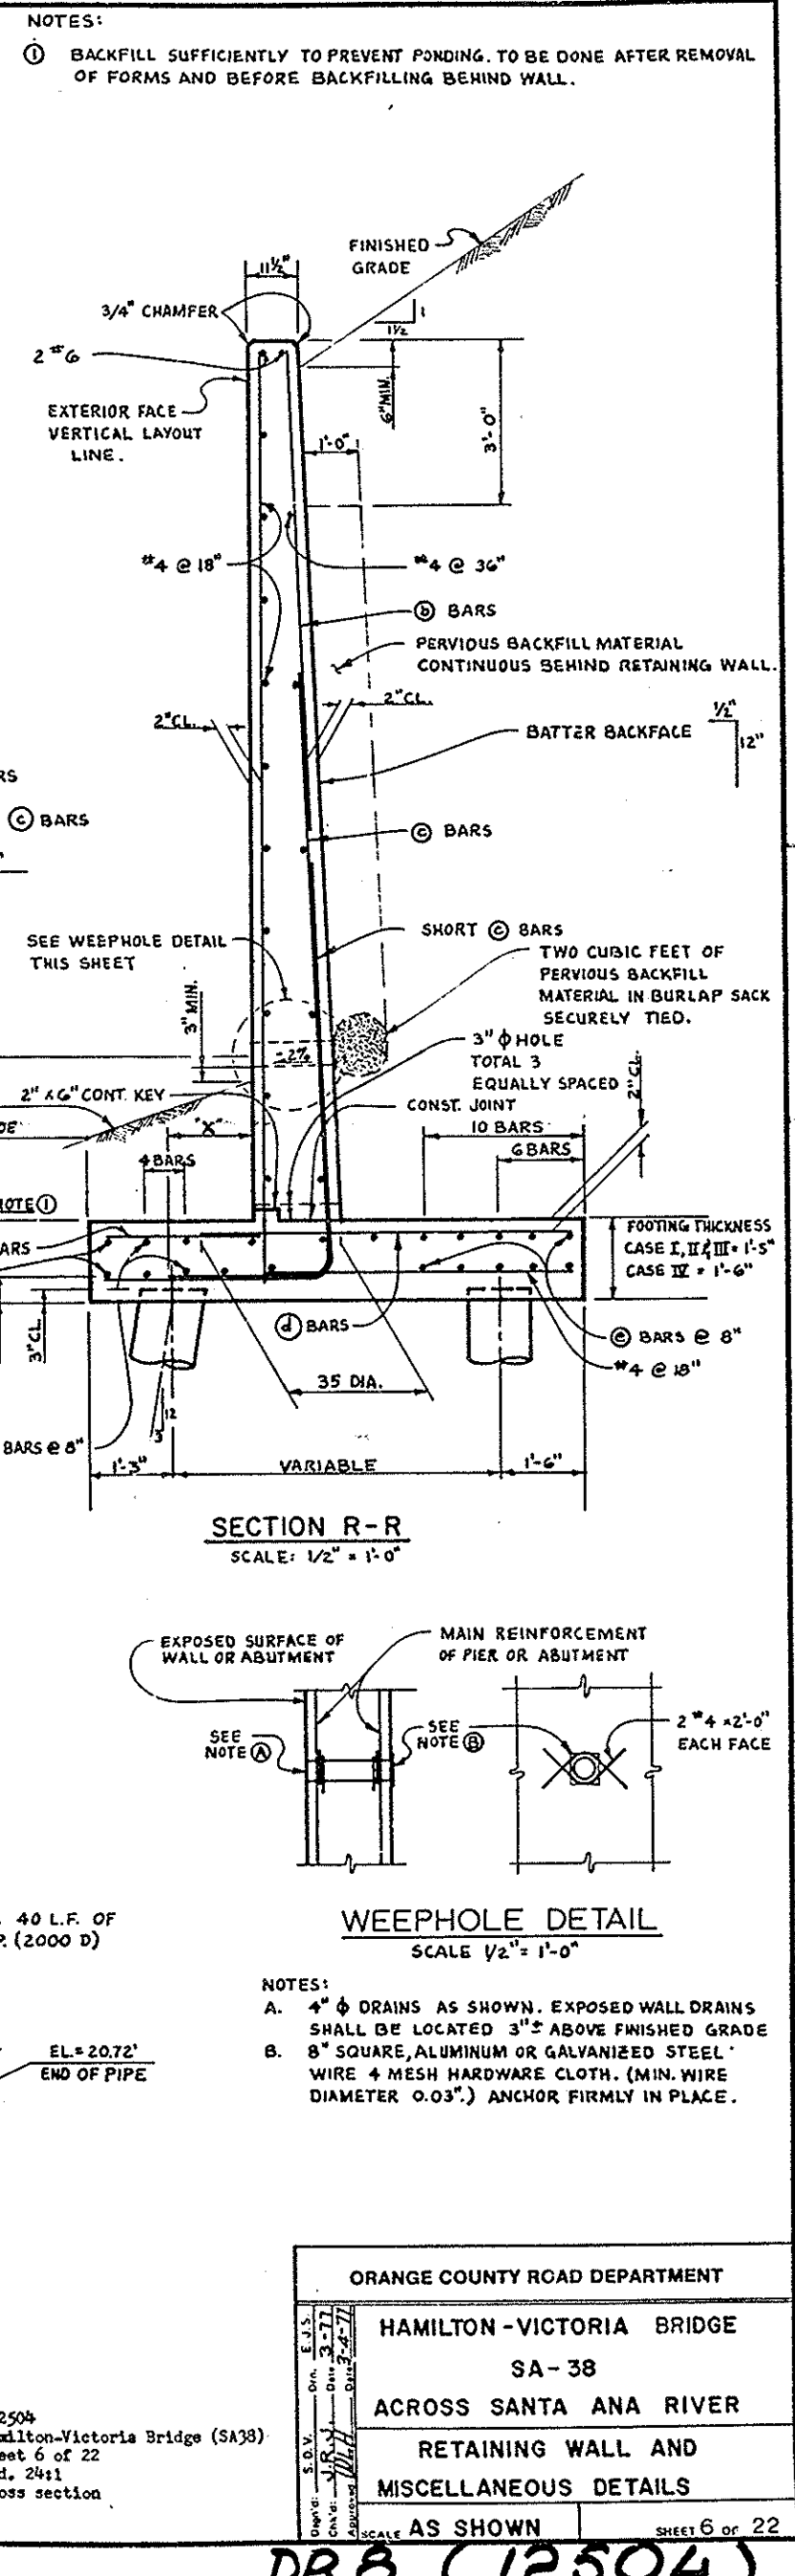

DRB (12504)