
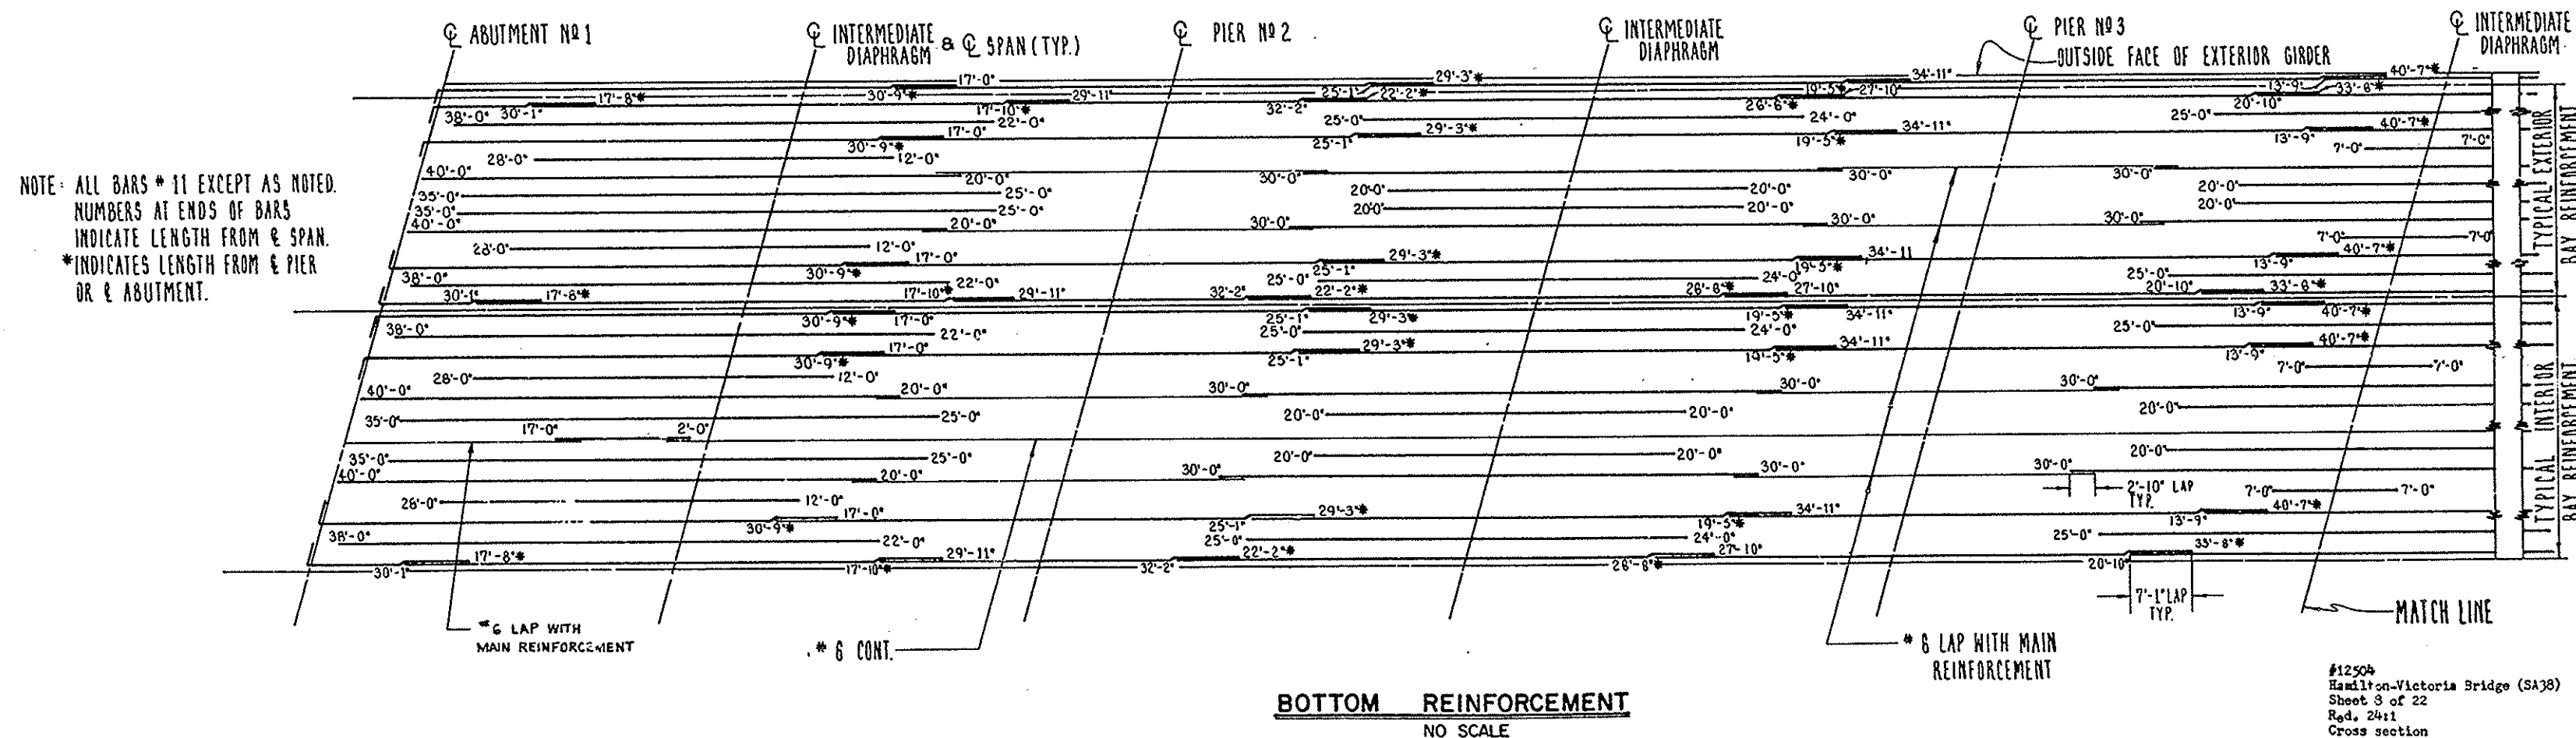
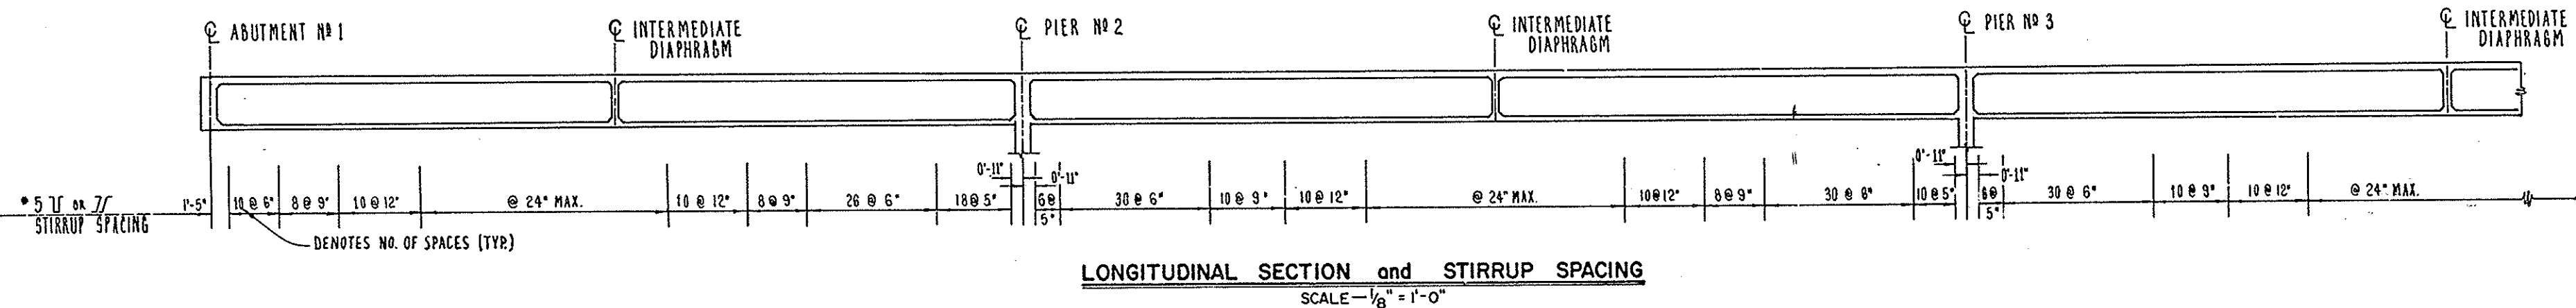


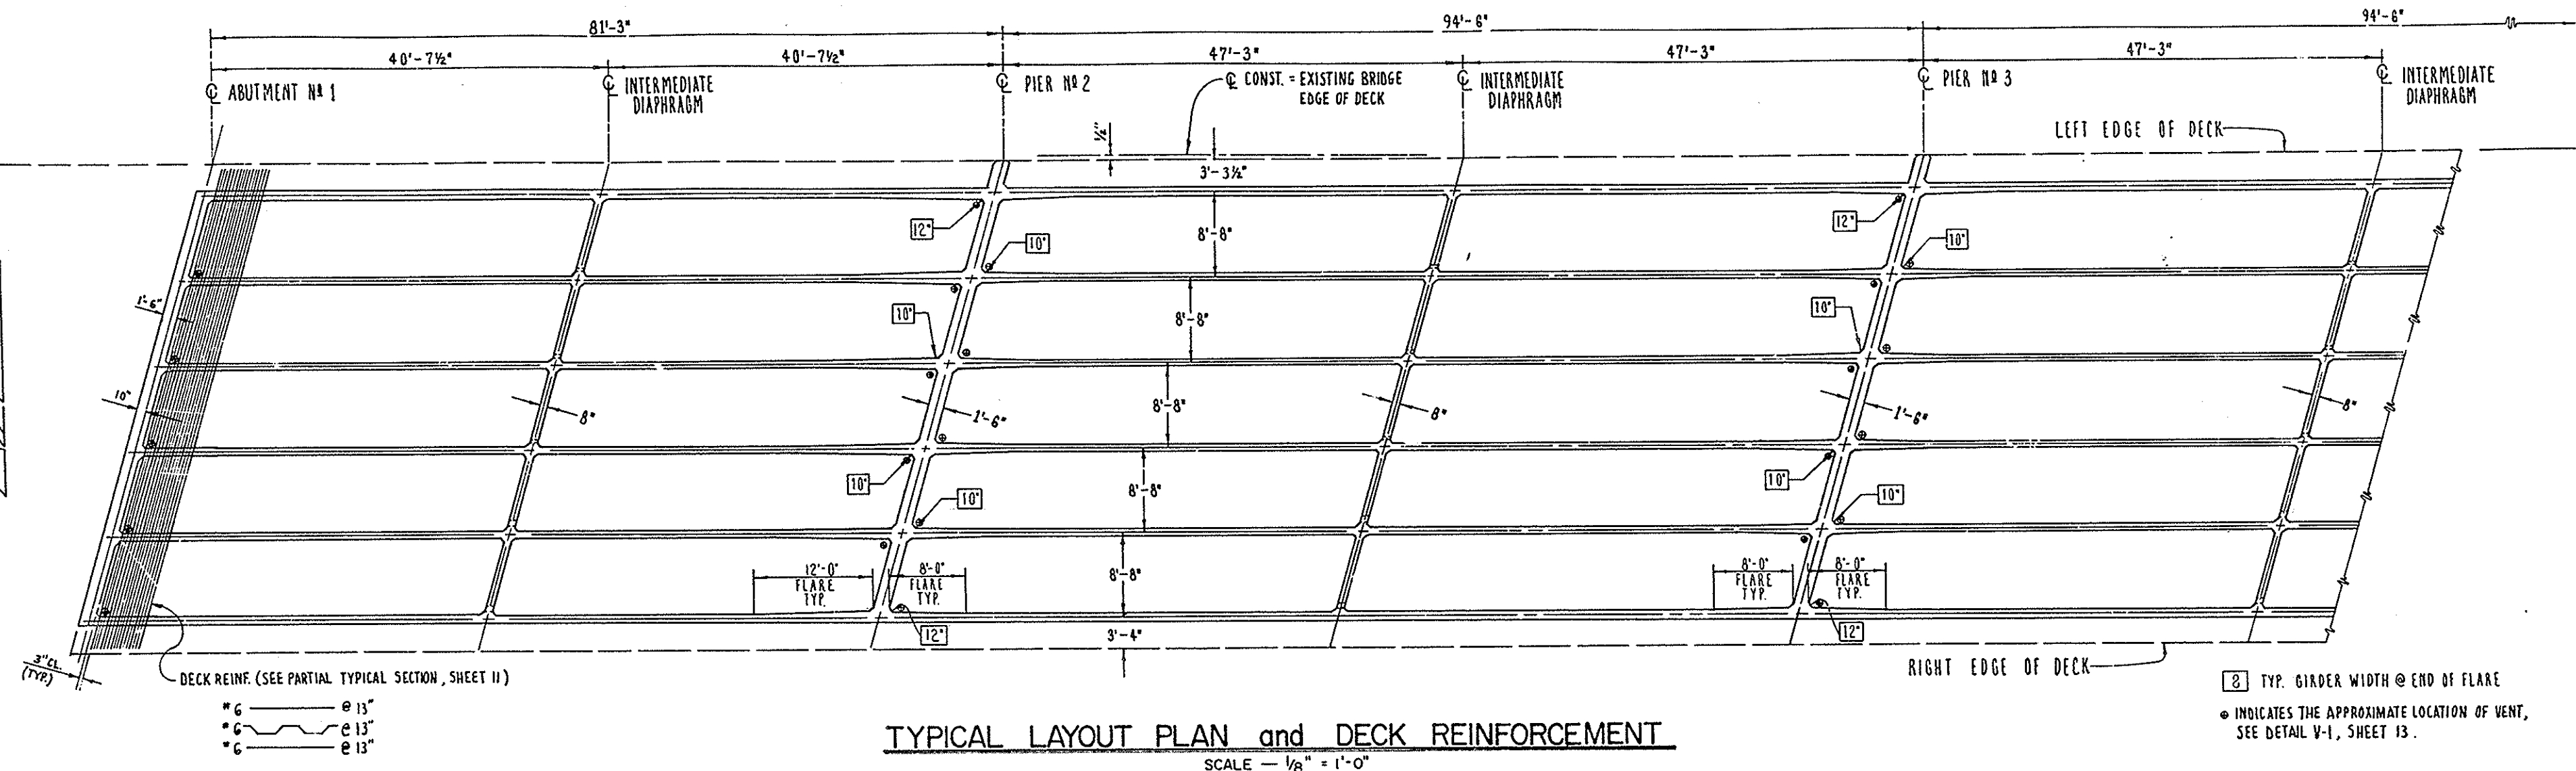

ORANGE COUNTY ROAD DEPARTMENT	
HAMILTON-VICTORIA BRIDGE	
SA-38	
ACROSS SANTA ANA RIVER	
SUPERSTRUCTURE LAYOUT and REINFORCEMENT	
AS SHOWN	SHEET 8 OF 22

DRB (12504)