


SCALE — $\frac{1}{8}'' = 1'-0''$



SCALE— $\frac{1}{8}" = 1' - 0"$

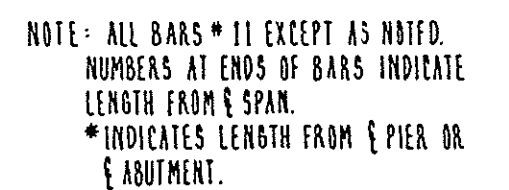

ORANGE COUNTY ROAD DEPARTMENT

HAMILTON-VICTORIA BRIDGE
SA - 38
ACROSS SANTA ANA RIVER

SUPERSTRUCTURE LAYOUT
and REINFORCEMENT

#12504
Hamilton- victoria Bridge (SA38)
Sheet 9 of 22
Red. 24;1
Cross section

DR 8 (12504)