
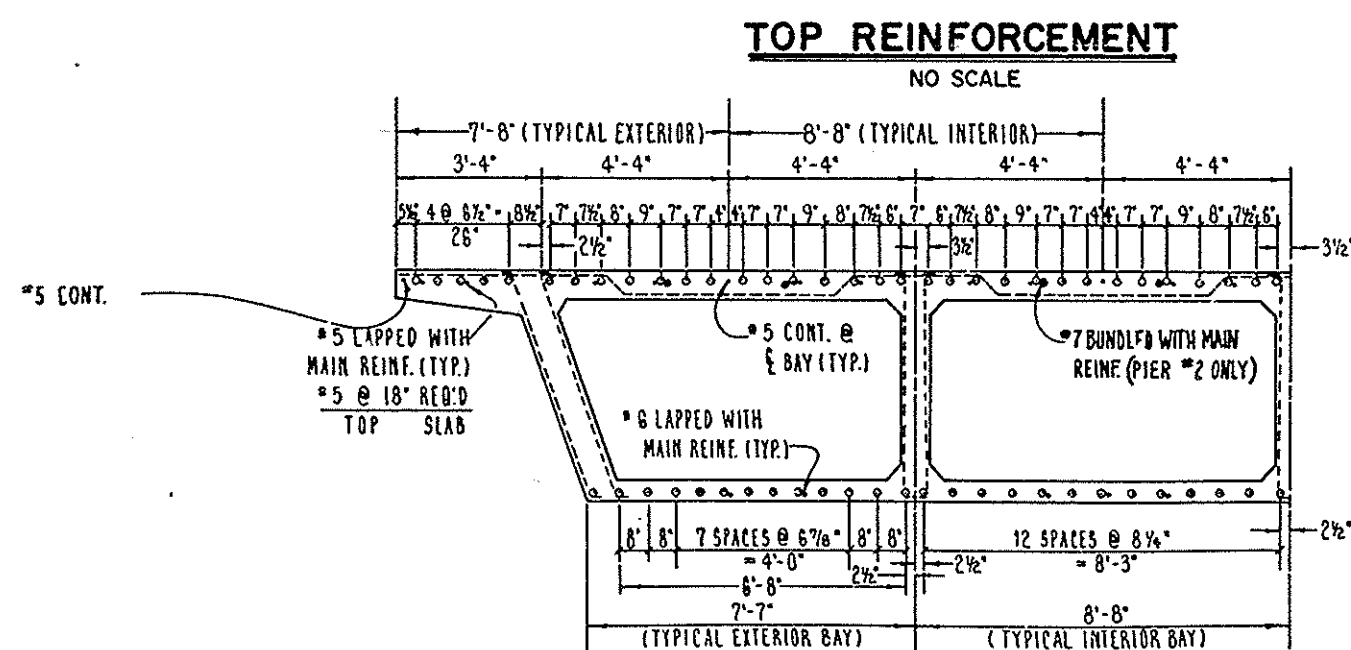
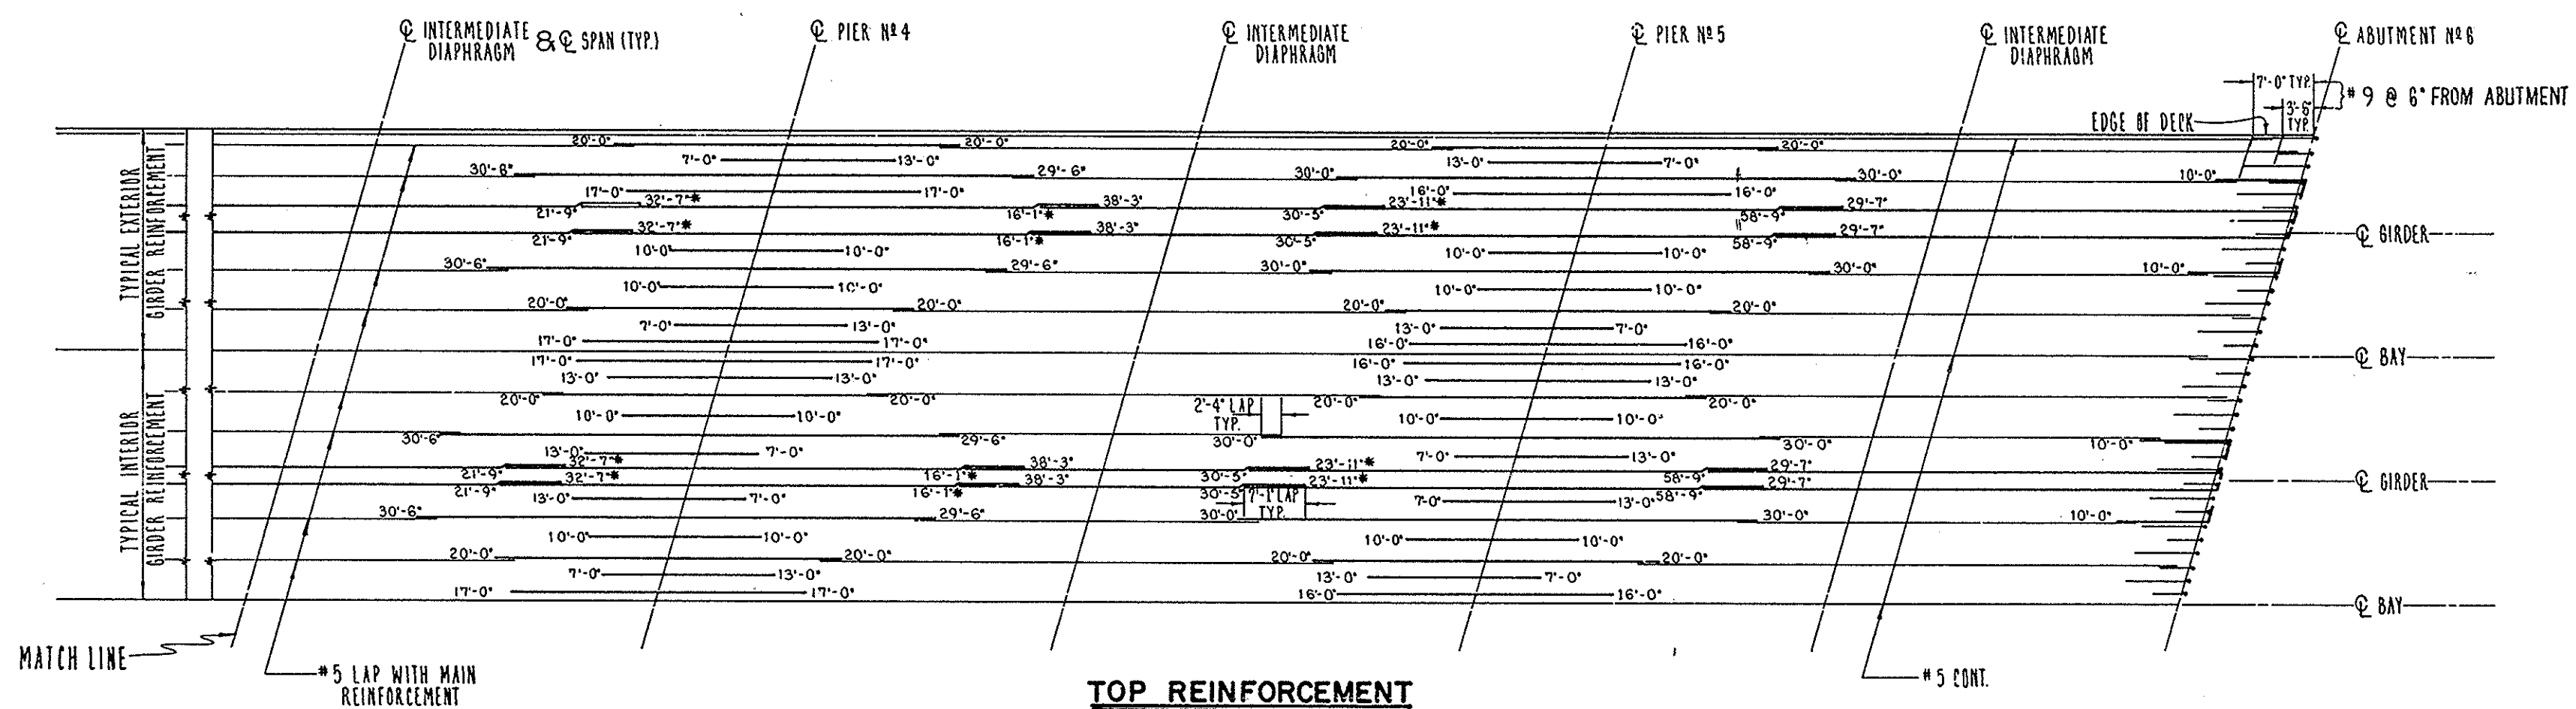


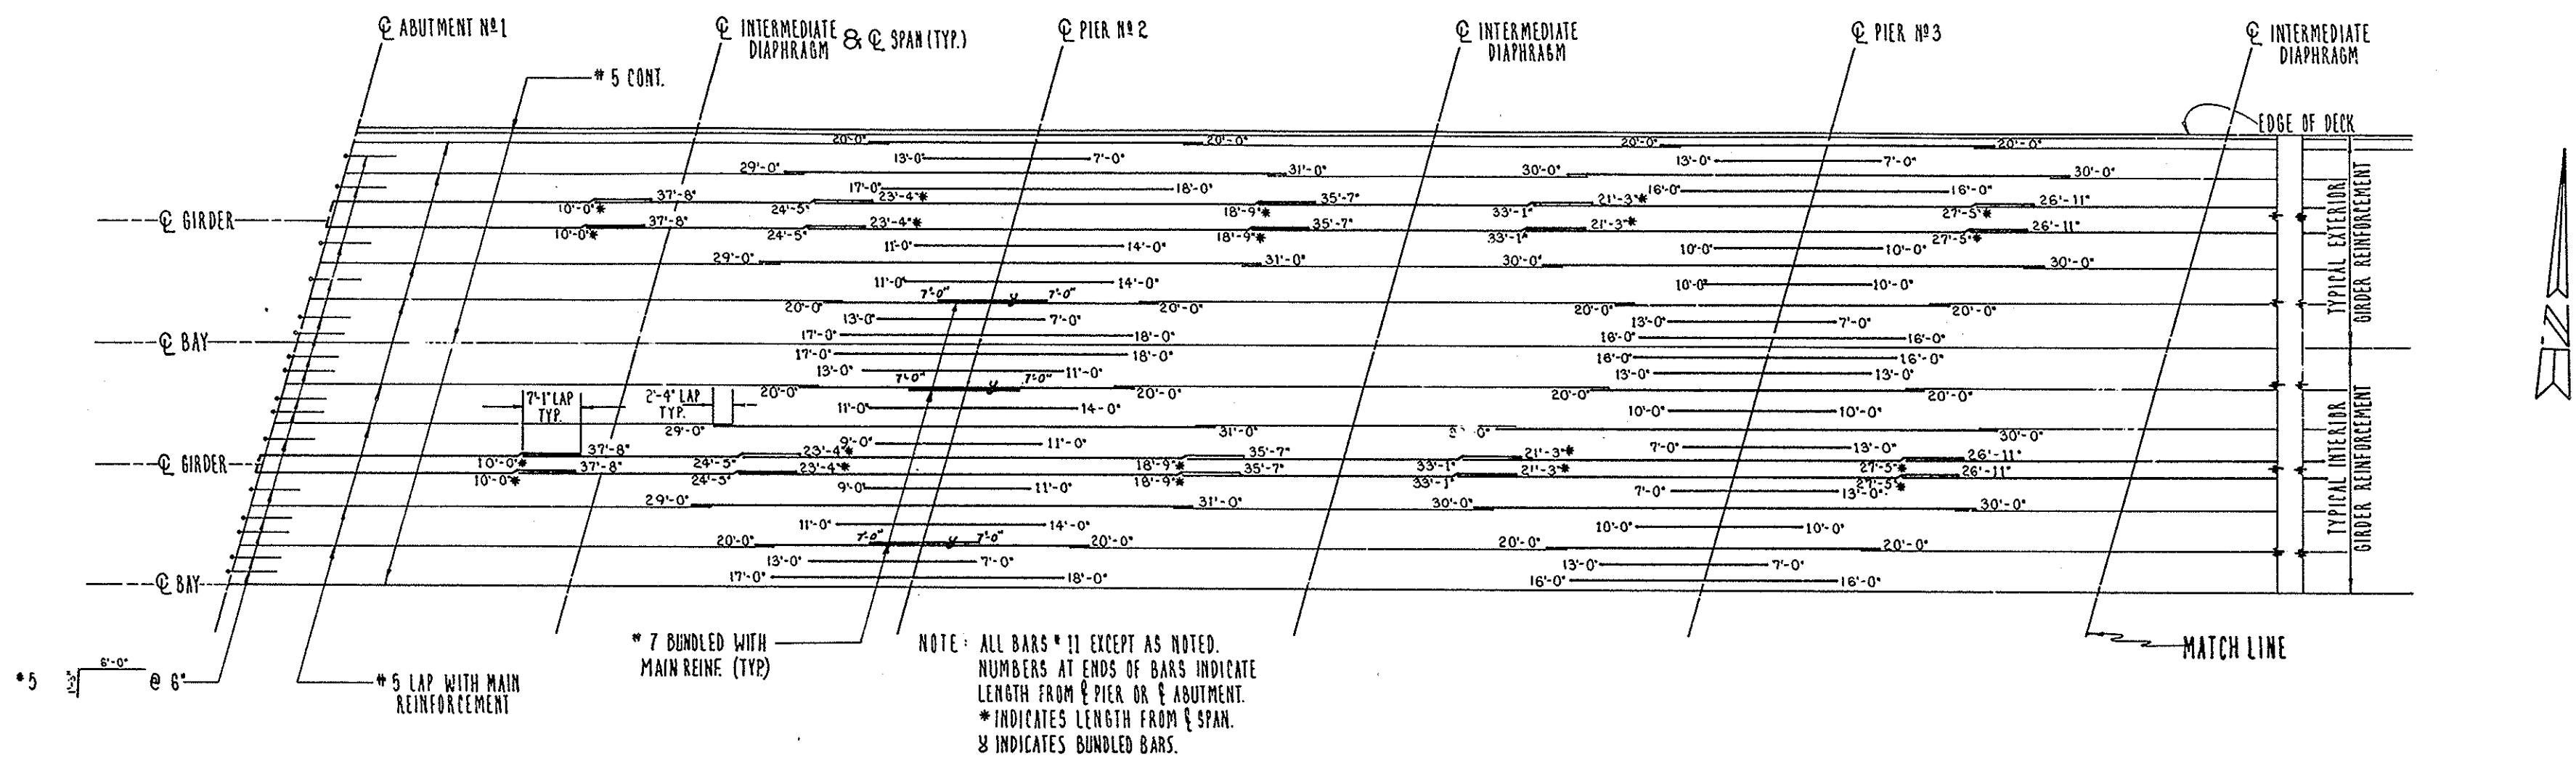

PLACING DIAGRAM
 SCALE - 3/8" = 1'-0"

#12504
 Hamilton-Victoria Bridge (SA38)
 Sheet 10 of 22
 Rev. 2/11
 Cross section

ORANGE COUNTY ROAD DEPARTMENT	
HAMILTON-VICTORIA BRIDGE SA-38 ACROSS SANTA ANA RIVER	
TOP DECK REINFORCEMENT and PLACING DIAGRAM	
SCALE AS SHOWN	SHEET 10 OF 22

DRB (12504)