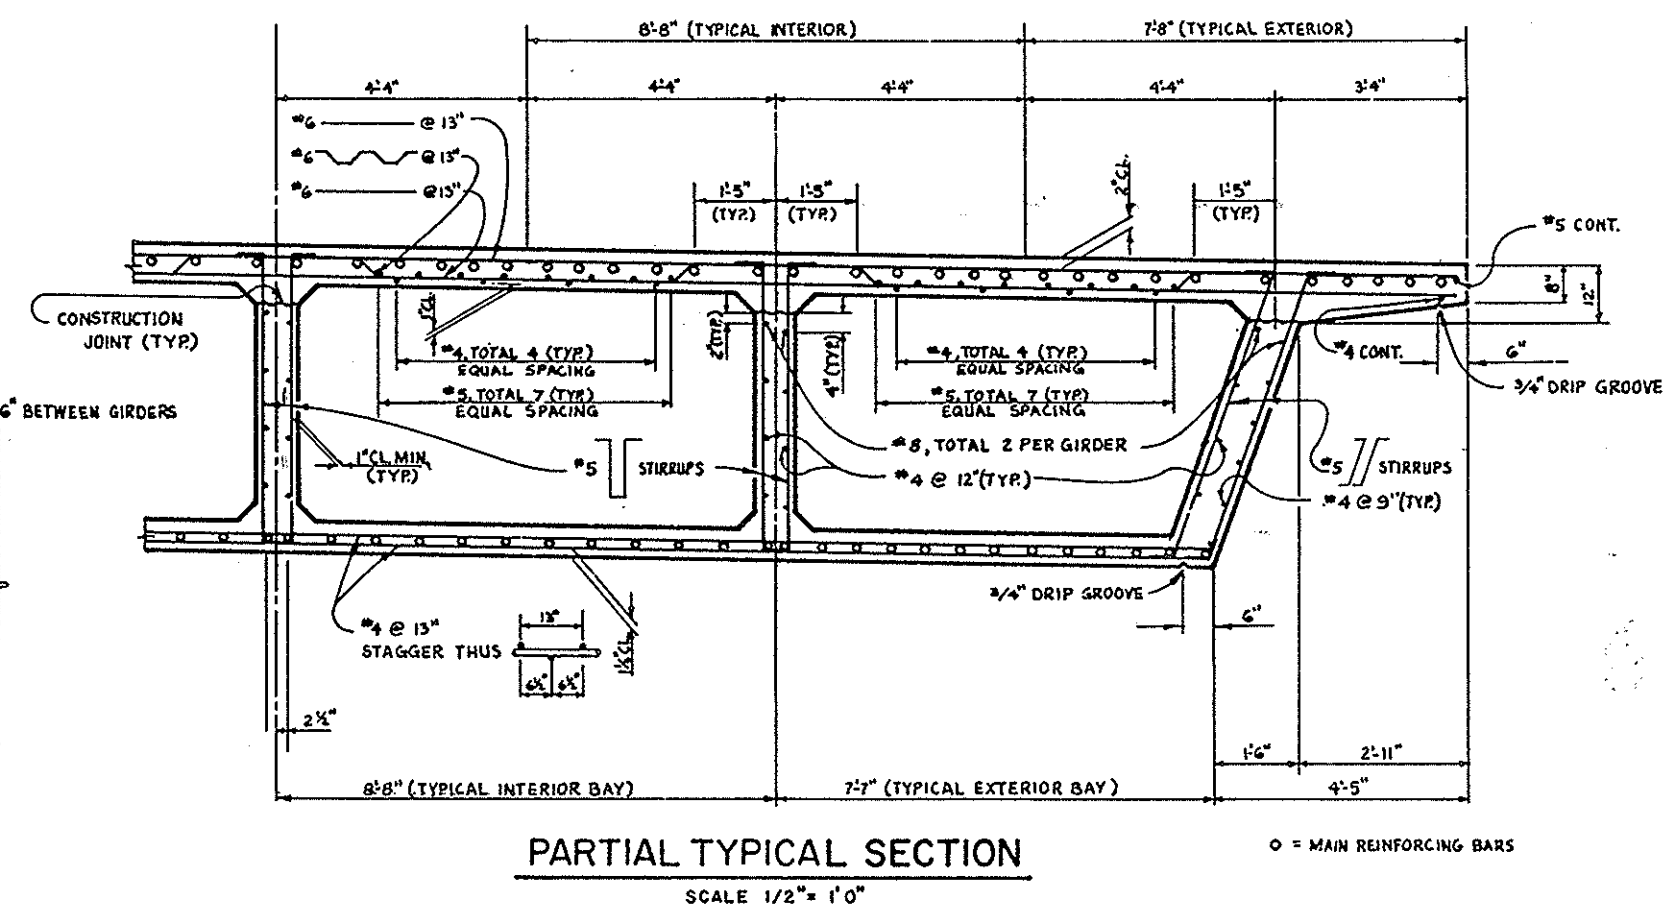
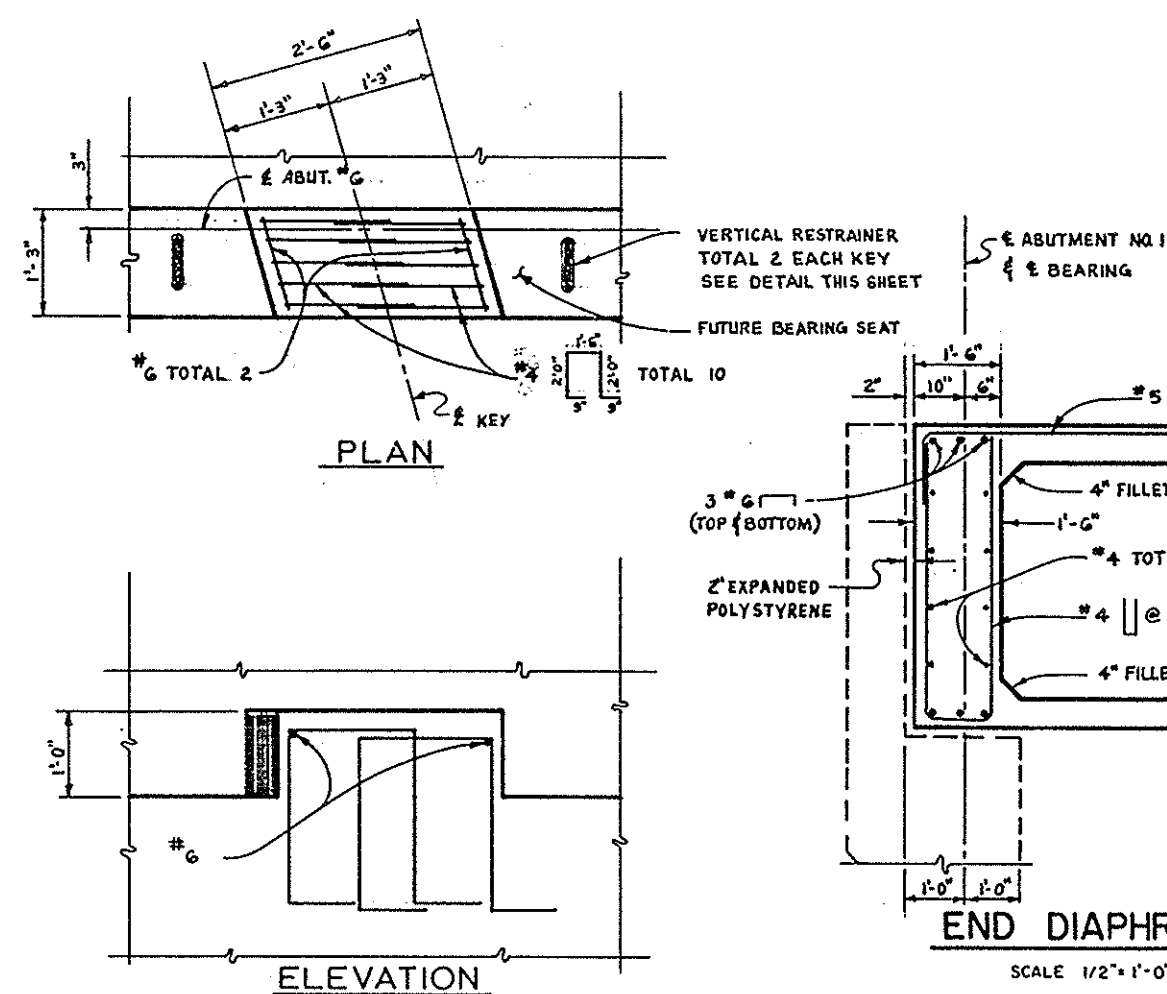
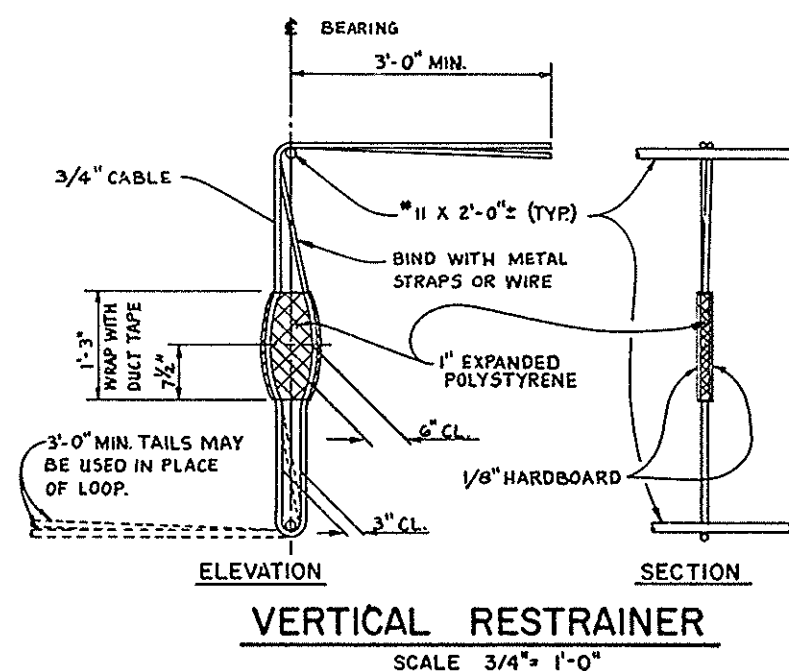
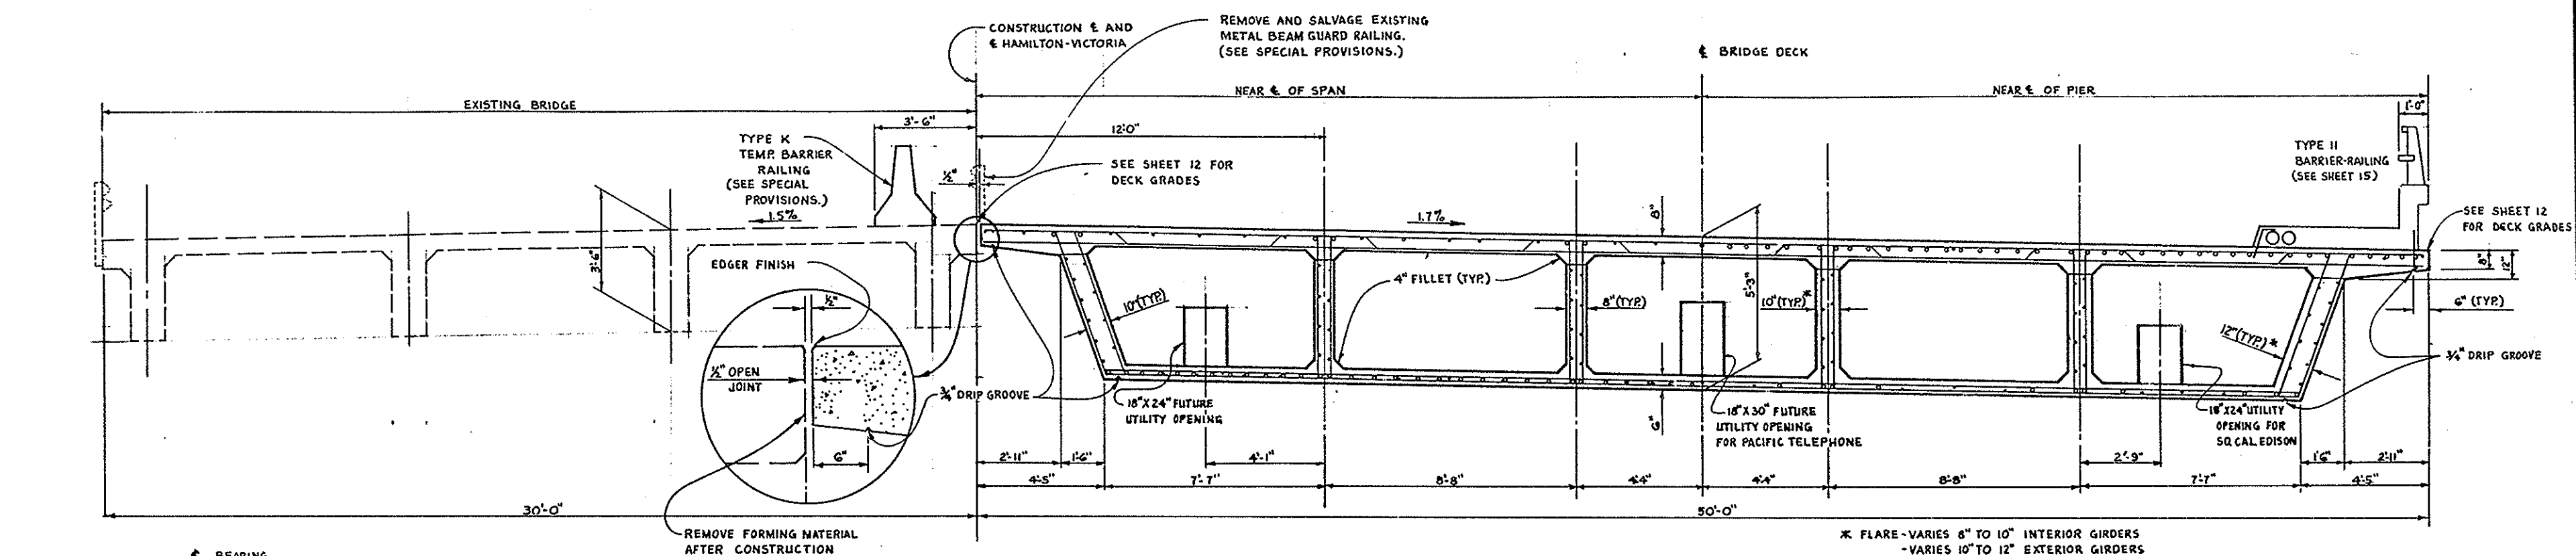


# GENERAL NOTES

DESIGN: AASHTO DATED 1975 WITH SUBSEQUENT REVISIONS AND STATE OF CALIFORNIA BRIDGE PLANNING AND DESIGN MANUAL.

LIVE LOADING: HS 20-44  $\frac{1}{2}$  ALTERNATIVE

REINFORCED CONCRETE:  $f'_c = 24,000$  psi EXCEPT  
= 20,000 psi IN TRANSVERSE  
DECK SLABS AND STIRRIPS.  
 $f_y = 1300$  psi  
 $f'_c = 3250$  psi @ 28 DAYS  
 $\pi = 10$

PILE LOADING: 70 TONS; TYPE: CLASS 70.

CONCRETE: CLASS "A" USING TYPE II PORTLAND CEMENT.

REINFORCEMENT SPLICING:  
BARS #8 & SMALLER - LAP 45 DIAMETERS OF SMALLER BAR JOINED.  
BARS #9, #10 & #11 - LAP 60 DIAMETERS OF SMALLER BAR JOINED.

|                                      |                |
|--------------------------------------|----------------|
| ORANGE COUNTY ROAD DEPARTMENT        |                |
| HAMILTON-VICTORIA BRIDGE             |                |
| SA-38                                |                |
| ACROSS SANTA ANA RIVER               |                |
| TYPICAL SECTION AND<br>GENERAL NOTES |                |
| SCALE AS SHOWN                       | SHEET 11 OF 22 |

DR 8 (12504)