




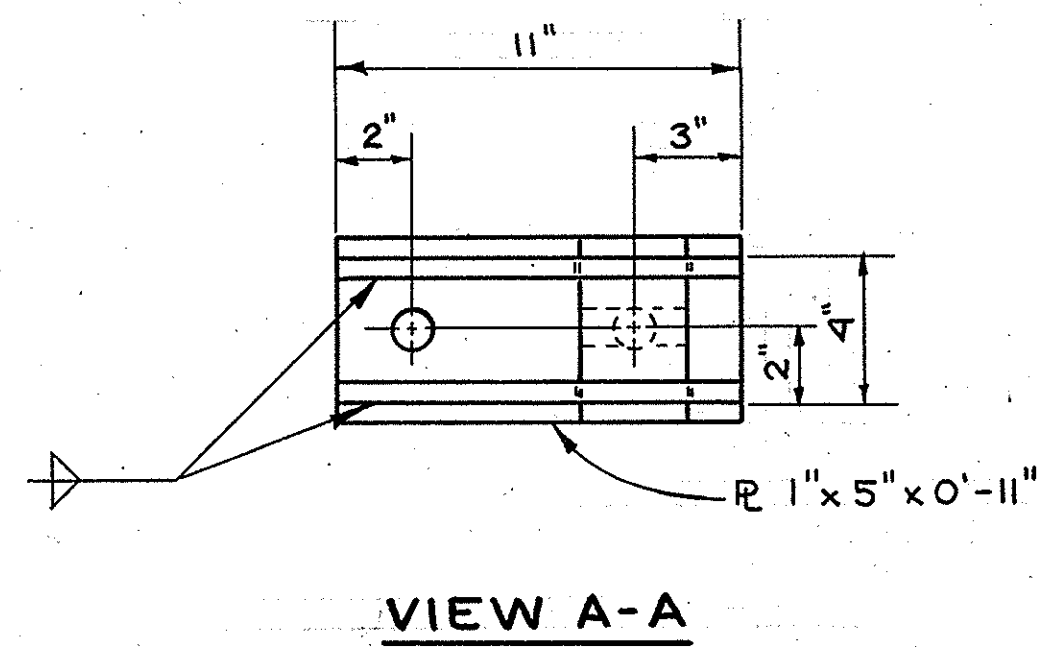


VIEW A-A

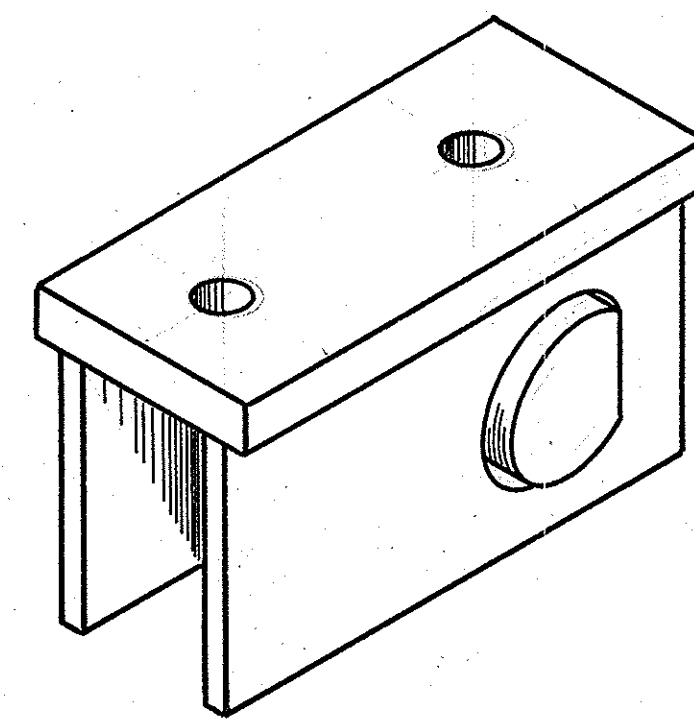


ISOMETRIC VIEW

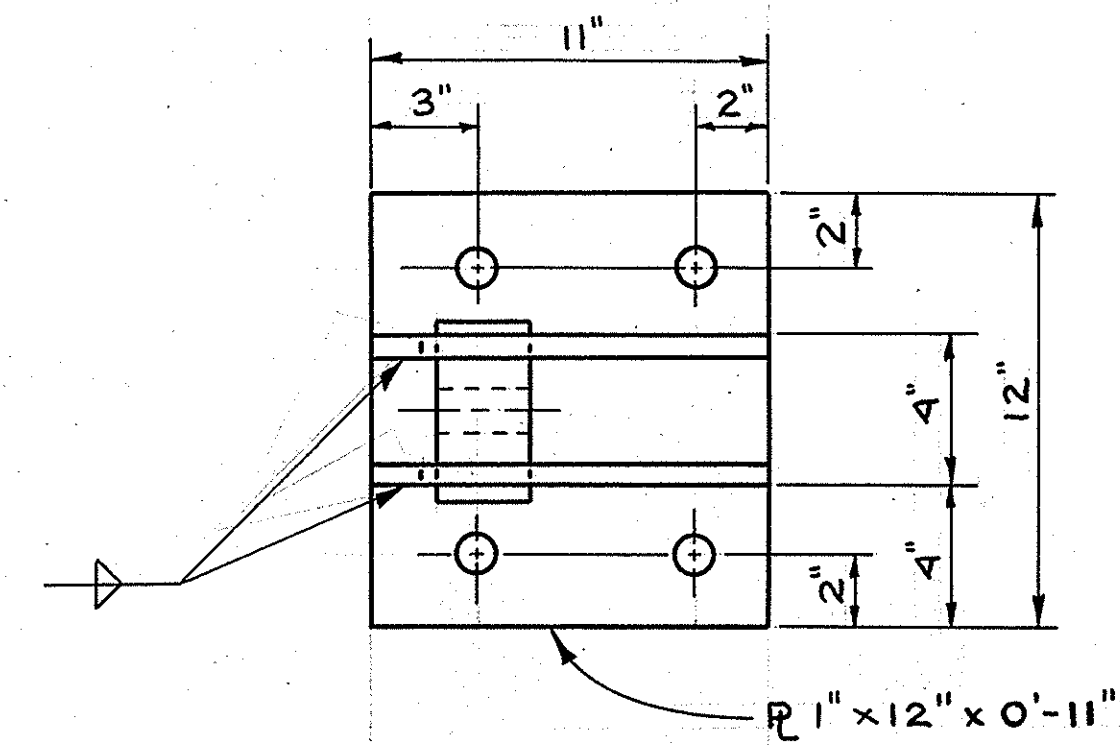

VIEW C-C

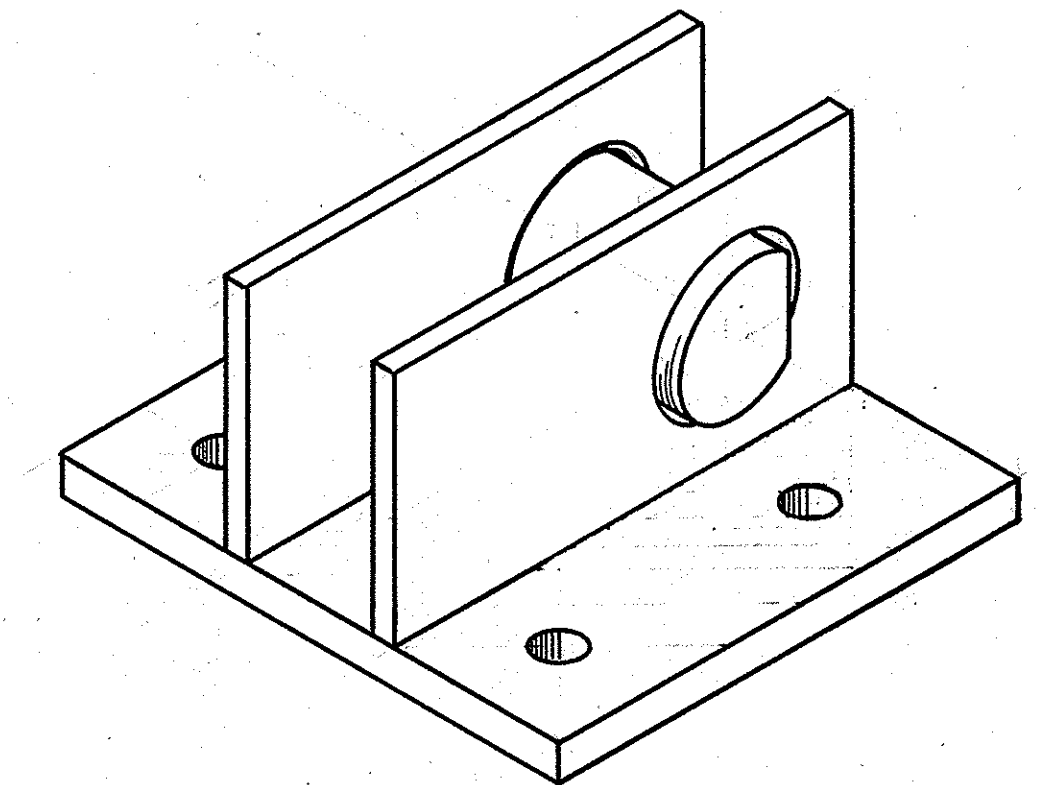


ISOMETRIC VIEW

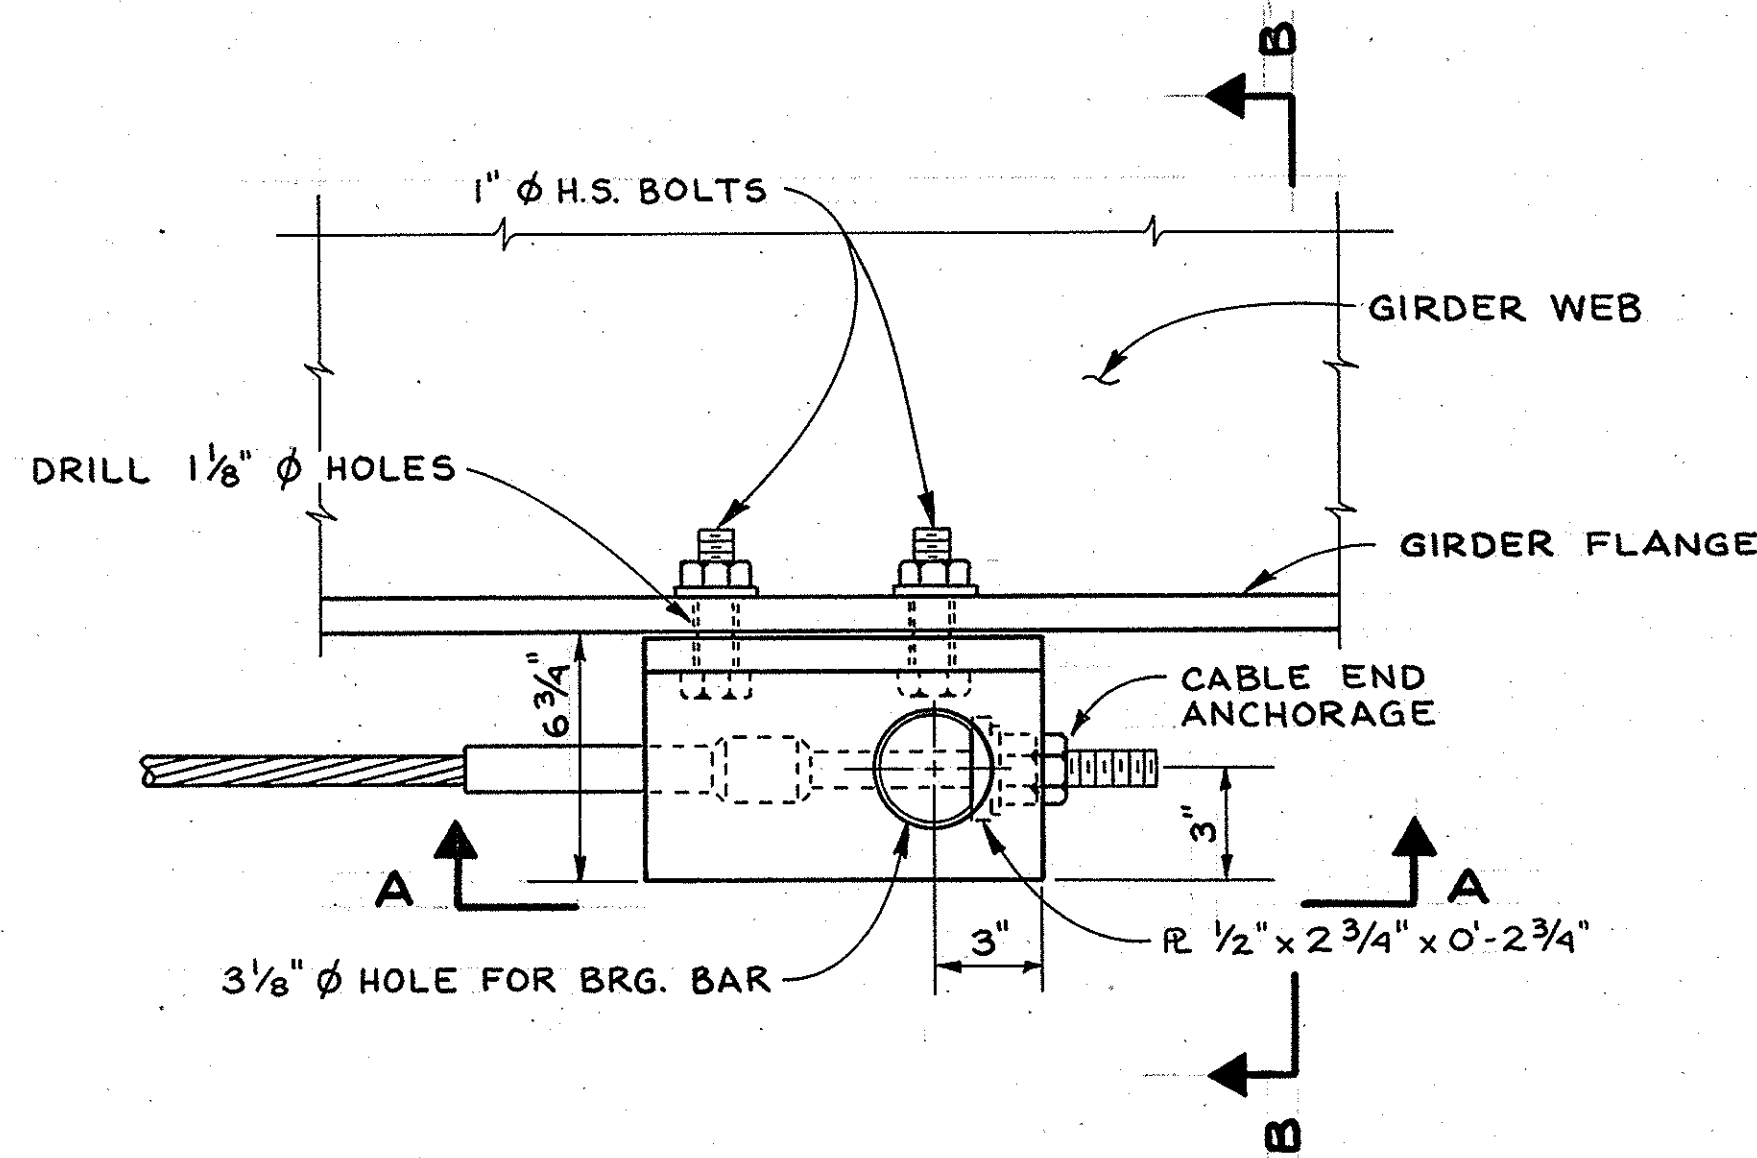


ELEVATION

BRACKET "A" DETAILS

NO SCALE

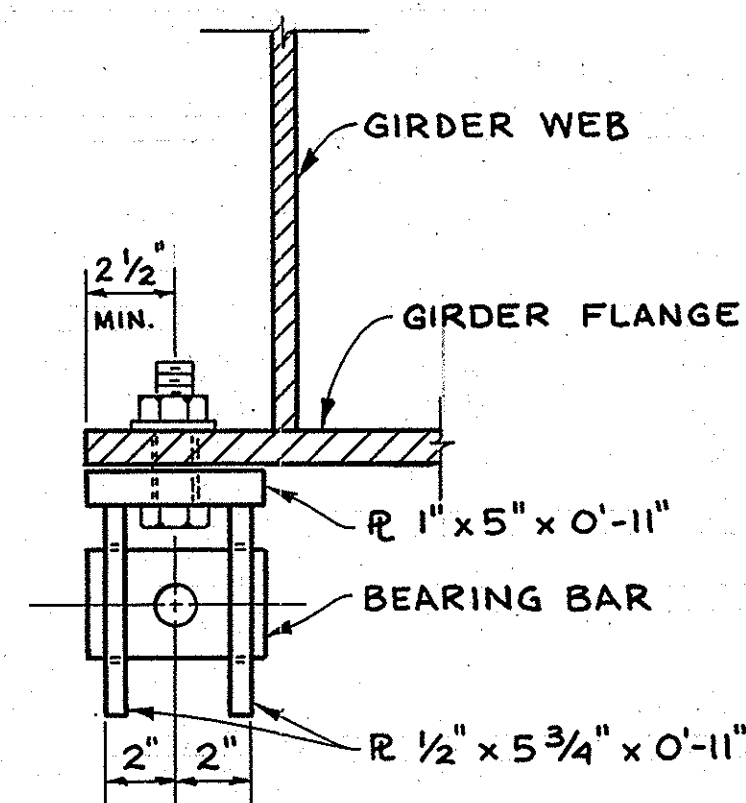


VIEW B-B

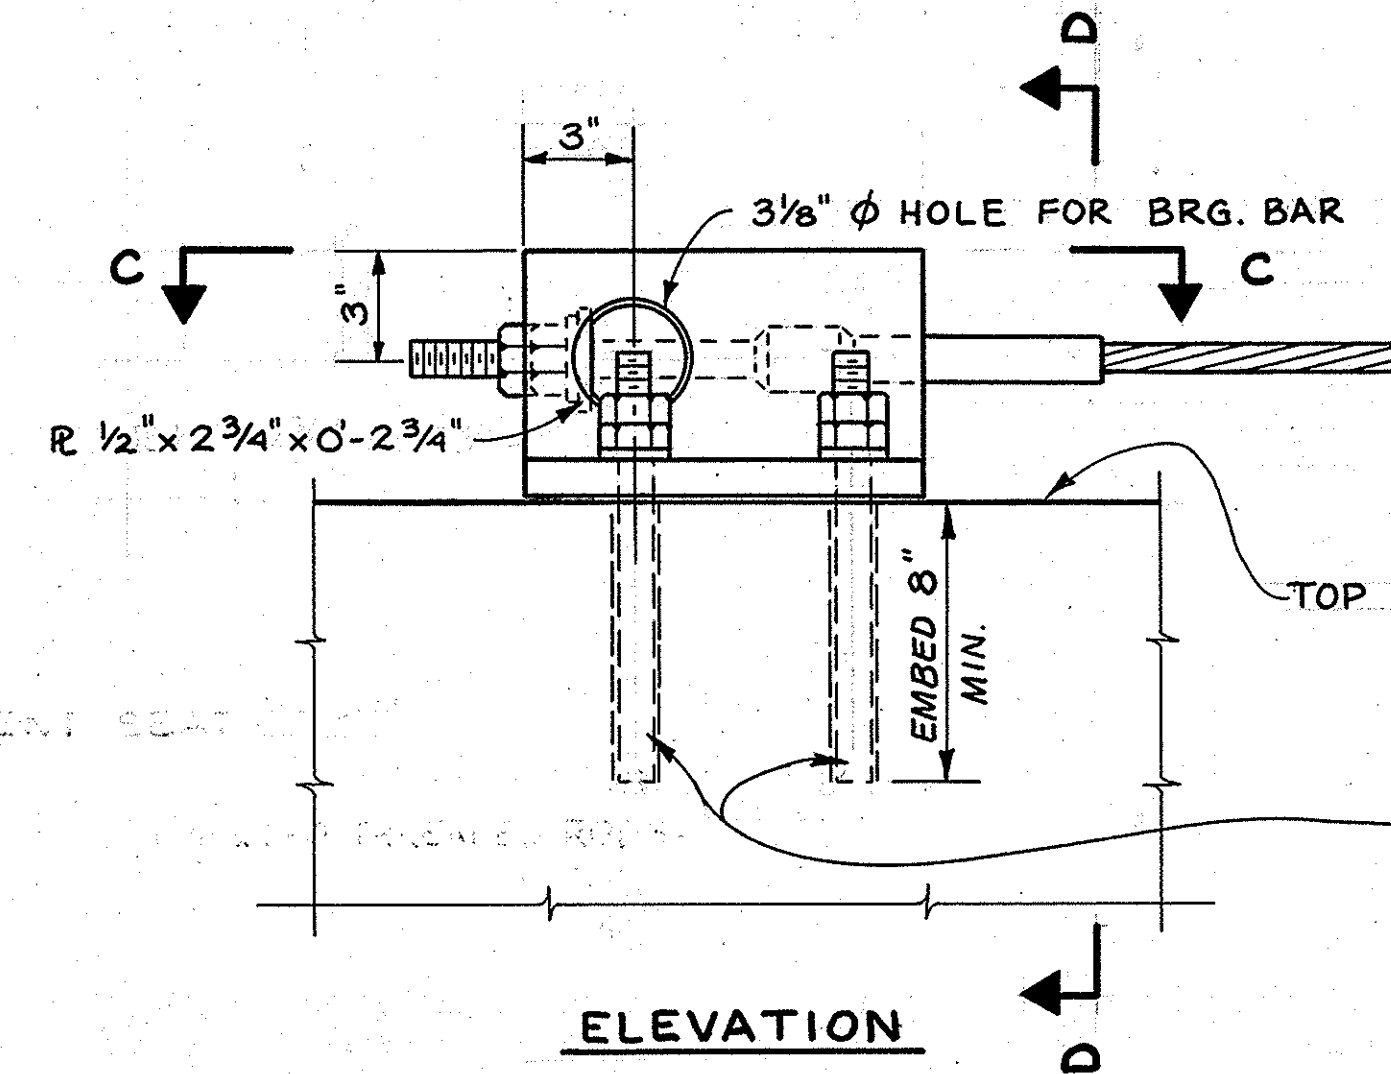

ELEVATION


MODIFIED BRACKET "A" DETAILS

NO SCALE

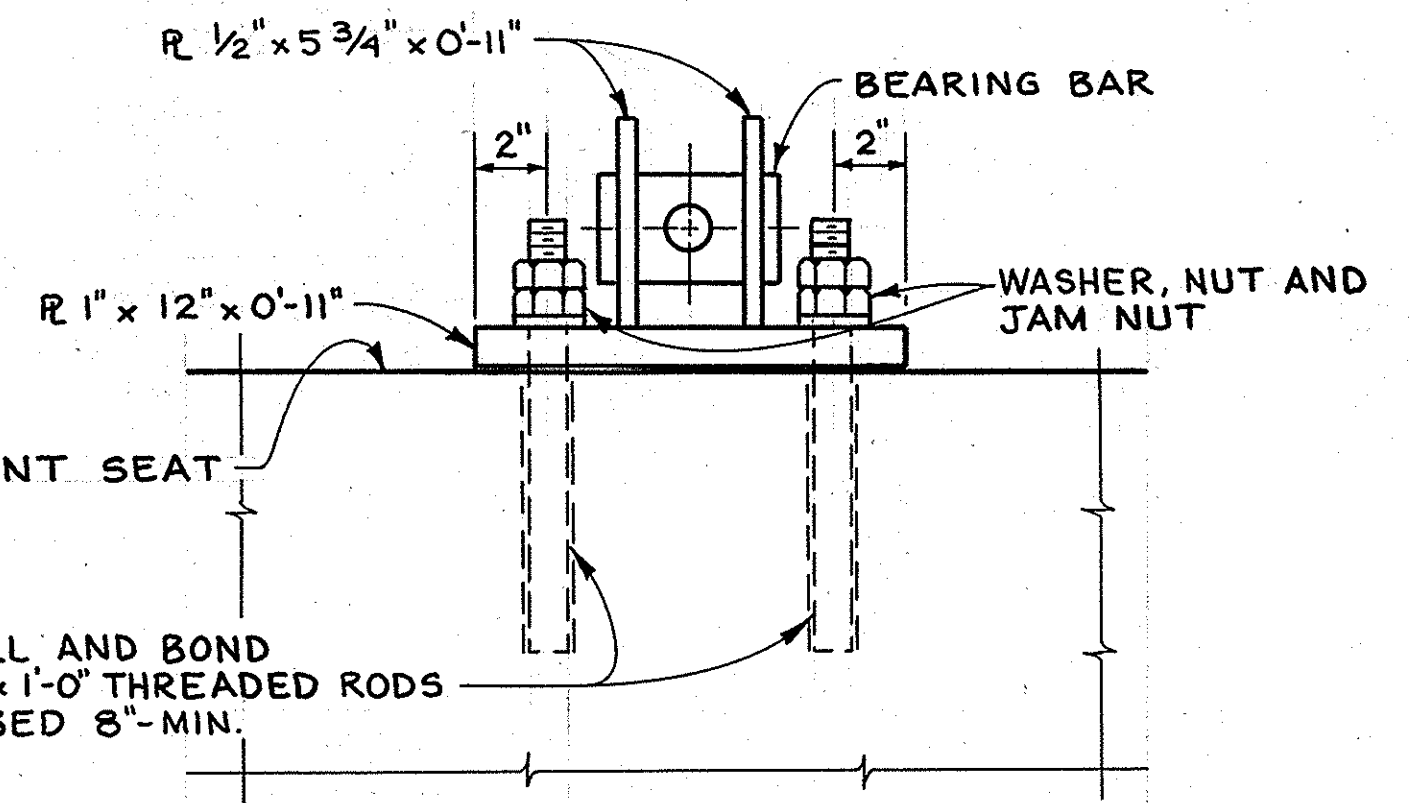


VIEW D-D

DRILL AND BOND
1" x 1'-0" THREADED RODS
EMBED 8" MIN.

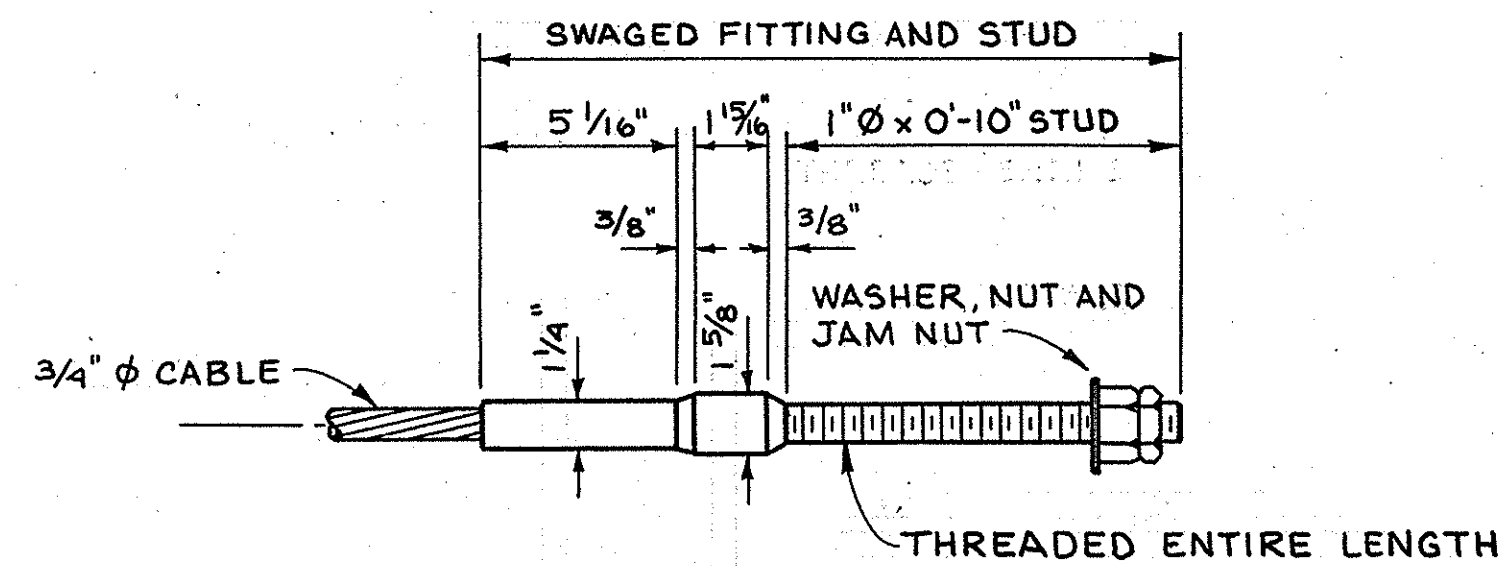

CABLE END ANCHORAGE

NO SCALE

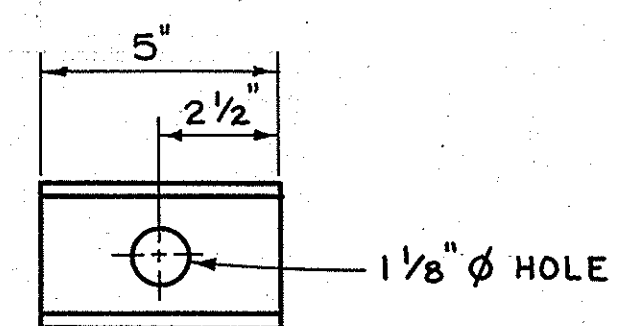


PLAN



ELEVATION

BEARING BAR DETAILS

NO SCALE

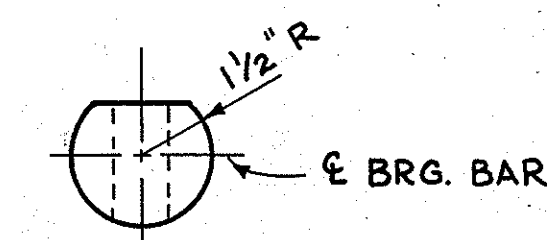

END VIEW

NOTE:
THE CONTRACTOR SHALL VERIFY
ALL DEPENDENT DIMENSIONS IN
THE FIELD BEFORE ORDERING
OR FABRICATING ANY MATERIAL.

1 1/2 0 1 2
3 inches on original drawing

ORANGE COUNTY ENVIRONMENTAL MANAGEMENT AGENCY			
SEISMIC RETROFIT HARBOR BLVD. BRIDGE SA-28 & SA-28A			
TYPE A BRACKET DETAILS			
MARK	DATE	DESCRIPTION	PREPARED UNDER SUPERVISION OF
REVISIONS			
DESIGNED	M.M.HSU	SCALE	DATE
DRAWN	B.MUNOZ	CHECKED	DATE
AS SHOWN	10/83	DWG. NO.	4