



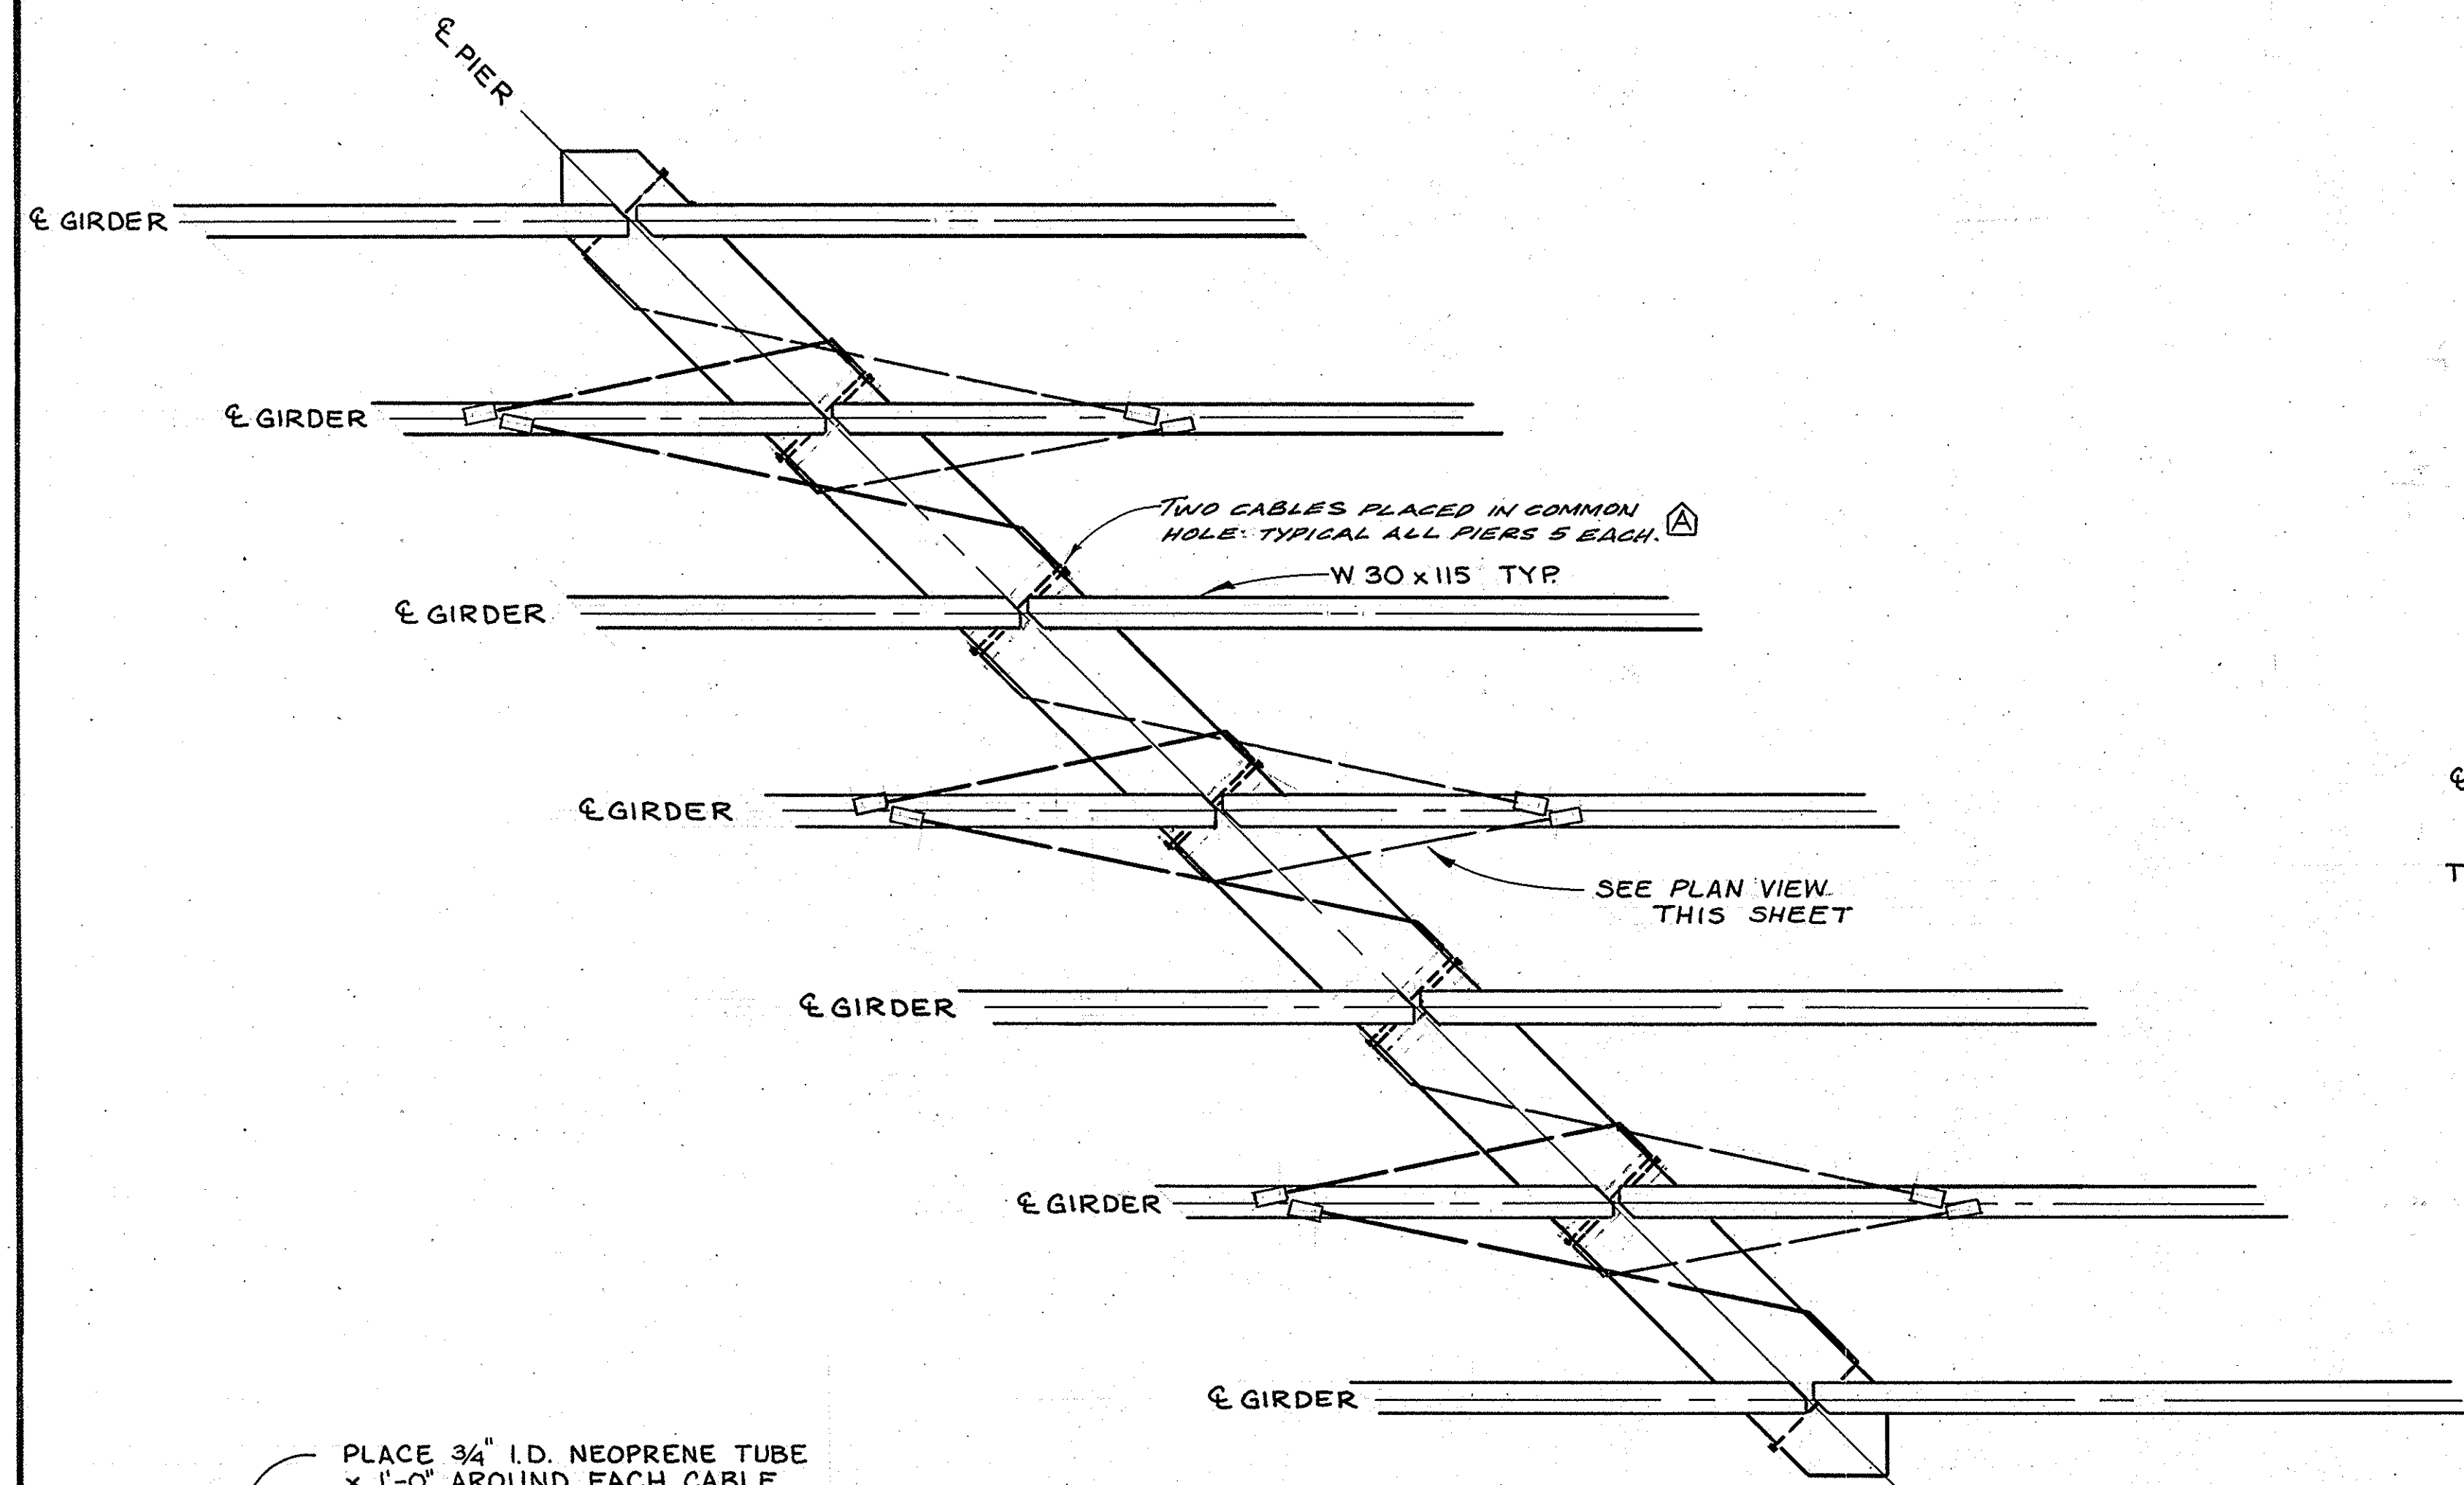


LONGITUDINAL CABLE RESTRAINER LAYOUT

NO SCALE

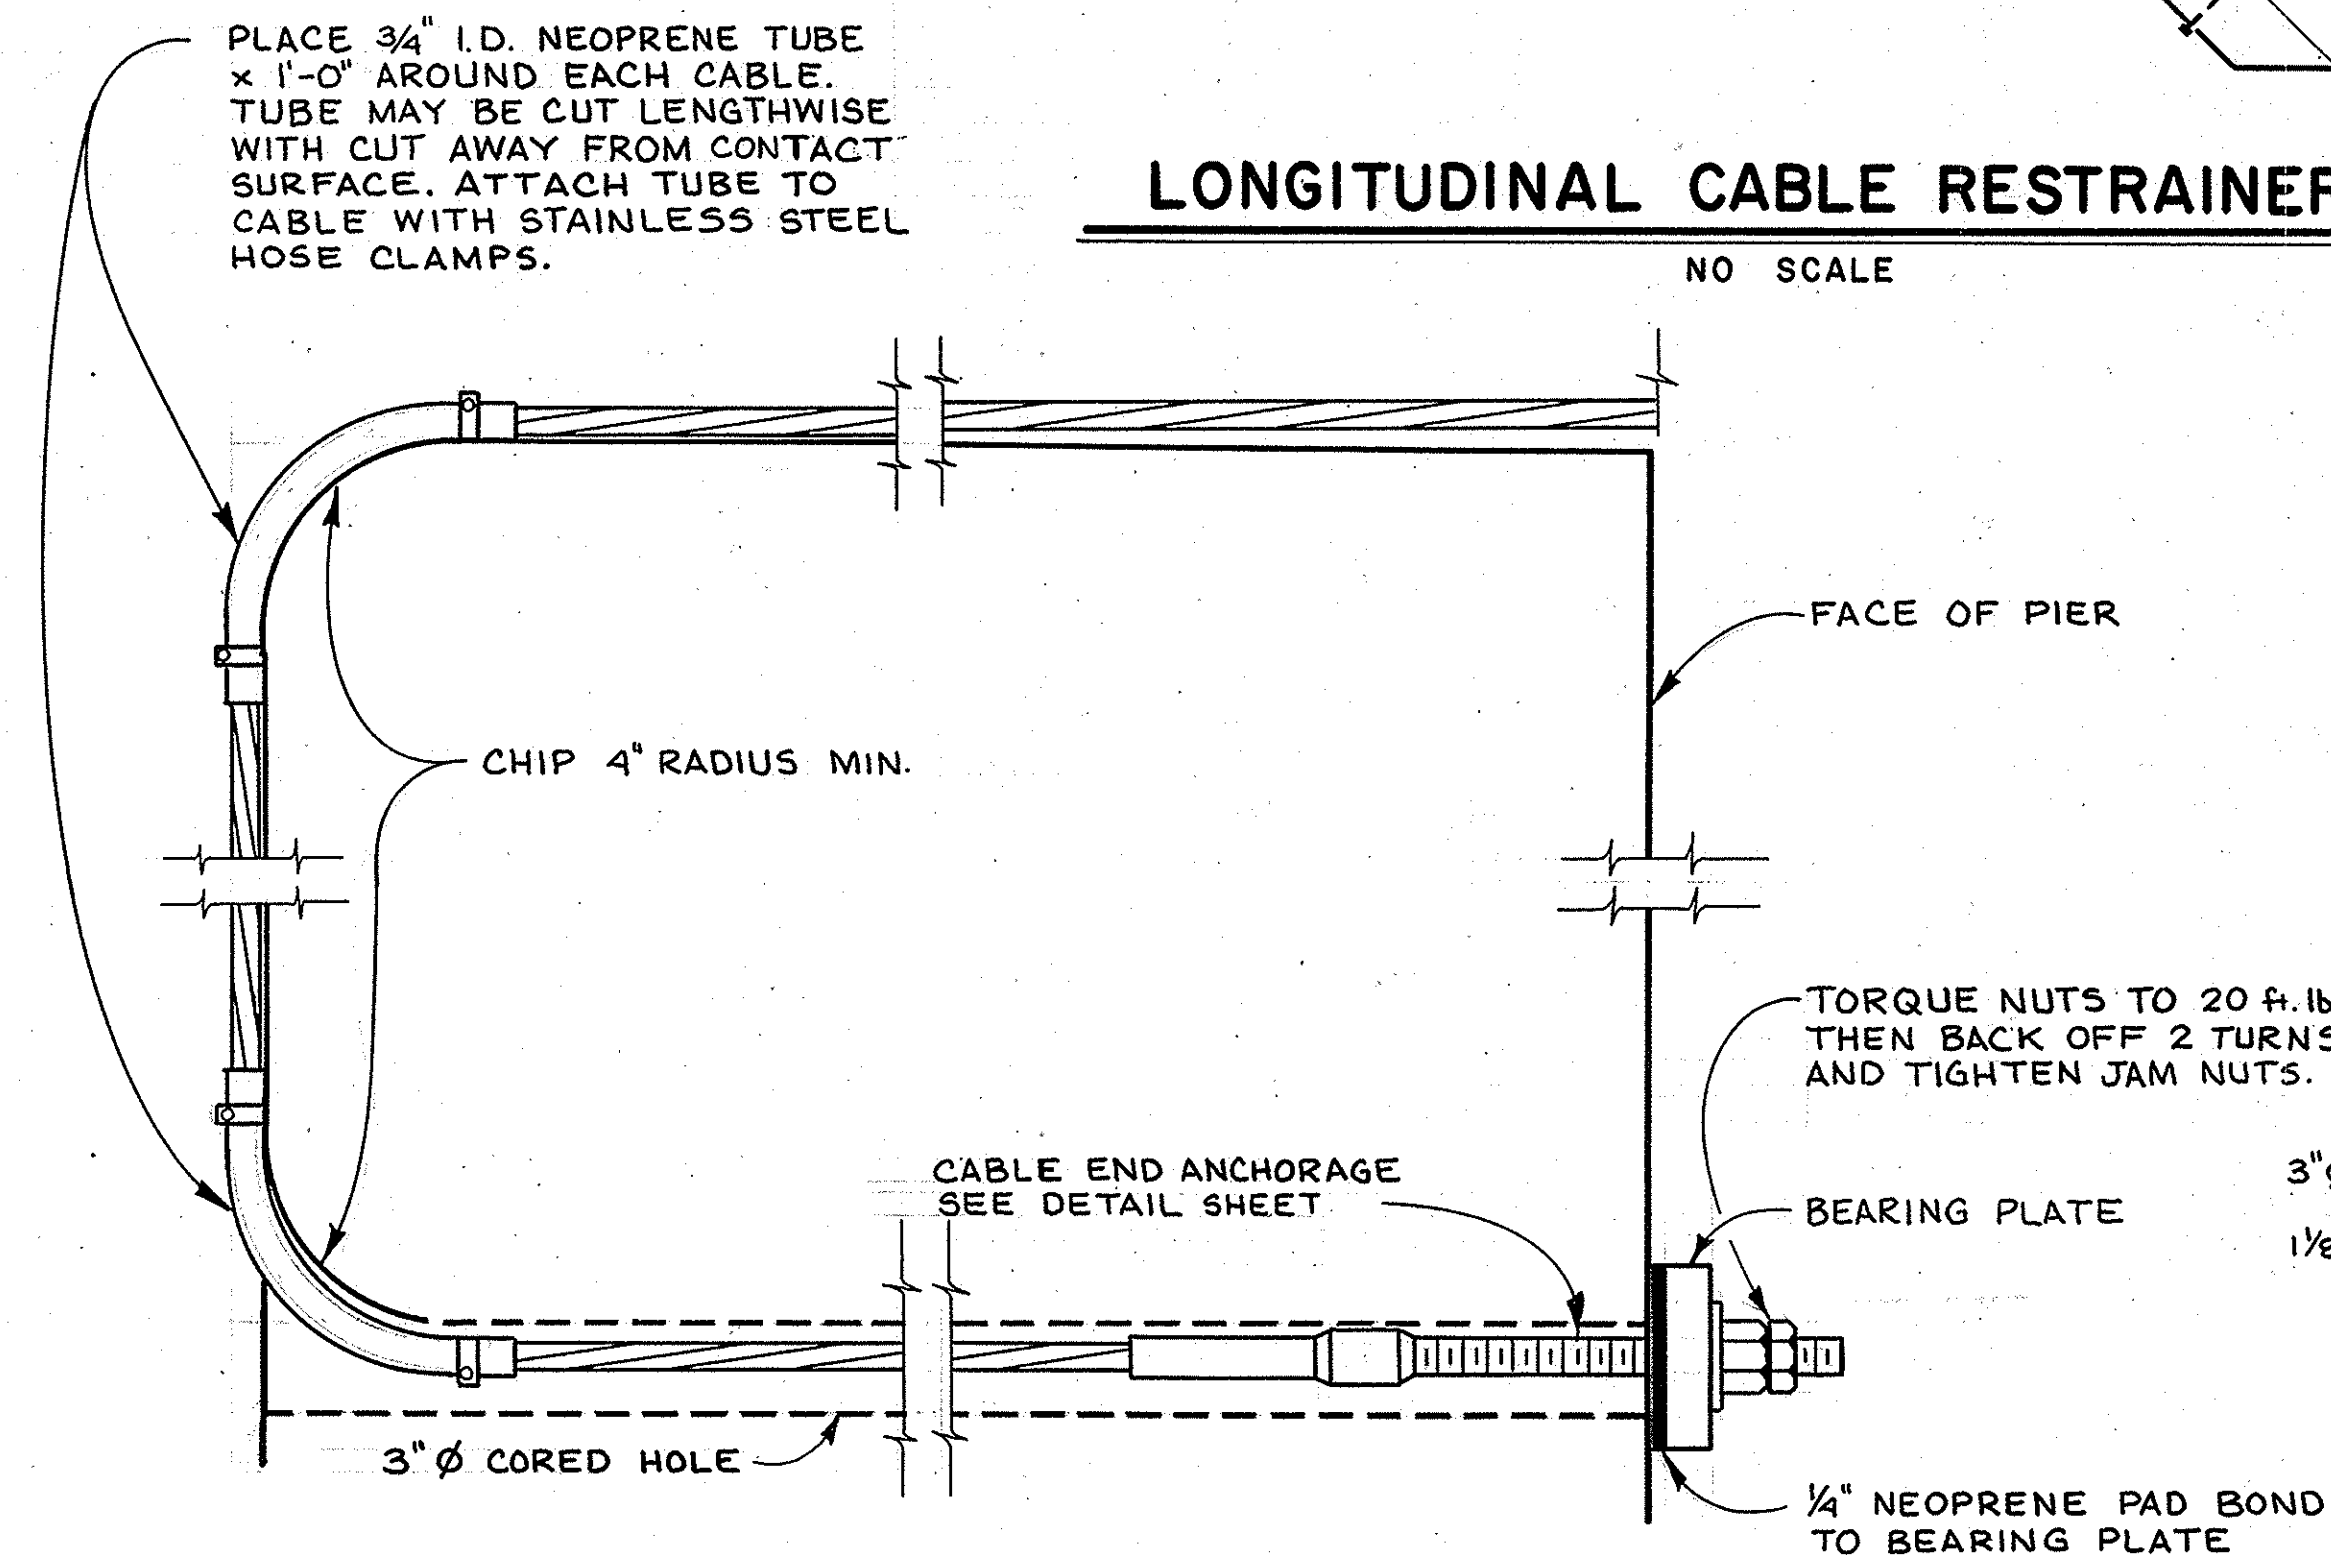


DETAIL C

NO SCALE

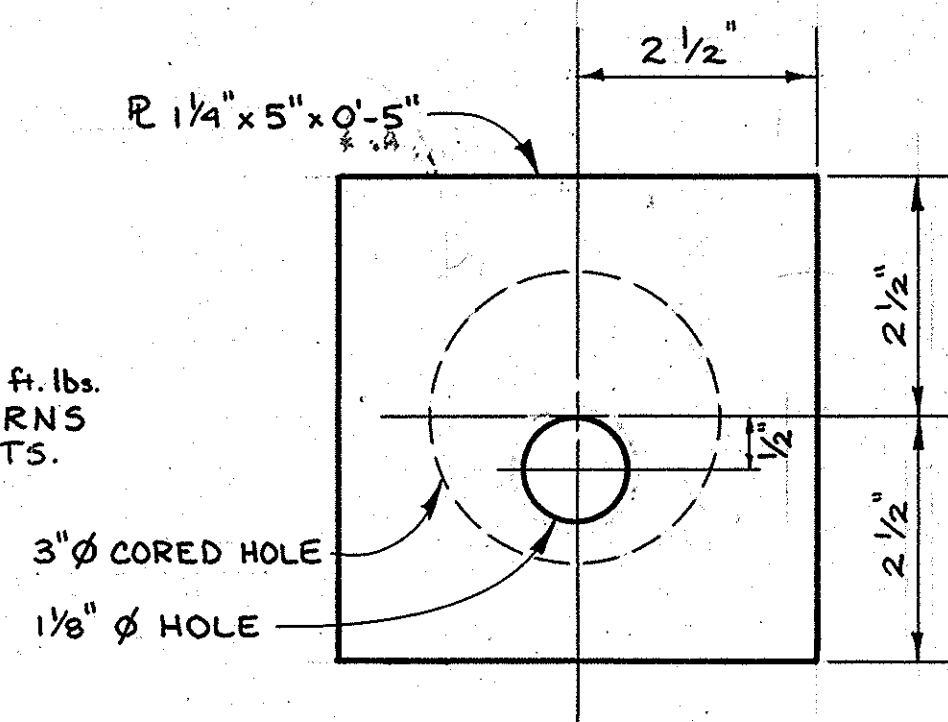


BEARING PLATE DETAIL

NO SCALE

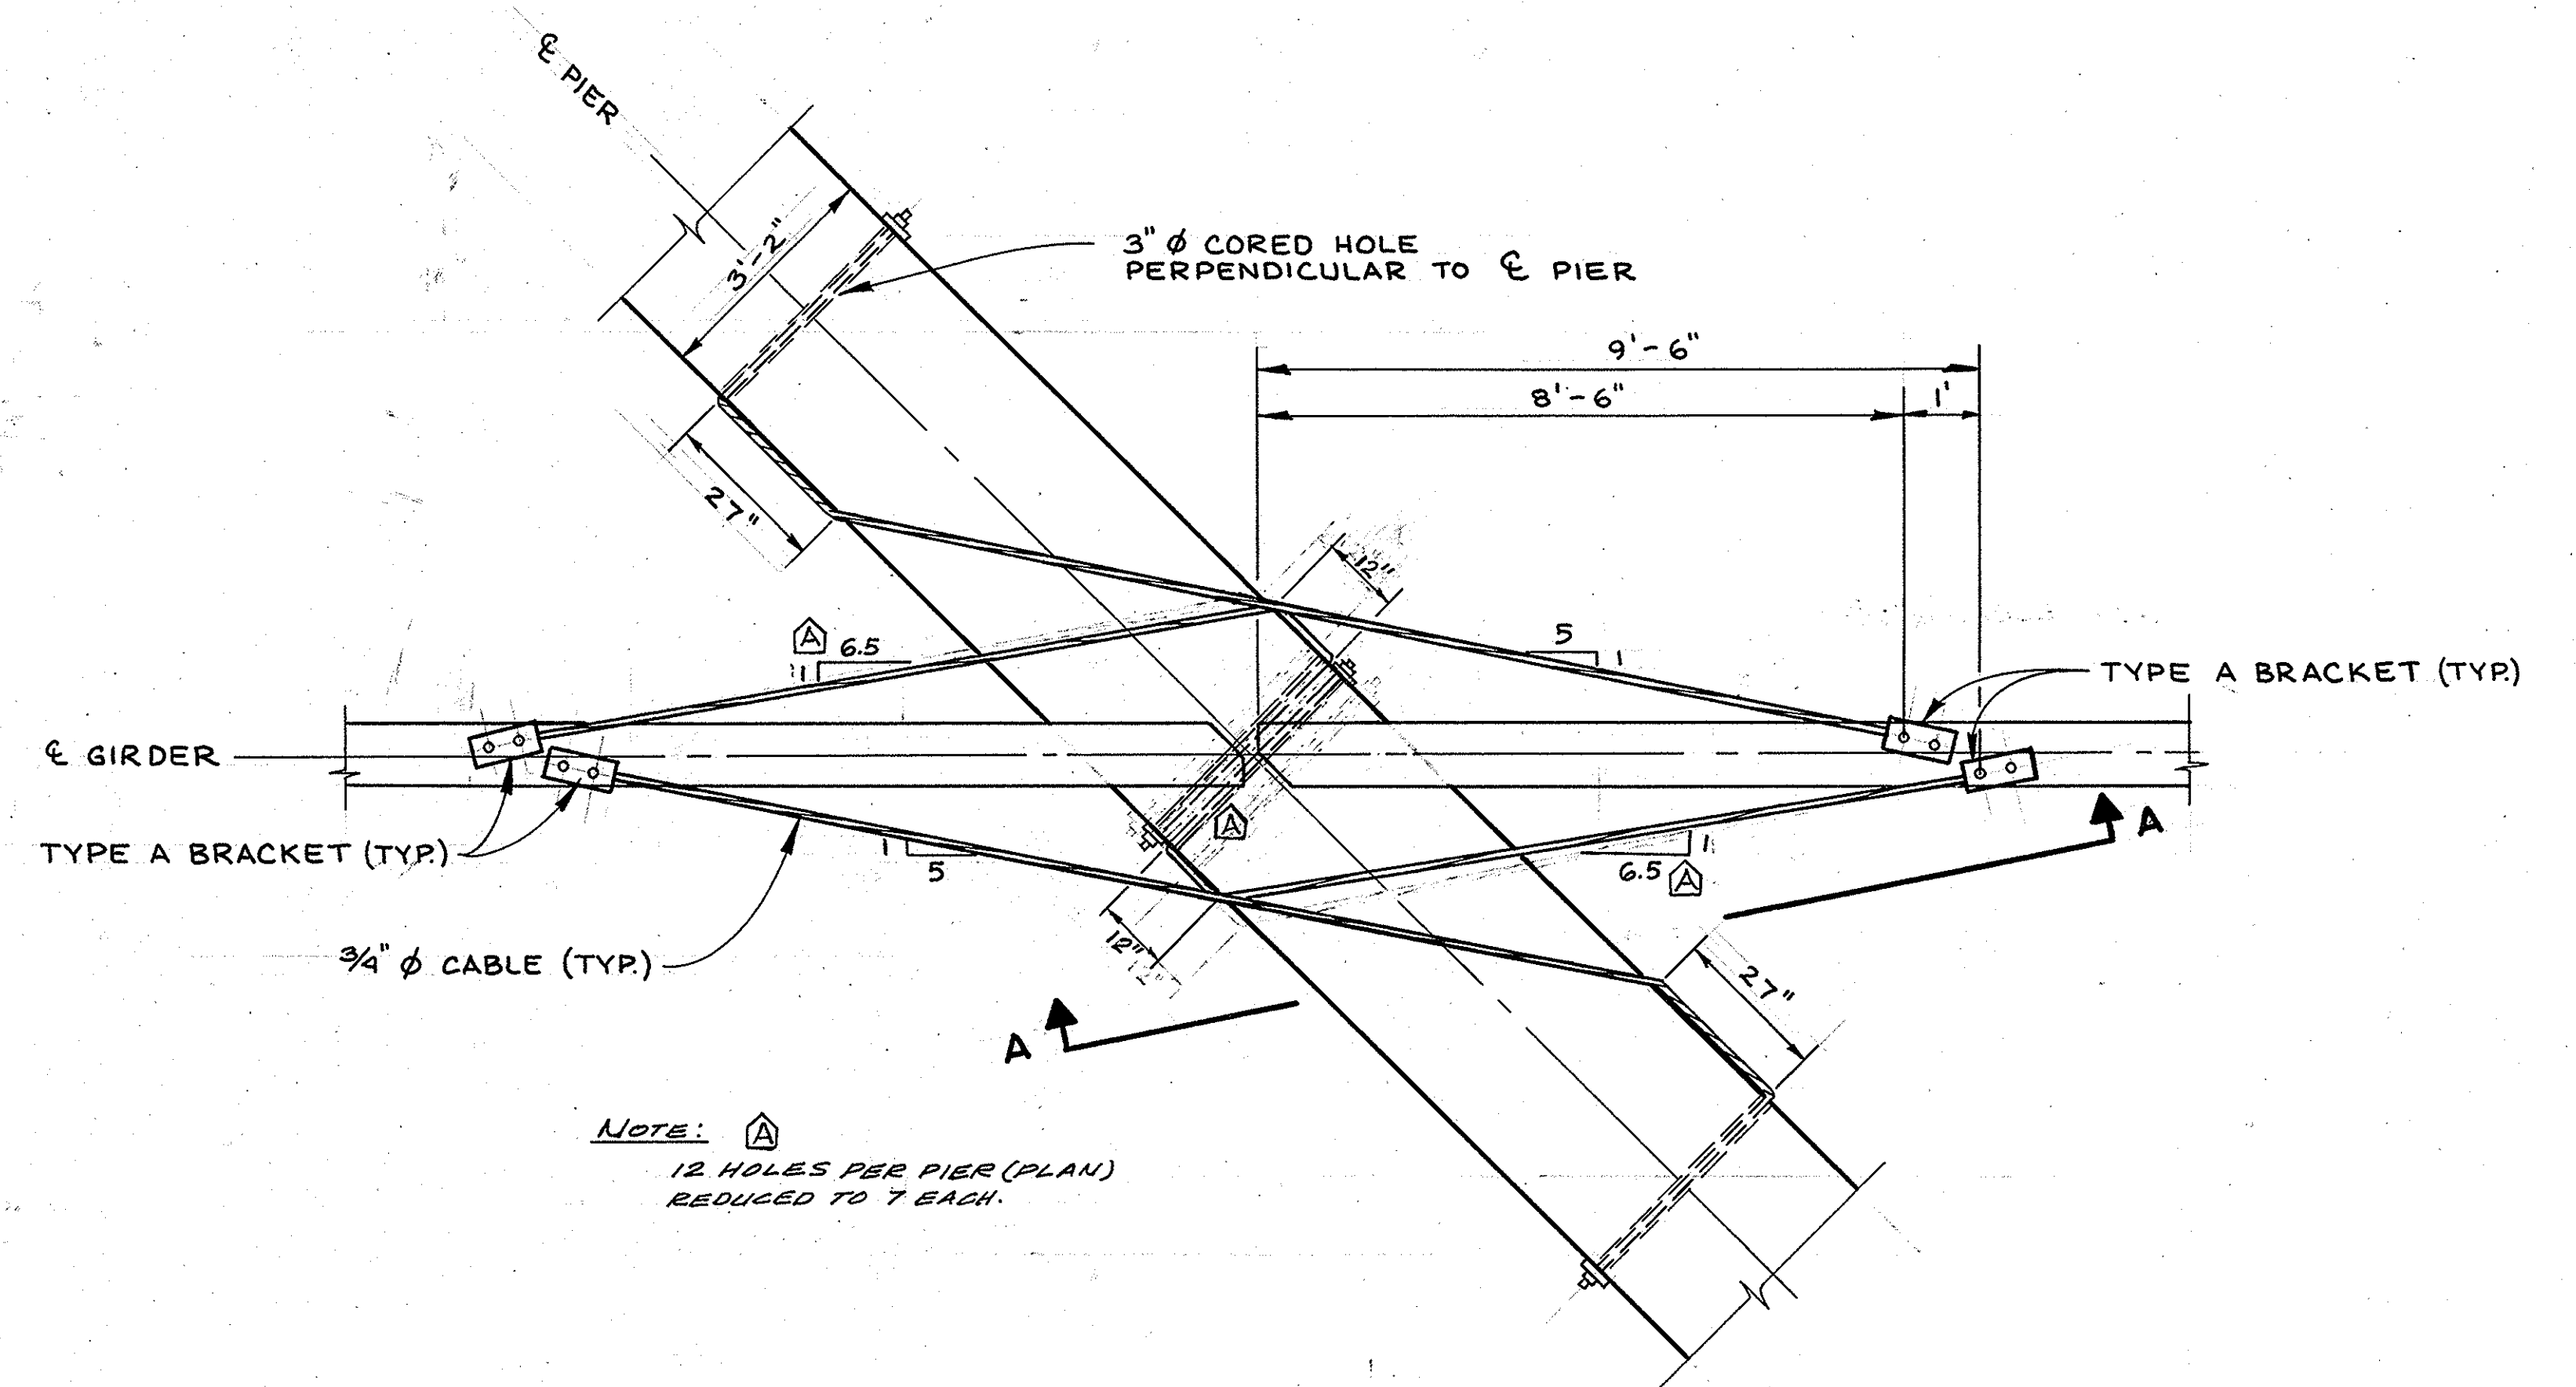

PLAN VIEW

NO SCALE

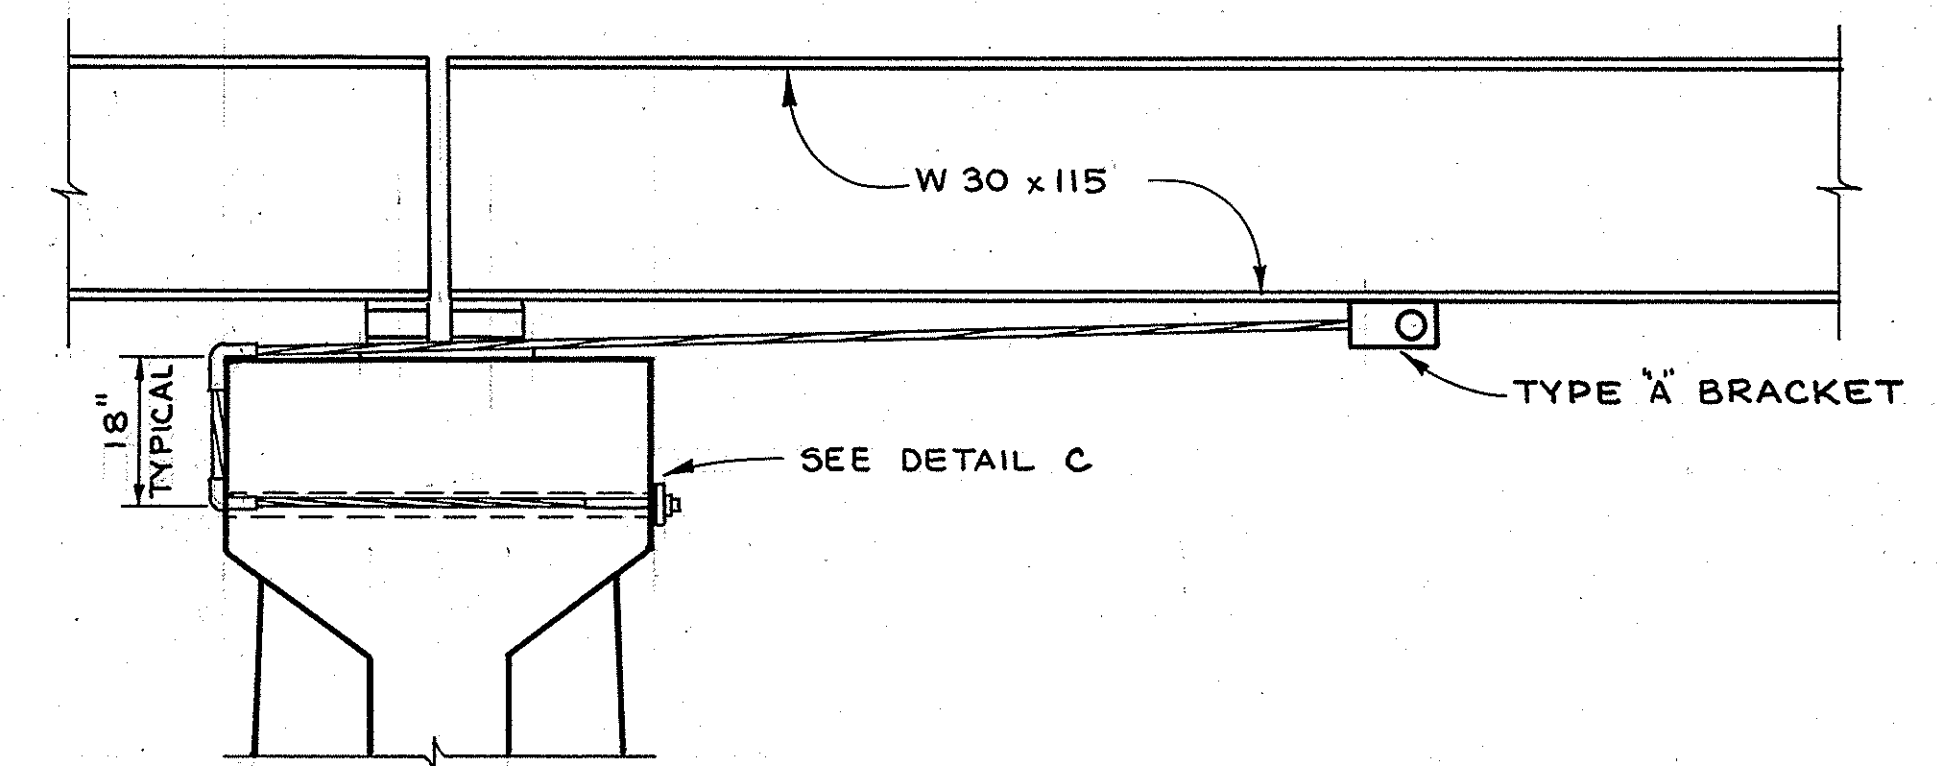

SECTION A-A

NO SCALE

1/2 0 1 2
3 inches on original drawing

NOTE:
THE CONTRACTOR SHALL VERIFY
ALL DEPENDENT DIMENSIONS IN
THE FIELD BEFORE ORDERING
OR FABRICATING ANY MATERIAL.

ORANGE COUNTY ENVIRONMENTAL MANAGEMENT AGENCY			
SEISMIC RETROFIT HARBOR BLVD. BRIDGE SA-28 & SA-28A			
PIER LONGITUDINAL CABLE RESTRAINER LAYOUT & DETAILS			
6-21-84 As BUILT	DATE	DESCRIPTION	PREPARED UNDER SUPERVISION OF <i>Steve W. [Signature]</i> 10/83
REVISIONS			DATE
DESIGNED: M.M.Hsu	SCALE	DATE	DWG. NO.
DRAWN: B.Munoz	CHECKED	AS SHOWN	10/83