
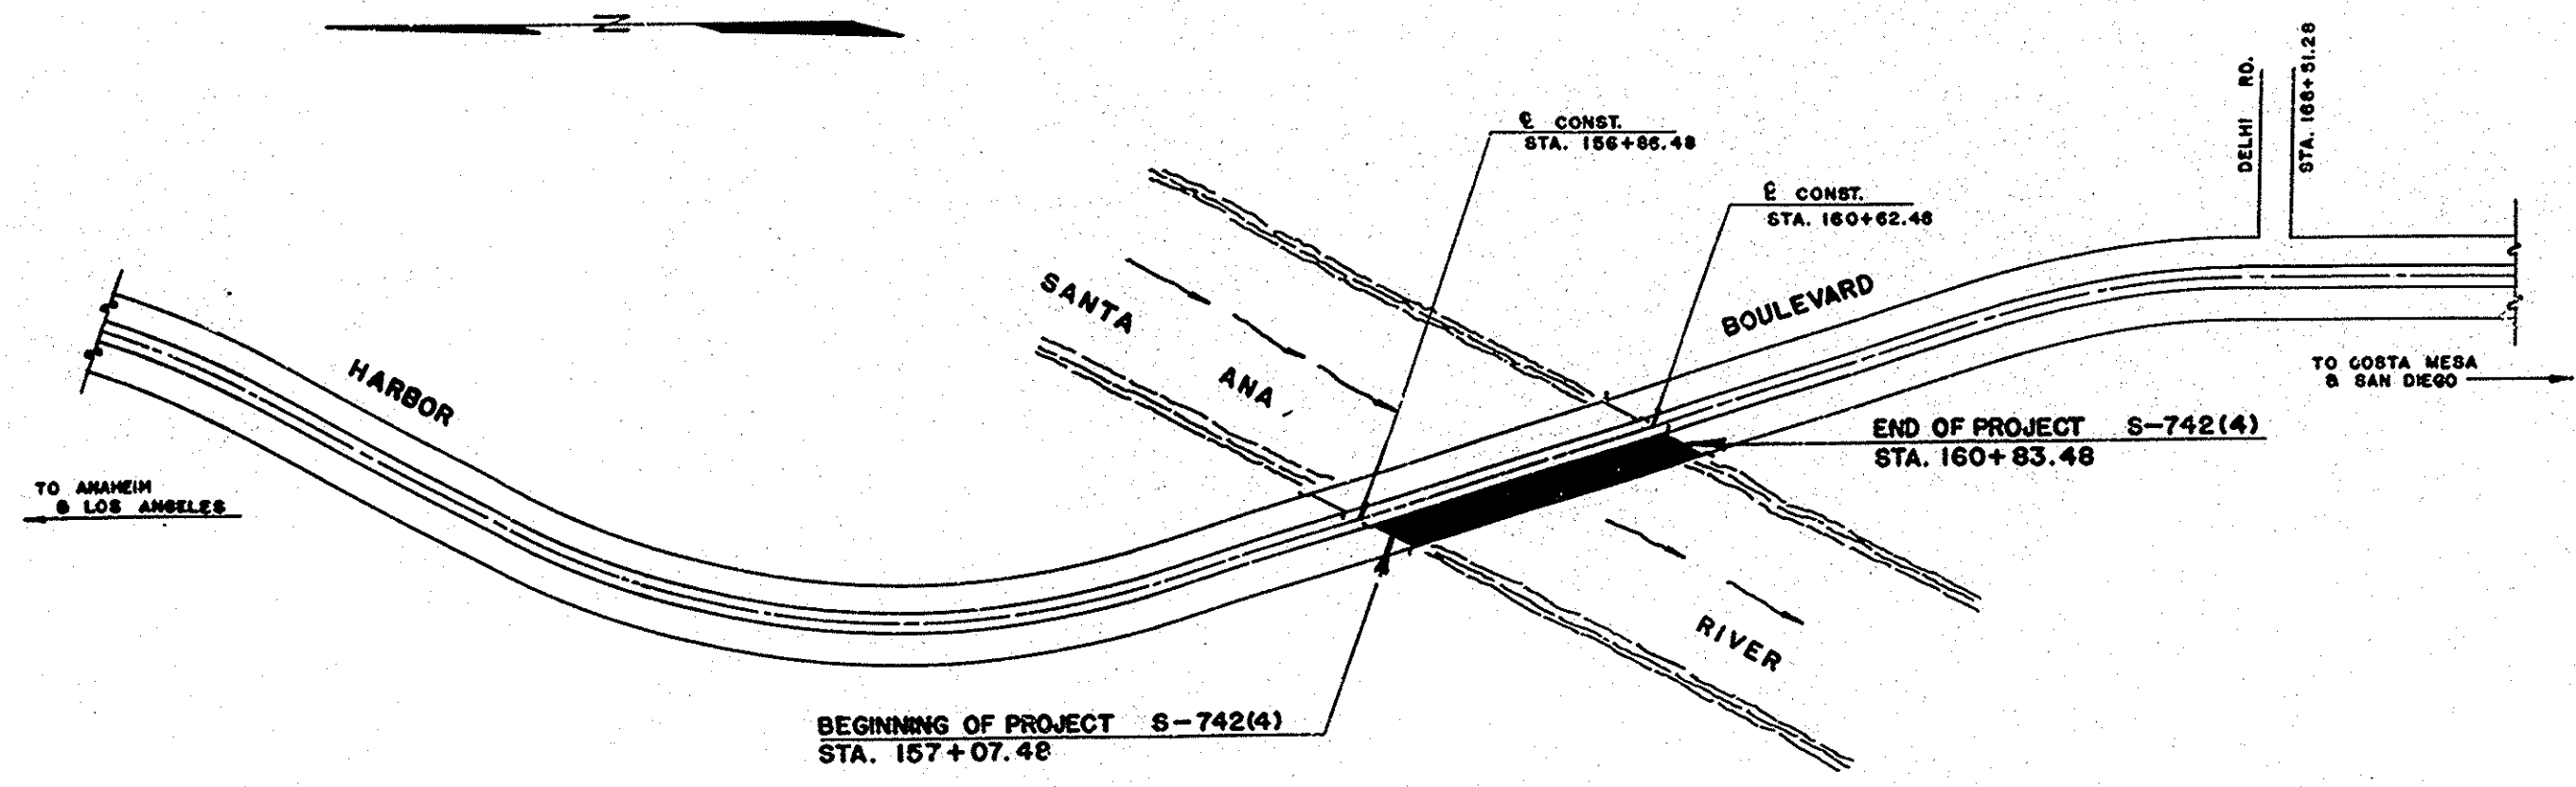
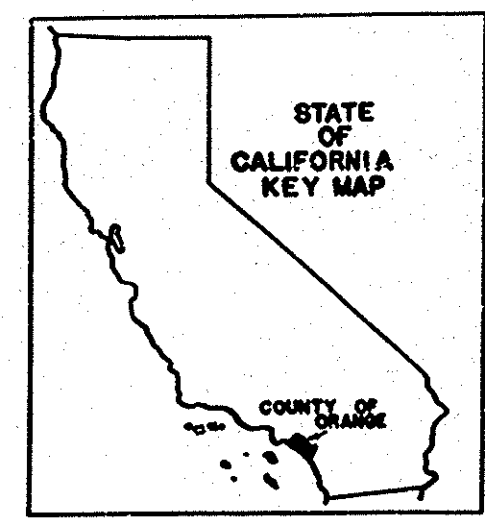



PUB. ROAD DIST. NO.	STATE	PROJECT NO.	FISCAL YEAR	SHEET NO.	TOTAL SHEETS
VII	ORA.	S-742(4)	1957	1.	15

INDEX OF SHEETS	
SHEET NO. 1	TITLE SHEET
" 2	GENERAL PLAN
" 3	FOUNDATION PLAN
" 4	ABUTMENT DETAILS
" 5	PIER DETAILS
" 6	MISCELLANEOUS DETAILS
" 7	GIRDER LAYOUT & DECK REINFORCEMENT
" 8	TYPICAL SECTION & GIRDER REINFORCEMENT
" 9	LONGITUDINAL TOP REINFORCEMENT
" 10	CONCRETE RAILING
" 11	LOG OF TEST BORINGS
" 12	STRUCTURE EXCAV. & BACKFILL
" 13	PILE DETAIL
" 1A-2A	APPROACHES (NOT TO BE COVERED BY THIS CONTRACT.)

STATE OF CALIFORNIA
DEPARTMENT OF PUBLIC WORKS
DIVISION OF HIGHWAYS
COUNTY OF ORANGE
PLAN
FEDERAL AID SECONDARY PROJECT
NO. S-742(4)
HARBOR BOULEVARD
ACROSS SANTA ANA RIVER BETWEEN
COSTA MESA AND GARDEN GROVE
TOTAL LENGTH 0.071 MILES

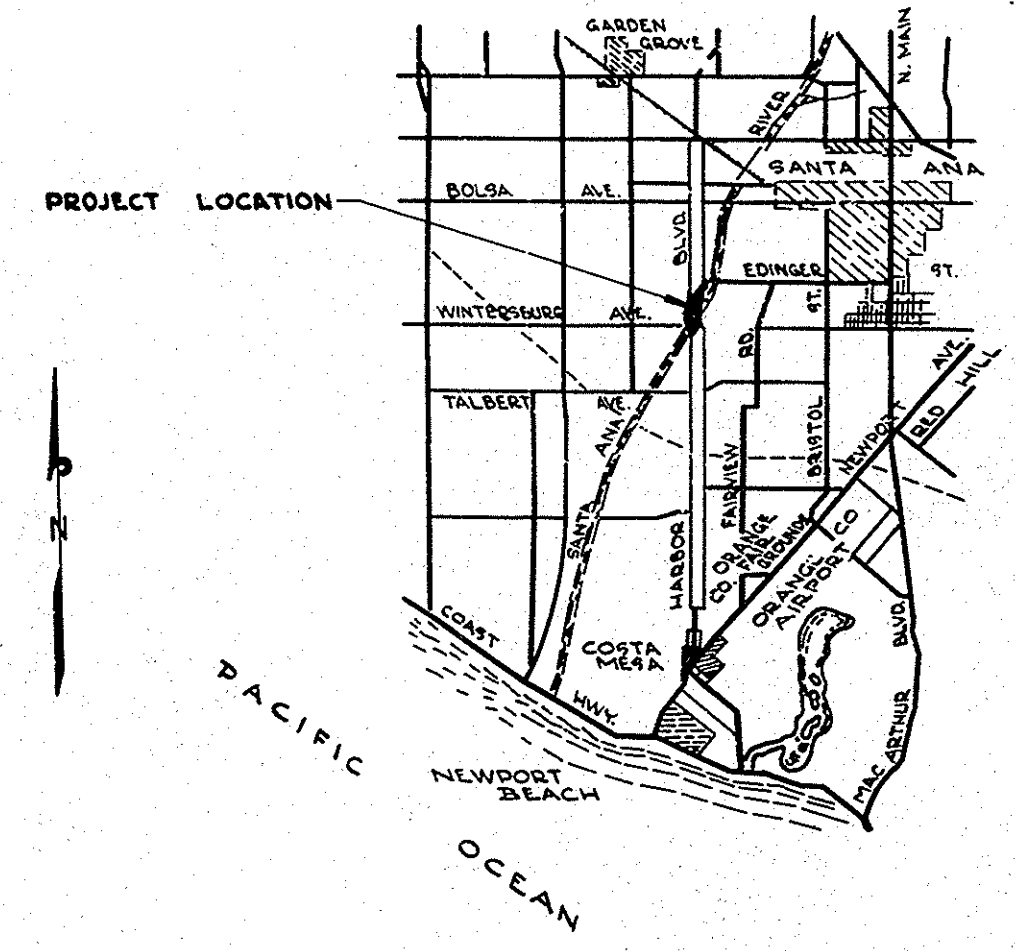

CONVENTIONAL SIGNS	
COUNTY LINE	BANK-RETAINING WALL
CITY-TOWN LIMITS	LEVEE
TOWNSHIP LINE	CULVERTS
SECTION LINE	DROP INLETS
GRANT LINE	TROLLEY POLE
FENCE	POWER POLE
GUARD RAIL	POWER TOWER
UNFENCED PROPERTY	TELEGRAPH POLE
R/W LINE	TELEPHONE POLE
BASE OR SURVEY LINE	MARSH
TRAVELLED WAY	
RAILROAD TRACKS	

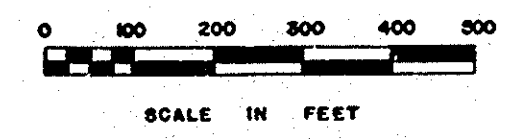

[Signature]
BRIDGE ENGINEER LIC. NO. 5585

COUNTY OF ORANGE
[Signature]
ROAD COMMISSIONER
CIVIL ENGINEER LICENSE NO. 7872

[Signature]
CHAIRMAN OF BOARD OF SUPERVISORS

STATE OF CALIFORNIA
[Signature]
DISTRICT ENGINEER - DIST. VII
APPROVED September 10, 1957

[Signature]
STATE HIGHWAY ENGINEER
CIVIL ENGINEER LICENSE NO. 2084

As BUILT CHANGES
IN RED INK.
9-8-58

MICROFILMED
JUL 1 1960

SA-28A

NO CHANGES THIS SHEET

Q5755-1
#14643 1957
SA-28A
HARBOR BLVD S/BOUND (WIDENING)
55C-OIL
Th. 828-J7