


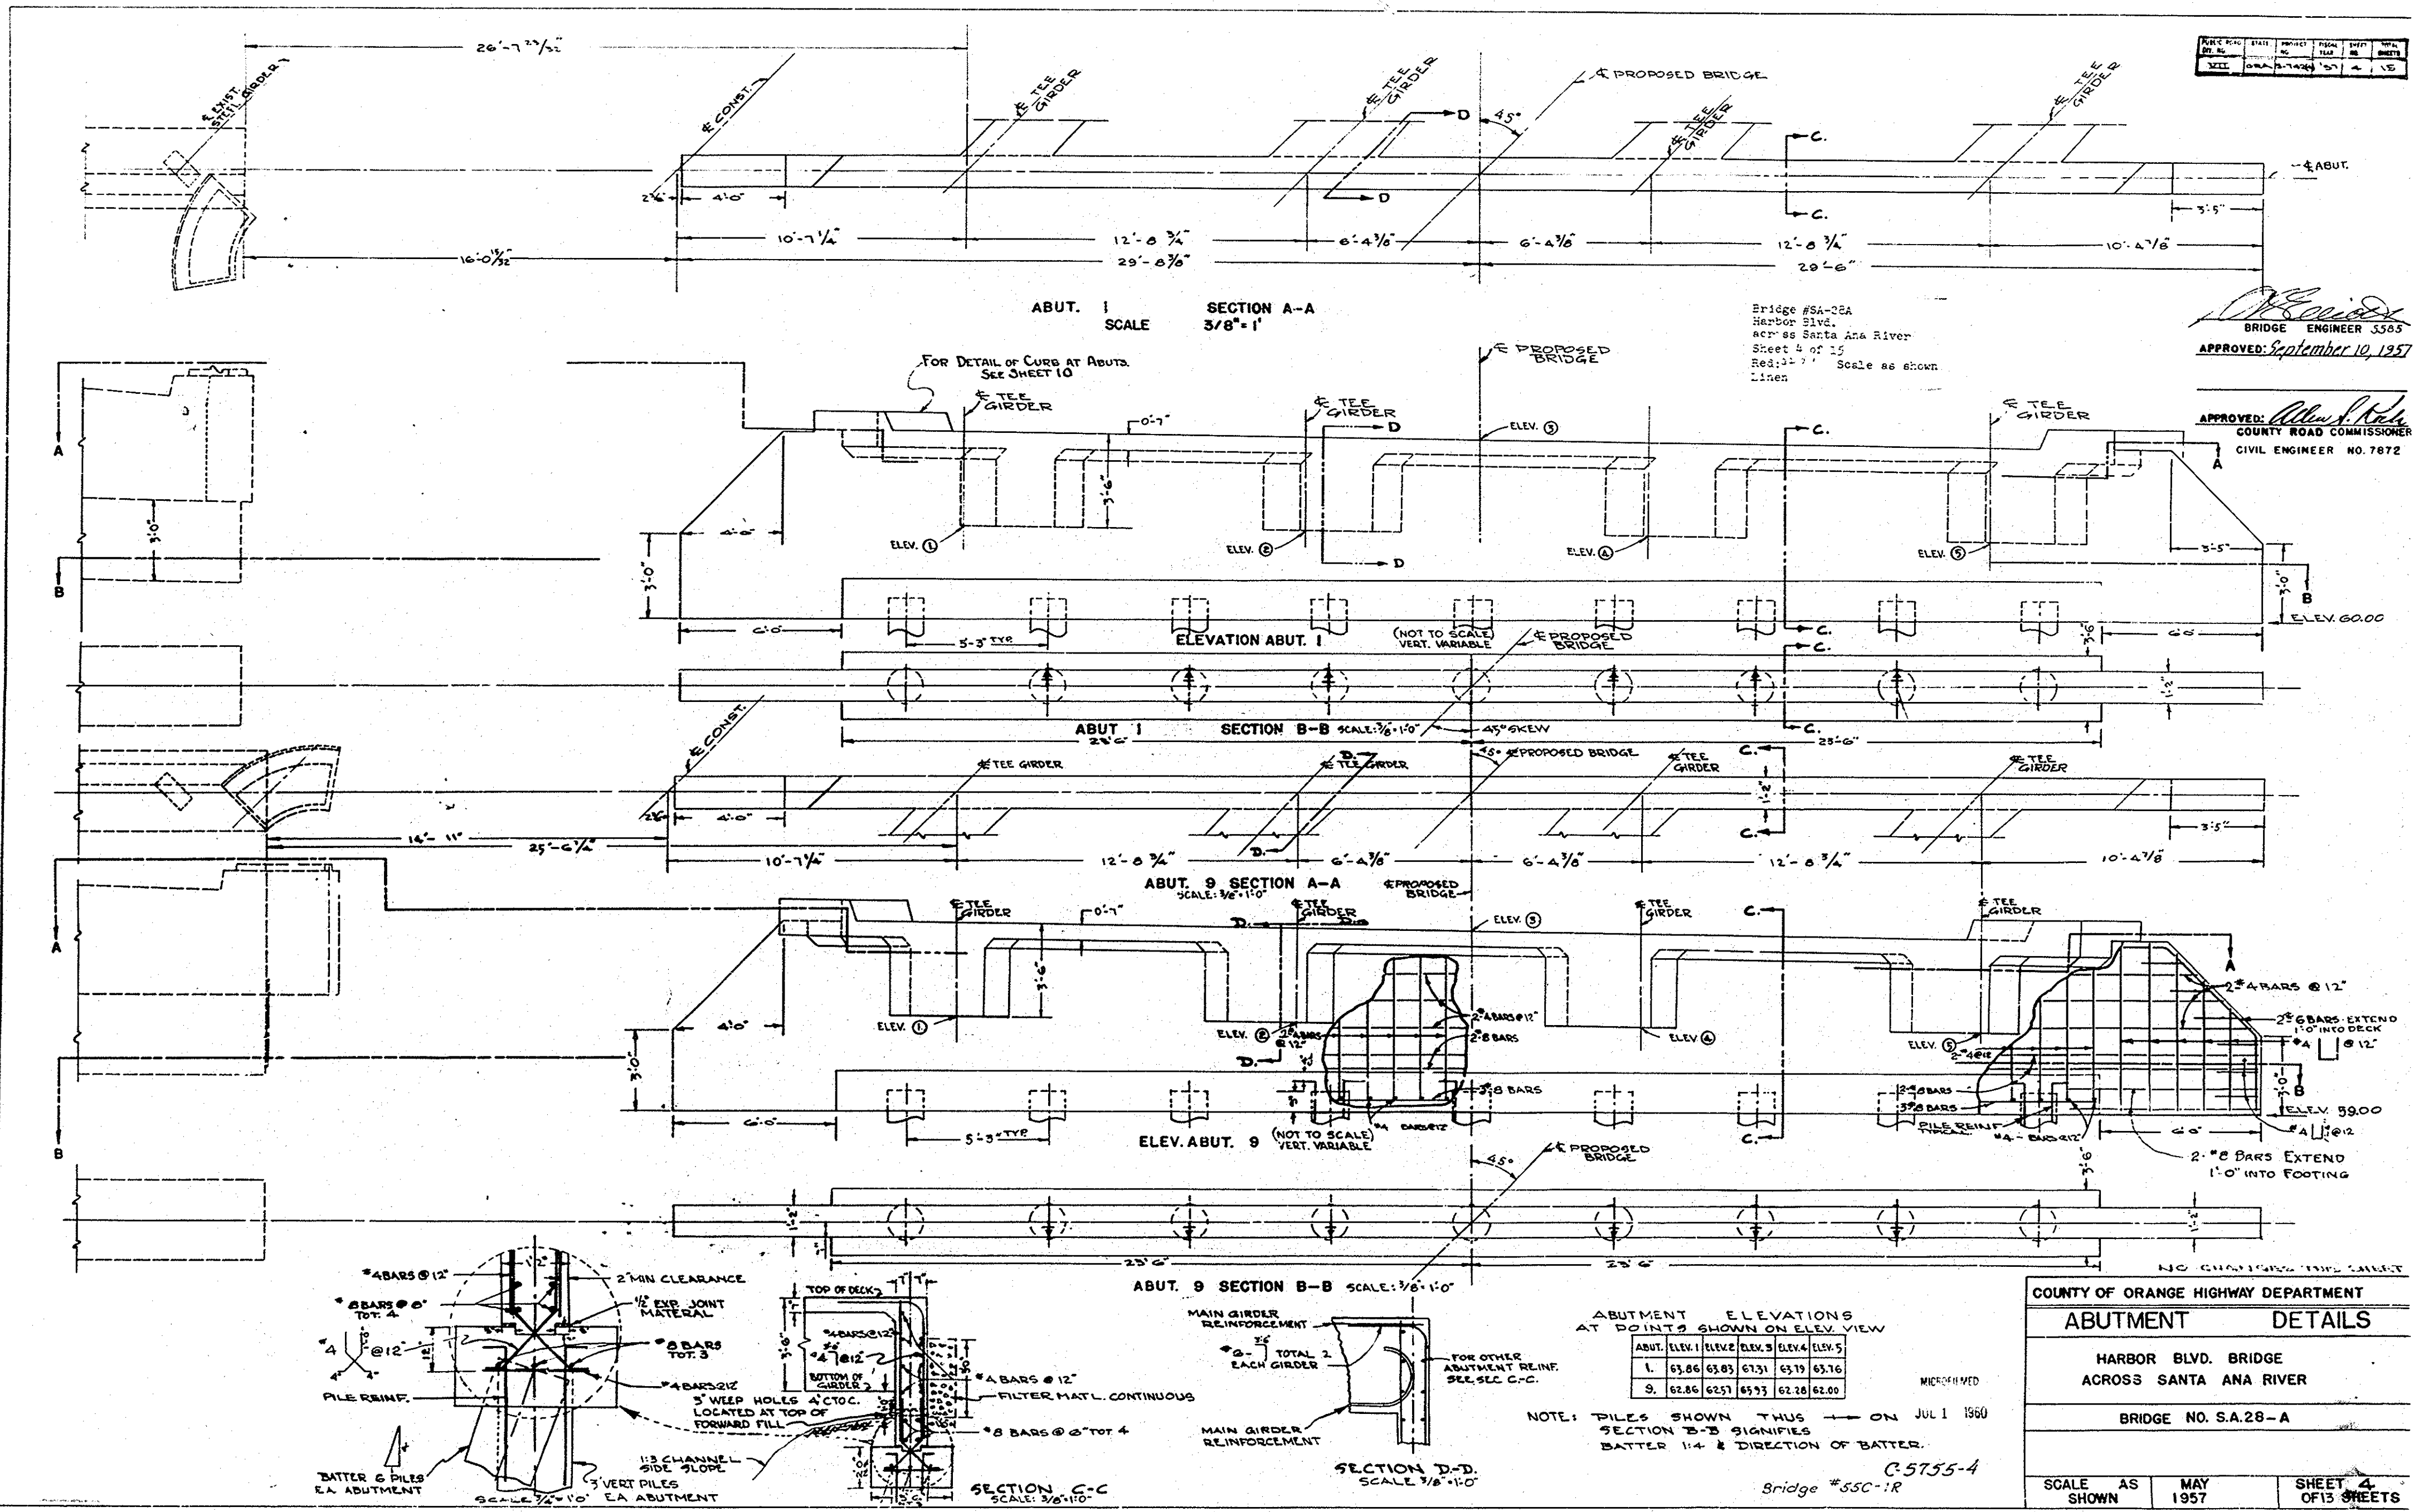

Bridge #5A-25A
Harbor Blvd.
across Santa Ana River
Sheet 4 of 15
Red. 11-7-57 Scale as shown
Linen

Alfred S. K...
BRIDGE ENGINEER 5505
APPROVED: September 10, 1957
Alfred S. K...
COUNTY ROAD COMMISSIONER
CIVIL ENGINEER NO. 7872

ABUTMENT ELEVATIONS
AT POINTS SHOWN ON ELEV. VIEW

ABUT. ELEV. 1	ELEV. 2	ELEV. 3	ELEV. 4	ELEV. 5
1. 63.86	63.83	63.31	63.19	63.76
9. 62.86	62.57	63.73	62.78	62.00

NOTE: PILES SHOWN THUS ON SECTION B-B SIGNIFY BATTER 1/4" & DIRECTION OF BATTER.

C-5755-4
Bridge #55C-1R

COUNTY OF ORANGE HIGHWAY DEPARTMENT		
ABUTMENT DETAILS		
HARBOR BLVD. BRIDGE ACROSS SANTA ANA RIVER		
BRIDGE NO. S.A.28-A		
SCALE AS SHOWN	MAY 1957	SHEET 4 OF 13 SHEETS