
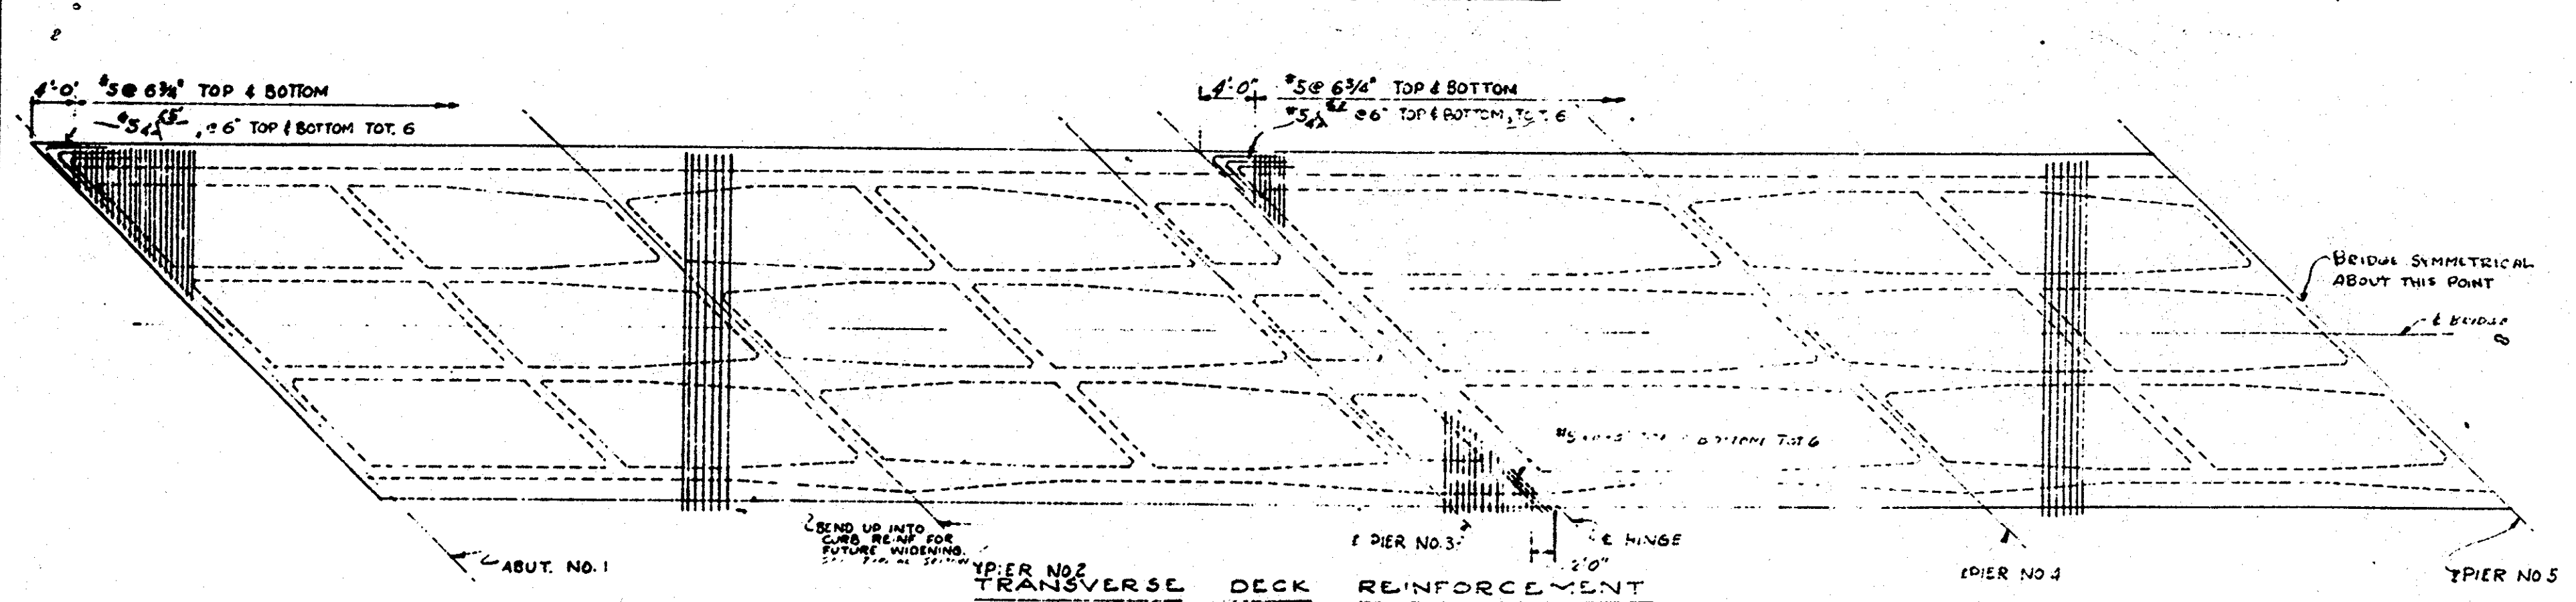
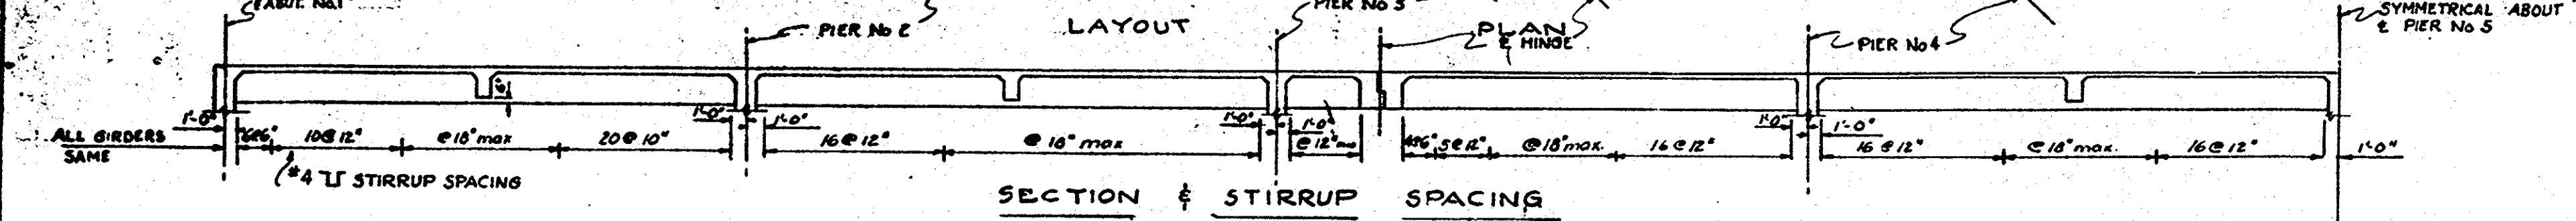


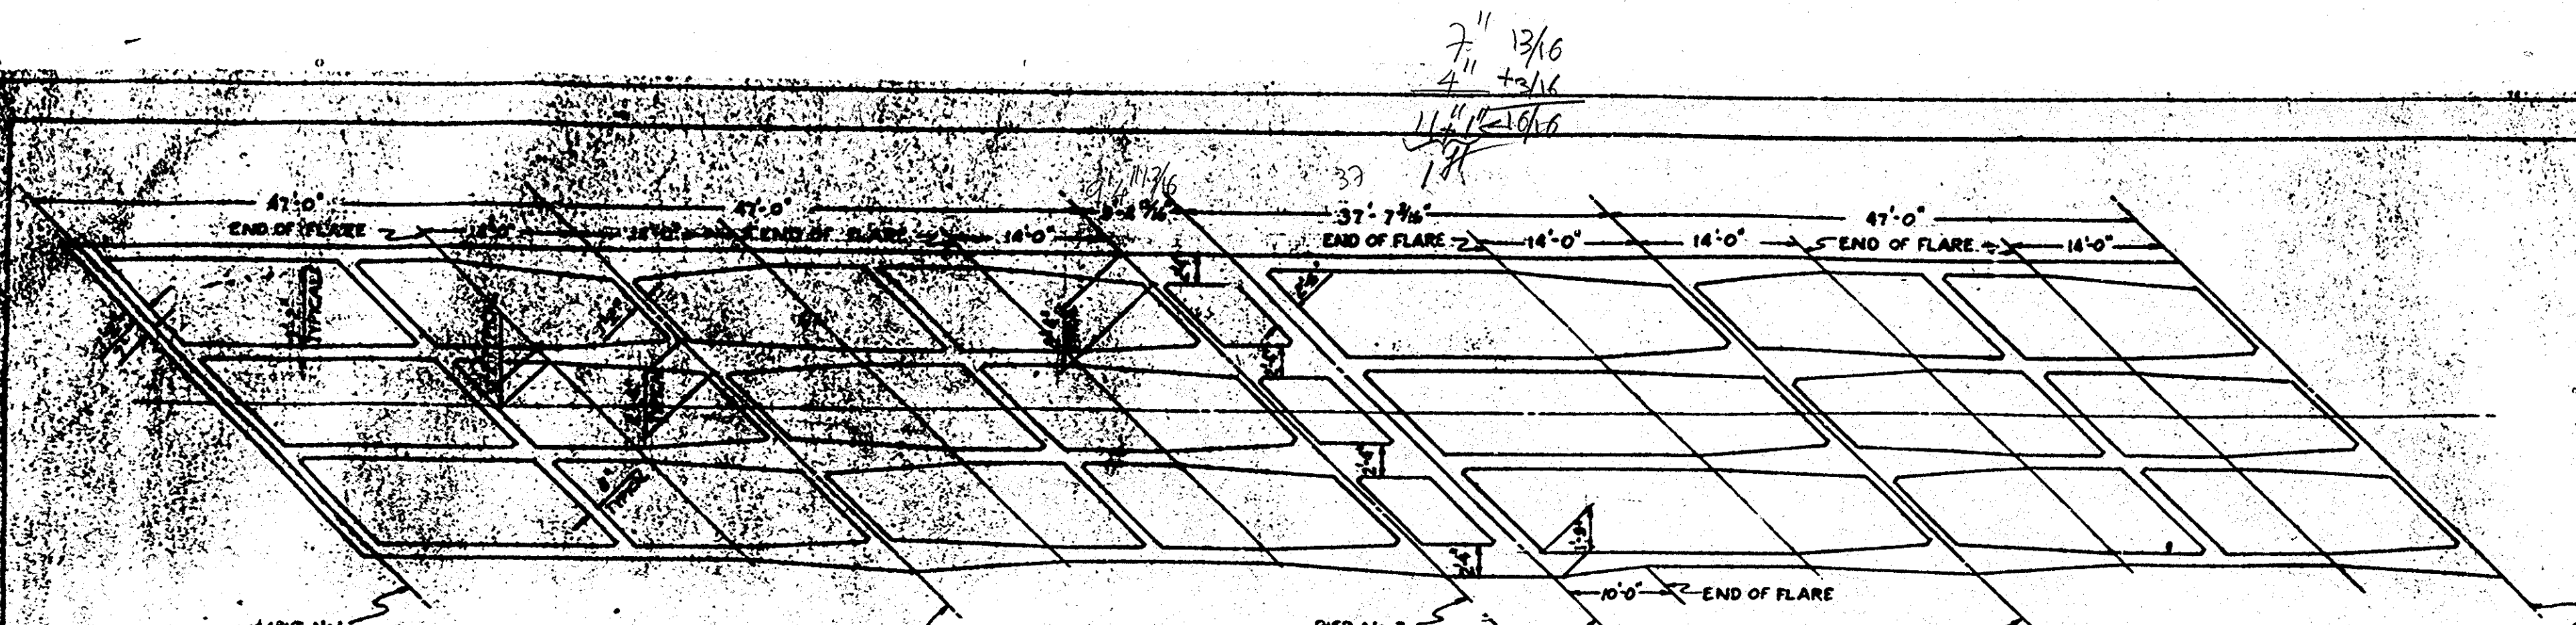

Bridge #8A-28-A
Harbor Blvd.
Across Santa Ana River
Sheet 7 of 13
Scale 1/8"=1'
Blackline Print

AS BUILT

CORRECTIONS BY _____
CONTRACT NO. 58-14DDC28-P
NO CORRECTIONS THIS SHEET
D.C. [Signature]

COUNTY OF ORANGE HIGHWAY DEPT.		
GIRDER LAYOUT & REINFORCEMENT		
HARBOR BLVD. BRIDGE ACROSS SANTA ANA RIVER		
BRIDGE NO. 8A-28-A		
MICROFILMED		
JUN 30 1960		
SCALE 1/8" = 1'-0"	MAY 1957	SHEET 7 OF 13 SHEETS

Br. No. 55C-1R

C5755-7

SA-28-A