


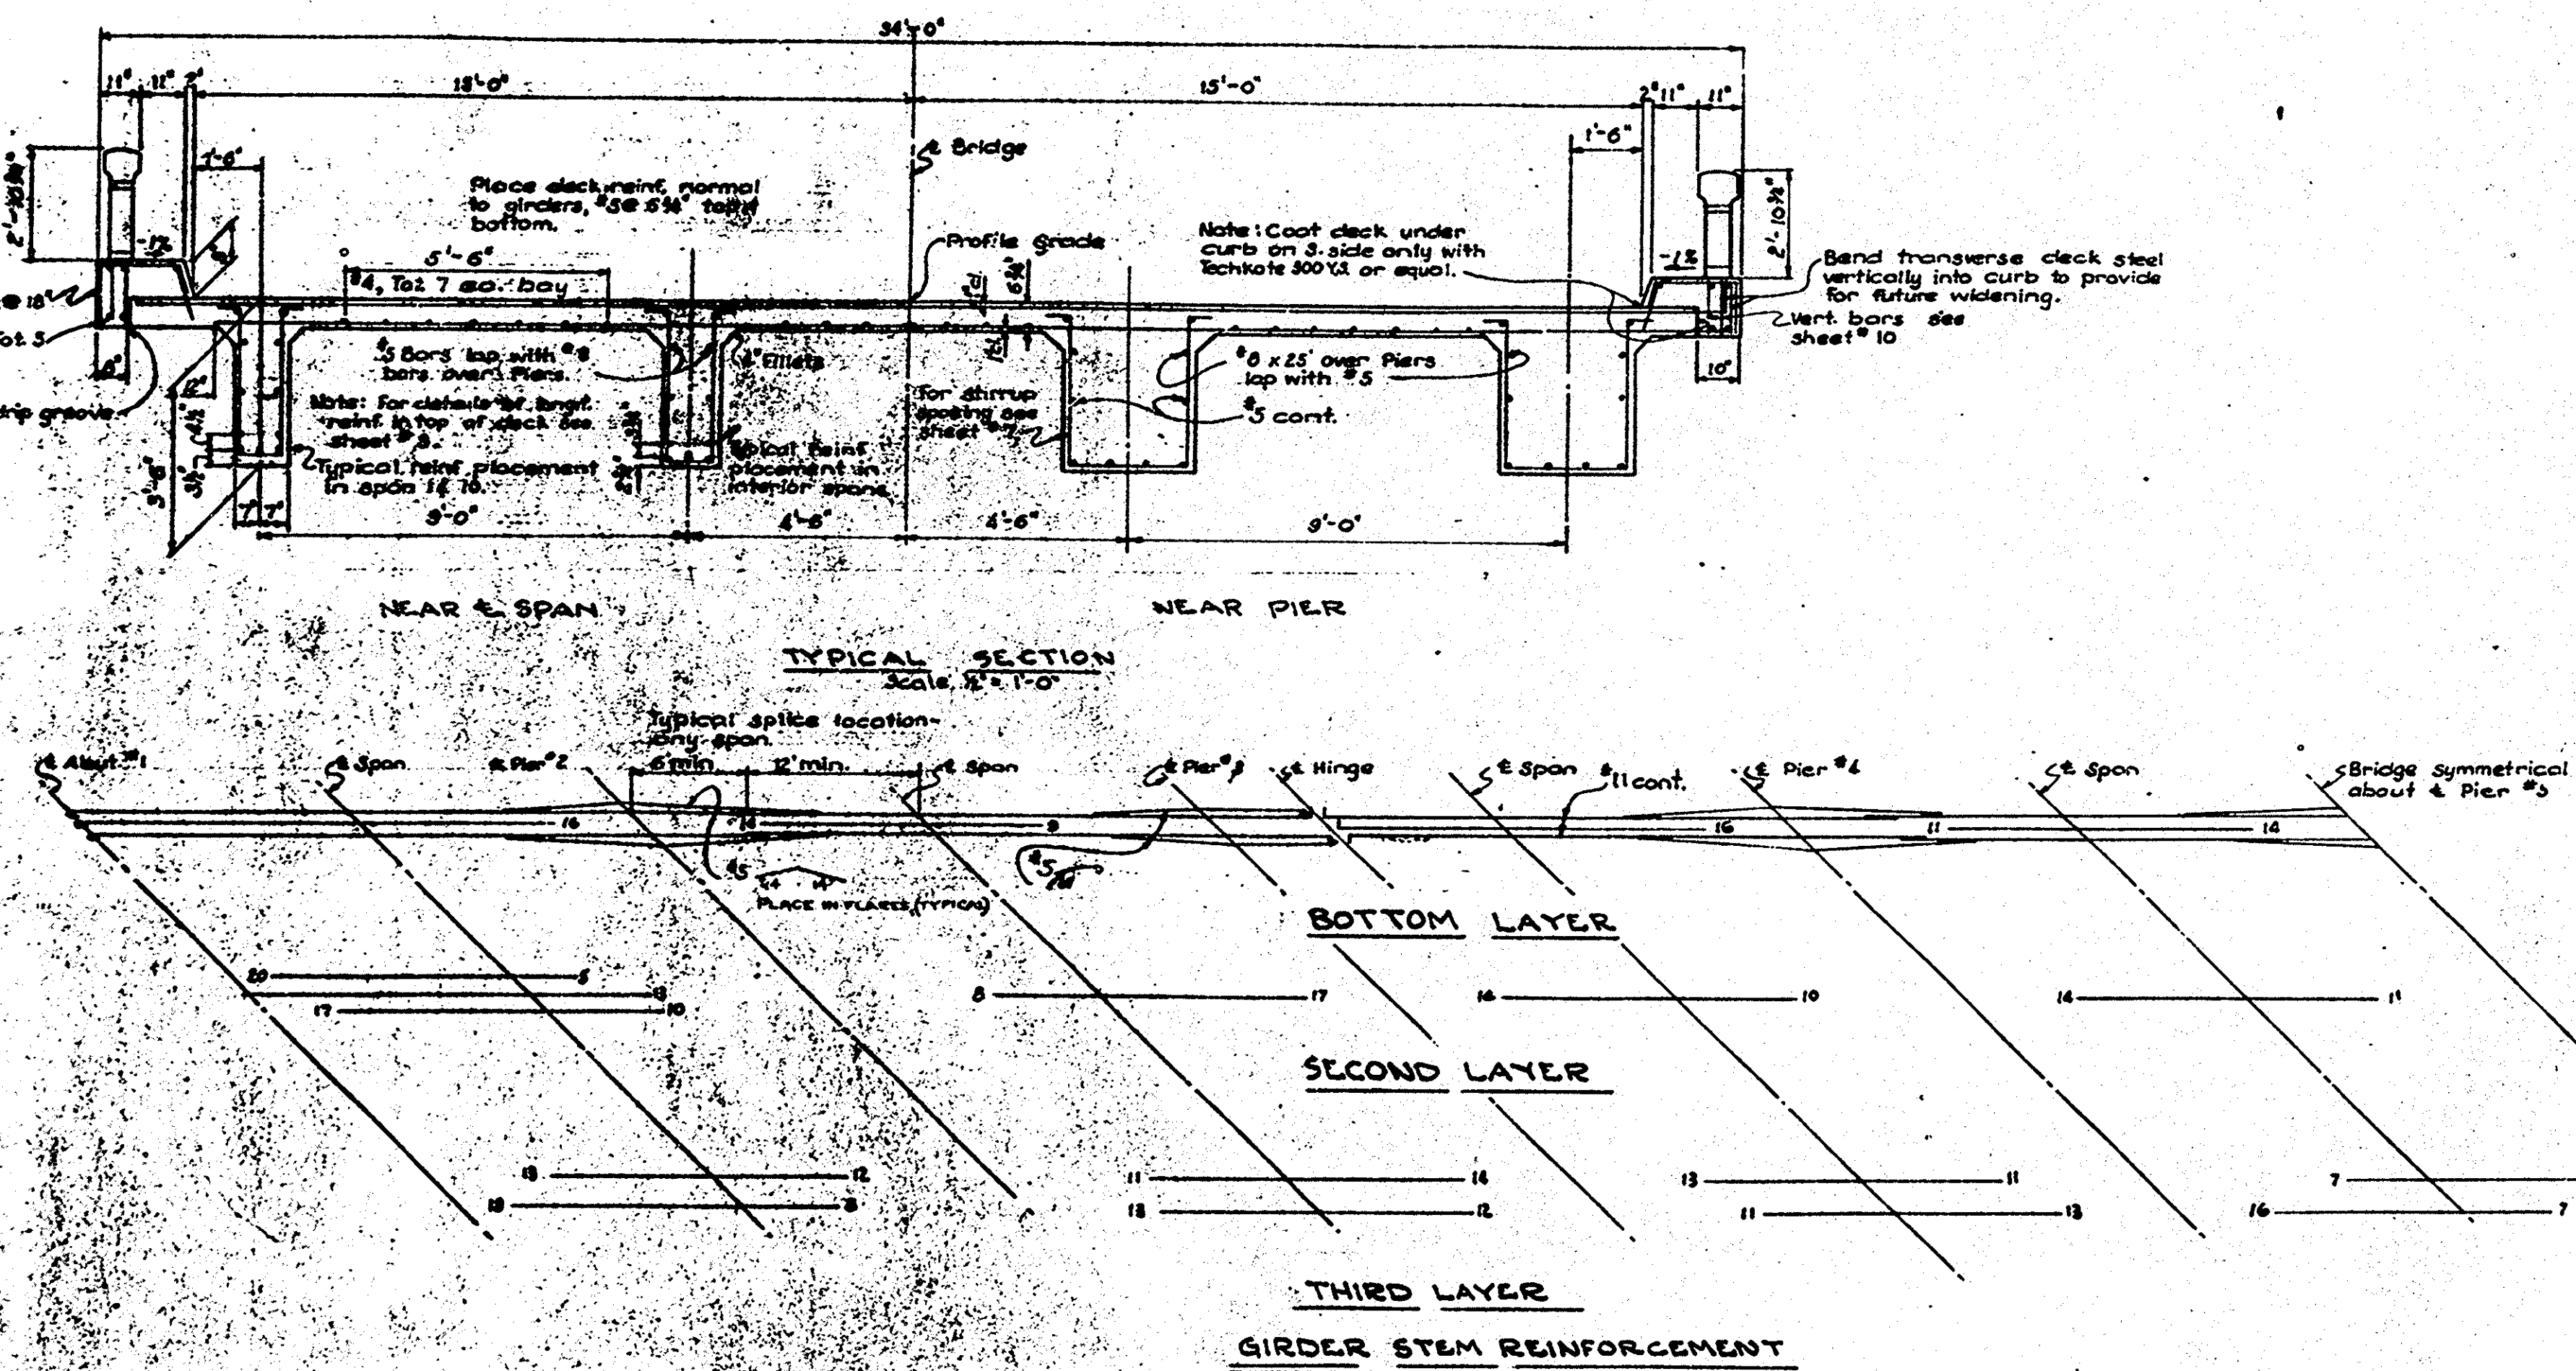

Note: All bars ^a 11, except as noted.
Numbers at ends of bars indicate
distances in feet from A Pier to C
Pier.

Bridge #8A-28-A
Harbor Blvd.
Across Santa Ana River
Sheet 8 of 13
Rep 225-1 Scale as shown
Blackline Print

AS BUILT
 CONNECTIONS BY _____
 CONTRACT NO. 58-142DC28-P
 NO CORRECTIONS THIS SHEET
H. C. Christman

MICROFILMED
JUN 30 1960
C5755-8

COUNTY OF ORANGE HIGHWAY DIST.		
TYPICAL SECTION & ORDER REINFORCEMENT		
HARBOR BLVD BRIDGE ACROSS SANTA ANA RIVER		
BRIDGE NO. S.A. 18-A		
SCALE 1" = 4'-0"	MAY 1954	THET 1954