

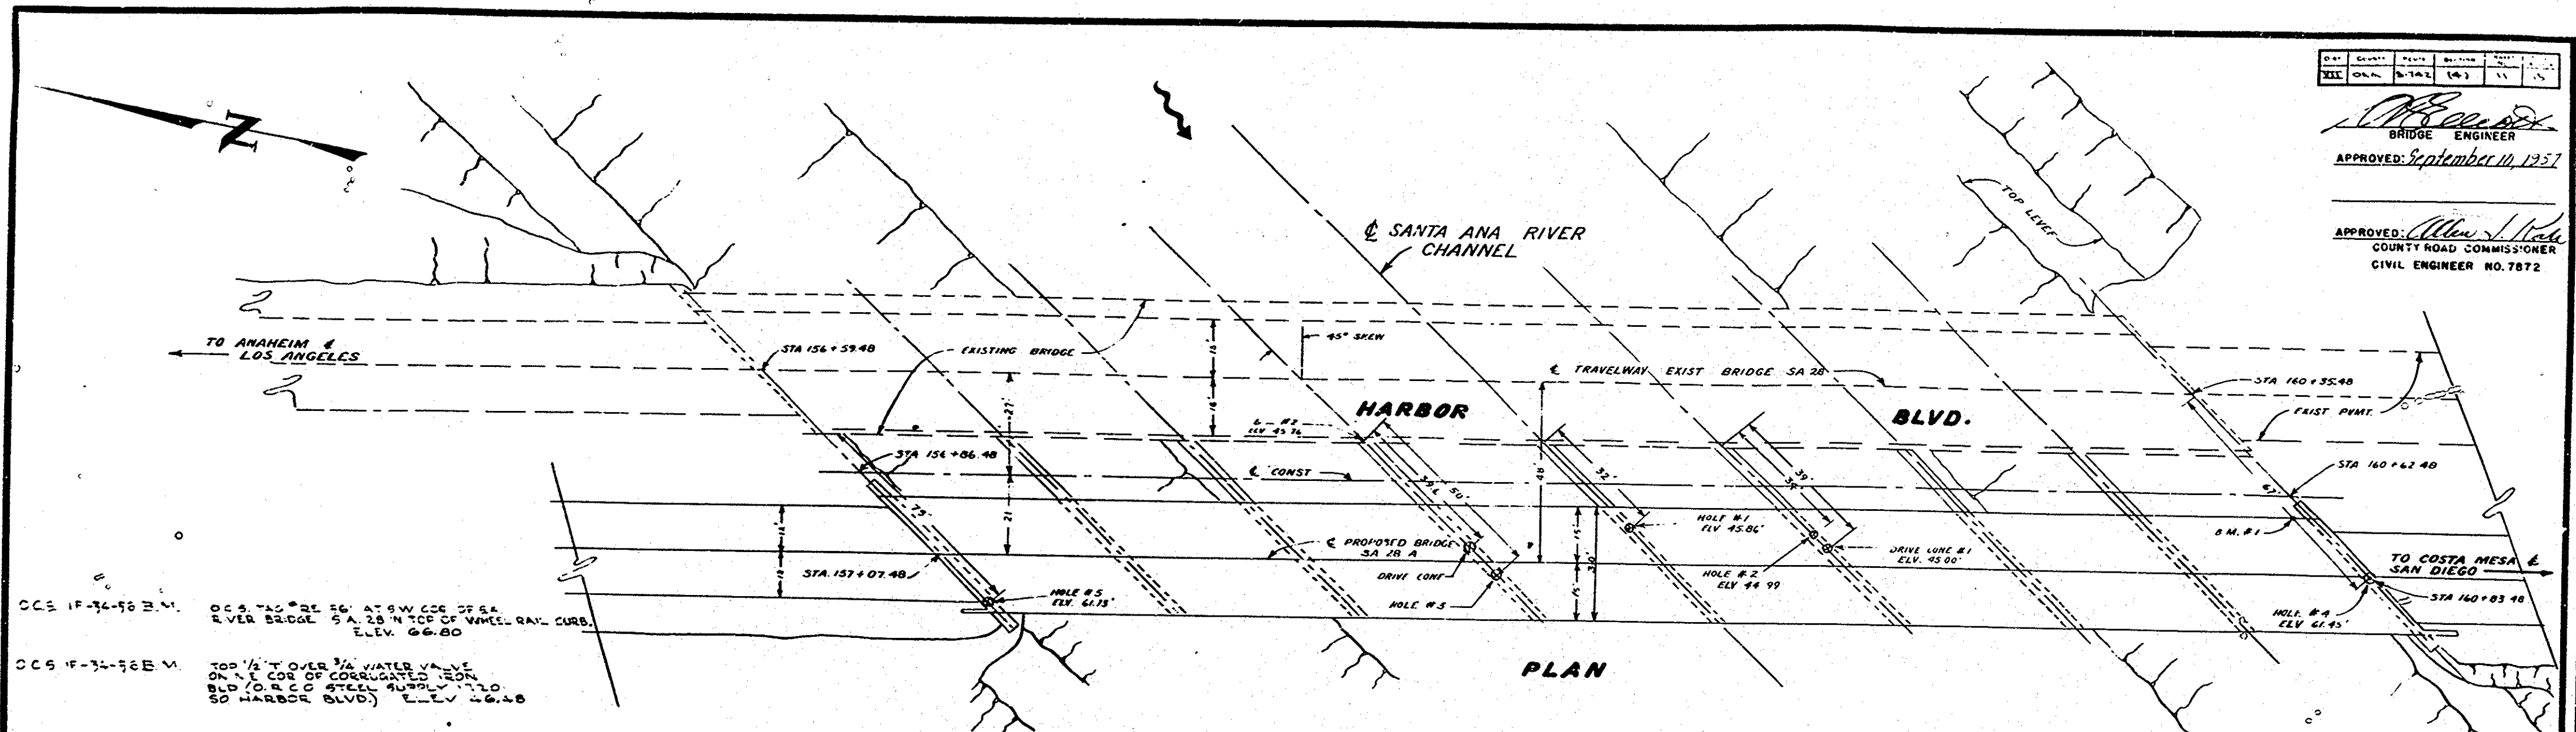


BRIDGE DEPARTMENT

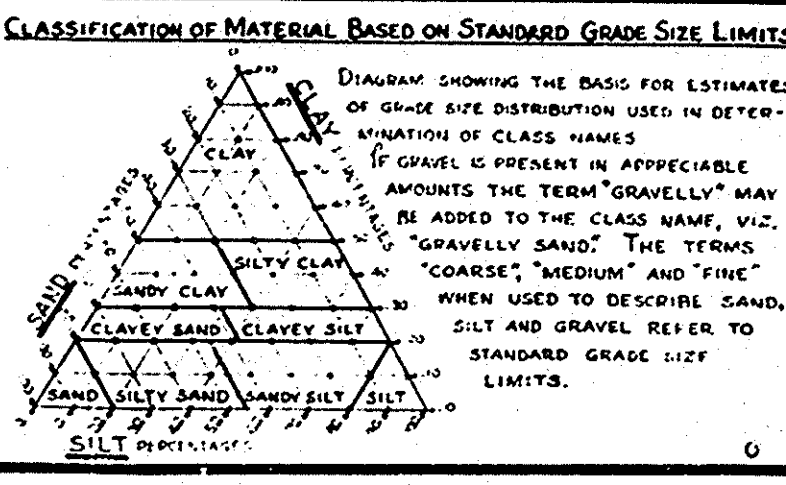


APPROVED: *[Signature]*
BRIDGE ENGINEER
APPROVED: *[Signature]*
COUNTY ROAD COMMISSIONER
CIVIL ENGINEER NO. 7872

CCS 1F-36-58 E.M.
CCS 1F-36-58 E.M.
TOP 1/2" OVER 3/4" WATER VALVE
ON 1/2" COR OF CORRUGATED IRON
BLD FOR CO STEEL TUBES 1710
50 HARBOR BLVD. ELEV 46.48

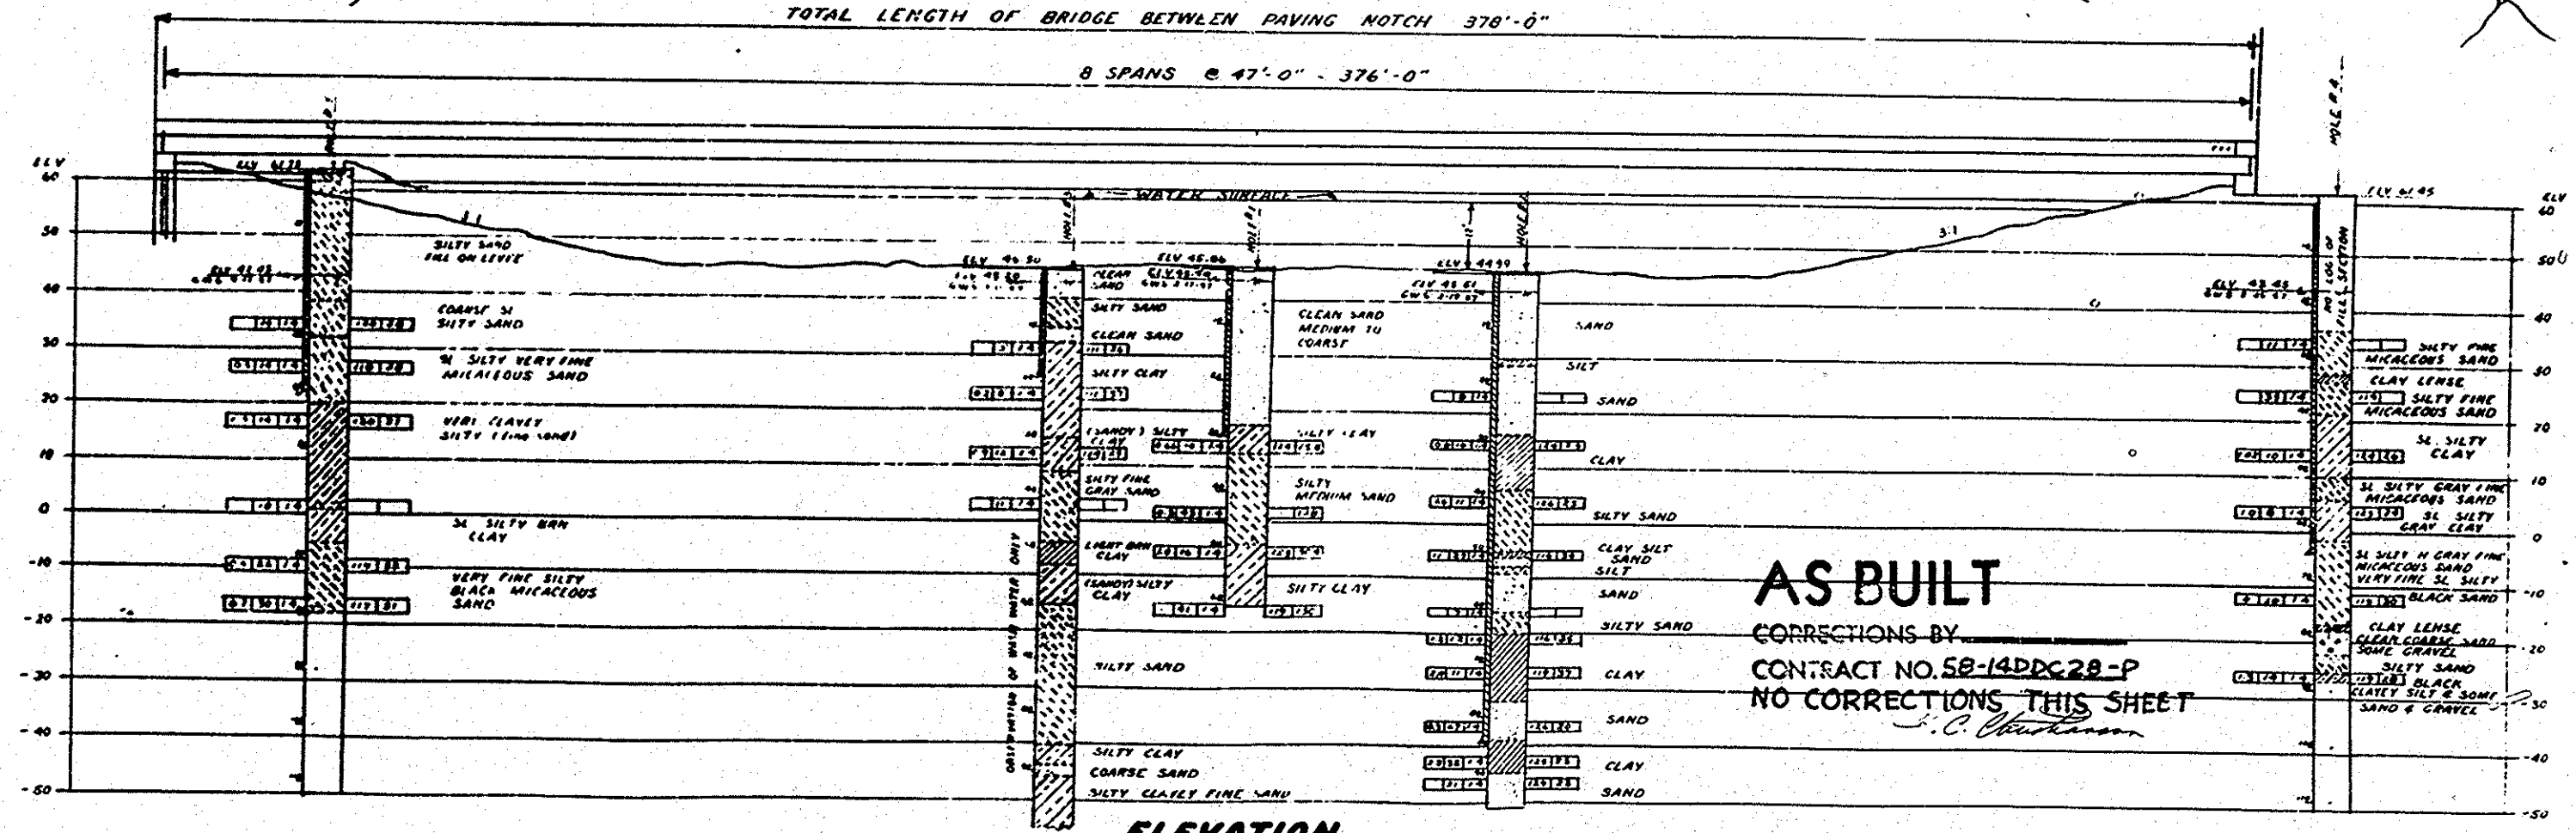

LEGEND OF EARTH MATERIALS

GRAVEL	SILTY CLAY OR CLAYEY SILT
SAND	PEAT AND/OR ORGANIC MATTER
SILT	FILL MATERIAL
CLAY	IGNEOUS ROCK
SANDY CLAY OR CLAYEY SAND	SEDIMENTARY ROCK
SANDY SILT OR SILTY SAND	METAMORPHIC ROCK

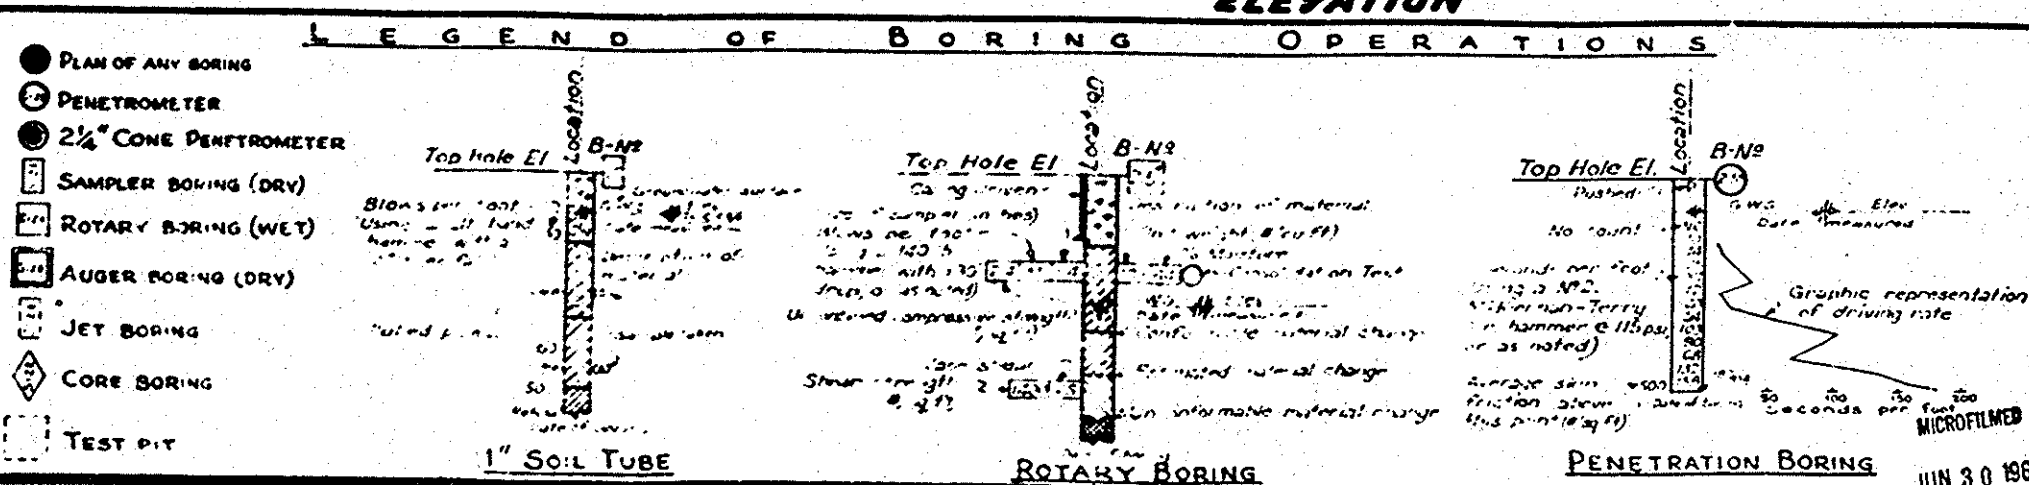

NOTES
The contractor's attention is directed to Section 2, Article (c) of the Standard Specifications and to the Special Provisions accompanying this set of plans.
Classification of earth material as shown on this sheet is based upon field inspection and is not to be construed to imply mechanical analysis.

COUNTY OF ORANGE HIGHWAY DEPT.
HARBOR BLVD. BRIDGE
ACROSS SANTA ANA RIVER
BRIDGE SA-28A
LOG OF TEST BORINGS

SCALE 1" = 20'
BRIDGE
FILE
DRAWING C-5755-11
SHEET 11 OF 13 SHEETS
SA-28A