
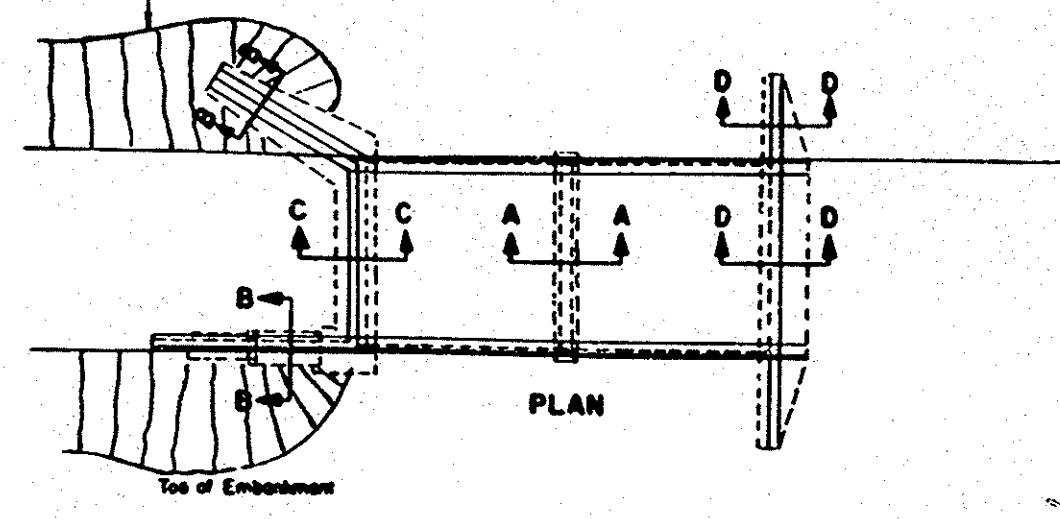
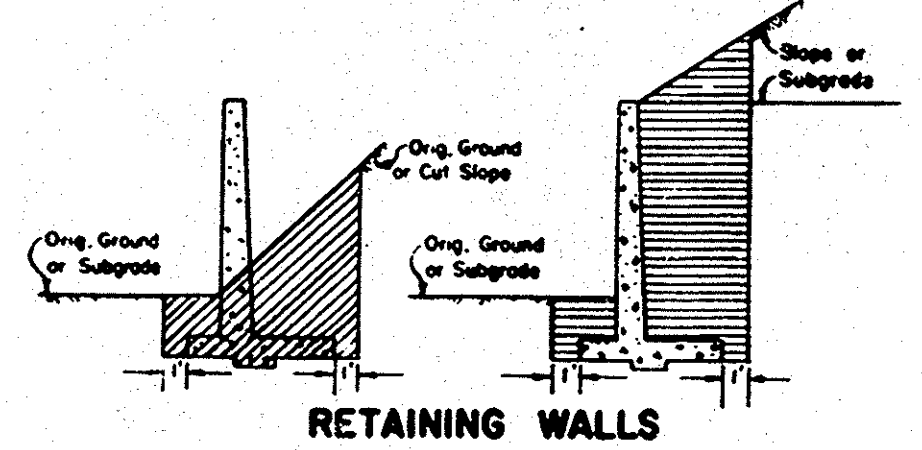
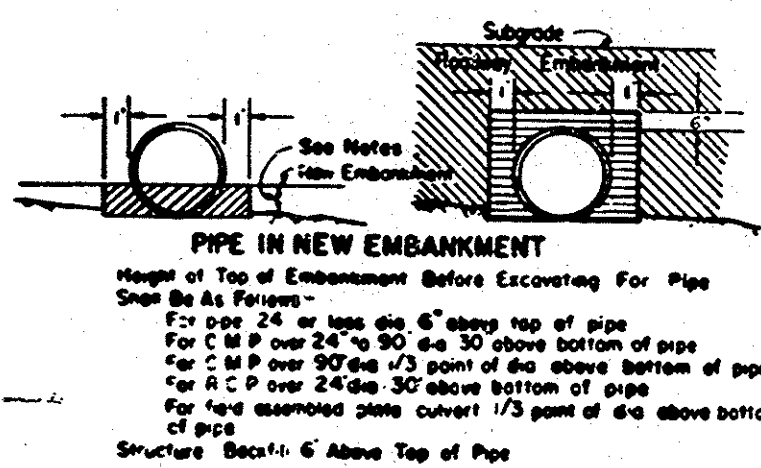
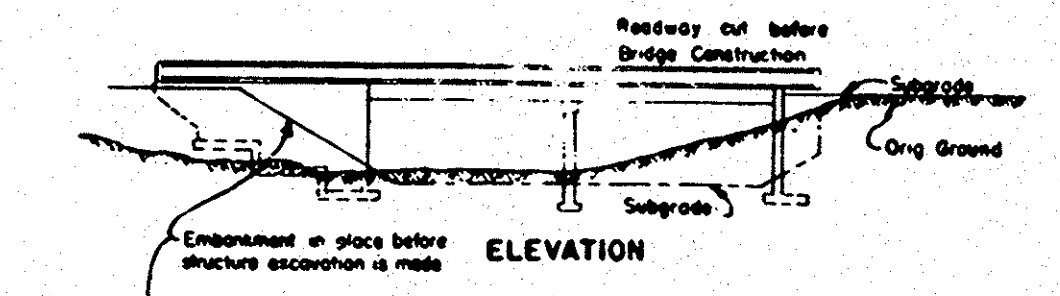
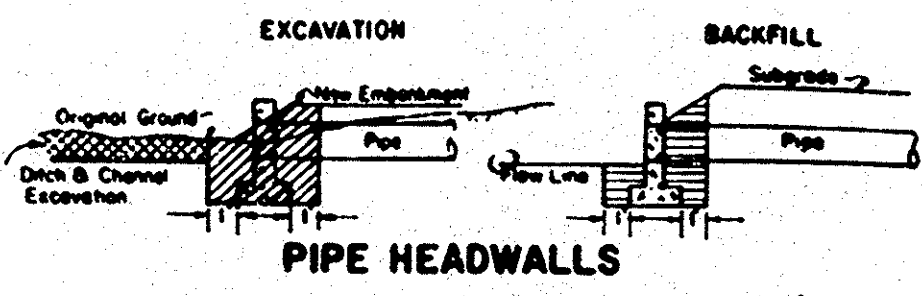












FILE NO. ORA	STATE	PROJECT NO.	SHEET NO.	TOTAL SHEETS
5-7420	CA	57	12	15

APPROVED: *[Signature]*
BRIDGE ENGINEER 5585
September 10, 1957

APPROVED: *[Signature]*
COUNTY ROAD COMMISSIONER
CIVIL ENGINEER NO. 7872


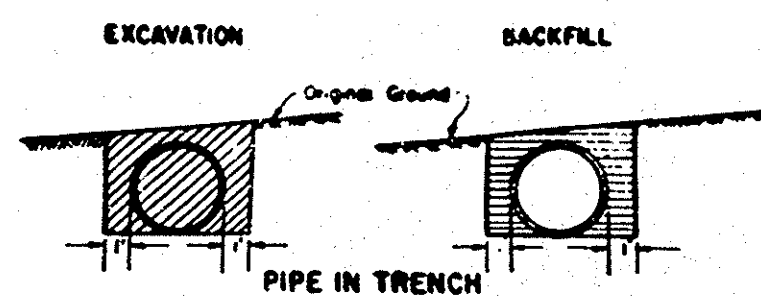


Bridge #SA-28-A
Harbor Blvd.
Across Santa Ana River
Sheet 12 of 15
R20-2-5-1 No Scale
Blackline Print

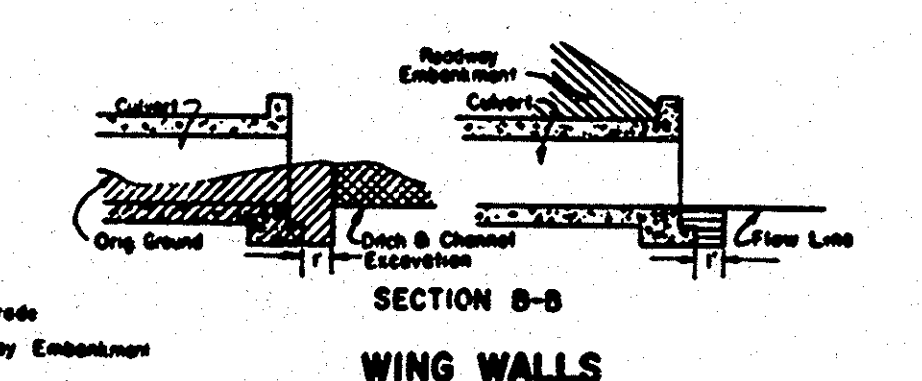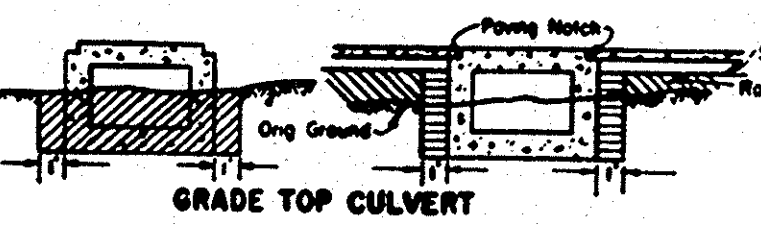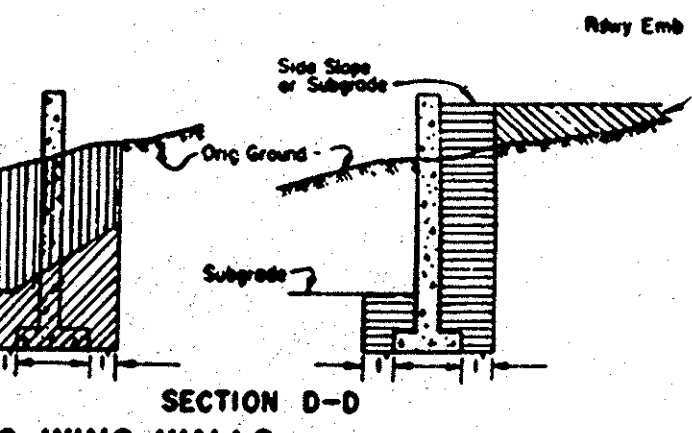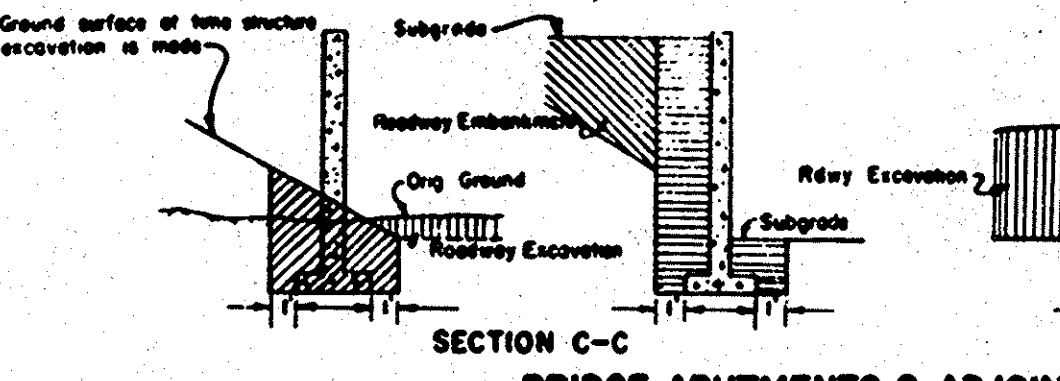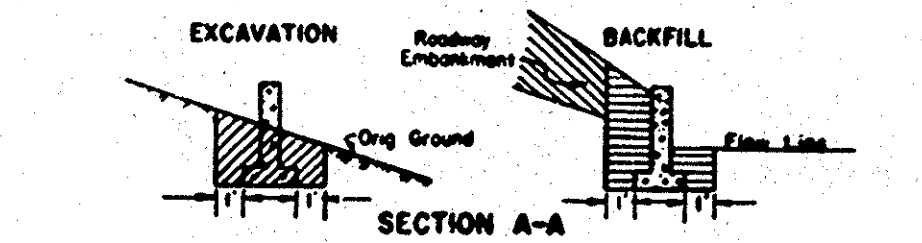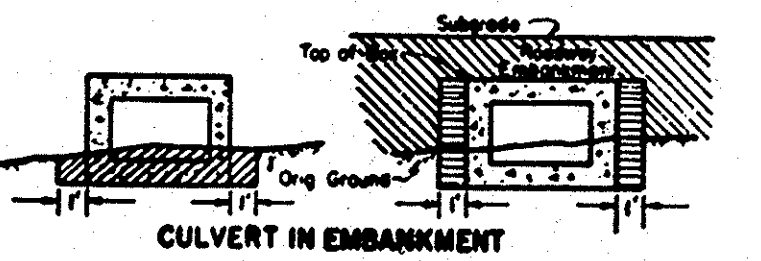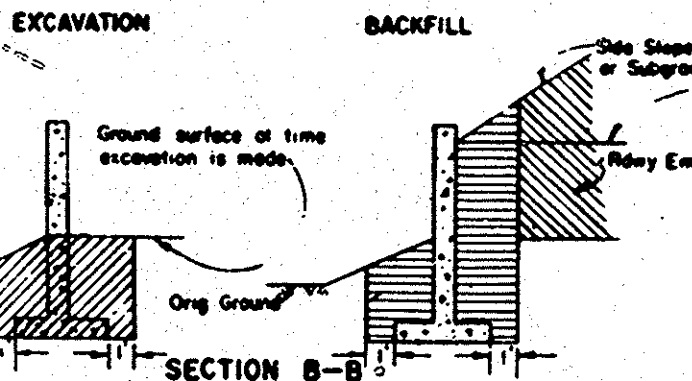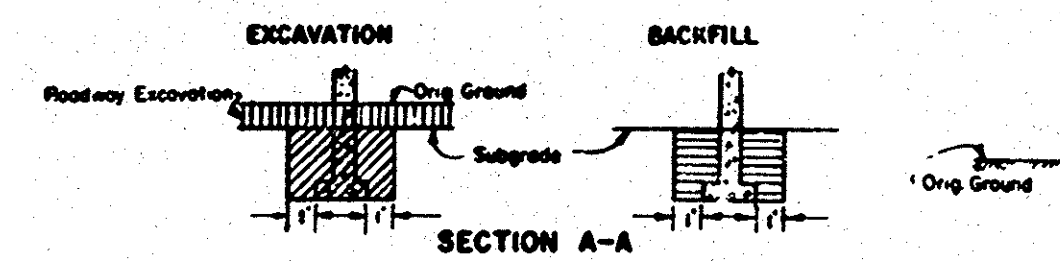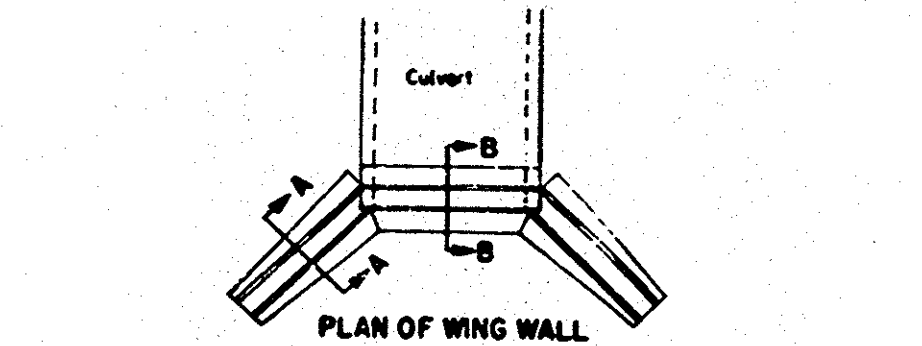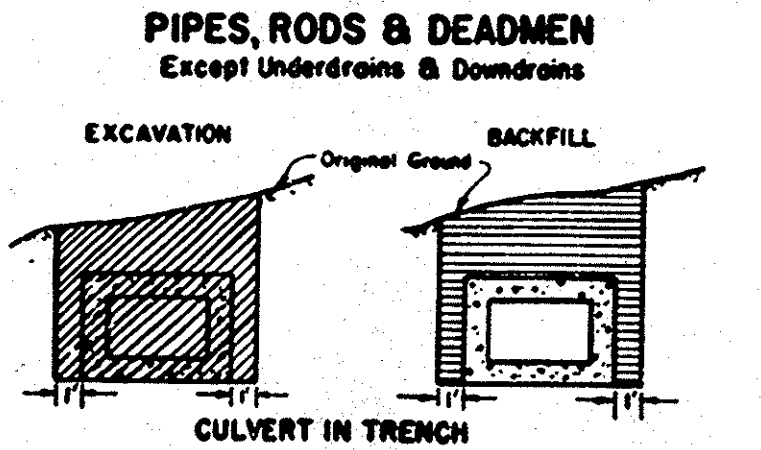

BRIDGE ABUTMENTS & ADJOINING WING WALLS

BOX CULVERTS

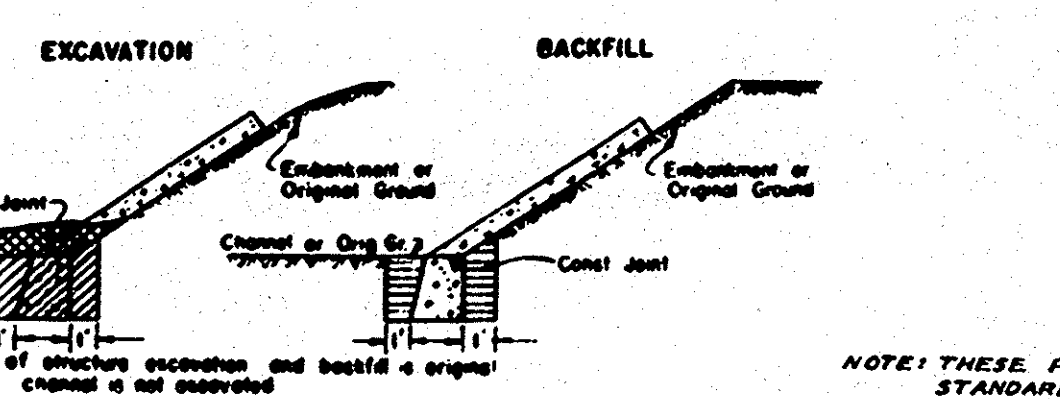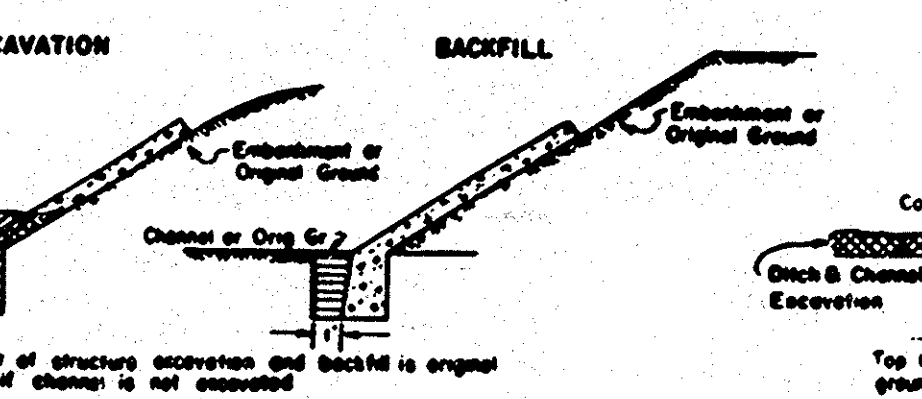

LEGEND
Structure Excavation
Structure Backfill
Ditch & Channel Excavation
Roadway Embankment
Roadway Excavation
Note: Subgrade shall be lowest subgrade as defined in the Standard Specifications.

AS BUILT
CORRECTIONS BY
CONTRACT NO. 58-14DDC-28-P
NO CORRECTIONS. THIS SHEET
[Signature]

NOTE: THESE PLANS ADOPTED FROM THE
STANDARD PLANS, STATE OF CALIFORNIA,
DEPARTMENT OF PUBLIC WORKS,
DIVISION OF HIGHWAYS

COUNTY OF ORANGE HIGHWAY DEPT.			
STRUCTURE EXCAV. & BACKFILL			
HARBOR BLVD. BRIDGE ACROSS SANTA ANA RIVER			
BRIDGE NO. S.A. 28-A			
APPROVED: <i>[Signature]</i> ROAD COMMISSIONER			
NO SCALE	STANDARD PLAN NO. 21-10	DATE MAY 1957	SHEET 12 OF 15 SHEETS

Bridge #55C-1R
JUN 30 1960
C-5755-12

SA 28-A