


FED. ROAD DIST. NO.	STATE	AD. NO.	PROJECT
2	CAL.	138	BRIDGE
DIST. COUNTY ROUTE		SECTION	PIER
VII Orm Buena Rd. 2			

APPROVED *[Signature]*
 ACTING BRIDGE ENGINEER
 November 13 1933

Bridge #8A-28
 Buena Street
 Across Santa Ana River
 Sheet 2 of 5
 Rep. 22.5' Scale 1/4"=1'
 Vollum

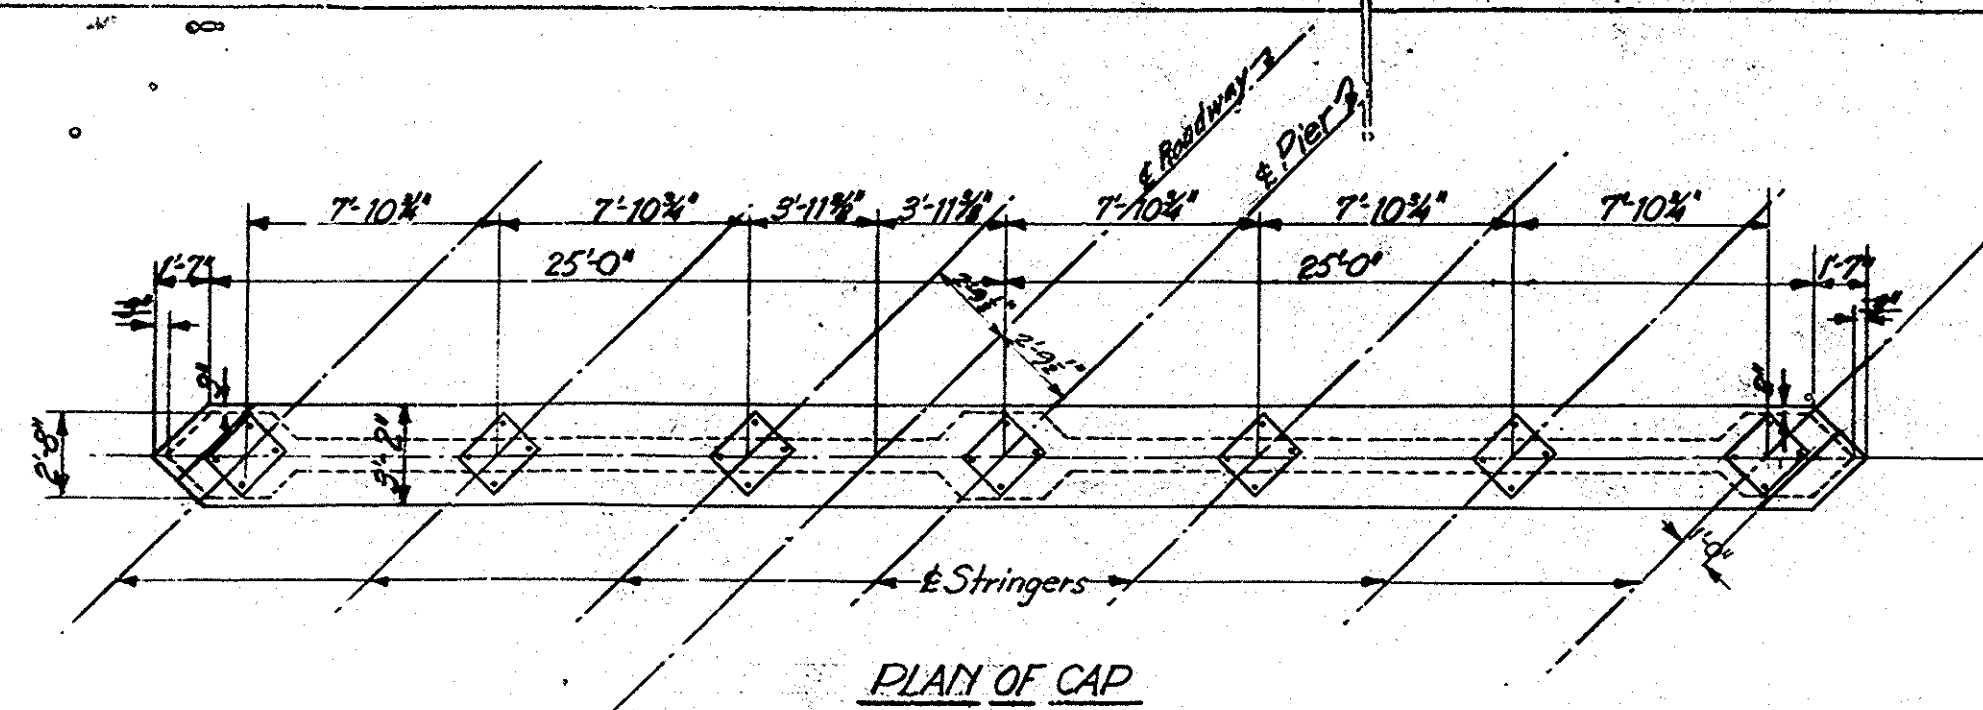

Elevations Top of bed plate.




Pier No.	1	2	3	4	5	6	7	8
1	65.04	65.26	65.38	65.45	65.44	65.35	65.21	65.03
2	5.83	5.83 5.73	5.83	5.88	5.86	5.74	5.58	5.39
3	5.85	6.03	6.12	6.13	6.09	5.96	5.77	5.58
4	5.99	6.15	6.21	6.21	6.15	5.99	5.78	5.59
5	5.96	6.09	6.13	6.12	6.03	5.85	5.62	5.43
6	5.74	5.86 5.86	5.88	5.83	5.73	5.53	5.28	5.09
7	5.35	5.44	5.45	5.38	5.26	5.04	4.77	4.58
8								

Pier No. 2-64.85
 3 5.34
 4 5.66
 5 5.80
 6 5.77
 7 5.55
 8 5.16

Pier No. 2-65.03
 3- 5.39
 4- 5.58
 5- 5.59
 6- 5.43
 7- 5.09
 8- 4.58

Pier No. 2-20.10' Pier No. 6-21.02'
 3 20.89' 7-20.80'
 4 20.91' 8-20.41'
 5 21.05'

Pier No. 2-20.08' Pier No. 6-20.68'
 3-20.64' 7-20.34'
 4-20.83' 8-19.83'
 5-20.84'

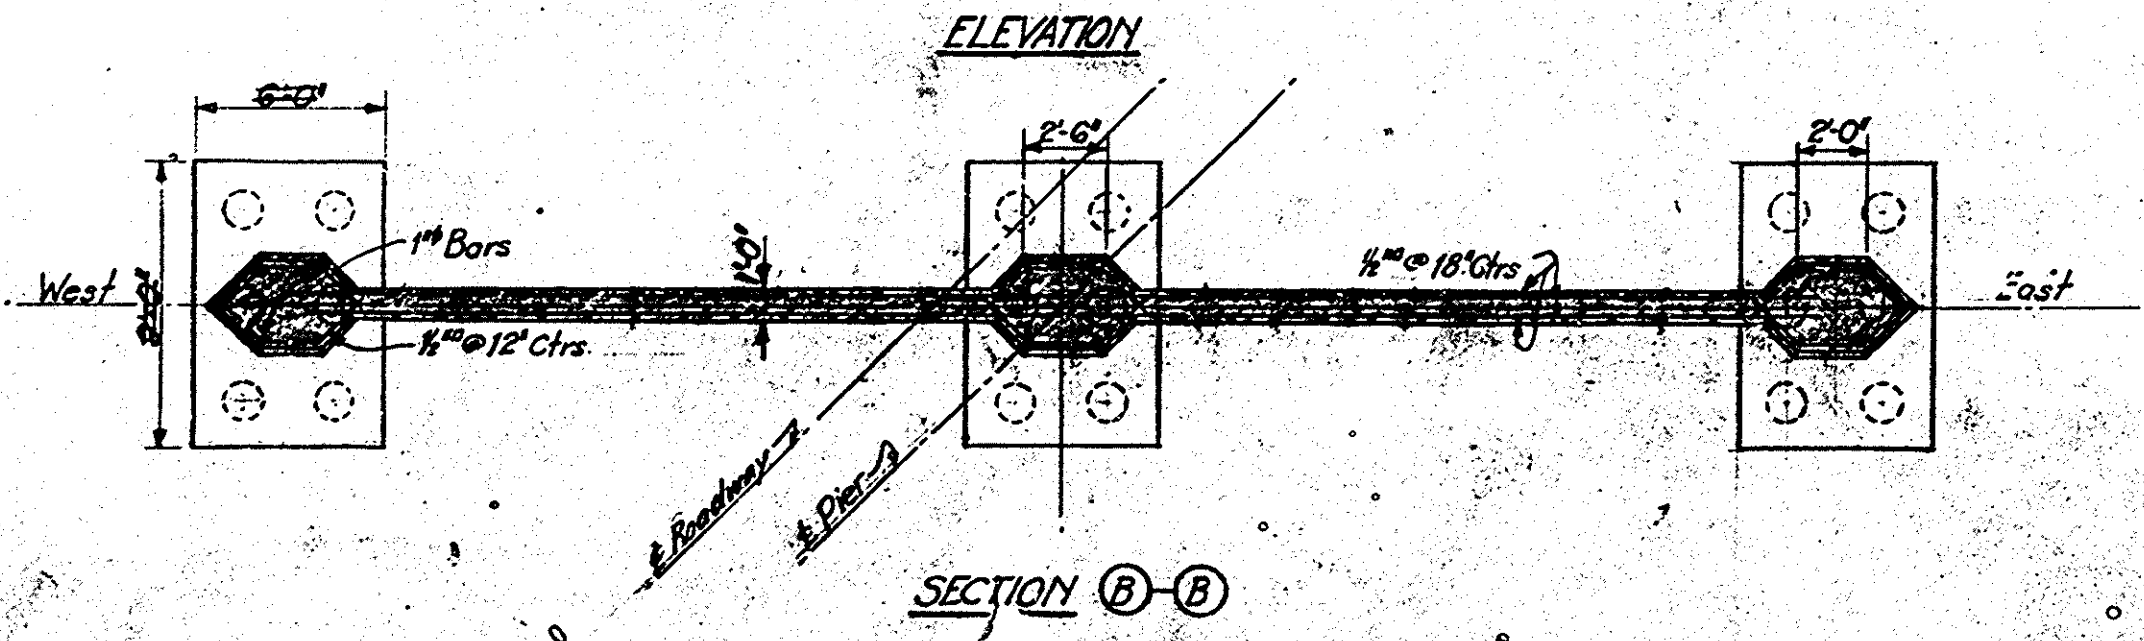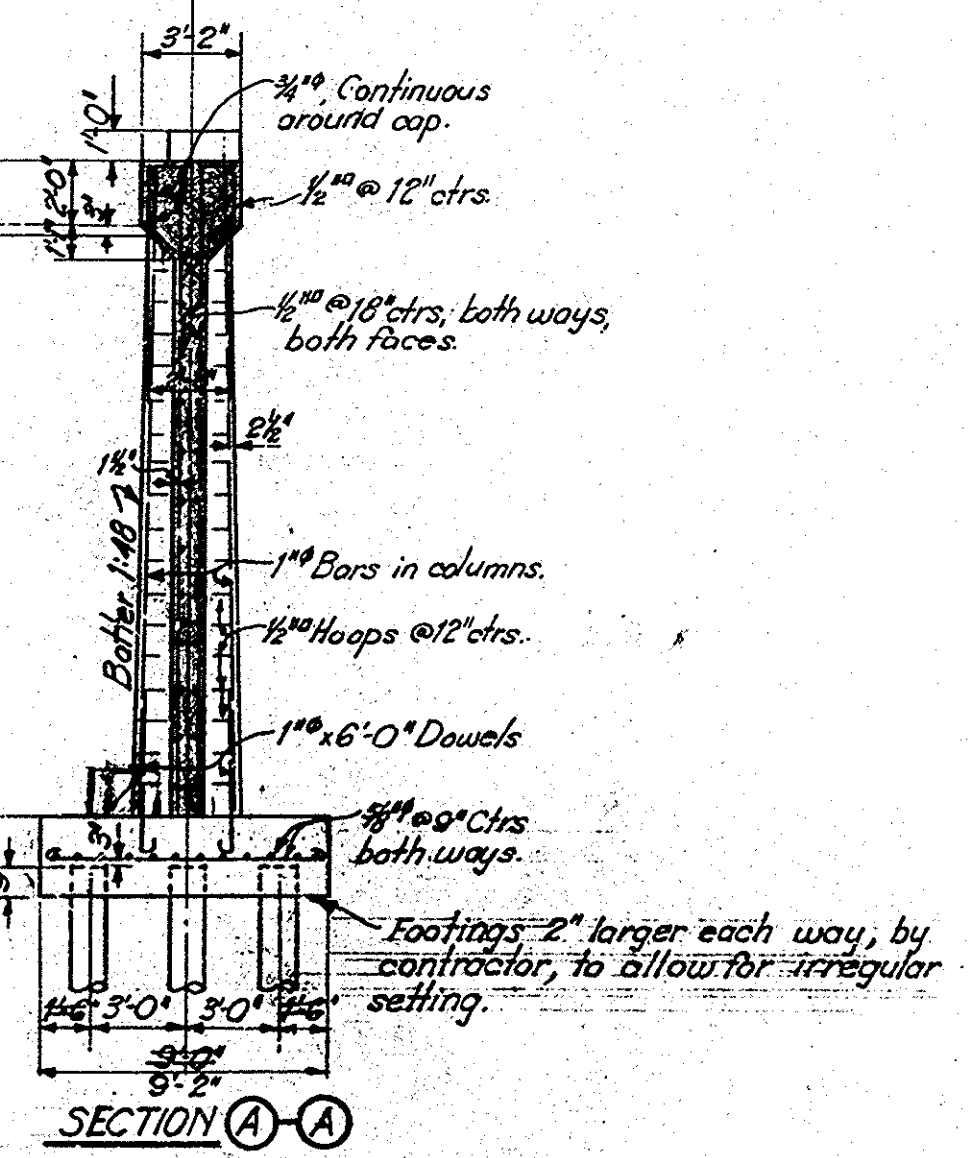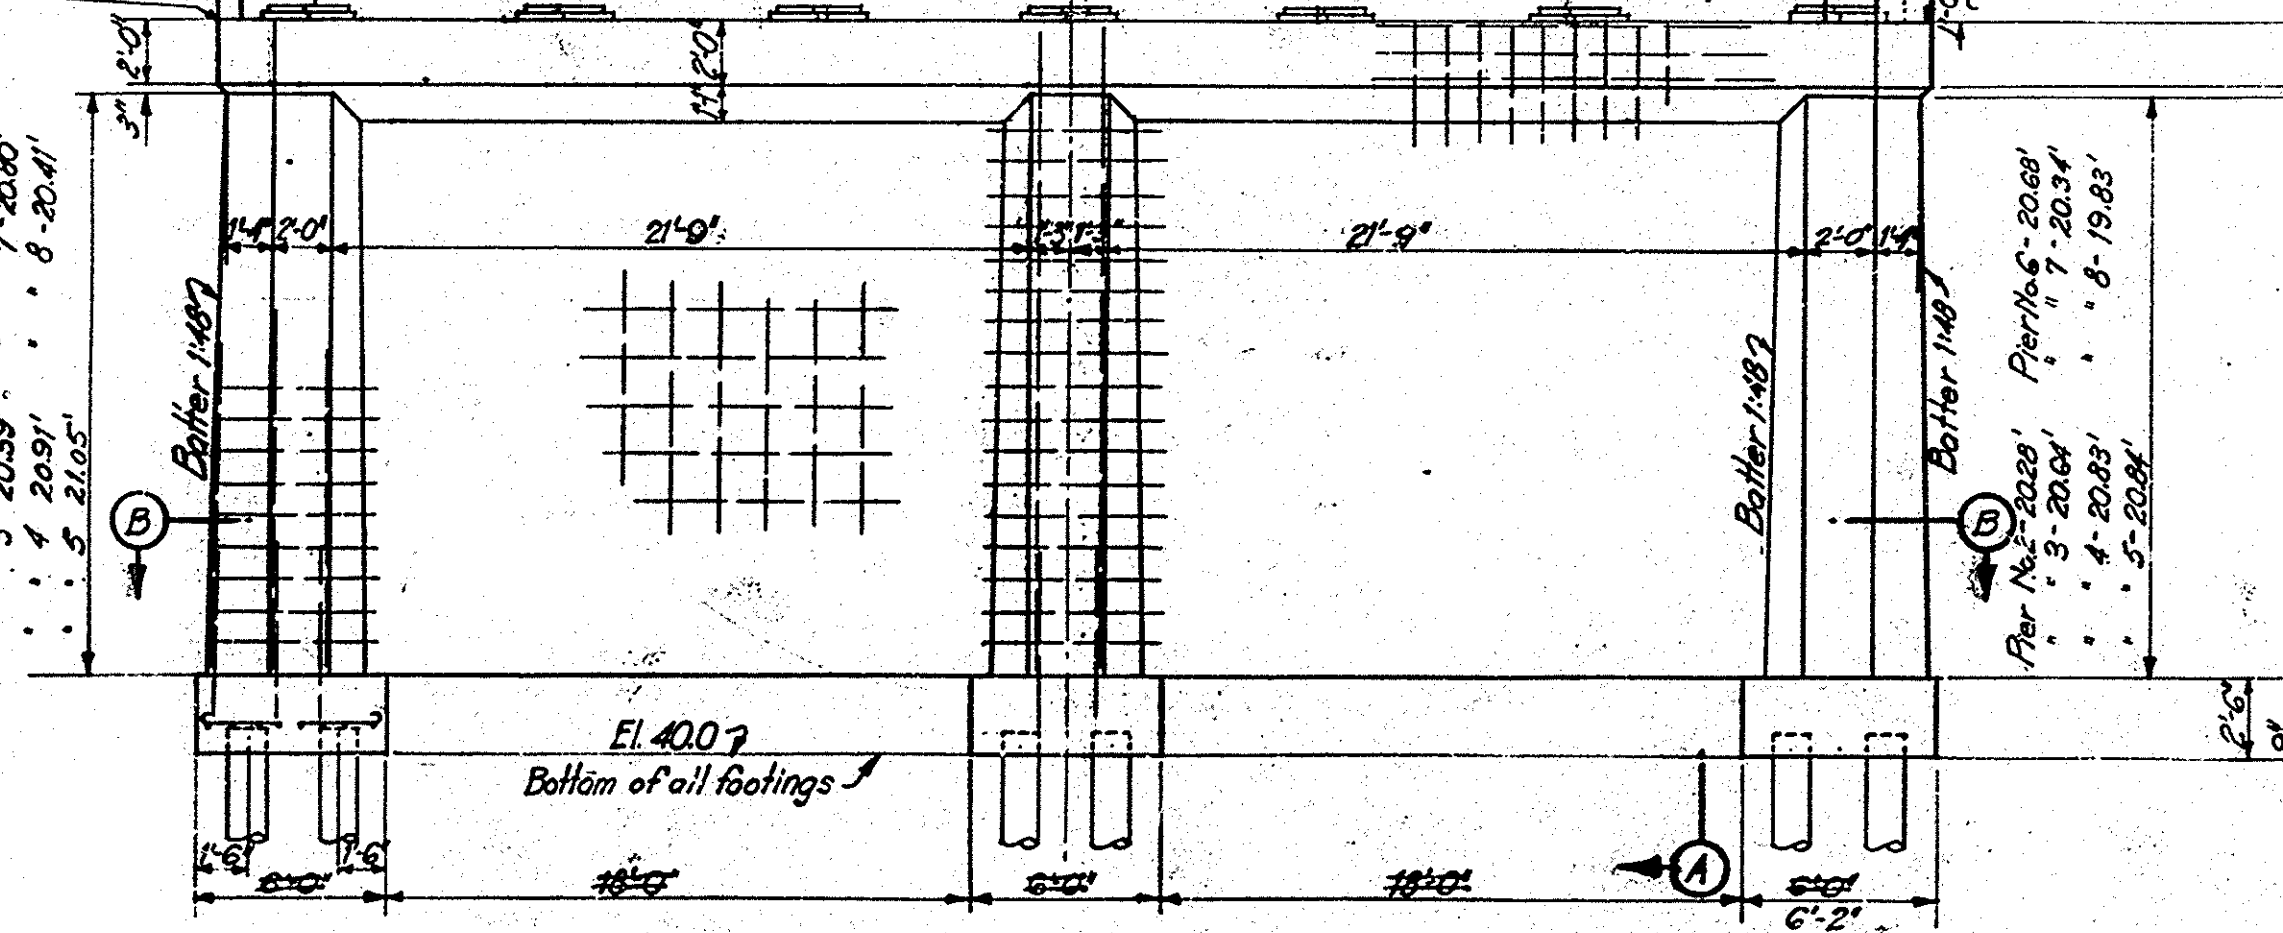

MICROFILMED
 JUN 30 1960

BRIDGE ACROSS SANTA ANA RIVER	
PIERS NOS. 2 TO 8, INCL.	
SCALE 1/4"=1'-0"	FILE NO.
BRIDGE NO.	DRAWING NO. E-248