




W. J. Farnsworth
ACTING CHIEF OF THE ENGINEER
APPROVED November 13, 1939

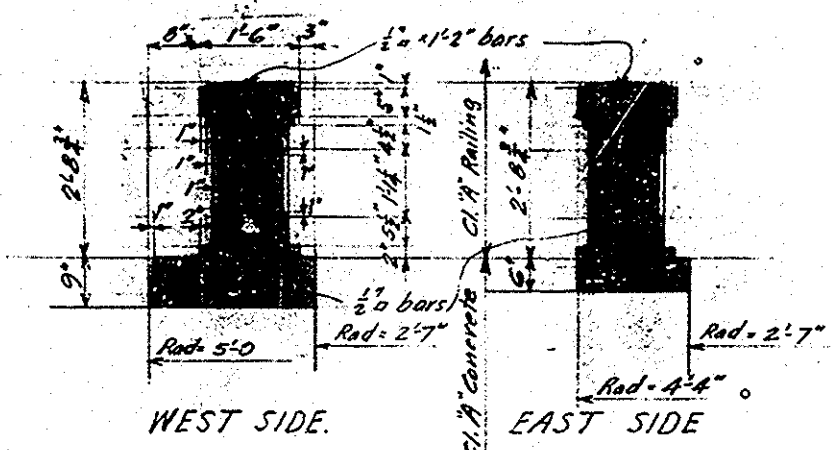


SECTION A-A.
Scale $\frac{1}{2}'' = 1'$

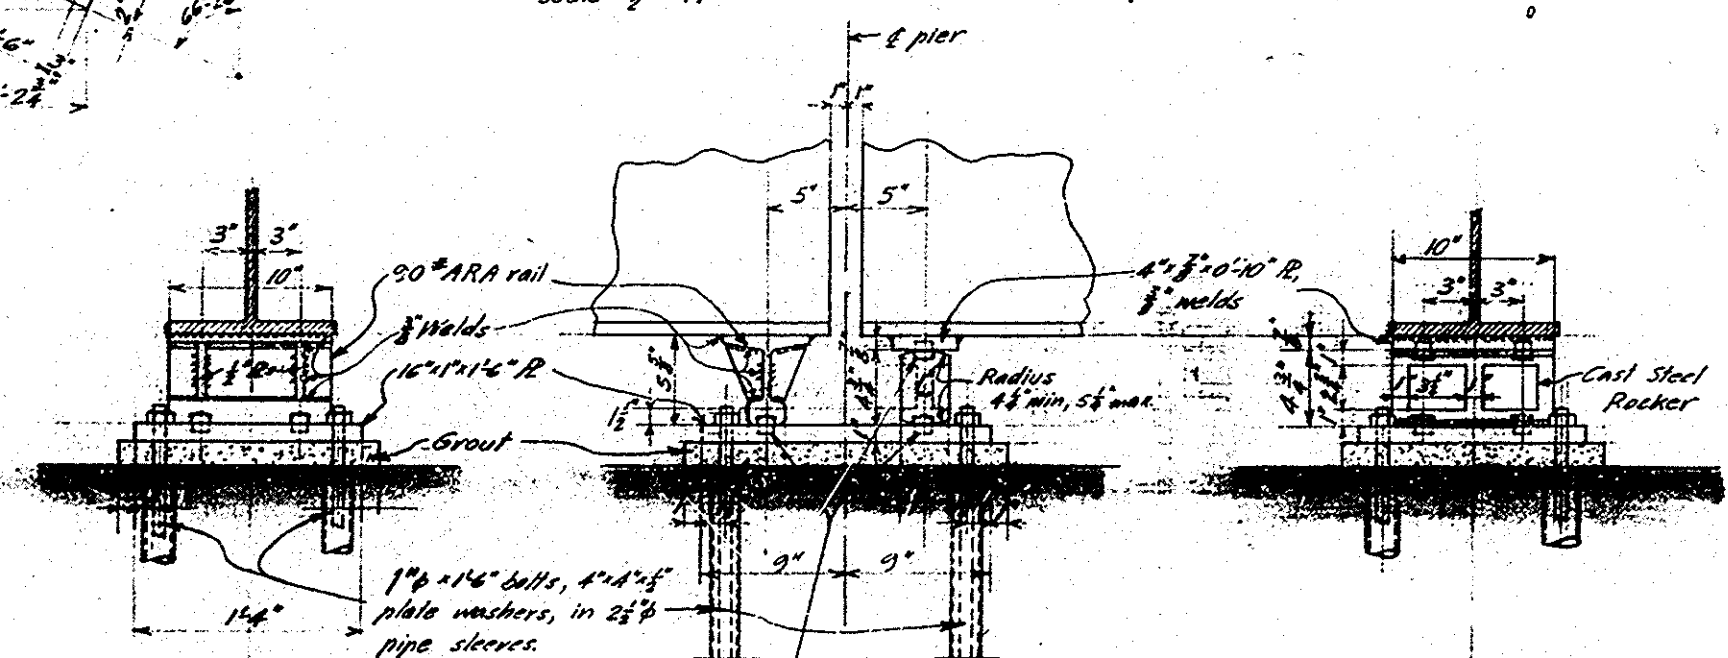

Bridge #9A-28
Buaro Street
Across Santa Ana River
Sheet 3 of 5
Feet 22.5' Scale as shown
Vellum

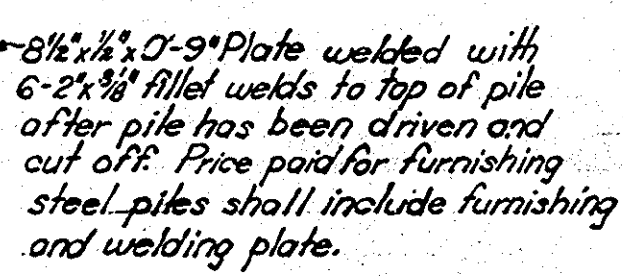

Scale: 1" = 1'-0"

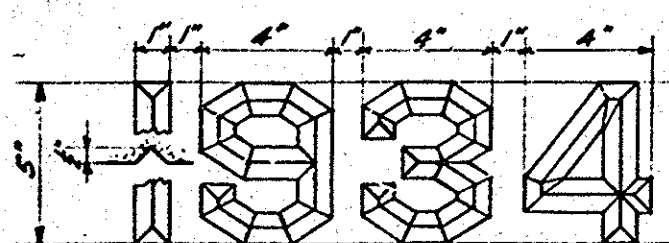

to be recessed into inside panels
of two end posts designated in
plan of piers 1 and 2.

BED PLATE FOR PIERS 1 AND 9.
14-Pls 8"x1" x 1'-4" req'd.

Scale $1\frac{1}{2}" = 1'$

56 fixed bearings req'd.
56 expansion bearings req'd.

BRIDGE ACROSS SANTA ANA RIVER.	
PIERS 1 AND 2	
SCALES NOTED	FILE NO. 1
BRIDGE NO. 1	DRAWING NO. 1

MICROFILMED

JUN 30 1960