
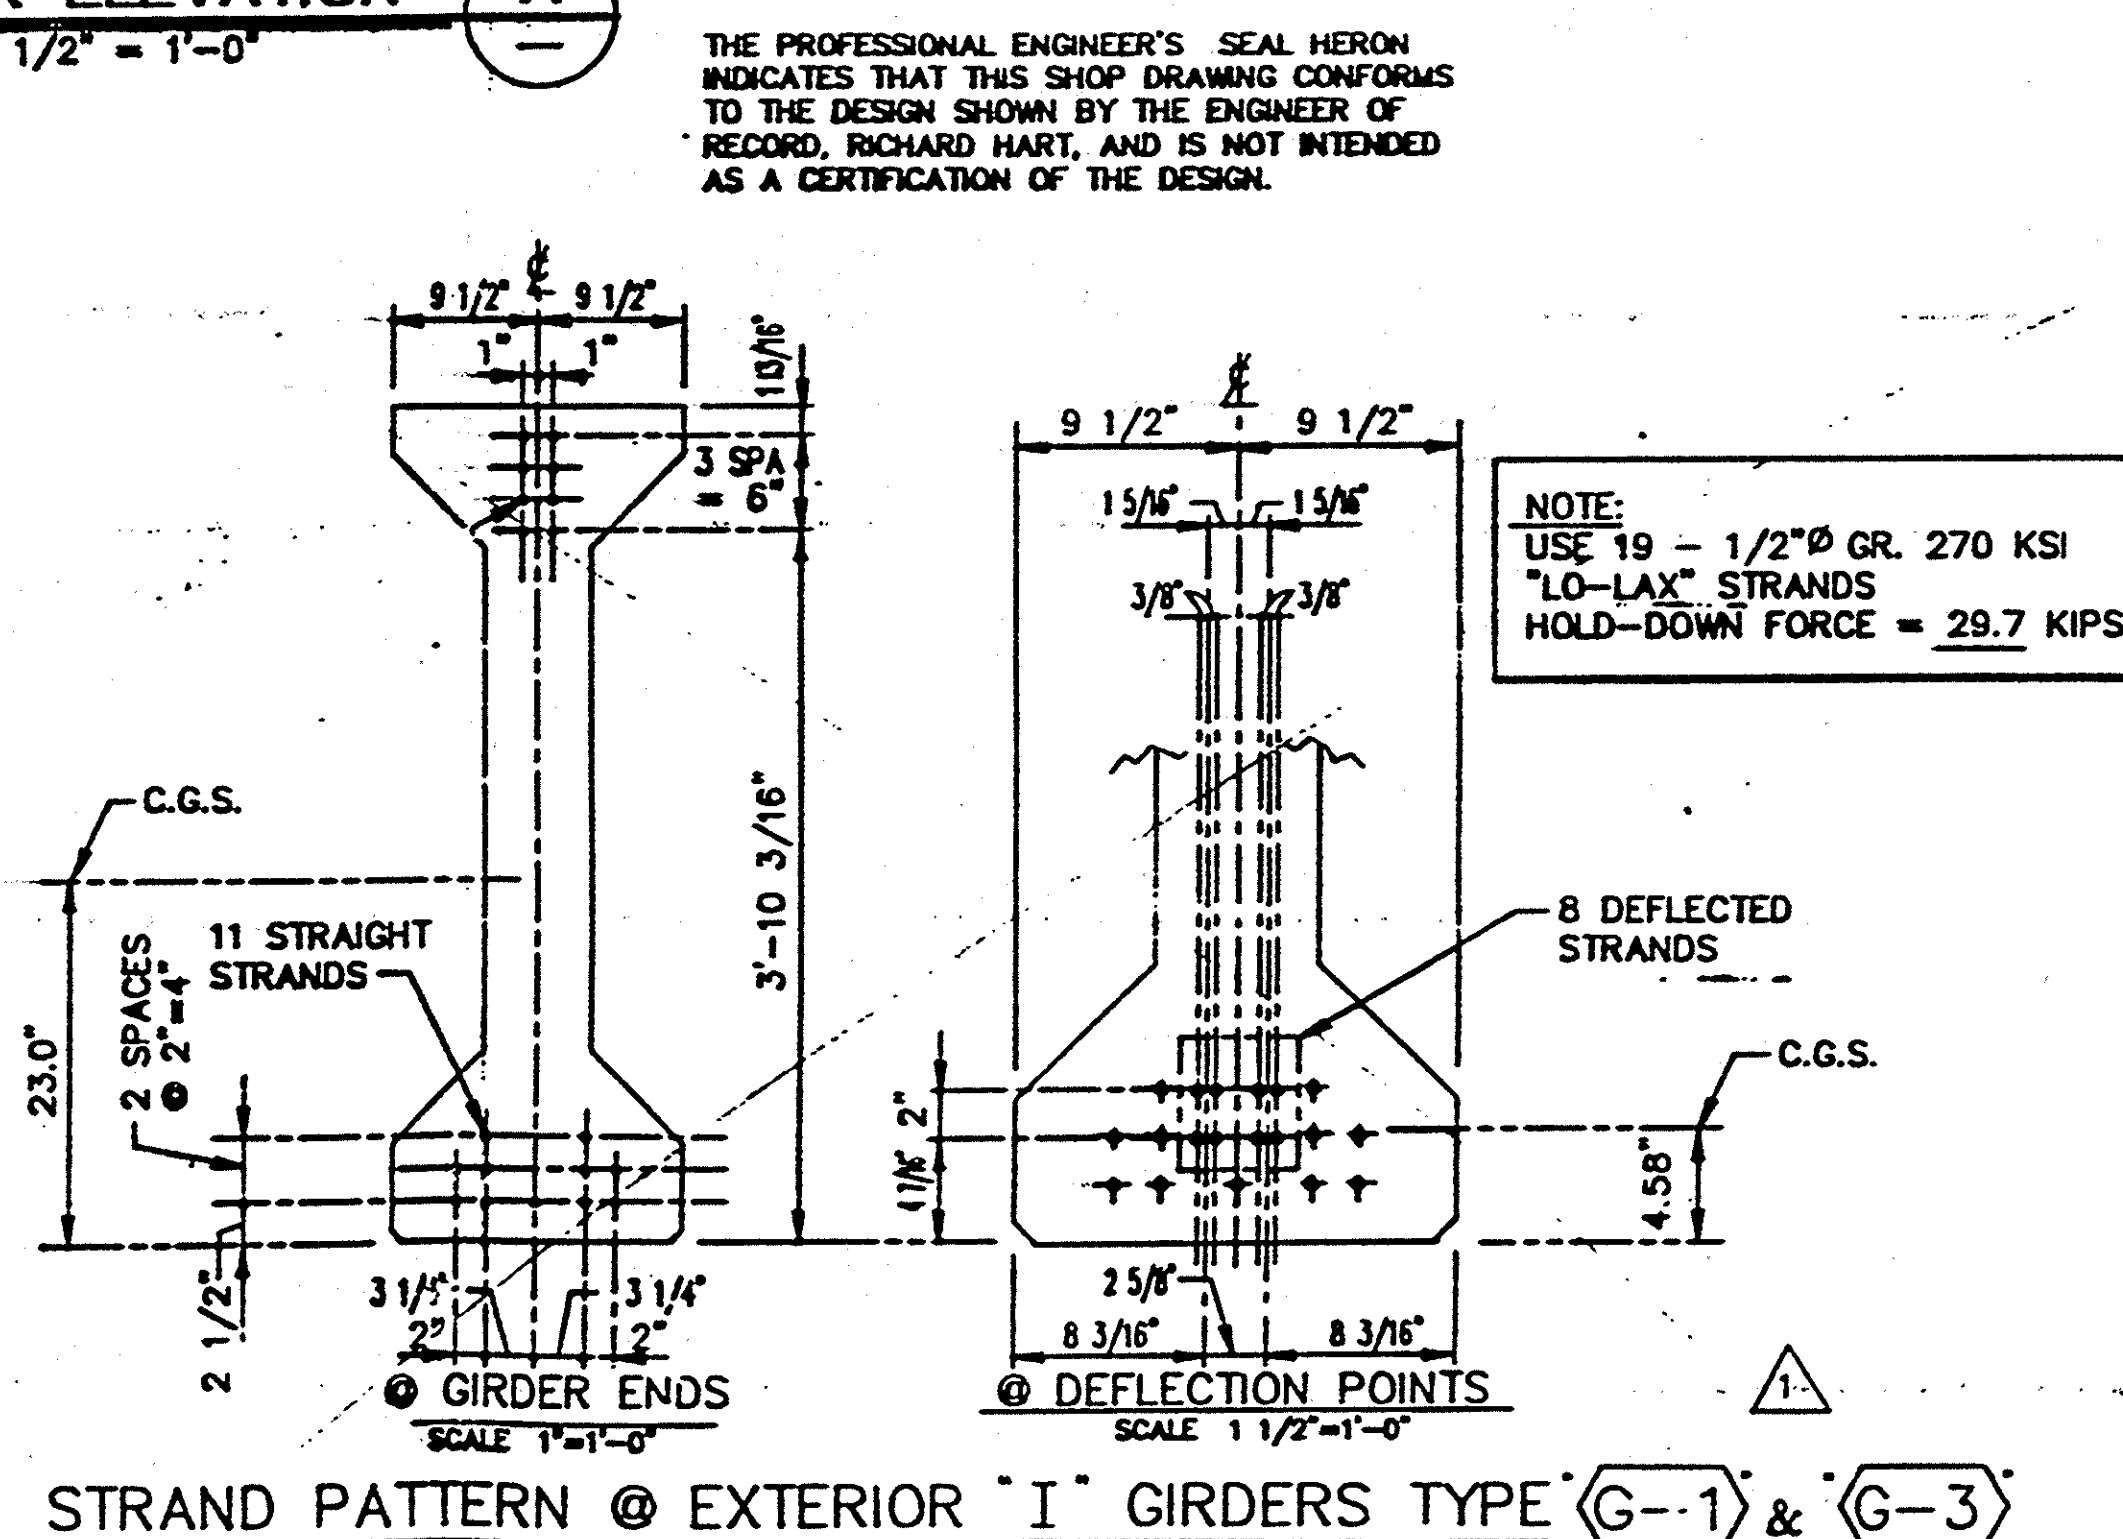
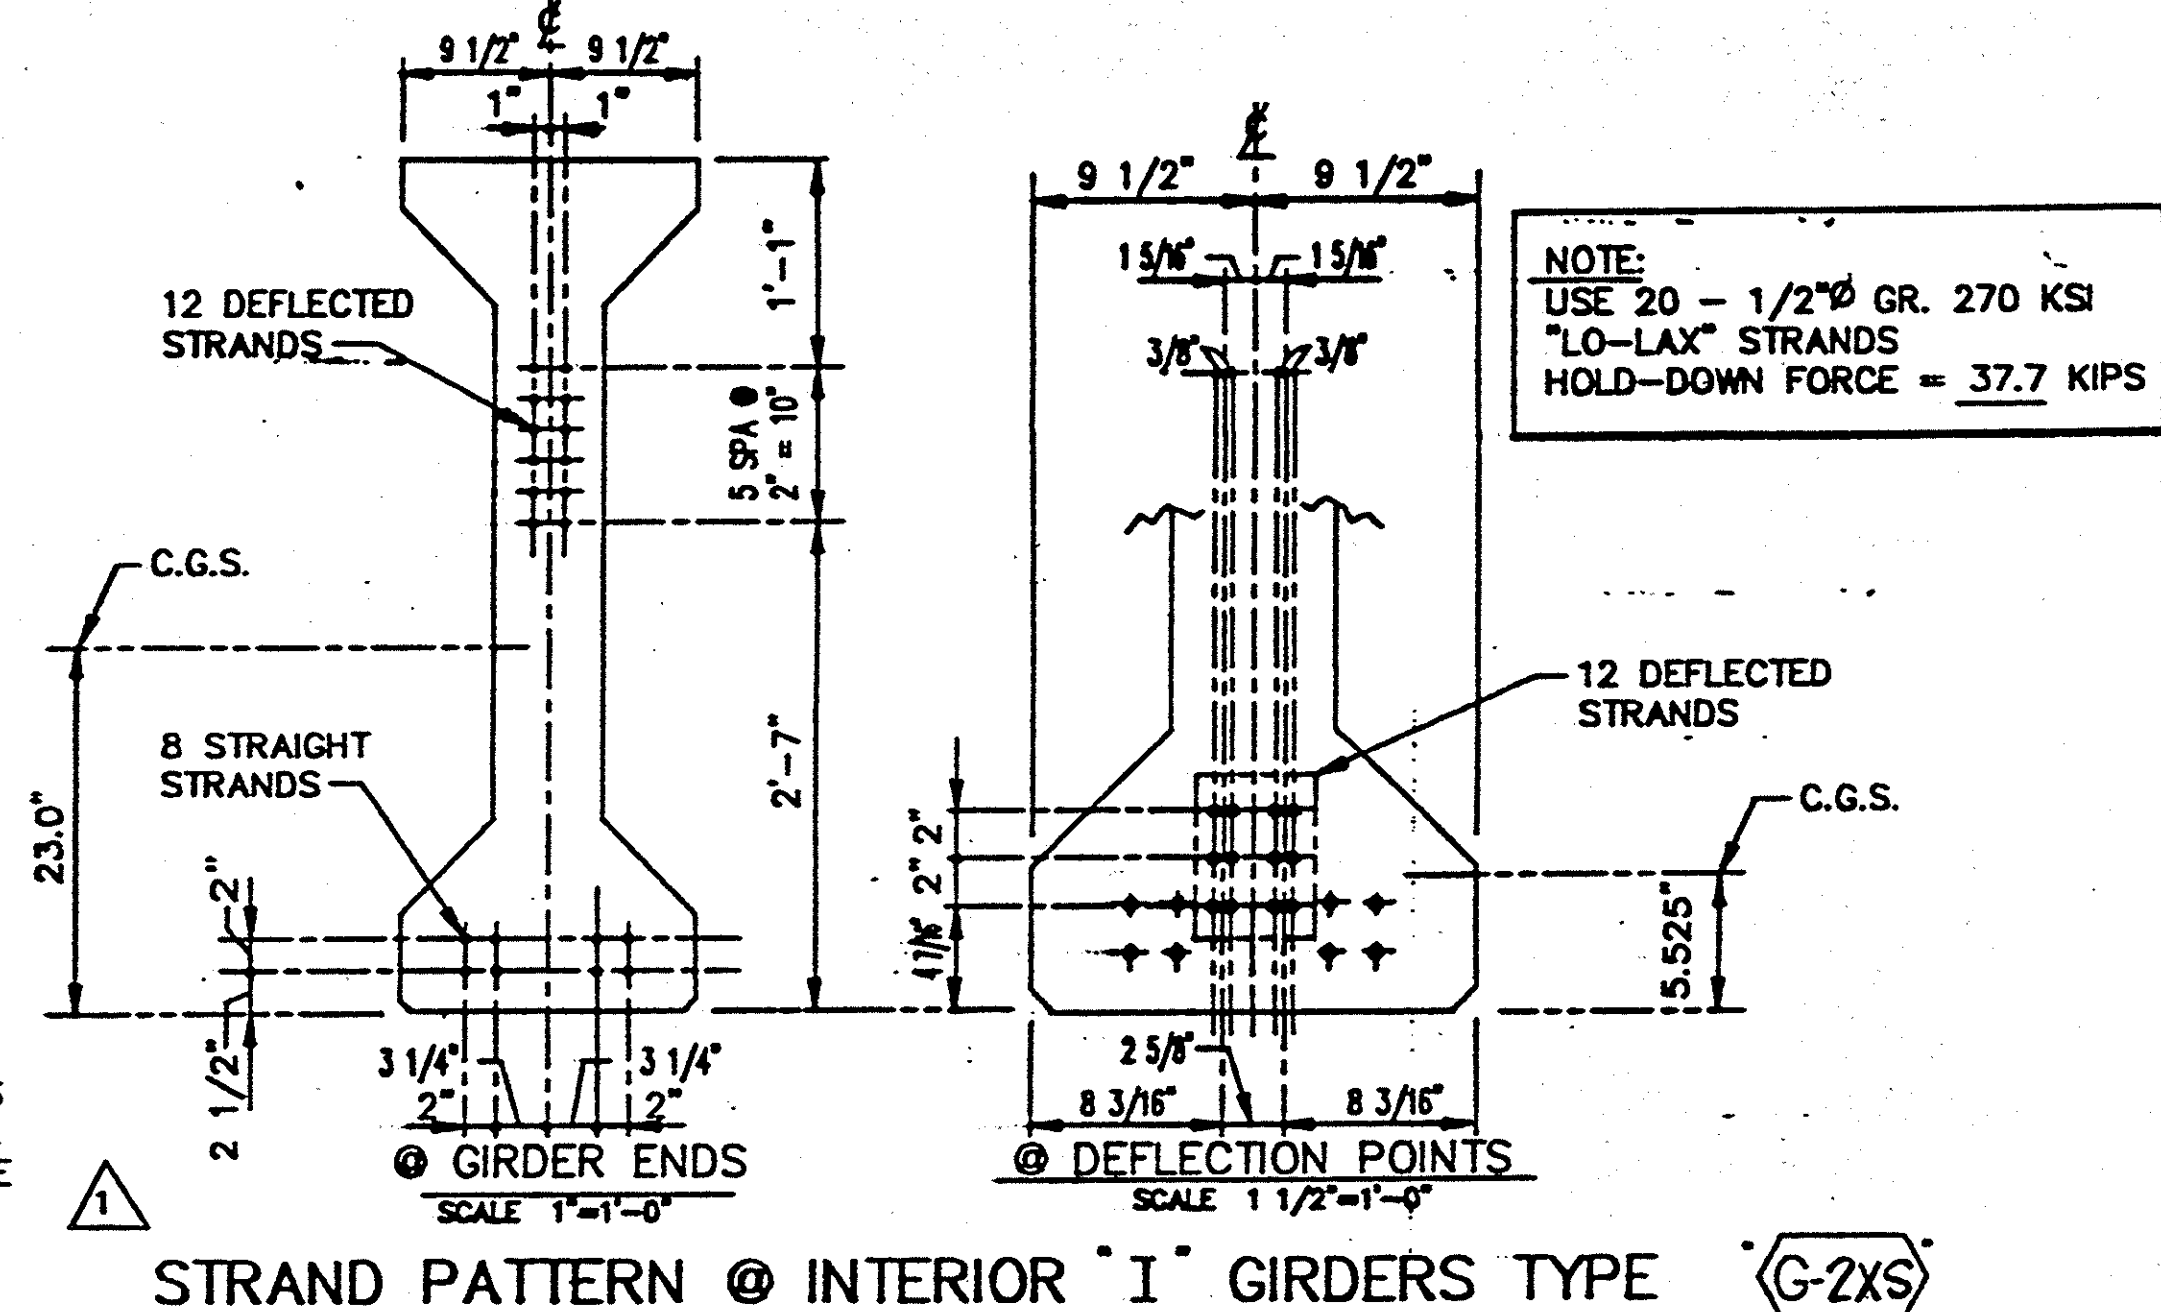


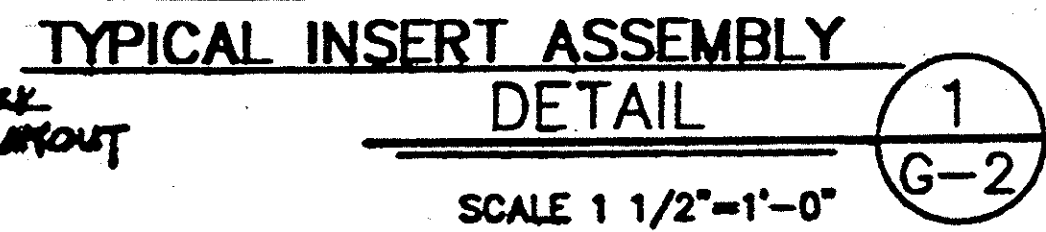

BRIDGE NO. (SA 29)		W.O. NO. R09318	
UNIT	MAKE	VOL. CU. YDS.	APPROX. WT.
G-2x6	1	9.8	20.04 TONS
		9.8	20.04 TONS
		9.8	20.04 TONS

5-24-92	GENERAL REVISIONS	RM	
5-03-93	ISSUED FOR APPROVAL	RM	
NO.	DATE	REVISIONS & ISSUES	BY

PACIFIC PRECAST ASSOCIATES
 A JOINT VENTURE
 P.O. BOX 308 PERRIS, CA 92572-0308

GRIFFITH COMPANY

2020 SOUTH YALE STREET SANTA ANA, CA 92704

HARBOR BLVD. BRIDGE

ORANGE CO. ENVIRONMENTAL AGENCY - SANTA ANA, CA

P.S. CONCRETE GIRDER TYPE **G-2x6**

DESIGNED	DRAWN	DATE	SCALE	REV. NO.	DWG. NO.
CHECKED	CHECKED	PR. ENGR.	NOTED		

APRIL 1993
 3304
 SHEET 5 OF 6