


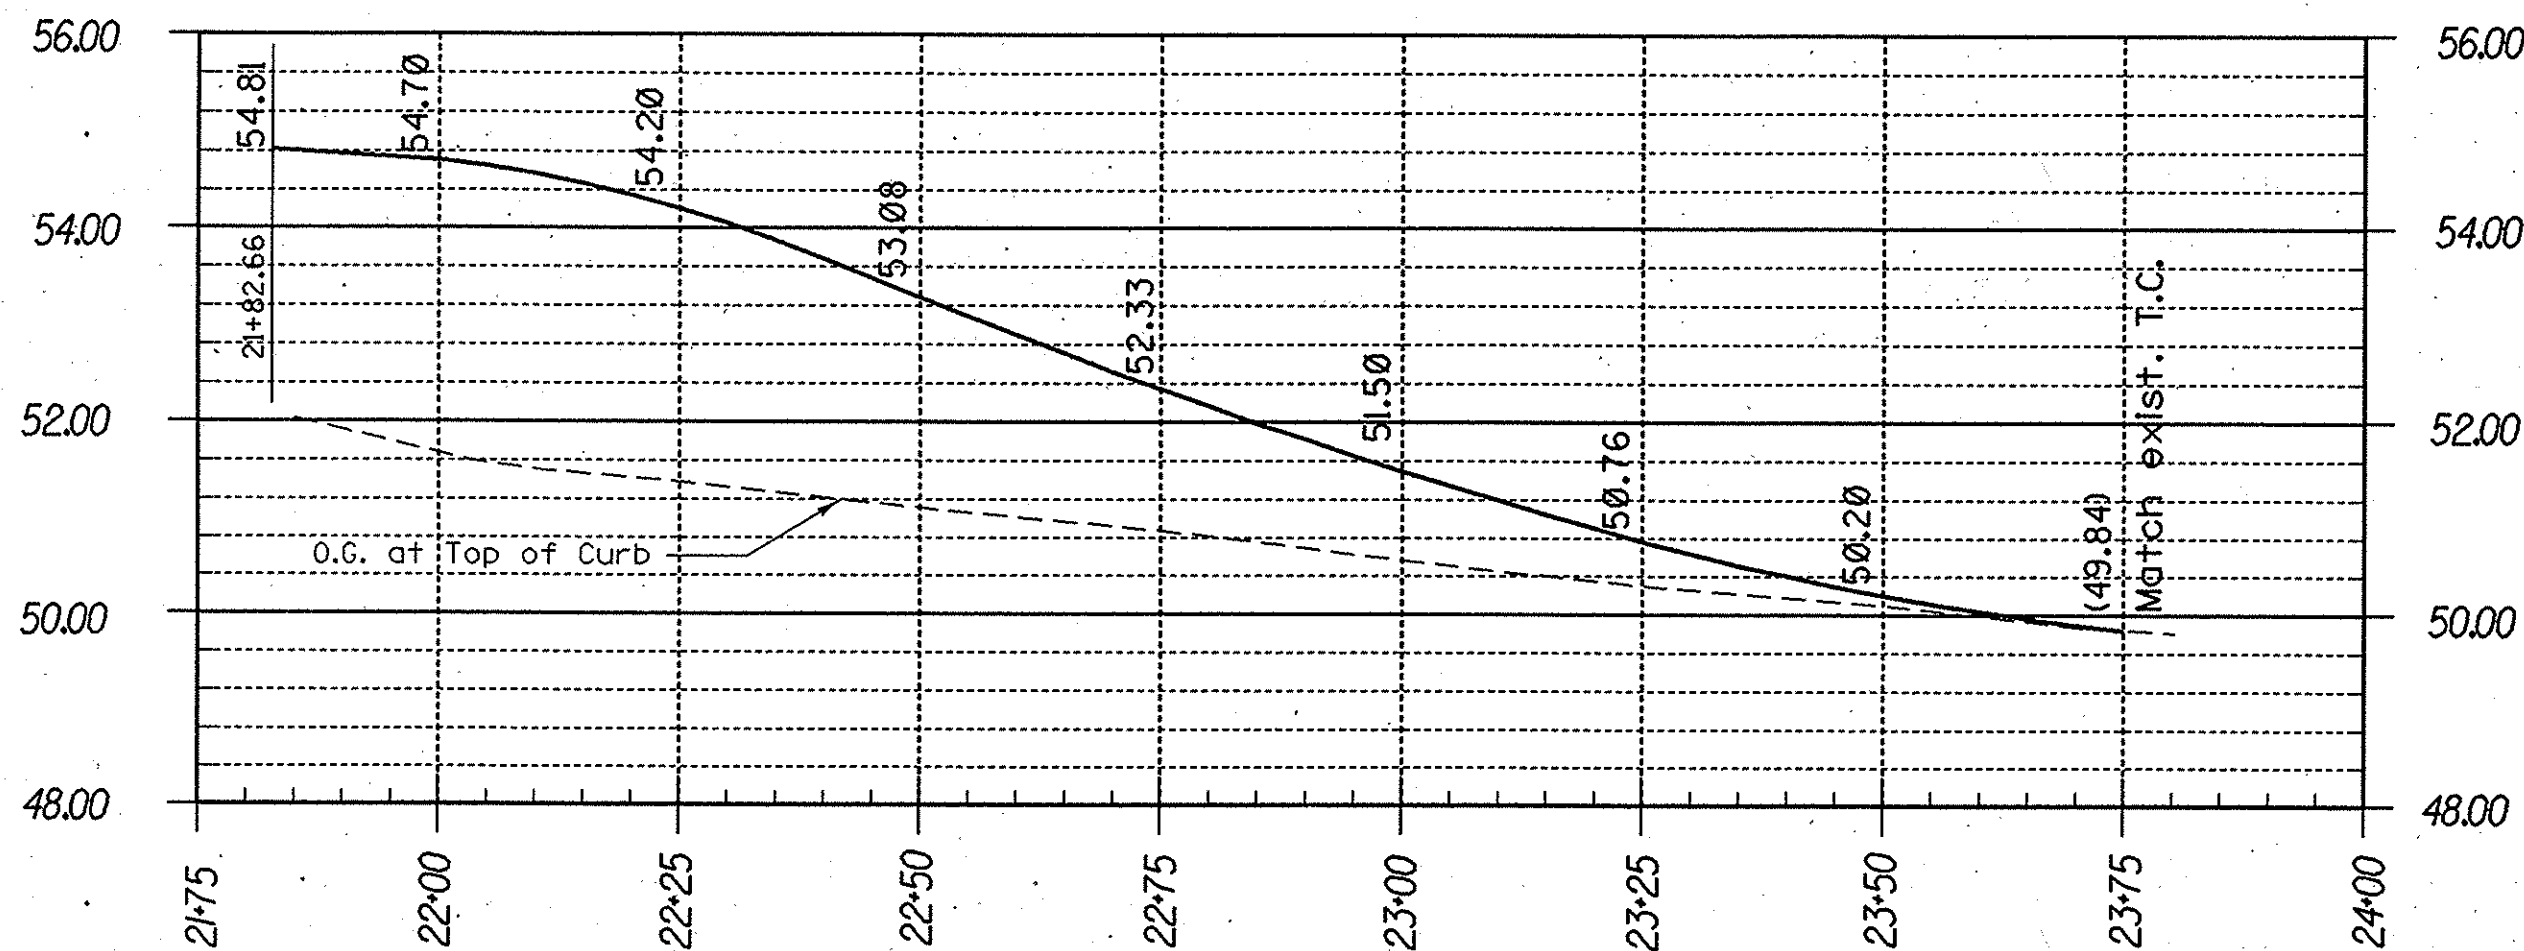


TOP OF CURB PROFILE (Frontage Rd.)

SCALE: VERT. 1"=2'
HORIZ. 1"=20'

CONSTRUCTION NOTES


- 3 Construct PCC curb and gutter, type A2-8, per APWA Std. Plan No. 104-0-0C.
- 7 Furnish and place var. thickness AC cap (min. 0.2') over exist. AC.
- 8 Construct retaining wall per details sheet 10.
- 9 Construct PCC sidewalk per EMA Std. Plan No. 1205.
- 14 Construct PCC access ramp per detail sheet 9.
- 31 Construct metal hand railing, Type B, per APWA Std. Plan No. 606-0-0C, post spacing 8' C.C. max.
- 35 Cold plane AC per typical sections and as directed by Engineer.

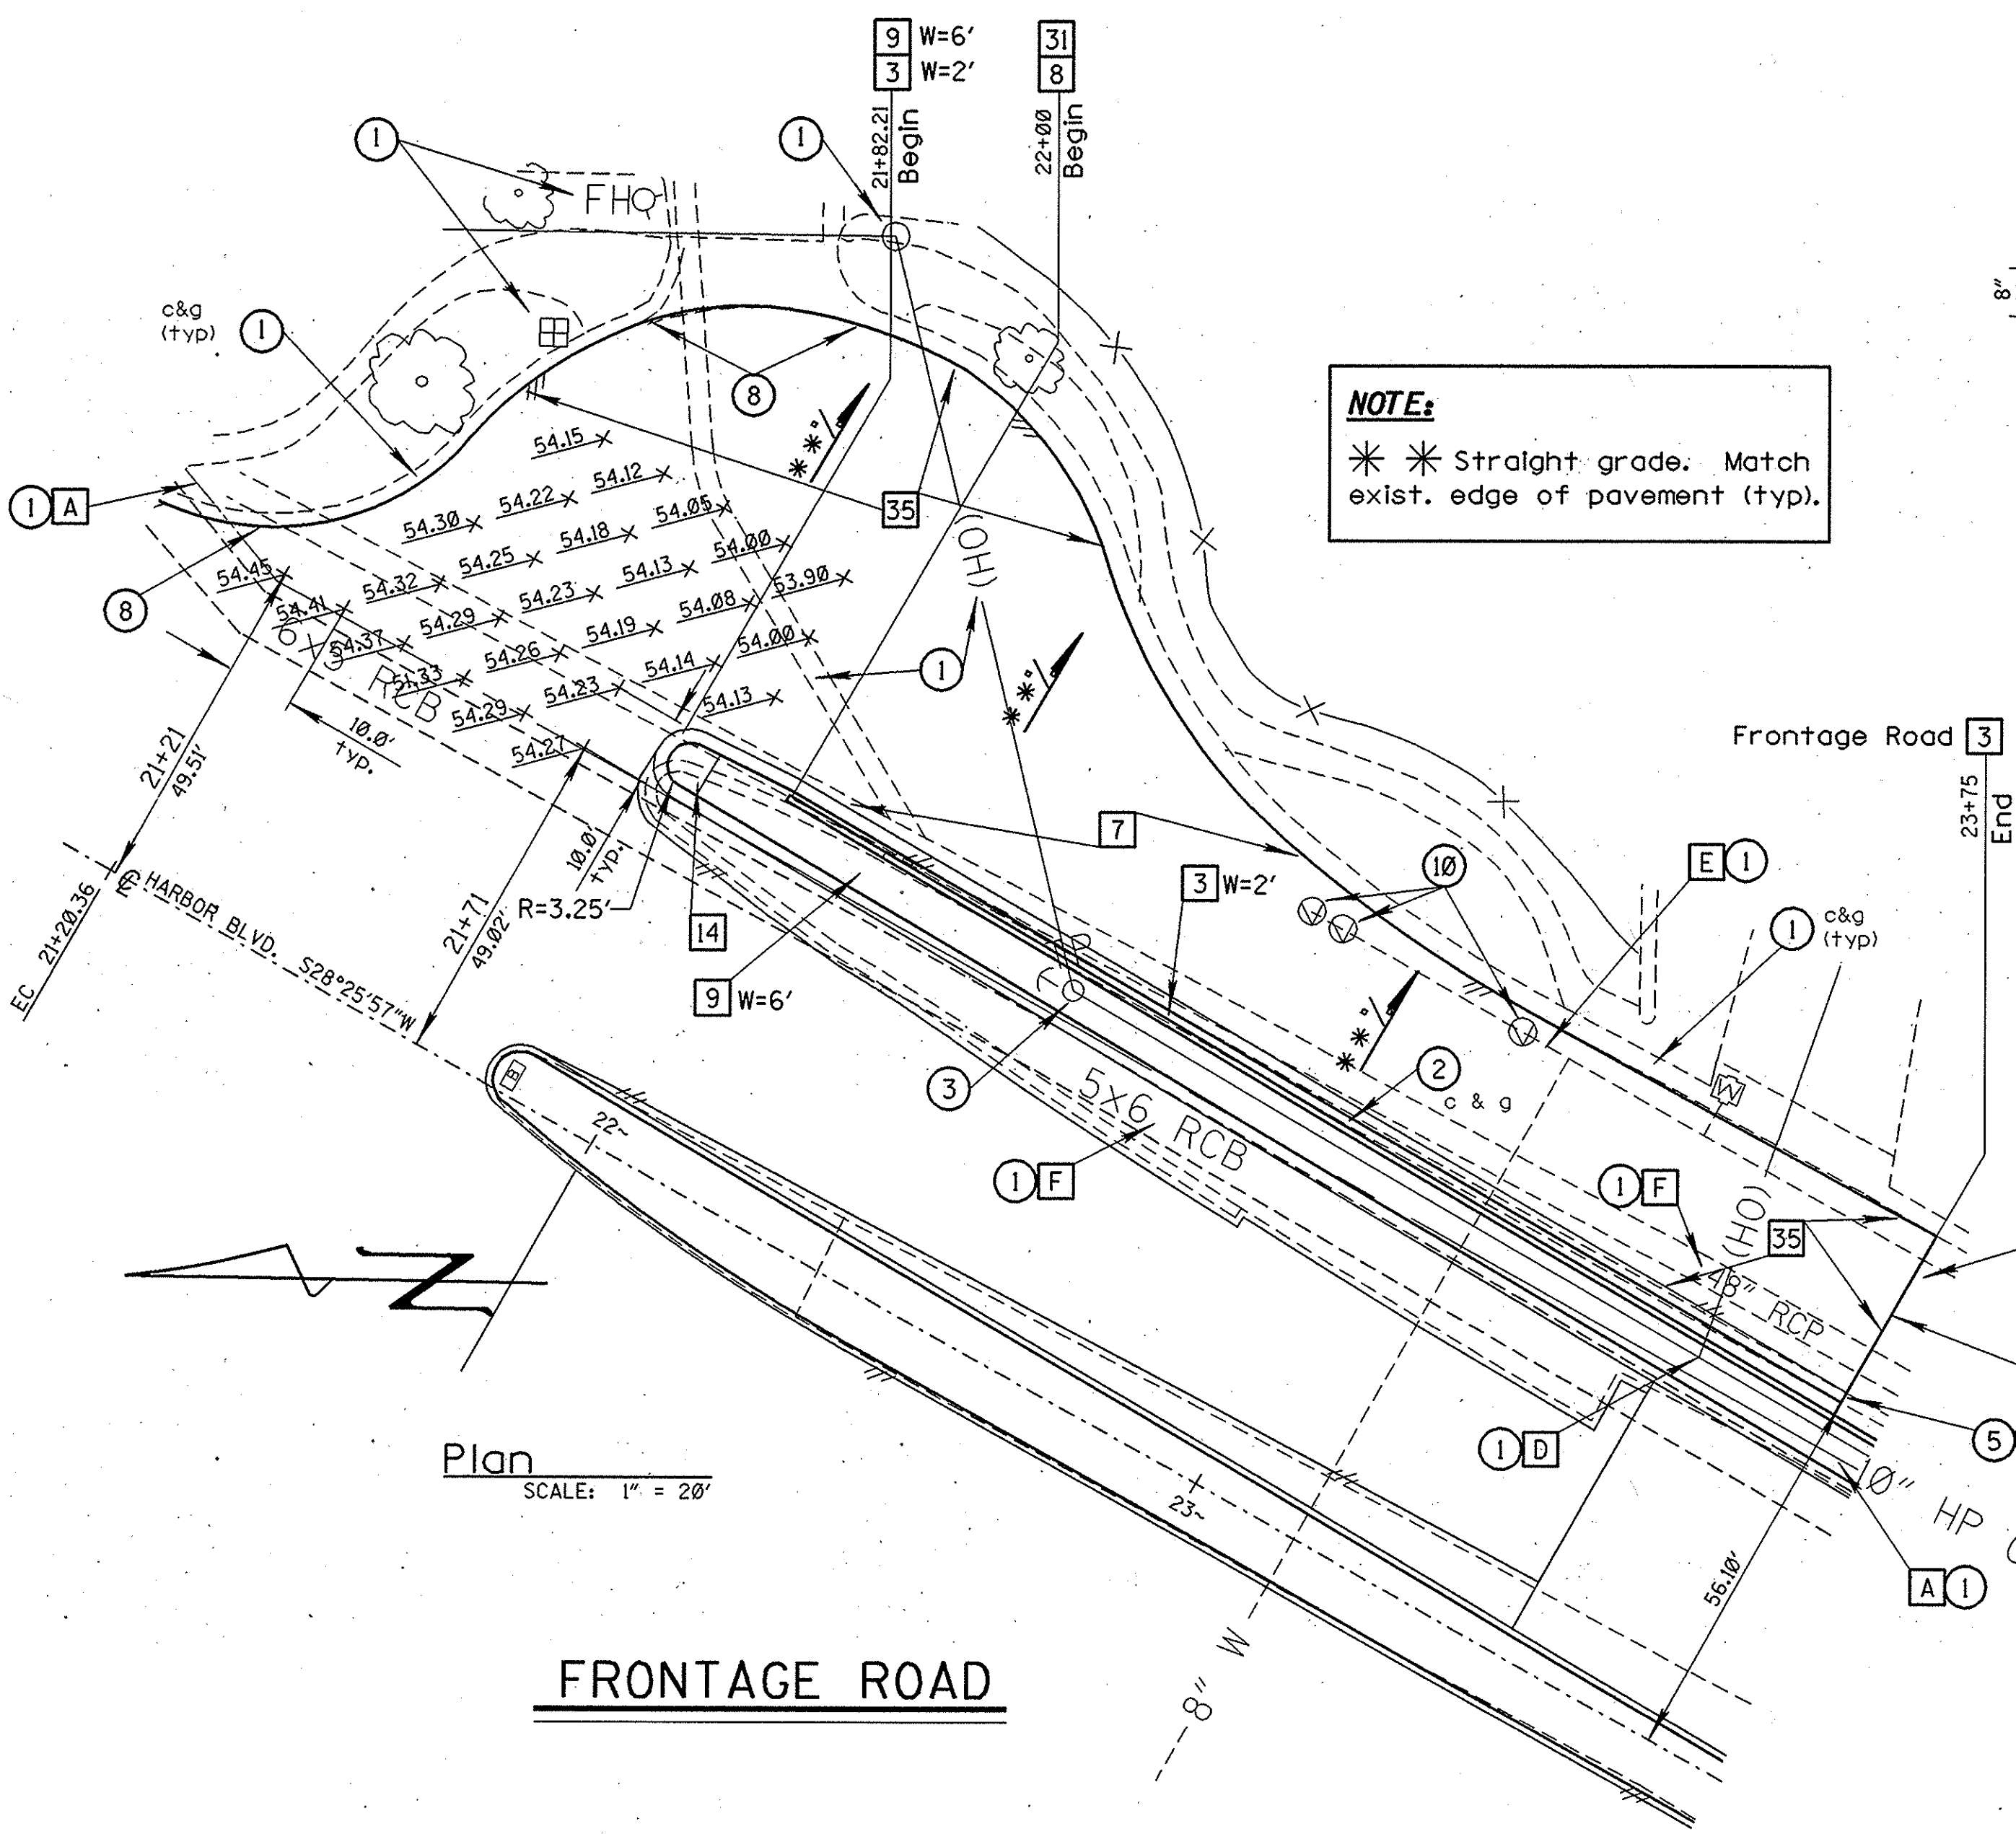

Plan

SCALE: 1" = 20'

FRONTAGE ROAD

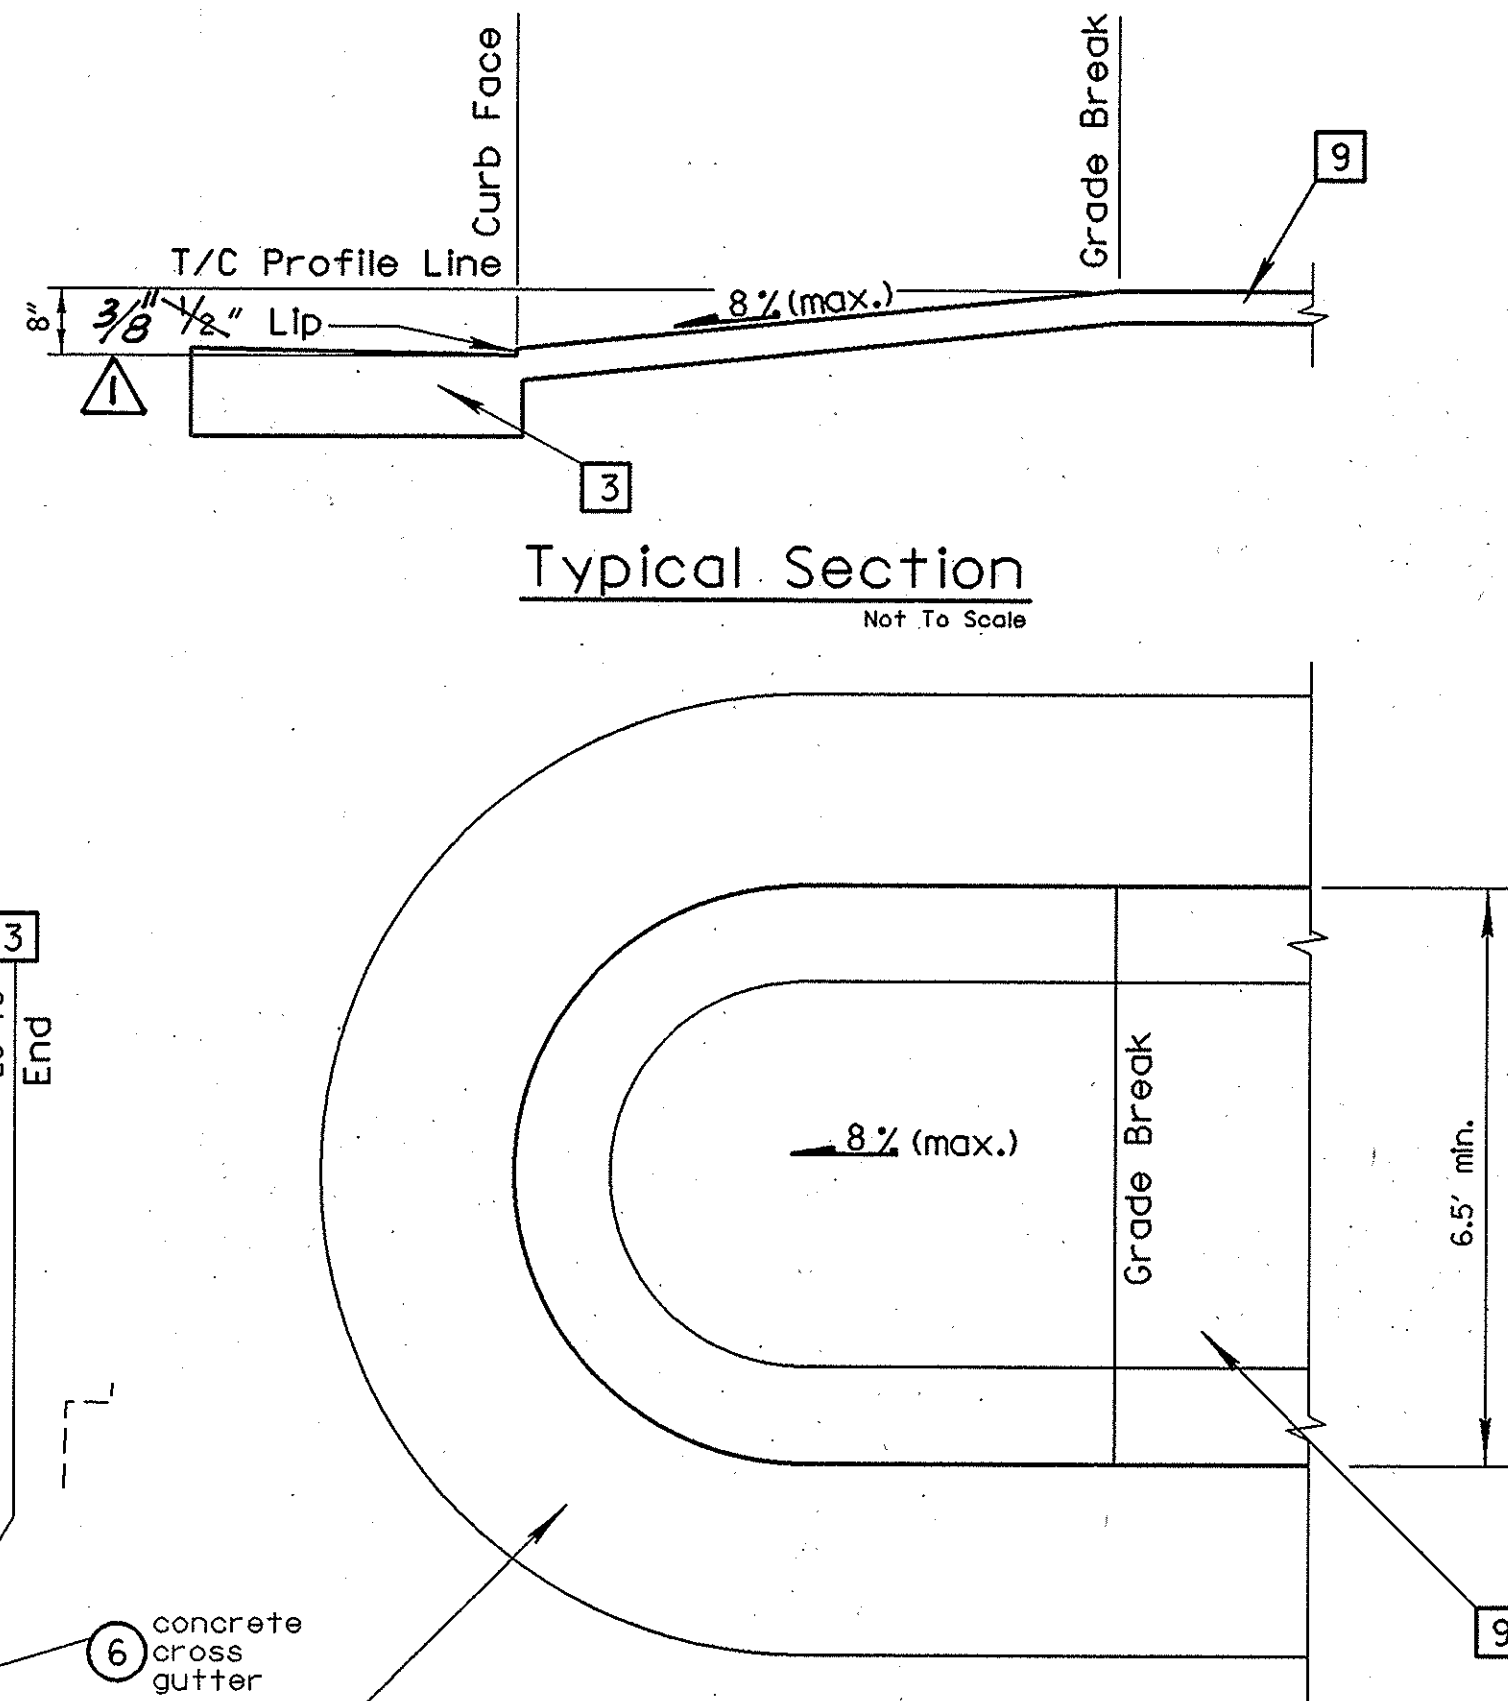

Typical Section

Not To Scale

PLAN

SIDEWALK ACCESS RAMP


14

UTILITIES

- A 10" H.P. Gas
- B Overhead Lines & Poles
- C Overhead Lines & Poles
- D Overhead Lines & Poles
- E Water Line
- F Storm Drain & RCB

OWNER

- So. Calif. Gas Co.
- Western Union
- Edison Company
- Pacific Bell
- City of Fountain Valley
- OCFCD

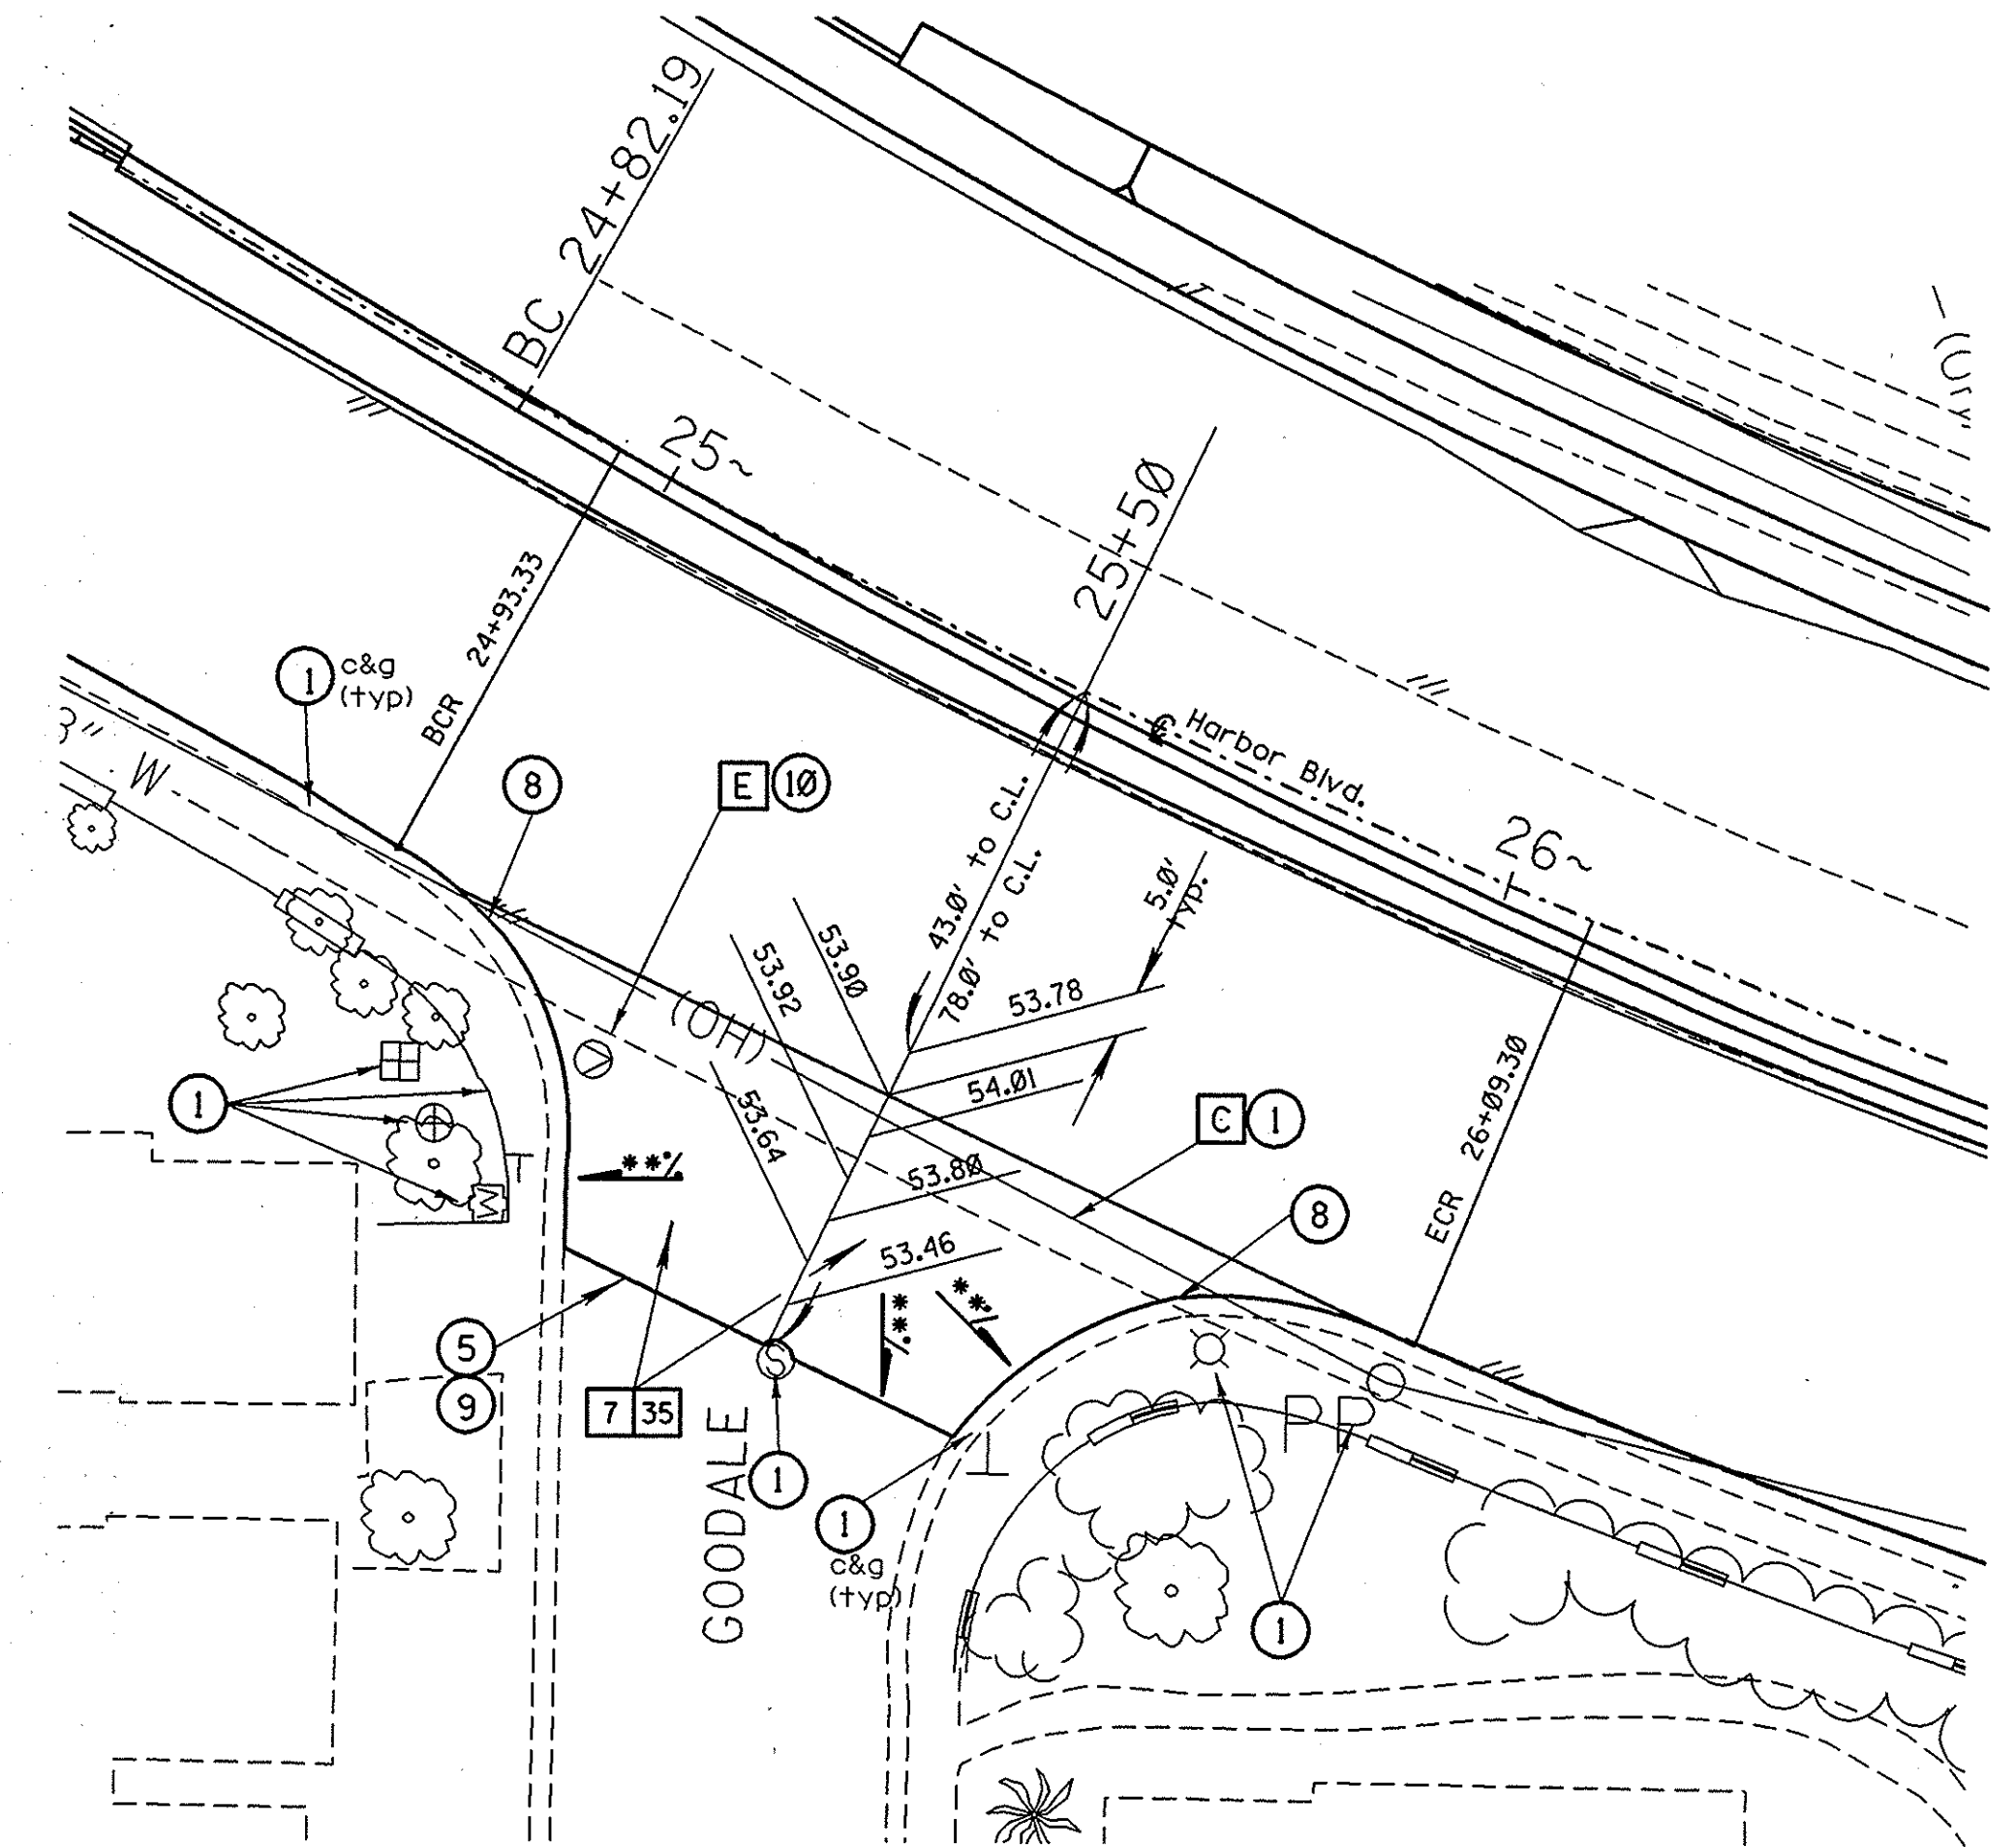

Plan

GOODALE AVENUE

SCALE: 1" = 20'

RECORD DRAWING

CAUTION: A 10" HIGH PRESSURE GAS LINE RUNS PARALLEL AND BENEATH HARBOR BLVD. CONTRACTOR TO USE EXTREME CARE WHEN WORKING IN VICINITY OF THIS UTILITY.

LEGEND

- 1 Protect in place
- 2 To be removed
- 3 To be relocated by others
- 4 Remove and salvage
- 5 Sawcut
- 6 Join existing and feather to satisfaction of Engineer.
- 7 Remove interfering portions.
- 8 Match exist. edge of pavement.
- 9 Join existing
- 10 Adjust to grade
- 11 Relocate

ORANGE COUNTY ENVIRONMENTAL MANAGEMENT AGENCY	
HARBOR BLVD. IMPROVEMENTS	
INTERSECTION DETAILS	
FRONTAGE ROAD AND GOODALE AVE.	
DESIGNED <u>RBS</u>	CHECKED <u>RAH</u>
DRAWN <u>SG</u>	DRAWING NO. <u>9</u>
SCALE <u>AS SHOWN</u>	DATE <u>3/95</u>
SHEET <u>9</u> OF <u>60</u>	

4/95 REVISE AS SHOWN

MARK DATE DESCRIPTION

REVISIONS

PREPARED UNDER

Richard H. RCE 39595 (exp. 12-31-93)

3/4/95