
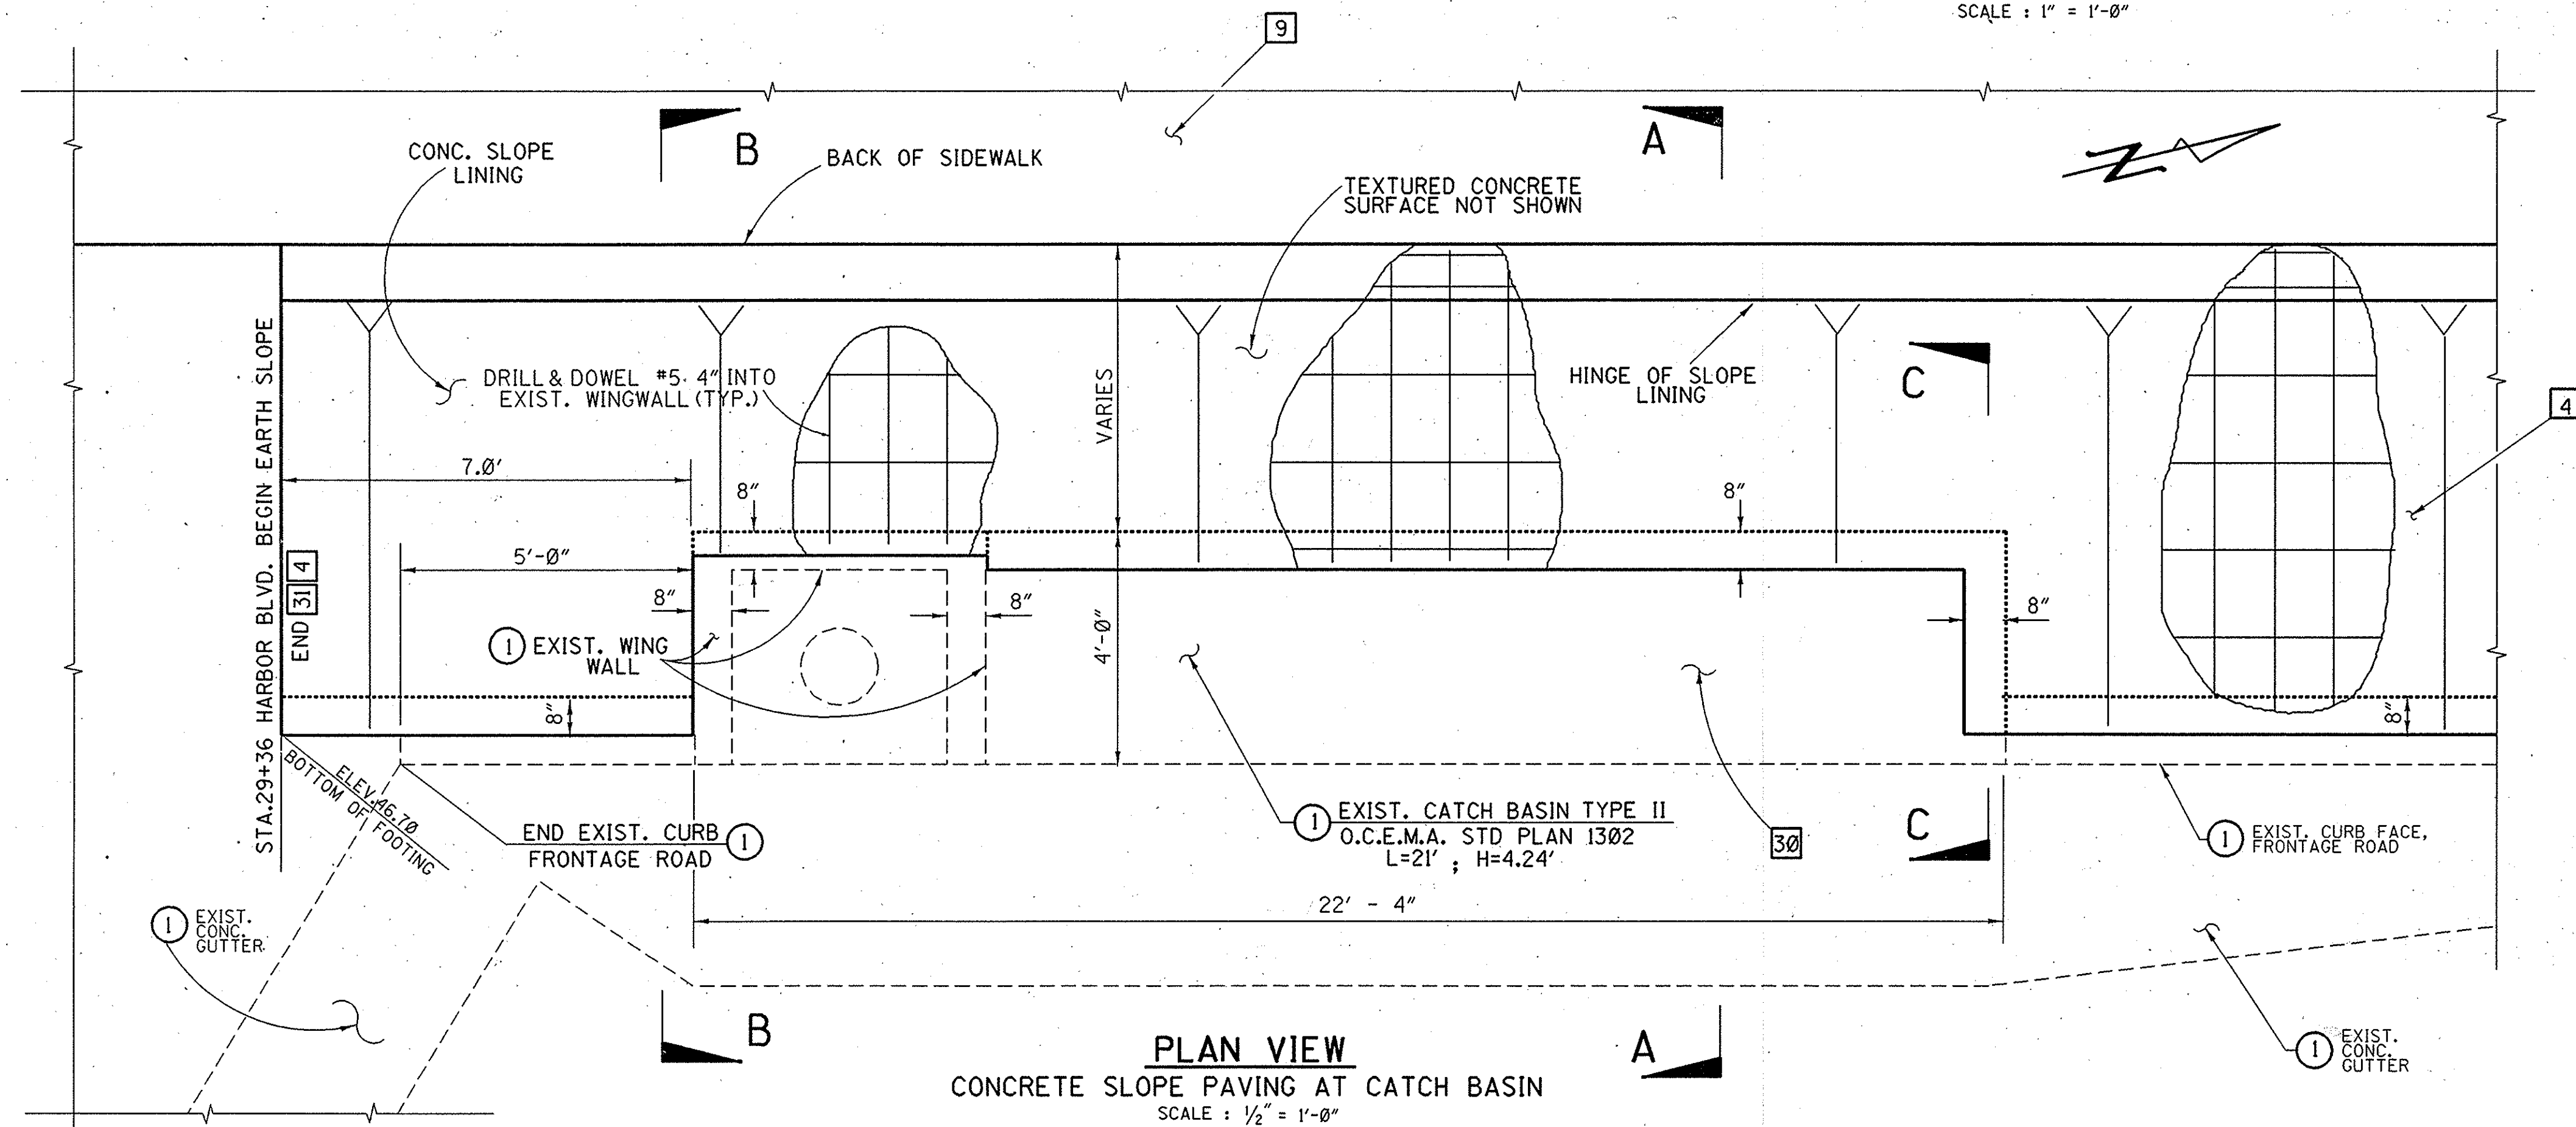


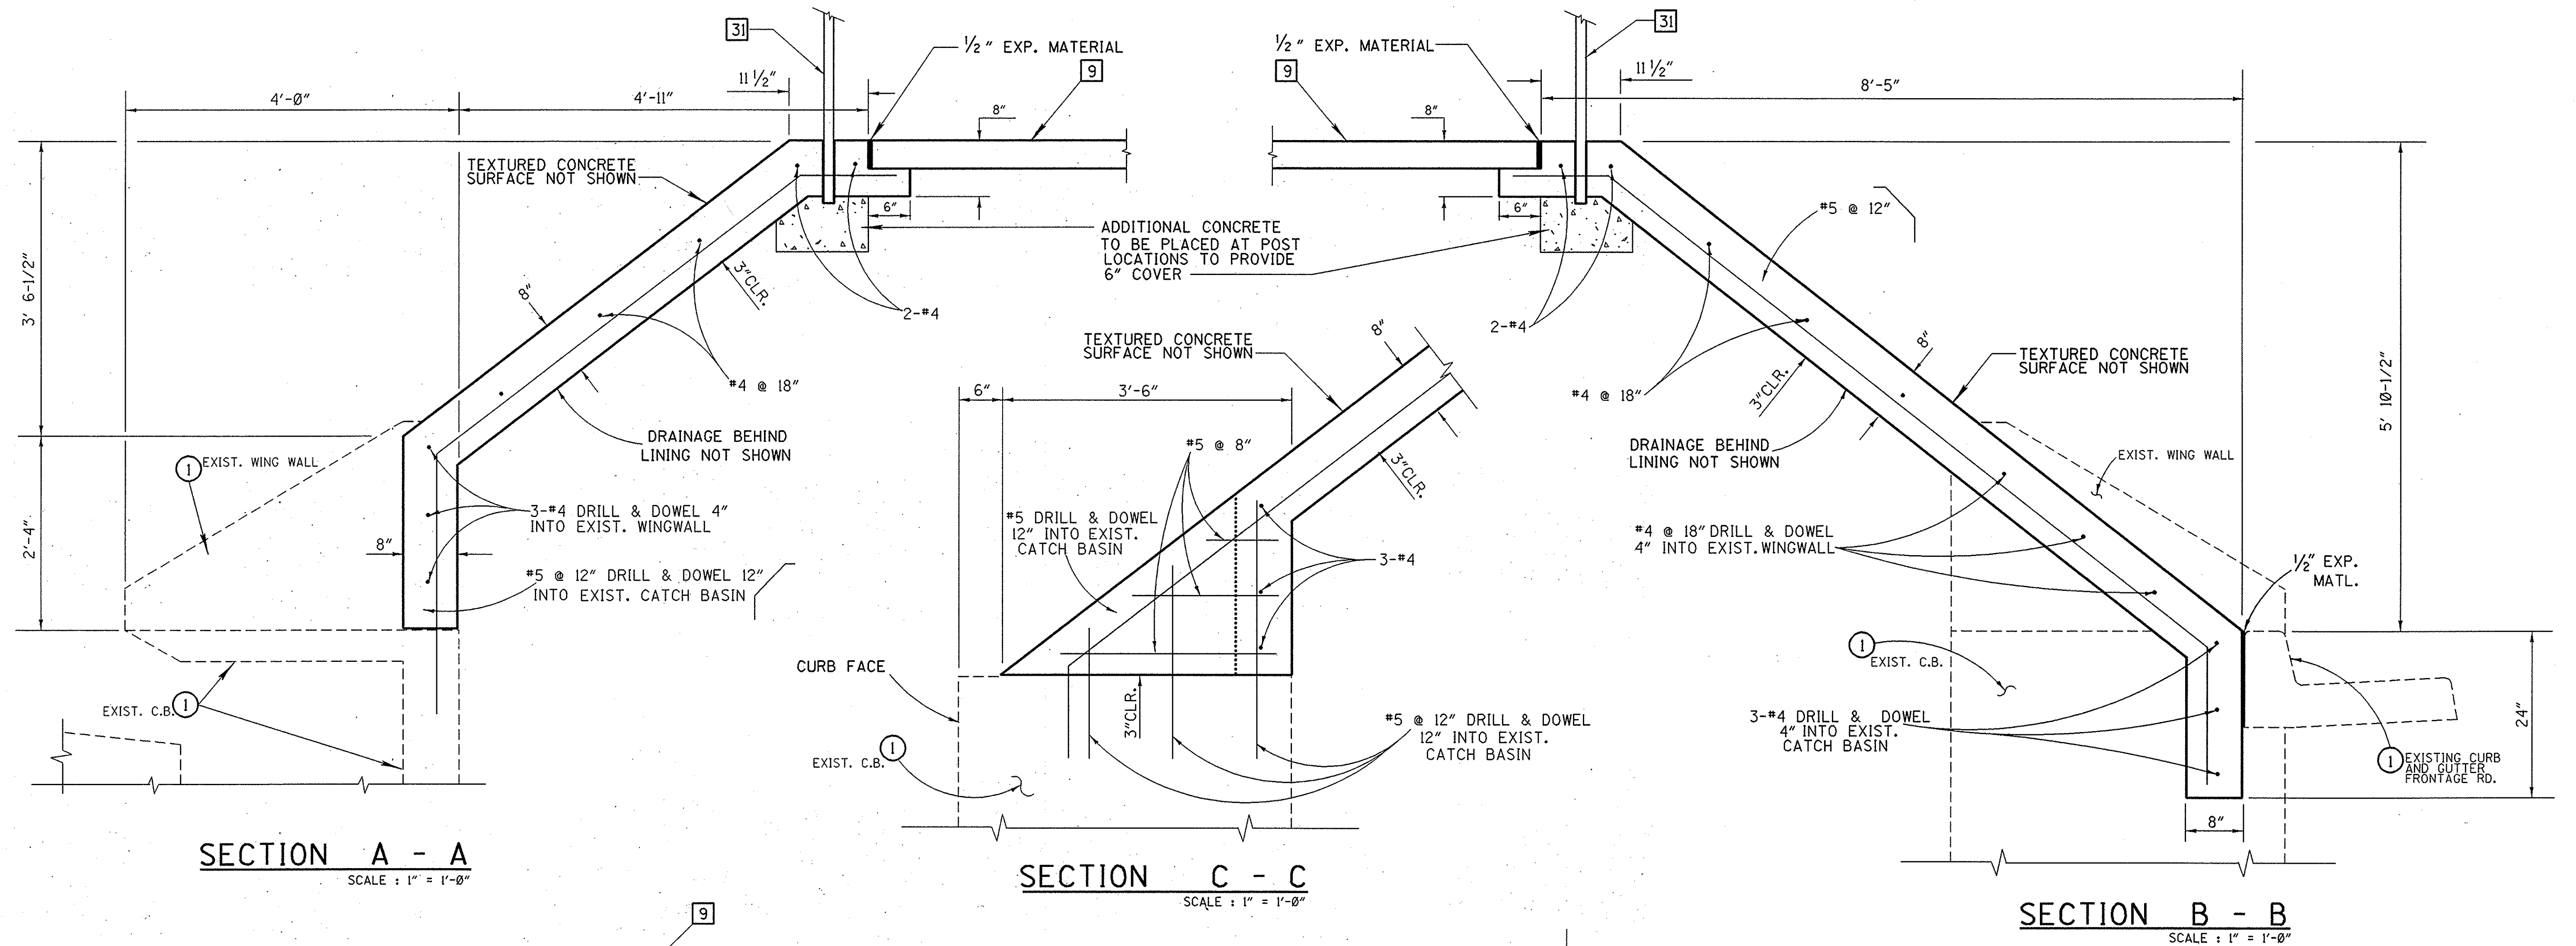

CONSTRUCTION NOTES

- 4 Construct conc. slope lining per details sheet 11.
- 9 Construct PCC sidewalk per EMA STD. Plan No. 1205.
- 30 See sheet 12 for details at catch basin.
- 31 Construct metal hand railing, Type B, per APWA Std. Plan No. 606-0-0C, post spacing 8' C.C. max.

CAUTION : A 10" HIGH PRESSURE GAS LINE RUNS PARALLEL AND BENEATH HARBOR BLVD. CONTRACTOR TO USE EXTREME CARE WHEN WORKING IN VICINITY OF THIS UTILITY.

LEGEND

- 1 Protect in place
- 2 To be removed
- 3 To be relocated by others
- 4 Remove and salvage
- 5 Sawcut
- 6 Join existing and feather to satisfaction of Engineer.
- 7 Remove interfering portions.
- 8 Match exist. edge of pavement.
- 9 Join existing
- 10 Adjust to grade
- 11 Relocate

1/2 0 2
3 inches on original drawing

ORANGE COUNTY ENVIRONMENTAL MANAGEMENT AGENCY	
HARBOR BLVD. IMPROVEMENTS	
SLOPE LINING AT CATCH BASIN	
29+25	
DESIGNED R.R.S.	SHEET
DRAWN H.P.	12
CHECKED R.H.	OF 60
SCALE AS SHOWN	DATE JAN 1993
DRAWING NO.	

PREPARED UNDER
RICHARD A. HART
RCE 39595 (EXP. 12-31-93)

3/4/93

RECORD DRAWING