


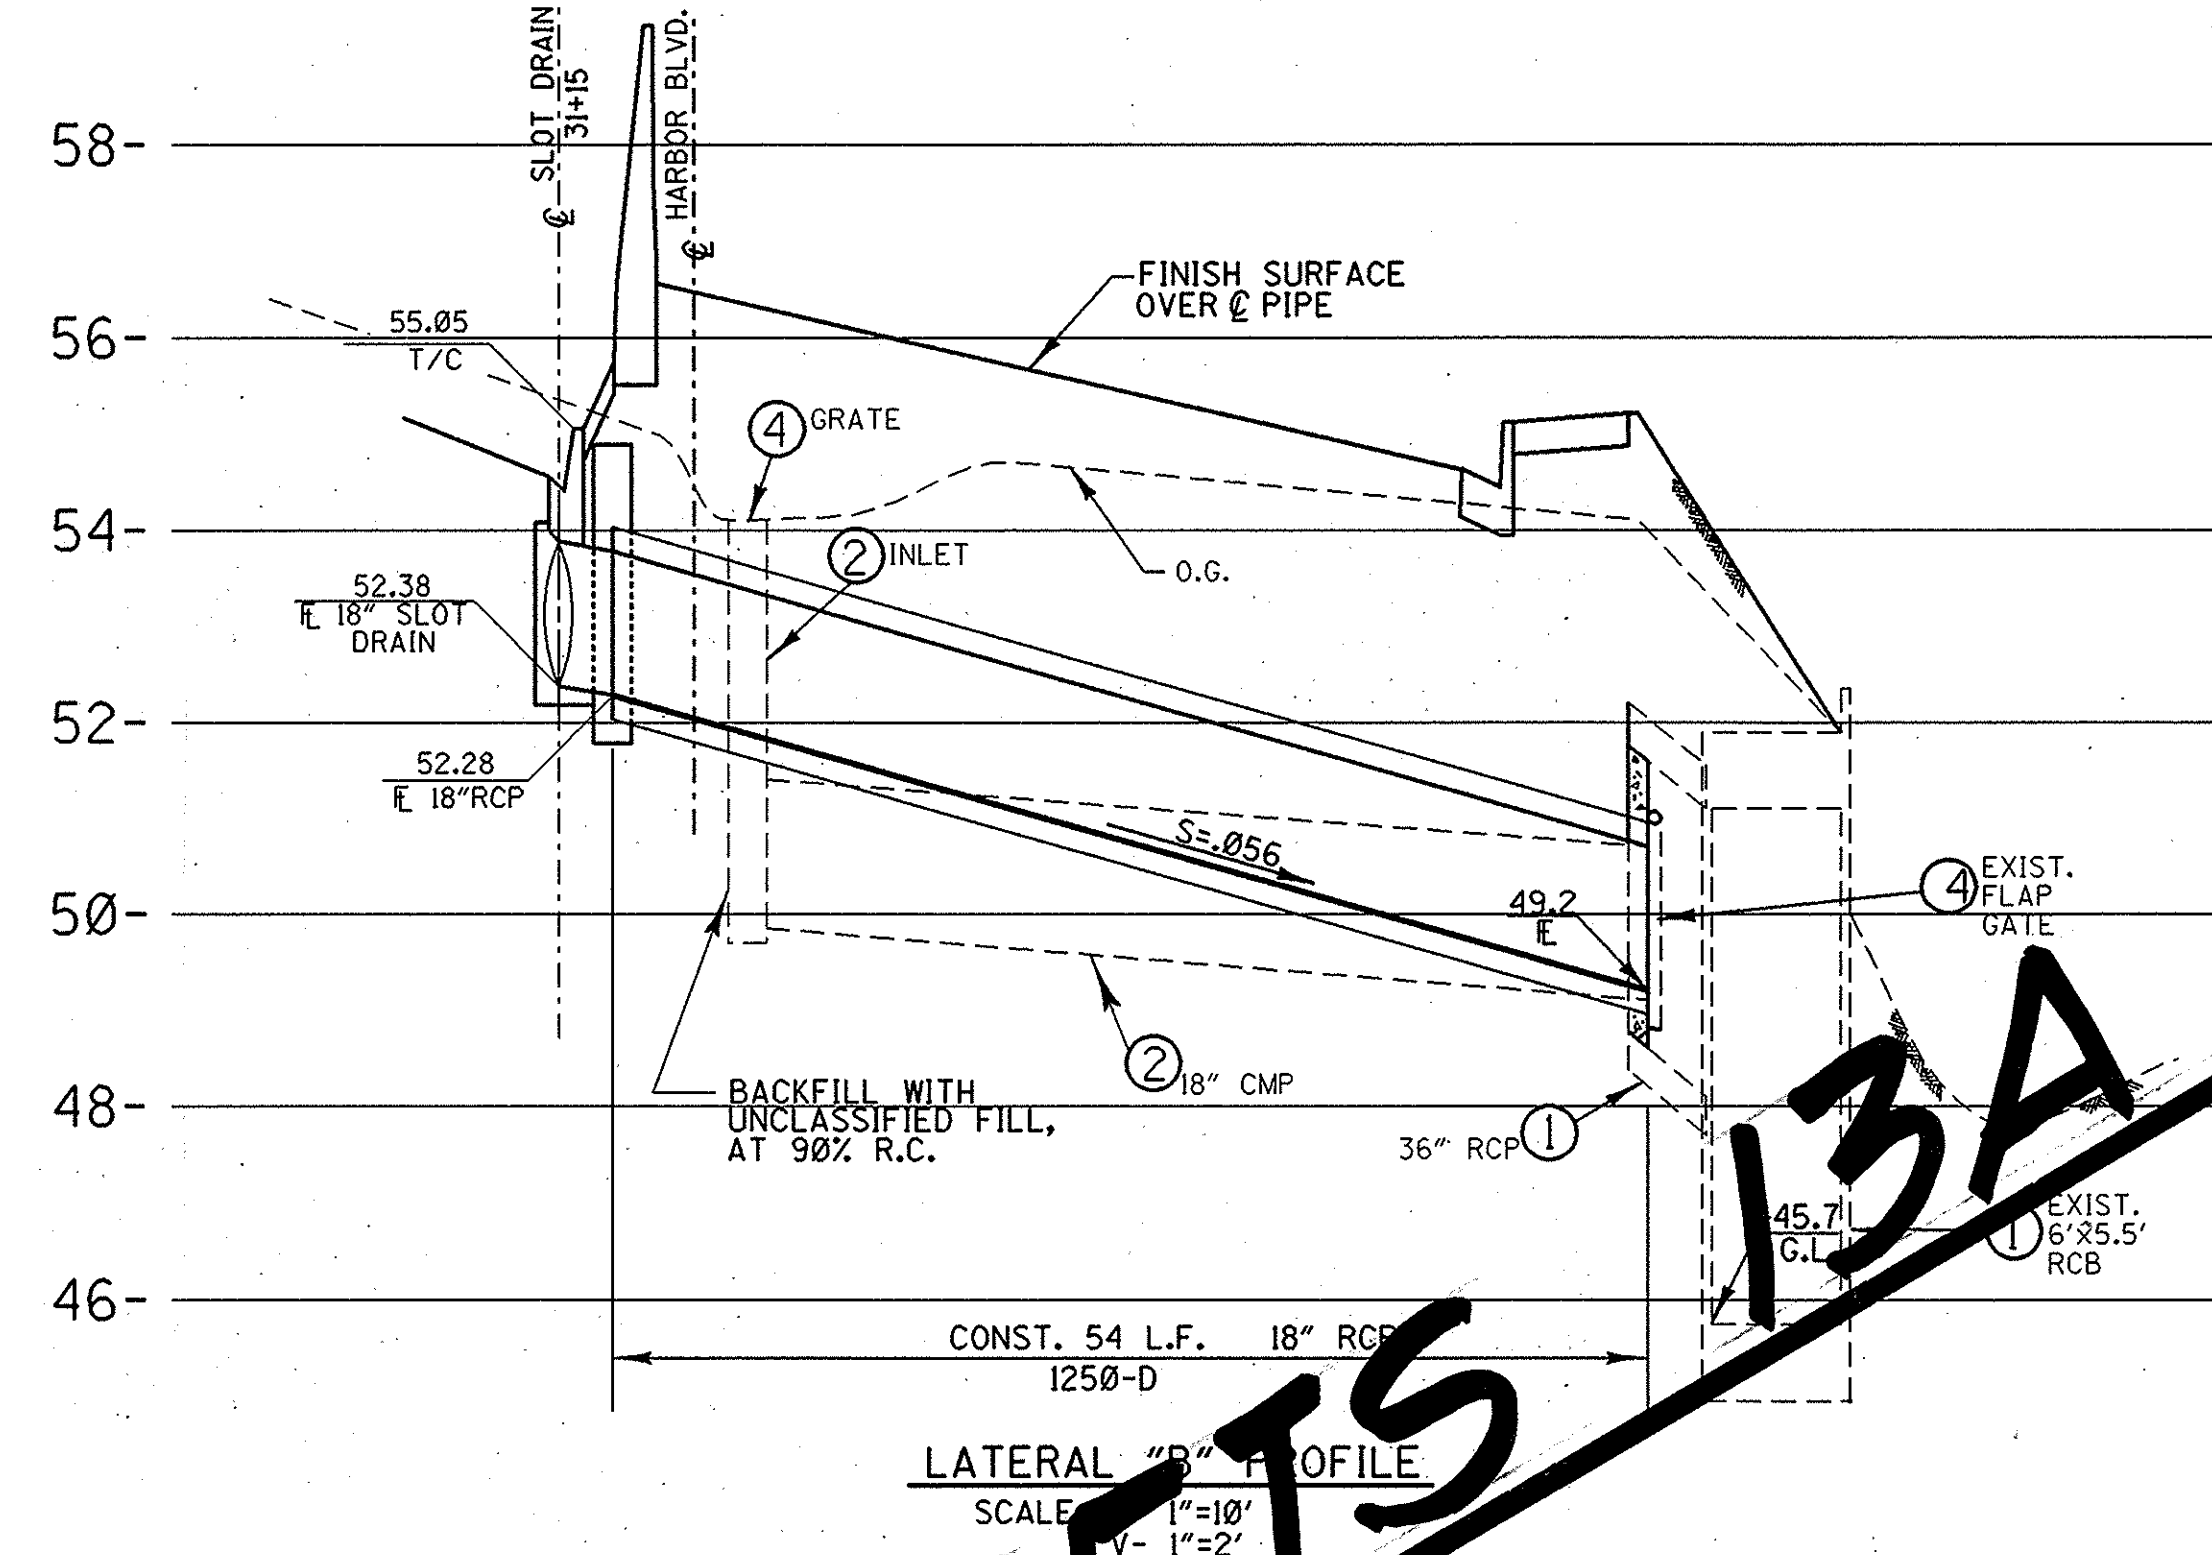


- [illegible]

- ### LEGEND
- ① Protect in place
 - ② To be removed
 - ③ To be relocated by others
 - ④ Remove and salvage
 - ⑤ Sawcut
 - ⑥ Join existing and feather to satisfaction of Engineer.
 - ⑦ Remove interfering portions.
 - ⑧ Match exist. edge of pavement.
 - ⑨ Join existing
 - ⑩ Adjust to grade
 - ⑪ Relocate

RECORD DRAWING

CAUTION: A 10" HIGH PRESSURE
GAS LINE RUNS PARALLEL AND BENEATH
HARBOR BLVD. CONTRACTOR TO USE
EXTREME CARE WHEN WORKING IN VICINITY
OF THIS UTILITY.

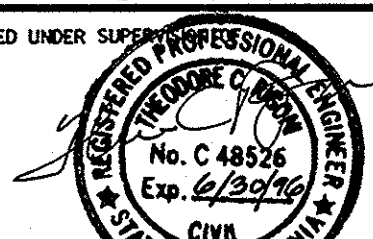

			ORANGE COUNTY ENVIRONMENTAL MANAGEMENT AGENCY	
			HARBOR BLVD. IMPROVEMENTS	
			LOCAL DRAINAGE	
			LATERALS A & B	
MARK	DATE	DESCRIPTION		
R E V I S I O N S				
PREPARED UNDER SUPERVISION OF				
 3/4/93 DATE				
TED RIGONI			DESIGNED <u>T. RIGONI</u>	SHEET
RCE 48526 (exp. 06-30-96)			DRAWN <u>SG/AHP</u>	13
			SCALE _____ DATE _____ CHECKED <u>RAH</u>	
			AS SHOWN MAR '93 DRAWING NO.	OF 60