



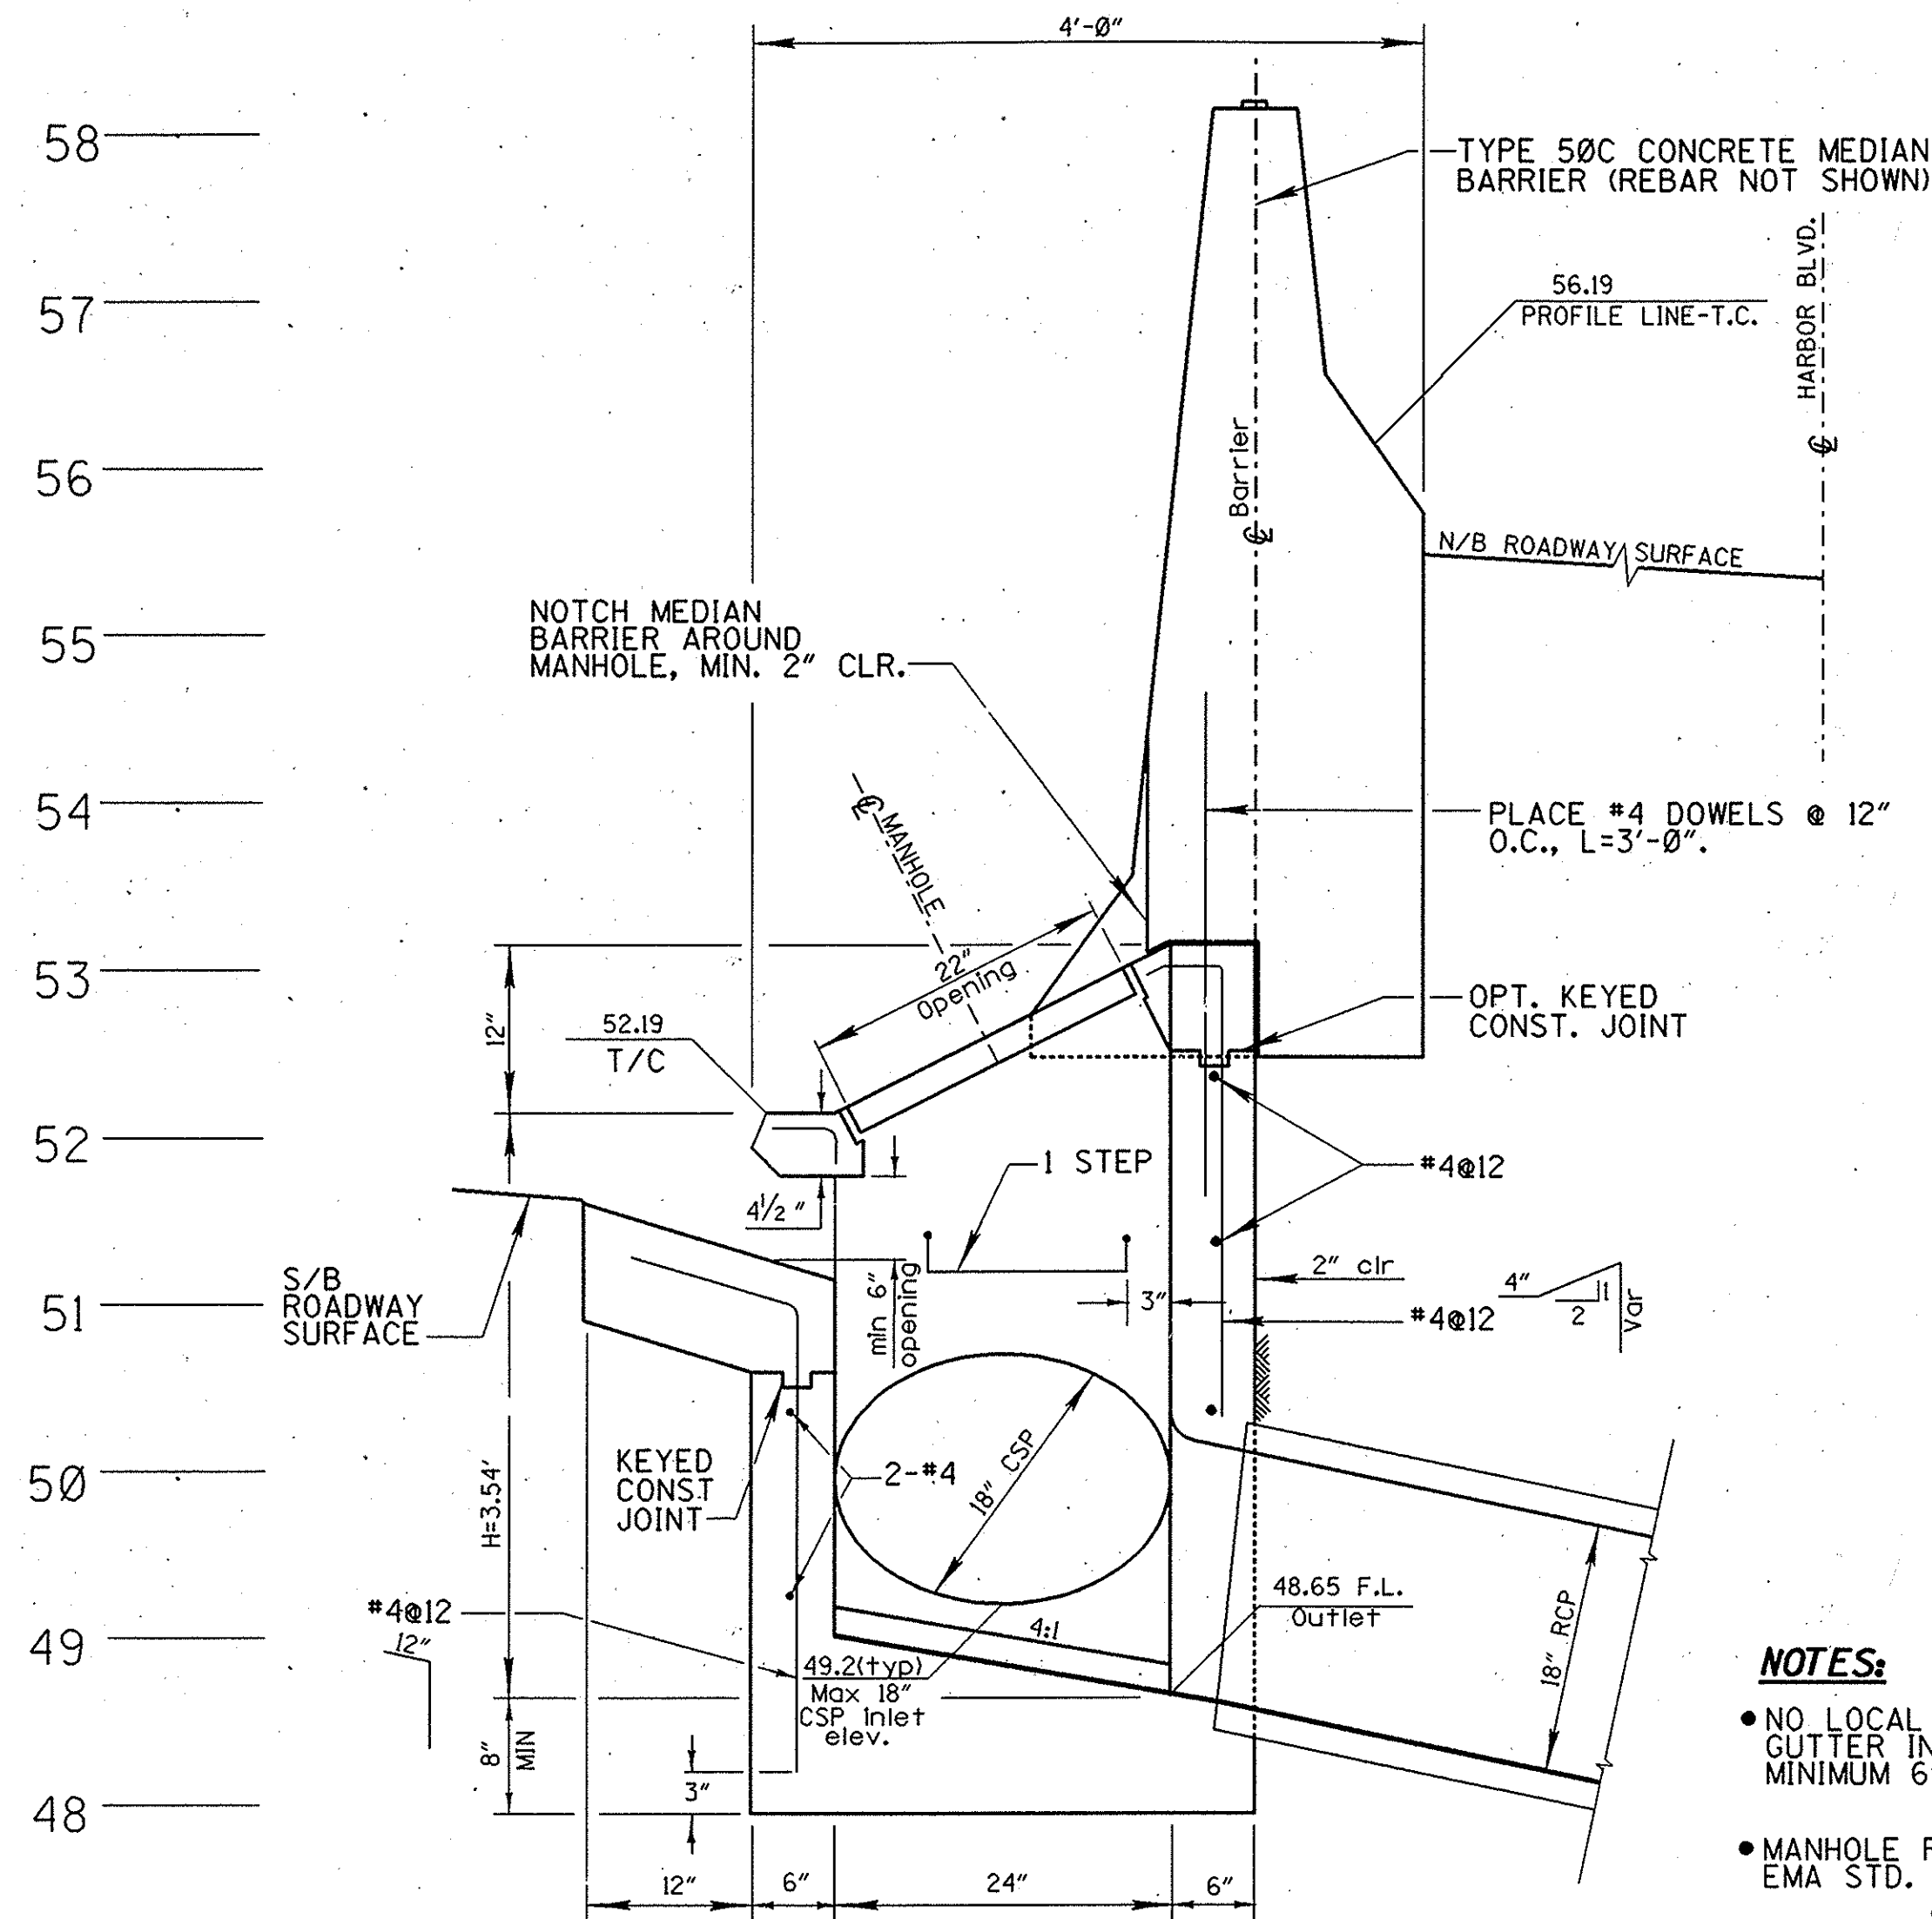


PROFILE (Looking Northerly)
SCALE: 1" = 1'

NOTES:

- NO LOCAL DEPRESSION. SLOPE GUTTER INLET TO ALLOW FOR MINIMUM 6" OPENING.
- MANHOLE FRAME AND COVER PER EMA STD. PLAN NO. 1312.
- CURB AND GUTTER TYPE "DETAIL A" PER EMA STD. PLAN NO. 1306.

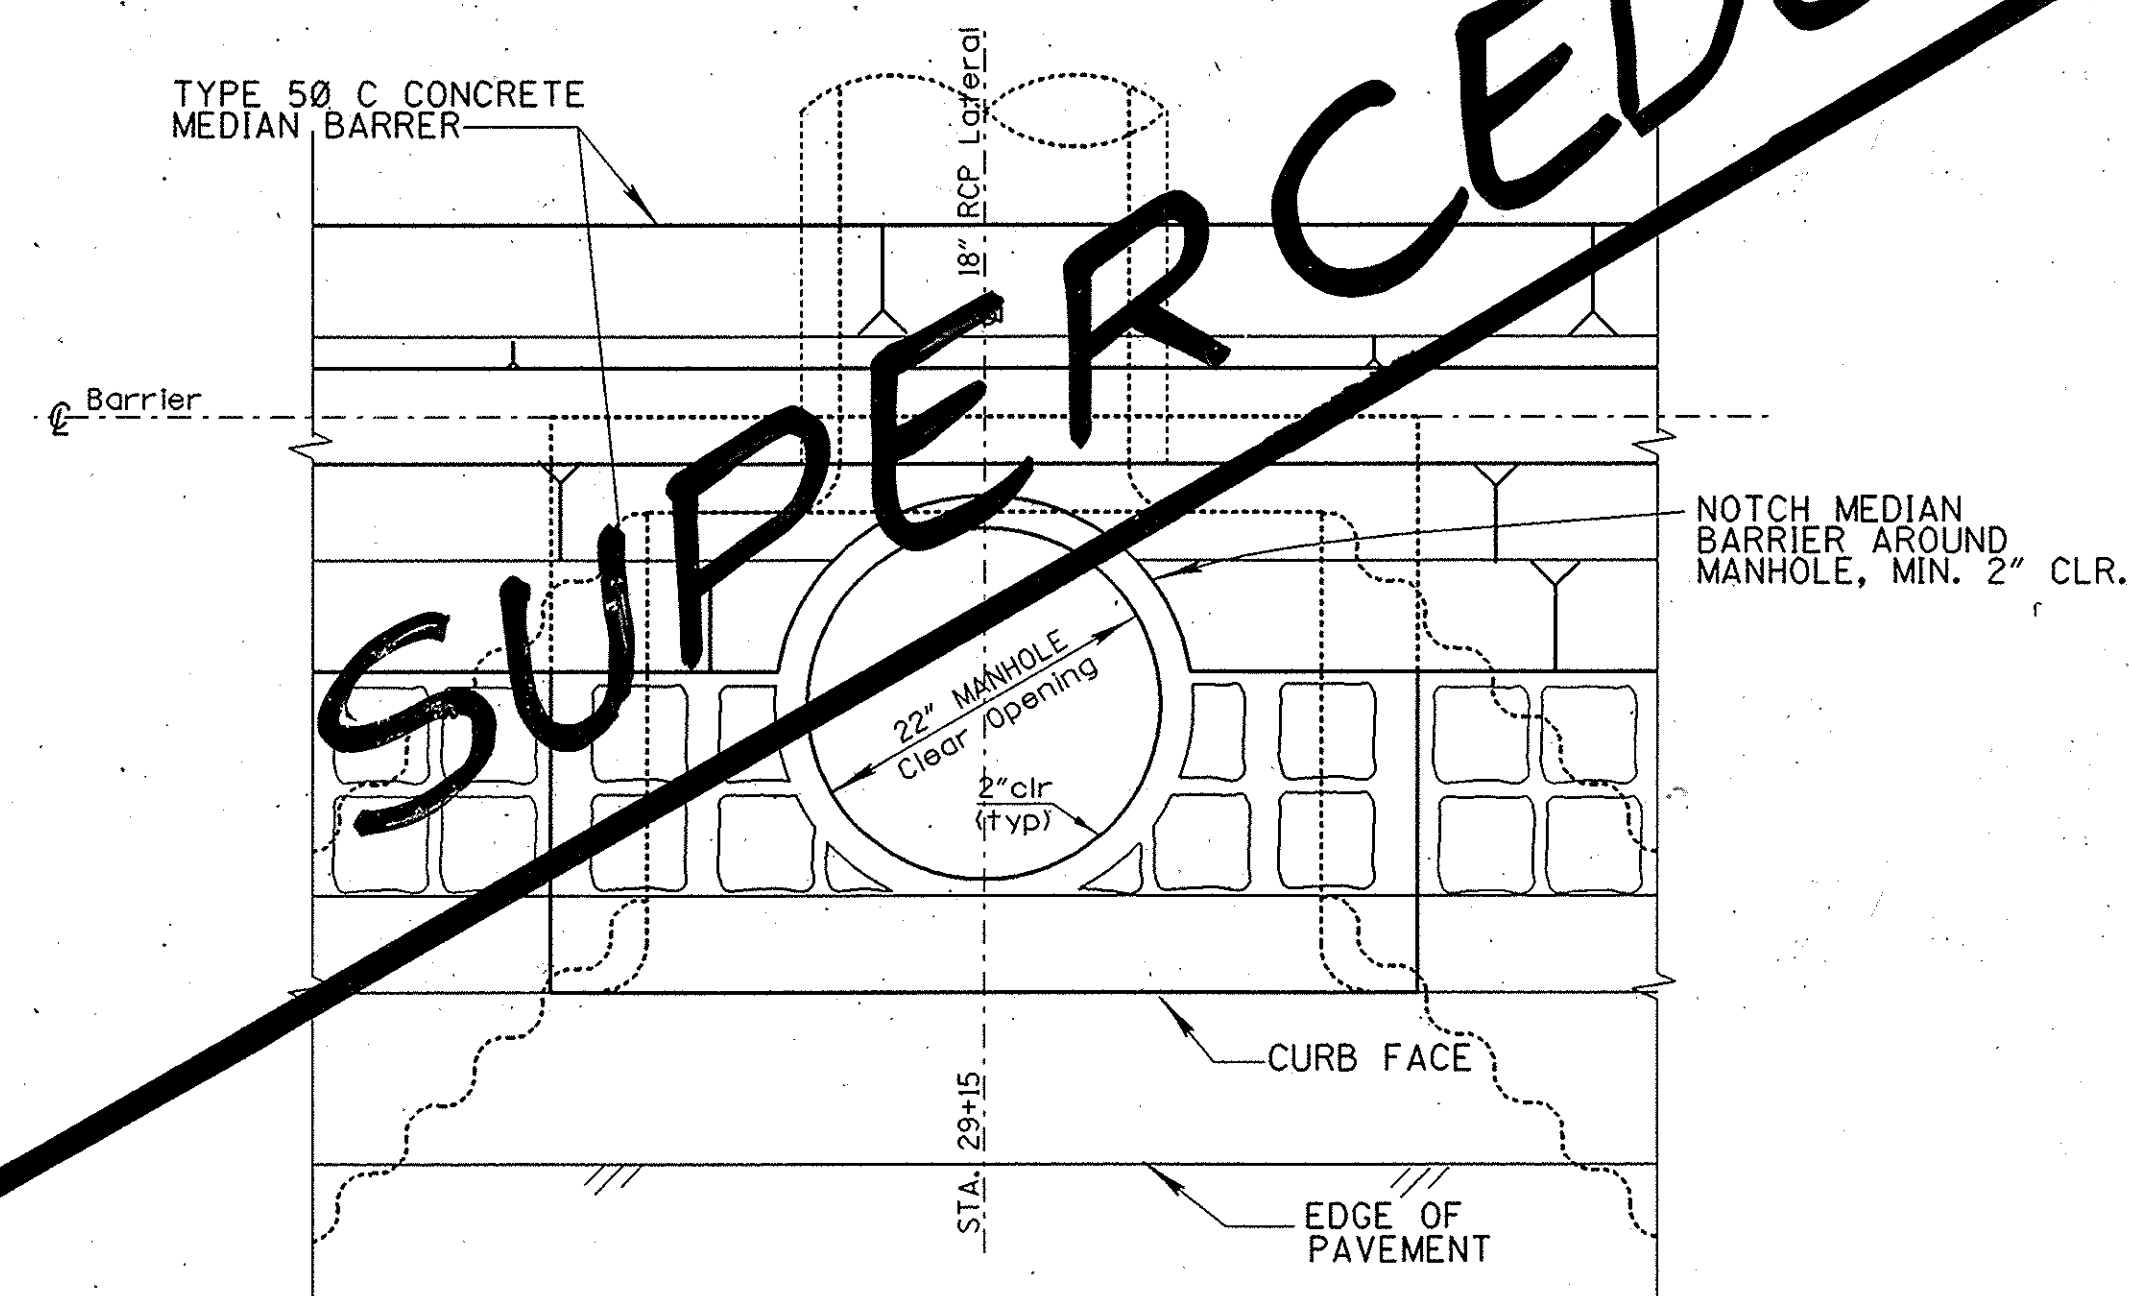


PLAN SURFACE
SCALE: 1" = 1'

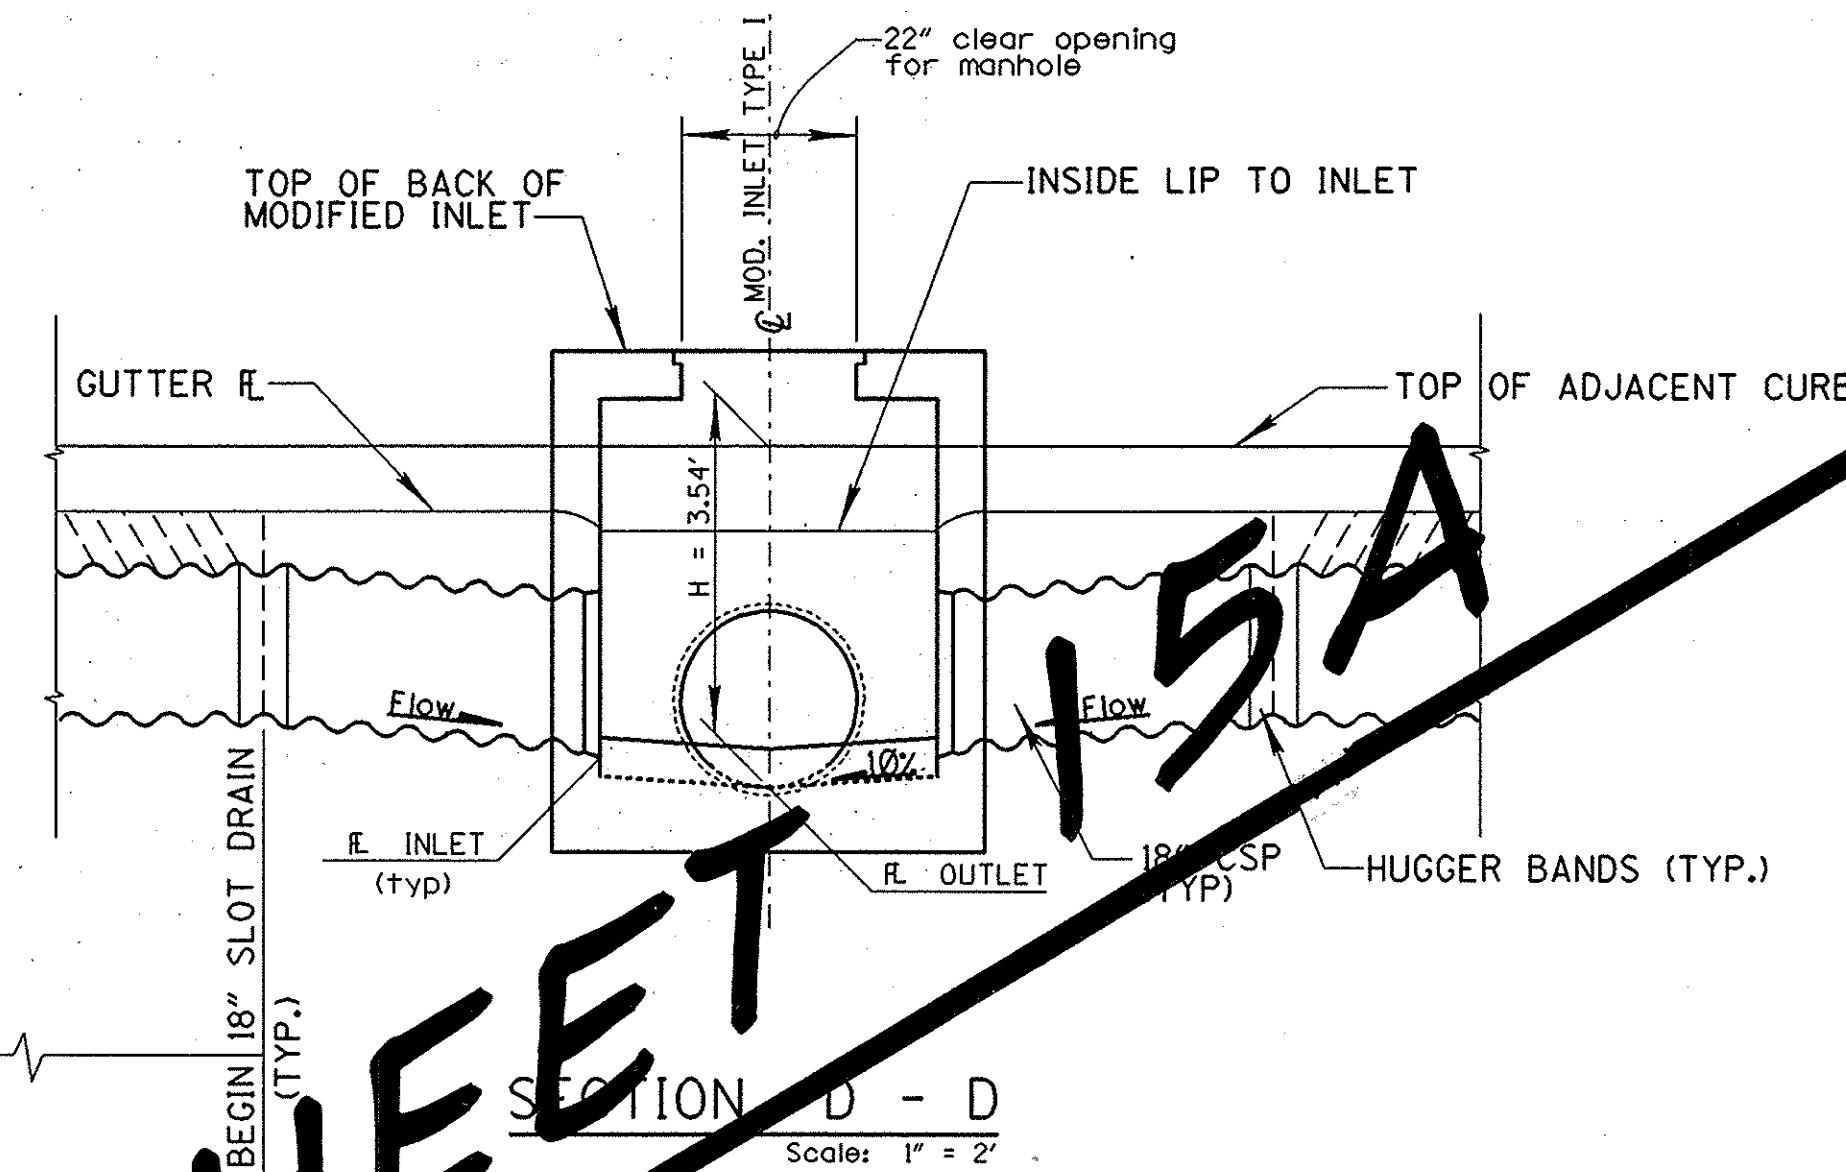

NOTE:

- NO REINFORCEMENT SHOWN
- ADJACENT PATTERN-STAMPED MEDIAN AND CONCRETE MEDIAN BARRIER NOT SHOWN

SEE SHEET 15A

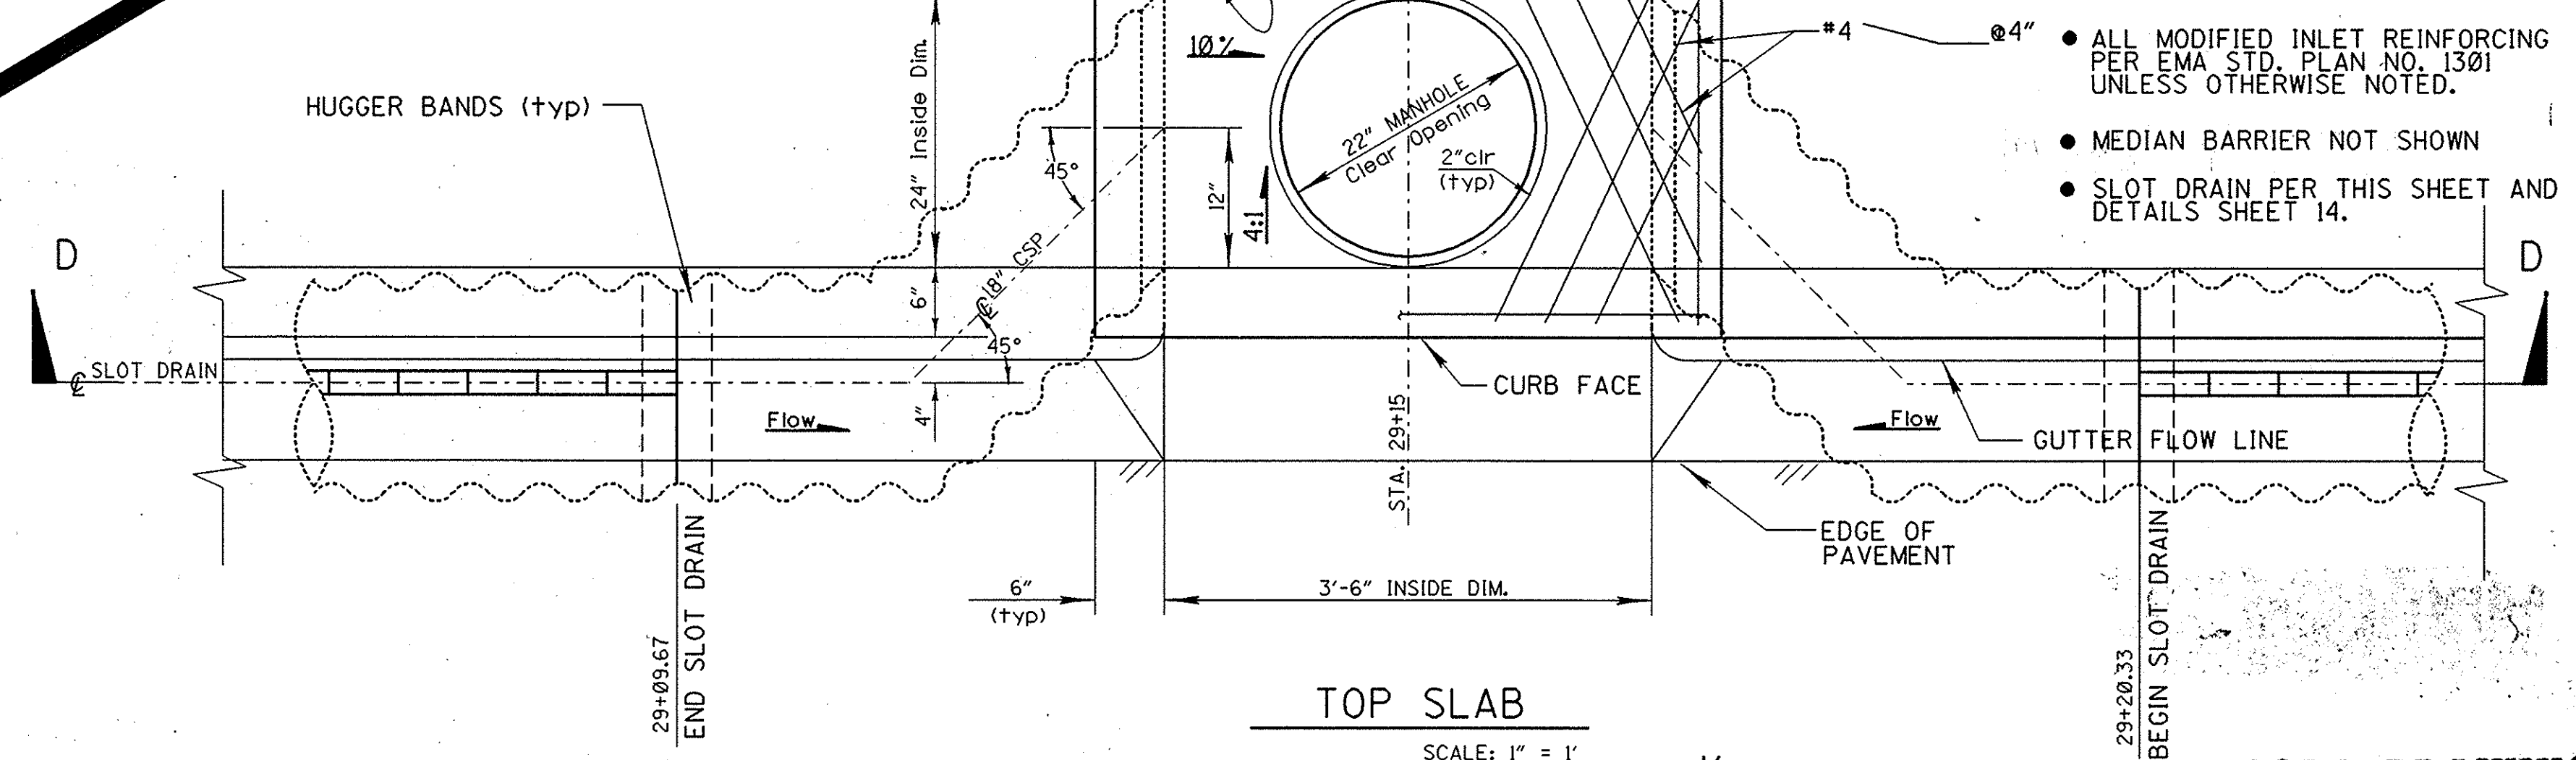

NOTE:

- BASIN CONSTRUCTION SYMMETRICAL ABOUT CENTERLINE
- ALL MODIFIED INLET REINFORCING PER EMA STD. PLAN NO. 1301 UNLESS OTHERWISE NOTED.
- MEDIAN BARRIER NOT SHOWN
- SLOT DRAIN PER THIS SHEET AND DETAILS SHEET 14.

CAUTION: A 10" HIGH PRESSURE GAS LINE RUNS PARALLEL AND BENEATH HARBOR BLVD. CONTRACTOR TO USE EXTREME CARE WHEN WORKING IN VICINITY OF THIS UTILITY.

1/2 0 1 2
3 inches on original drawing

RECORD DRAWING

ORANGE COUNTY ENVIRONMENTAL MANAGEMENT AGENCY	
HARBOR BLVD. IMPROVEMENTS LOCAL DRAINAGE DETAILS MODIFIED TYPE I INLET STA. 29+15	
DESIGNED TCR	CHECKED RAH
DRAWN SG	DATE MAR '93
SCALE AS SHOWN	DRAWING NO.
TED RIGONI RCE 48526 (exp. 06-30-96)	DATE 3/4/93