



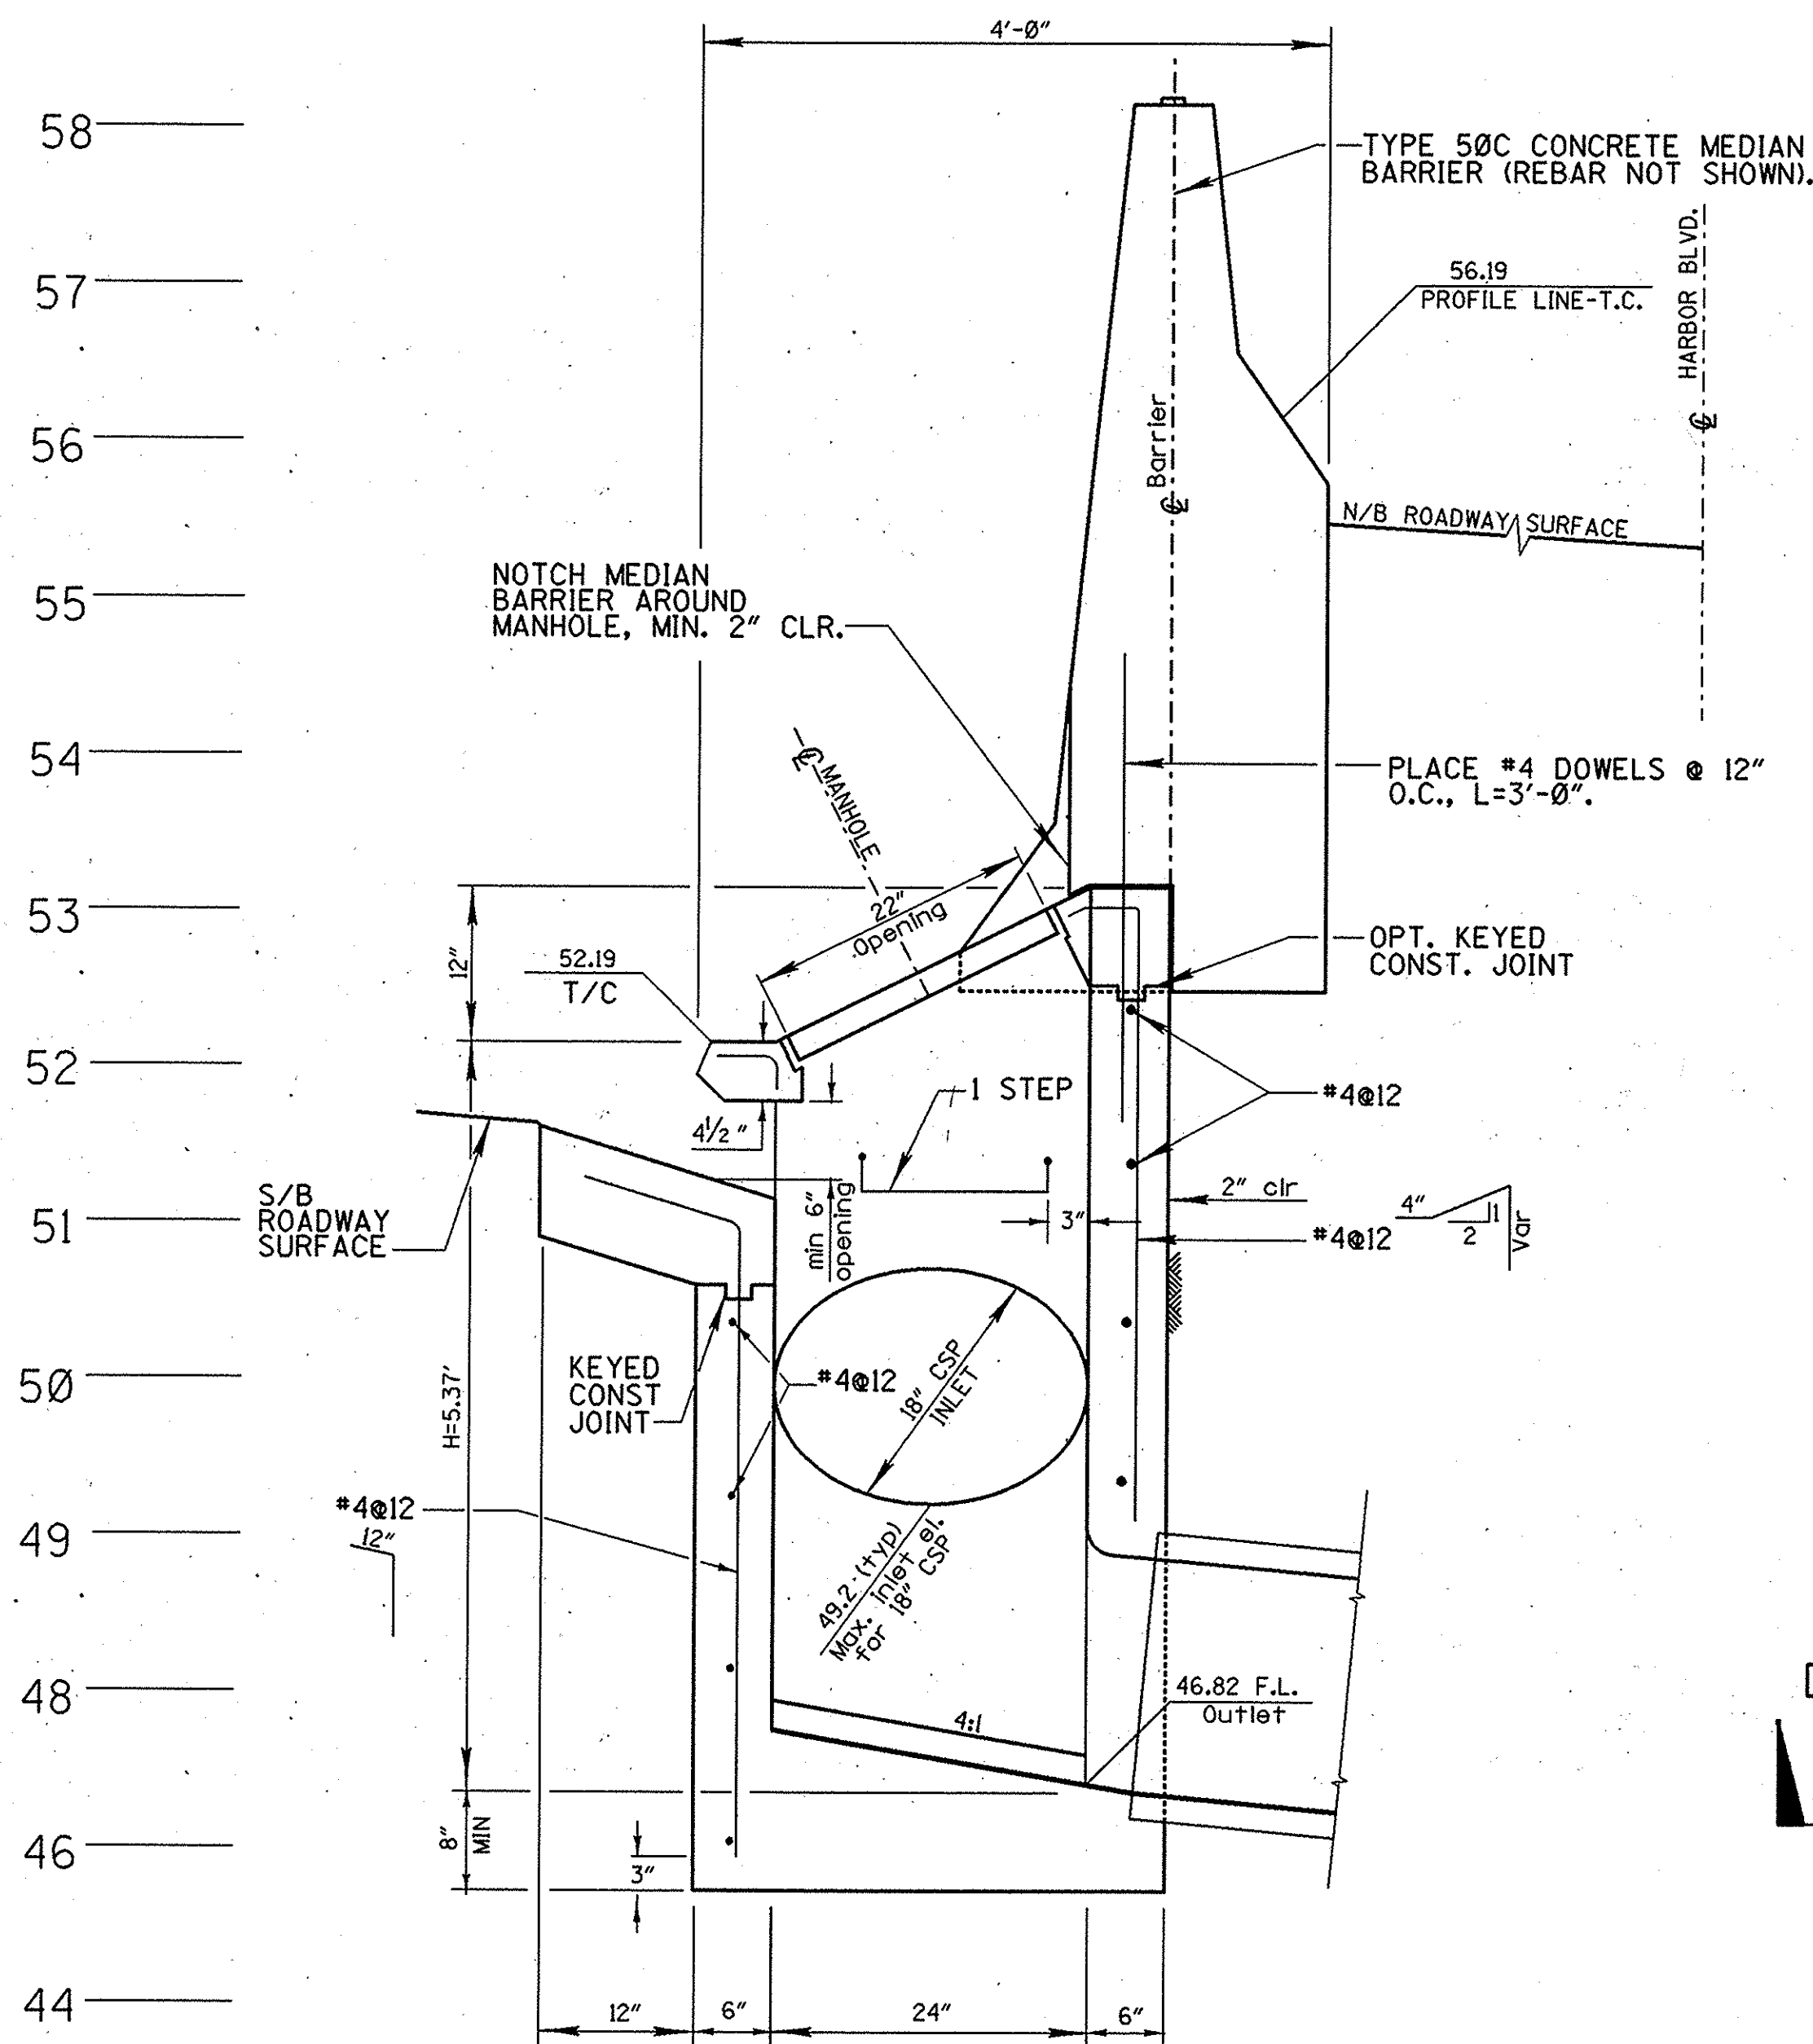

PROFILE (Looking Northerly)
SCALE: 1" = 1'


- NOTE:**
- NO LOCAL DEPRESSION, SLOPE GUTTER INLET TO ALLOW FOR MINIMUM 6" OPENING.
 - MANHOLE FRAME AND COVER PER EMA STD. PLAN NO. 1312.
 - CURB INLET TYPE "DETAIL A" PER EMA STD. PLAN NO. 1306.
 - CORNER CONNECTION PER APWA STD. PLAN 308-0.

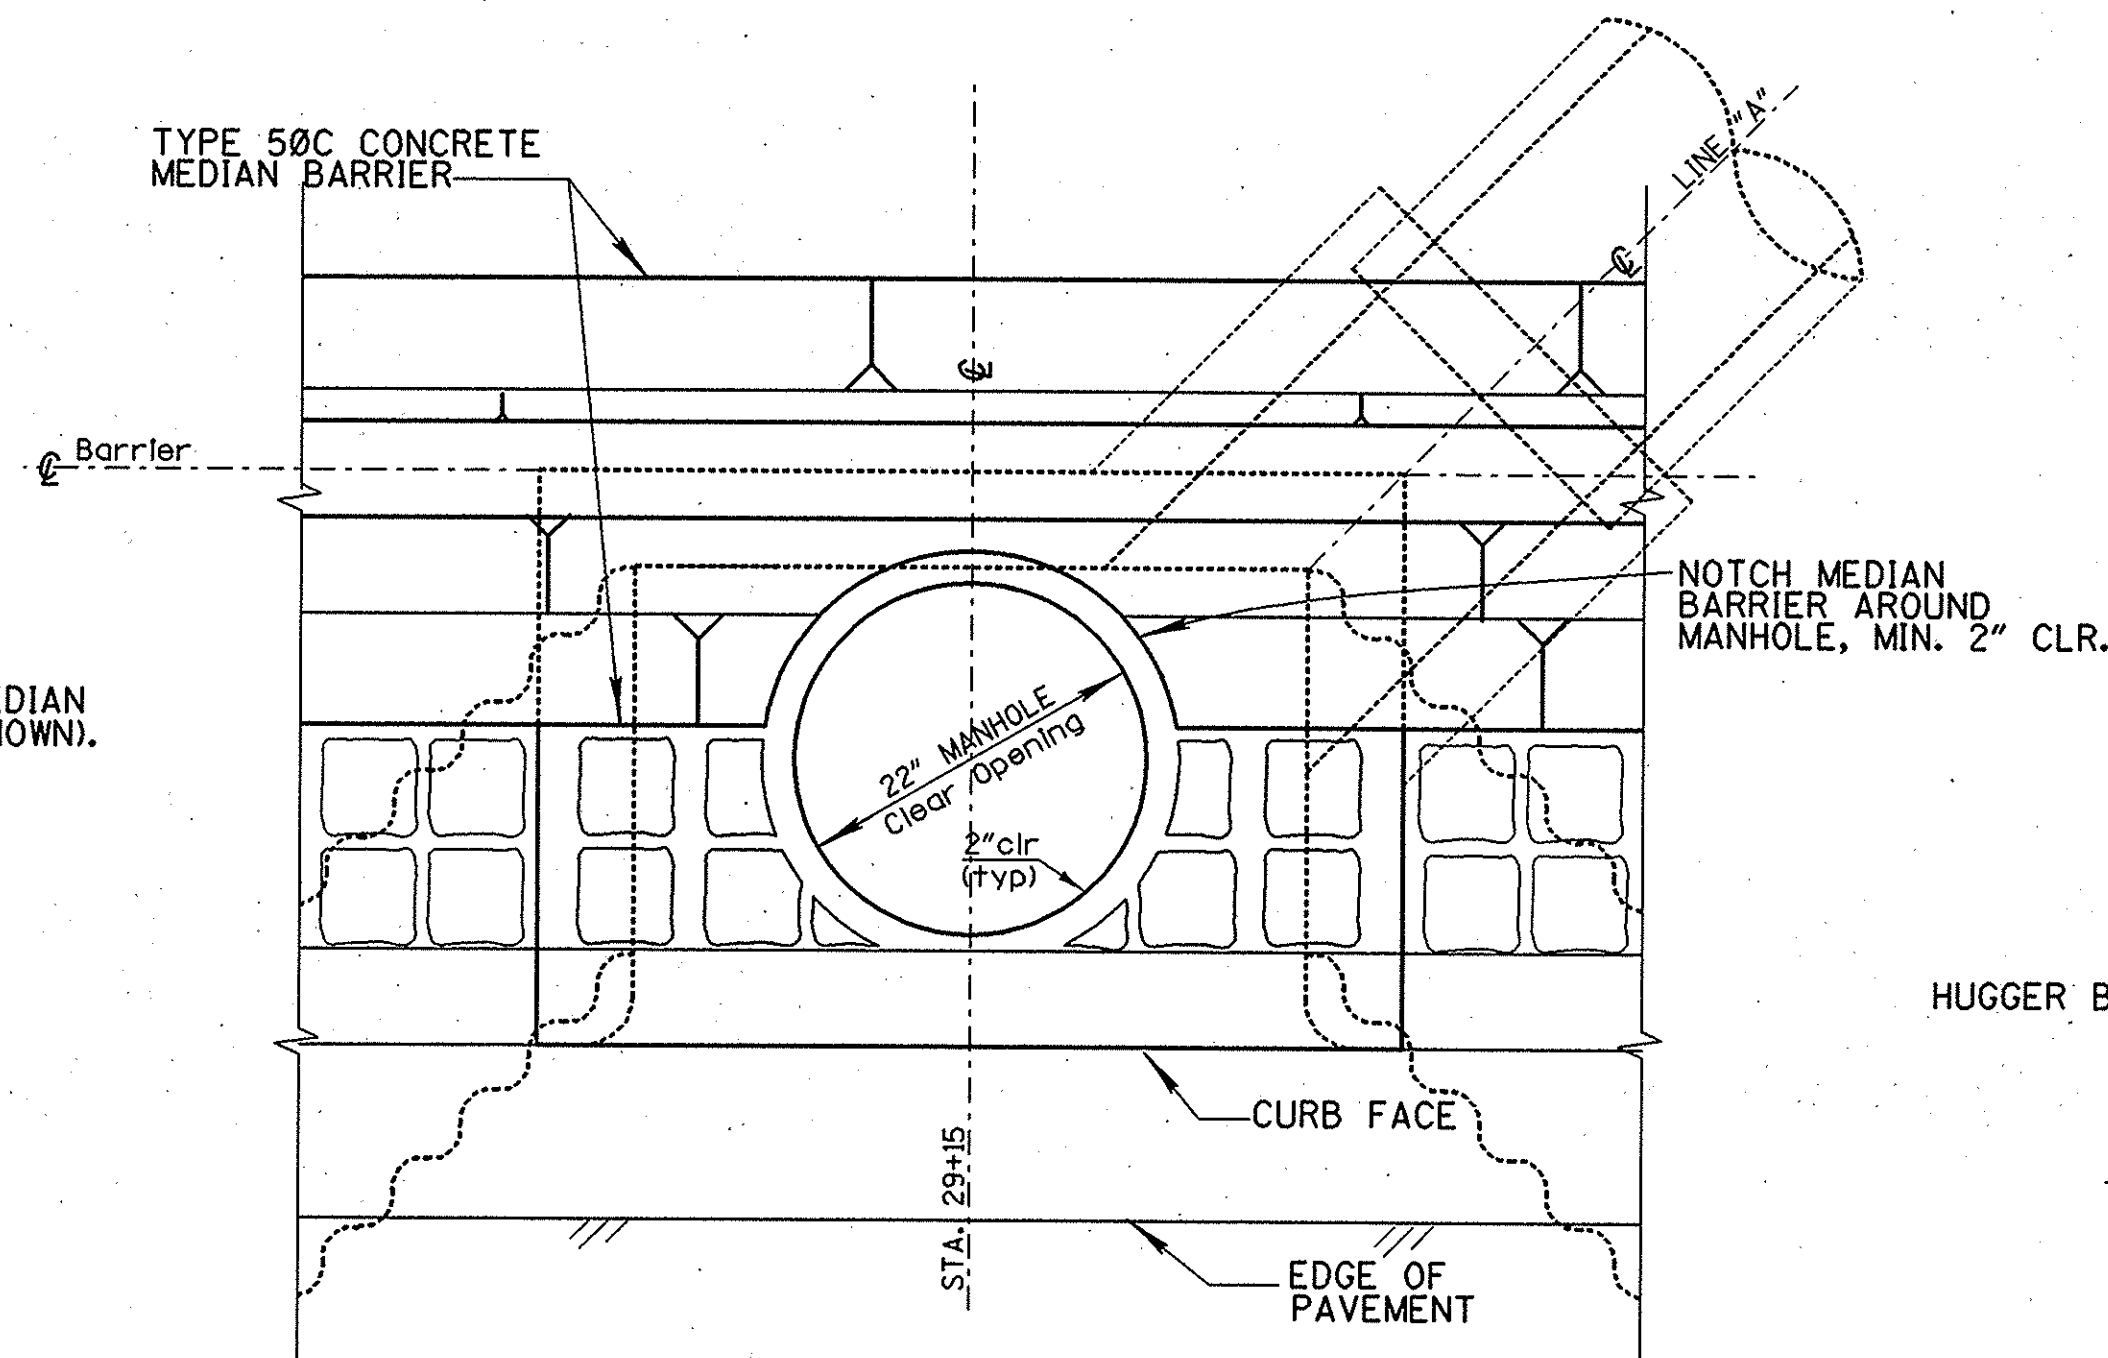

PLAN SURFACE
SCALE: 1" = 1'


- NOTE:**
- TOP SLAB REINFORCING SYMMETRICAL ABOUT CENTERLINE
 - ALL MODIFIED INLET REINFORCING PER EMA STD. PLAN NO. 1301 UNLESS OTHERWISE NOTED.
 - MEDIAN BARRIER NOT SHOWN
 - SLOT DRAIN PER THIS SHEET AND DETAILS SHEET 14.

CAUTION: A 10" HIGH PRESSURE GAS LINE RUNS PARALLEL AND BENEATH HARBOR BLVD. CONTRACTOR TO USE EXTREME CARE WHEN WORKING IN VICINITY OF THIS UTILITY.

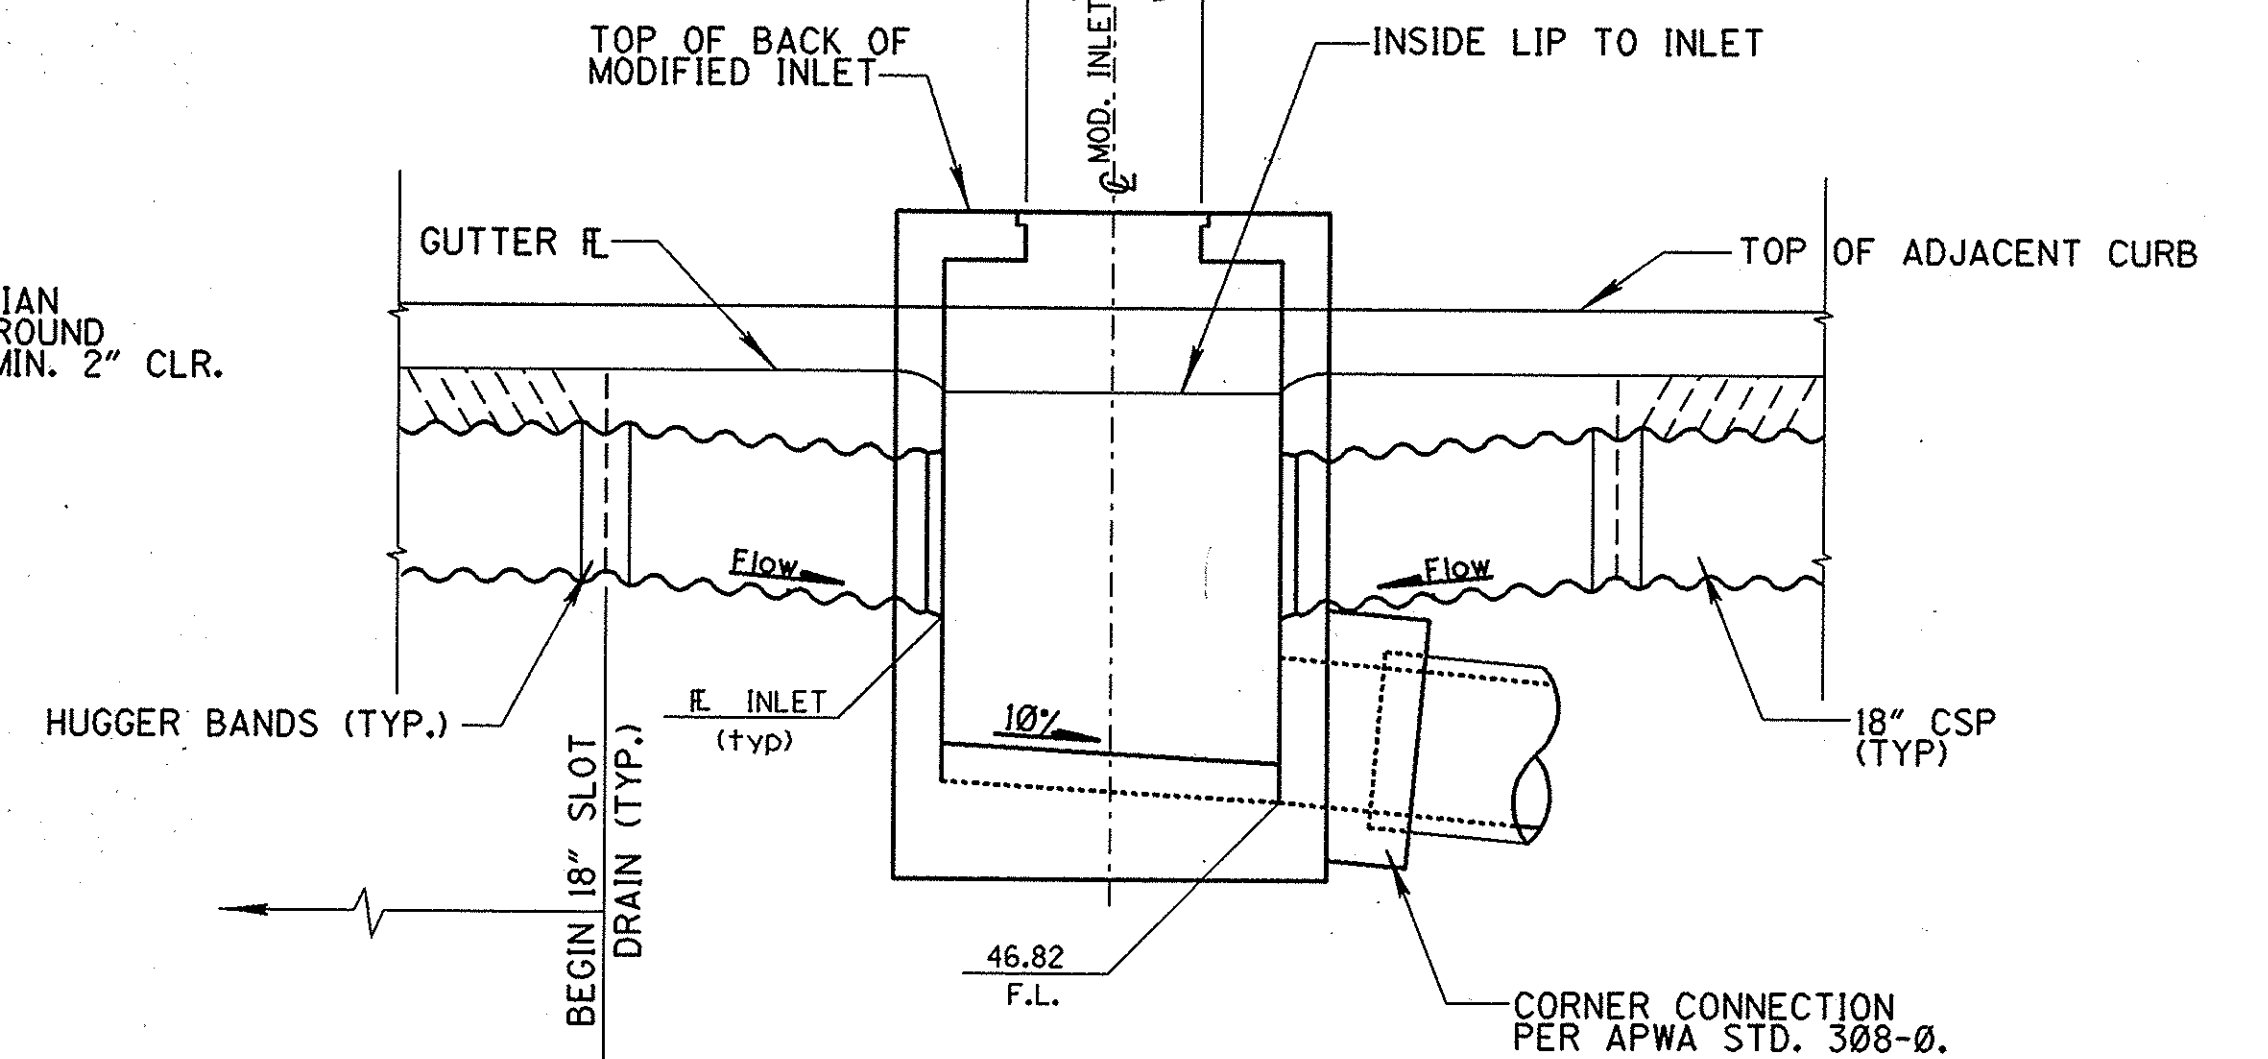

SECTION D - D
Scale: 1" = 2'

- NOTE:**
- NO REINFORCEMENT SHOWN
 - ADJACENT PATTERN-STAMPED MEDIAN AND CONCRETE MEDIAN BARRIER NOT SHOWN.

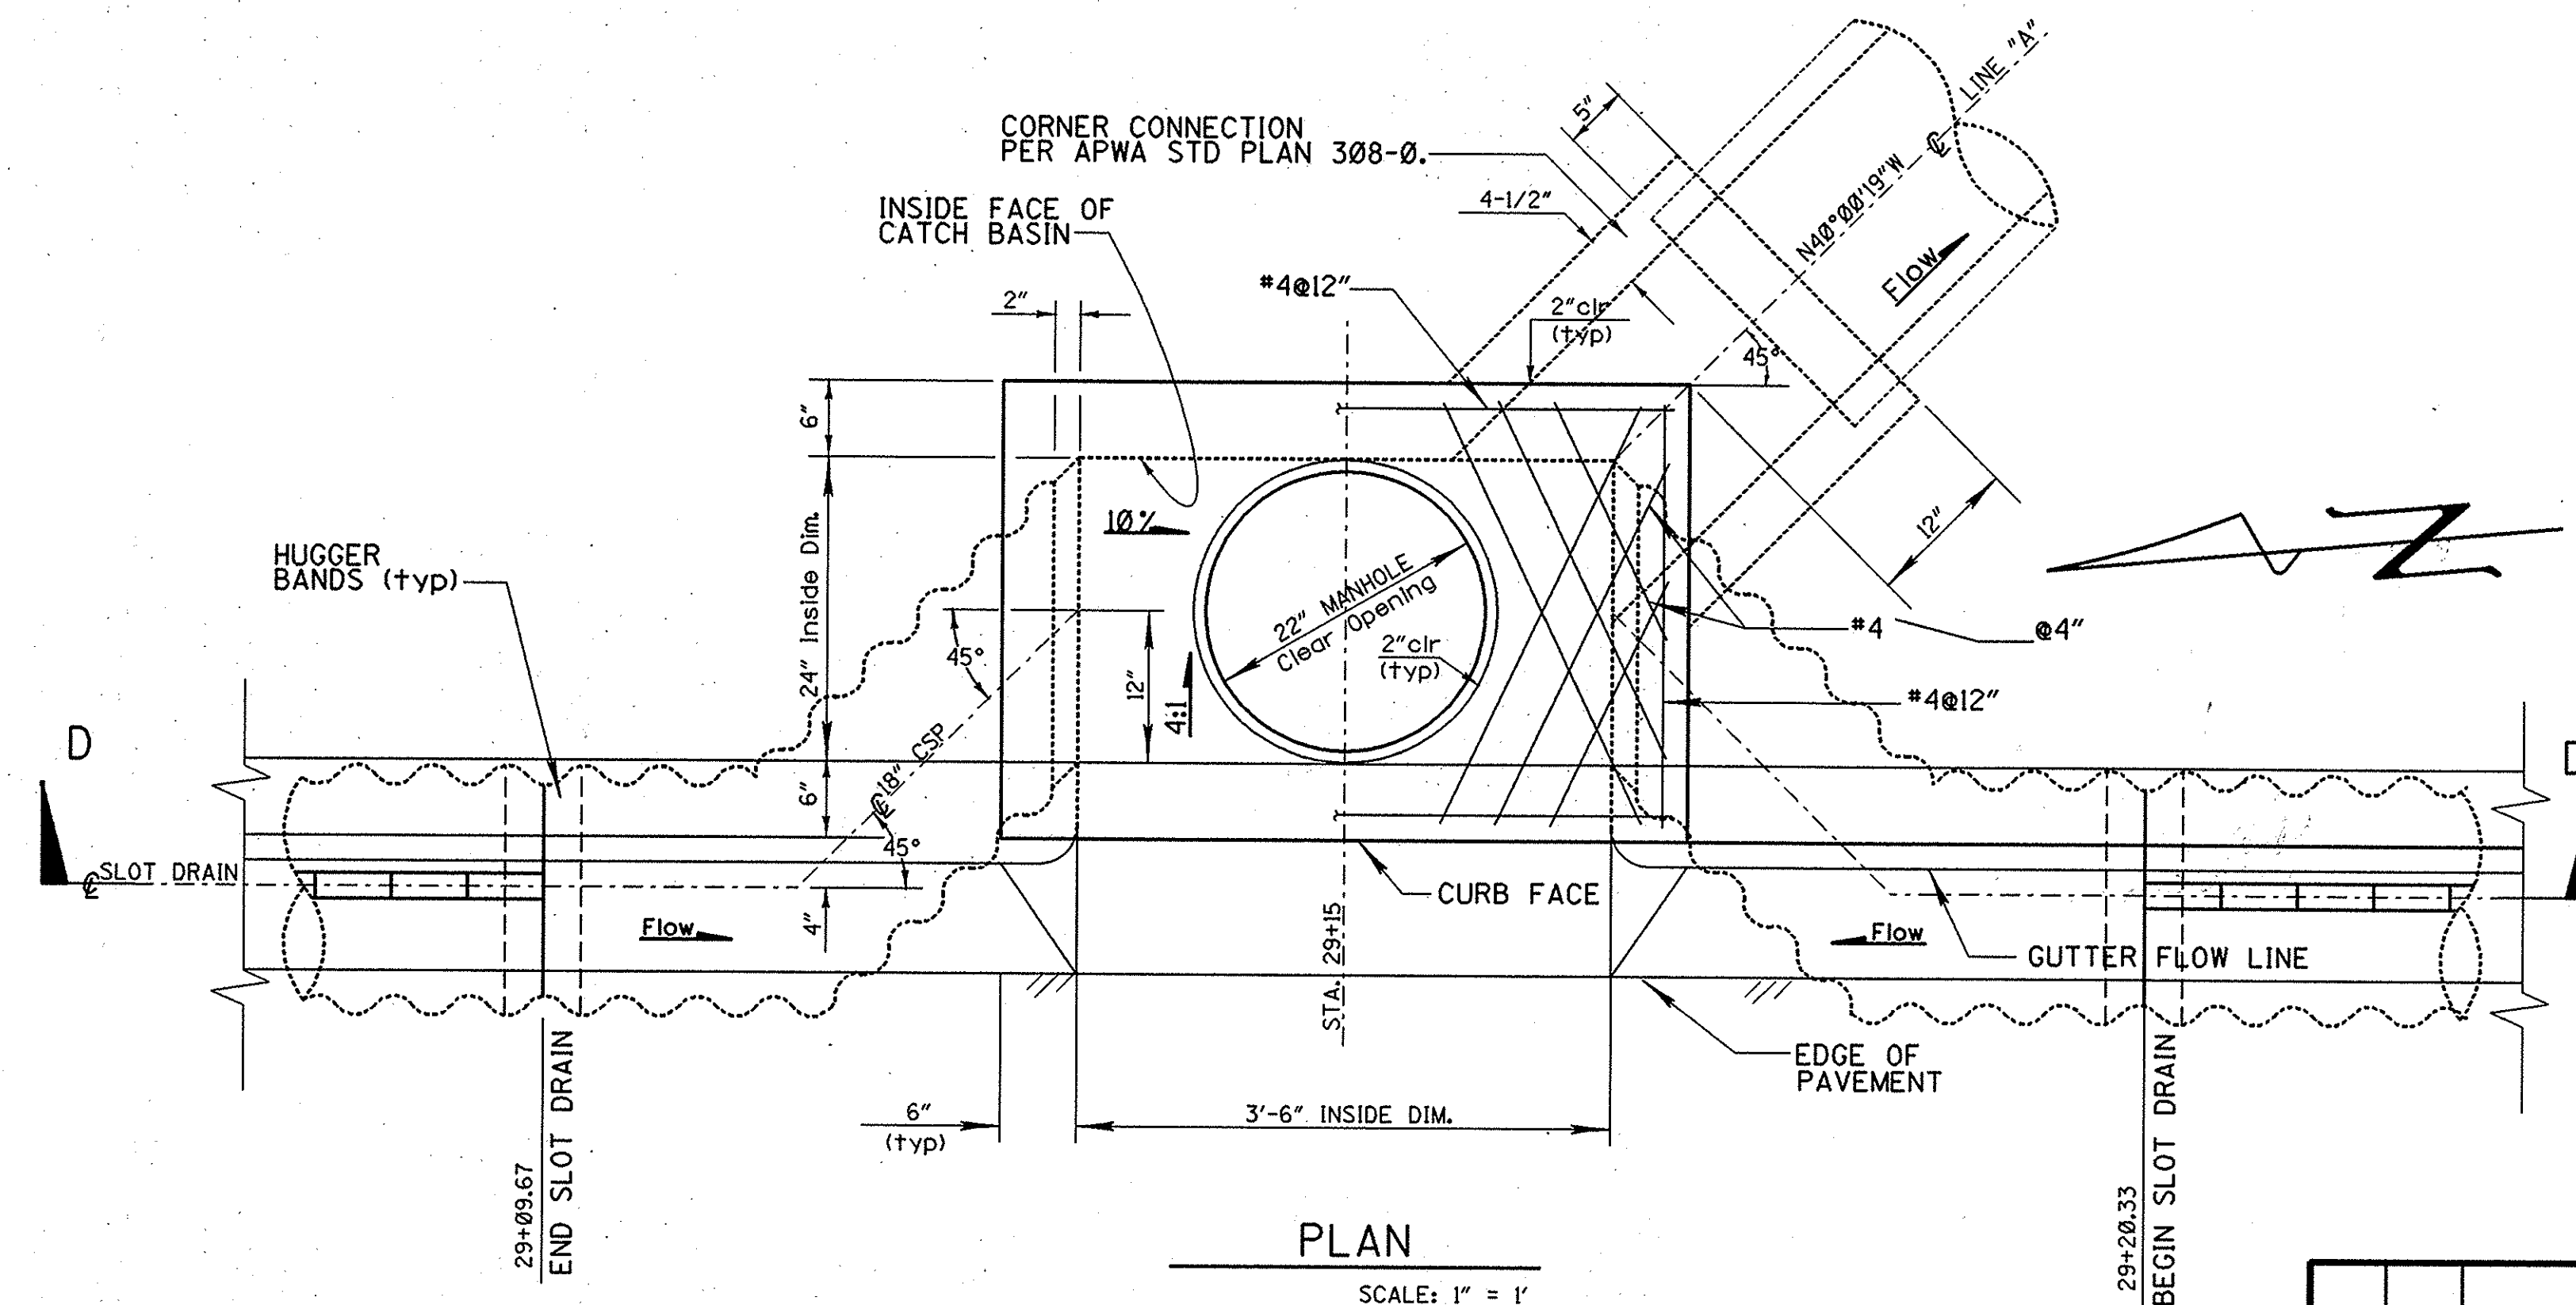

PLAN
SCALE: 1" = 1'

RECORD DRAWING

1 1/2 0 1 2
3 inches on original drawing

ORANGE COUNTY ENVIRONMENTAL MANAGEMENT AGENCY HARBOR BLVD. IMPROVEMENTS LOCAL DRAINAGE DETAILS MODIFIED TYPE I INLET STA. 29+15		SHEET 15A OF 60
DESIGNED: TCR DRAWN: SG SCALE: AS SHOWN DATE: APR '93		CHECKED: RAH DRAWING NO.: DATE:
PREPARED UNDER: 4-93 Substitute sheet 15A for sheet 15. REVISIONS: No. 148526 Exp. 6-30-96 CIVIL 5-19-93		DATE:
TED RIGONI RCE 48526 (exp. 06-30-96)		DATE: