

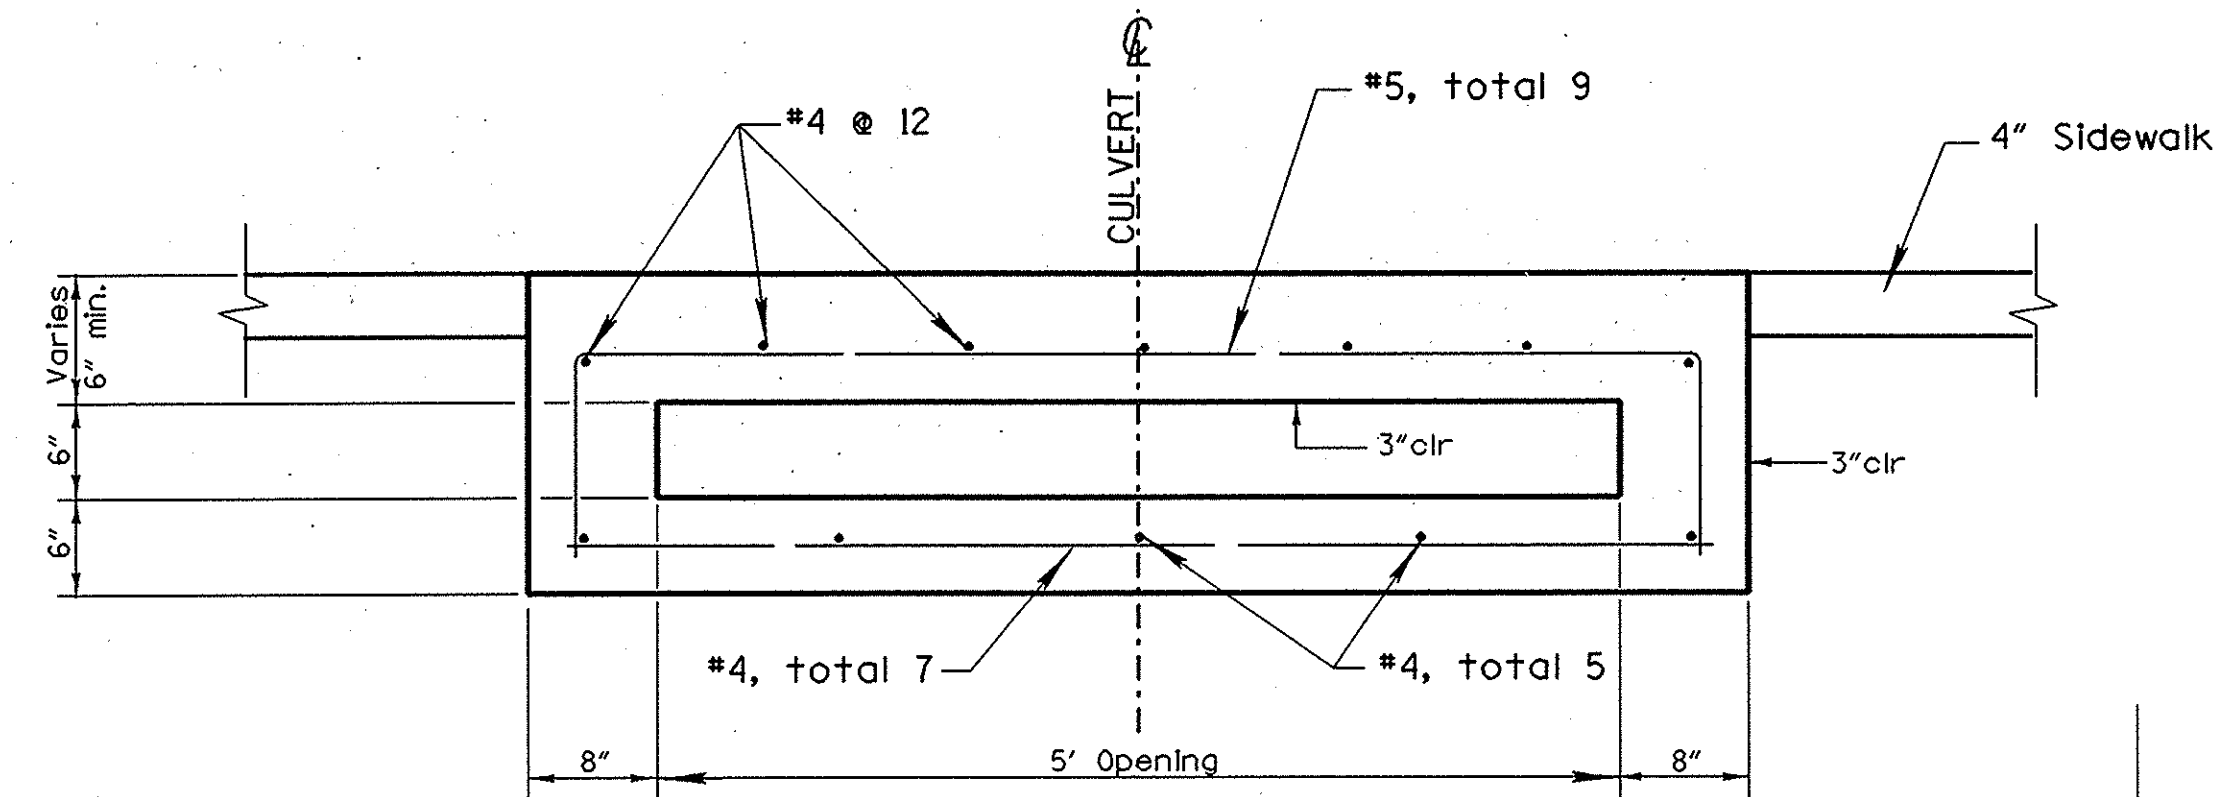
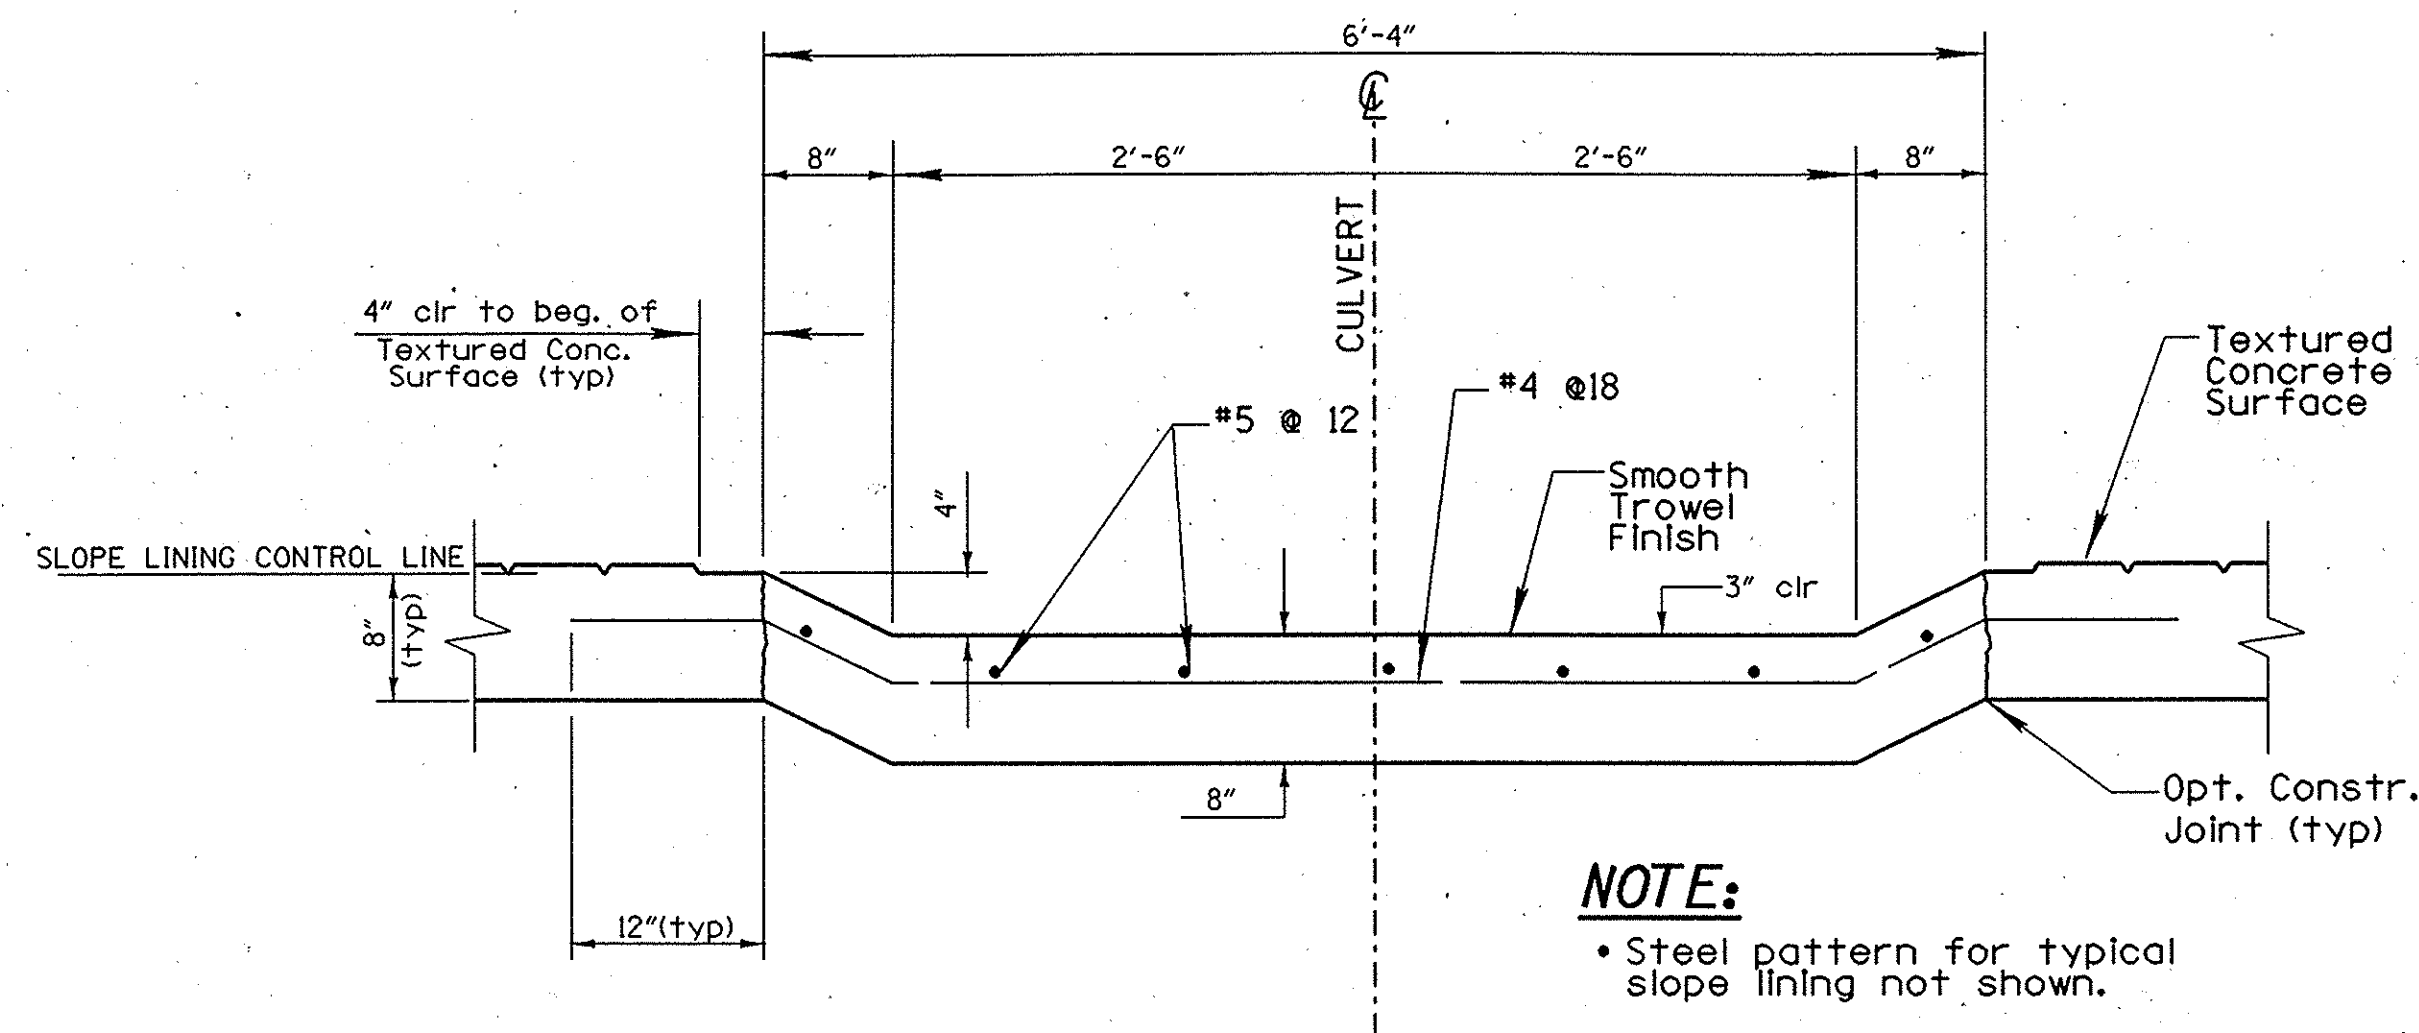


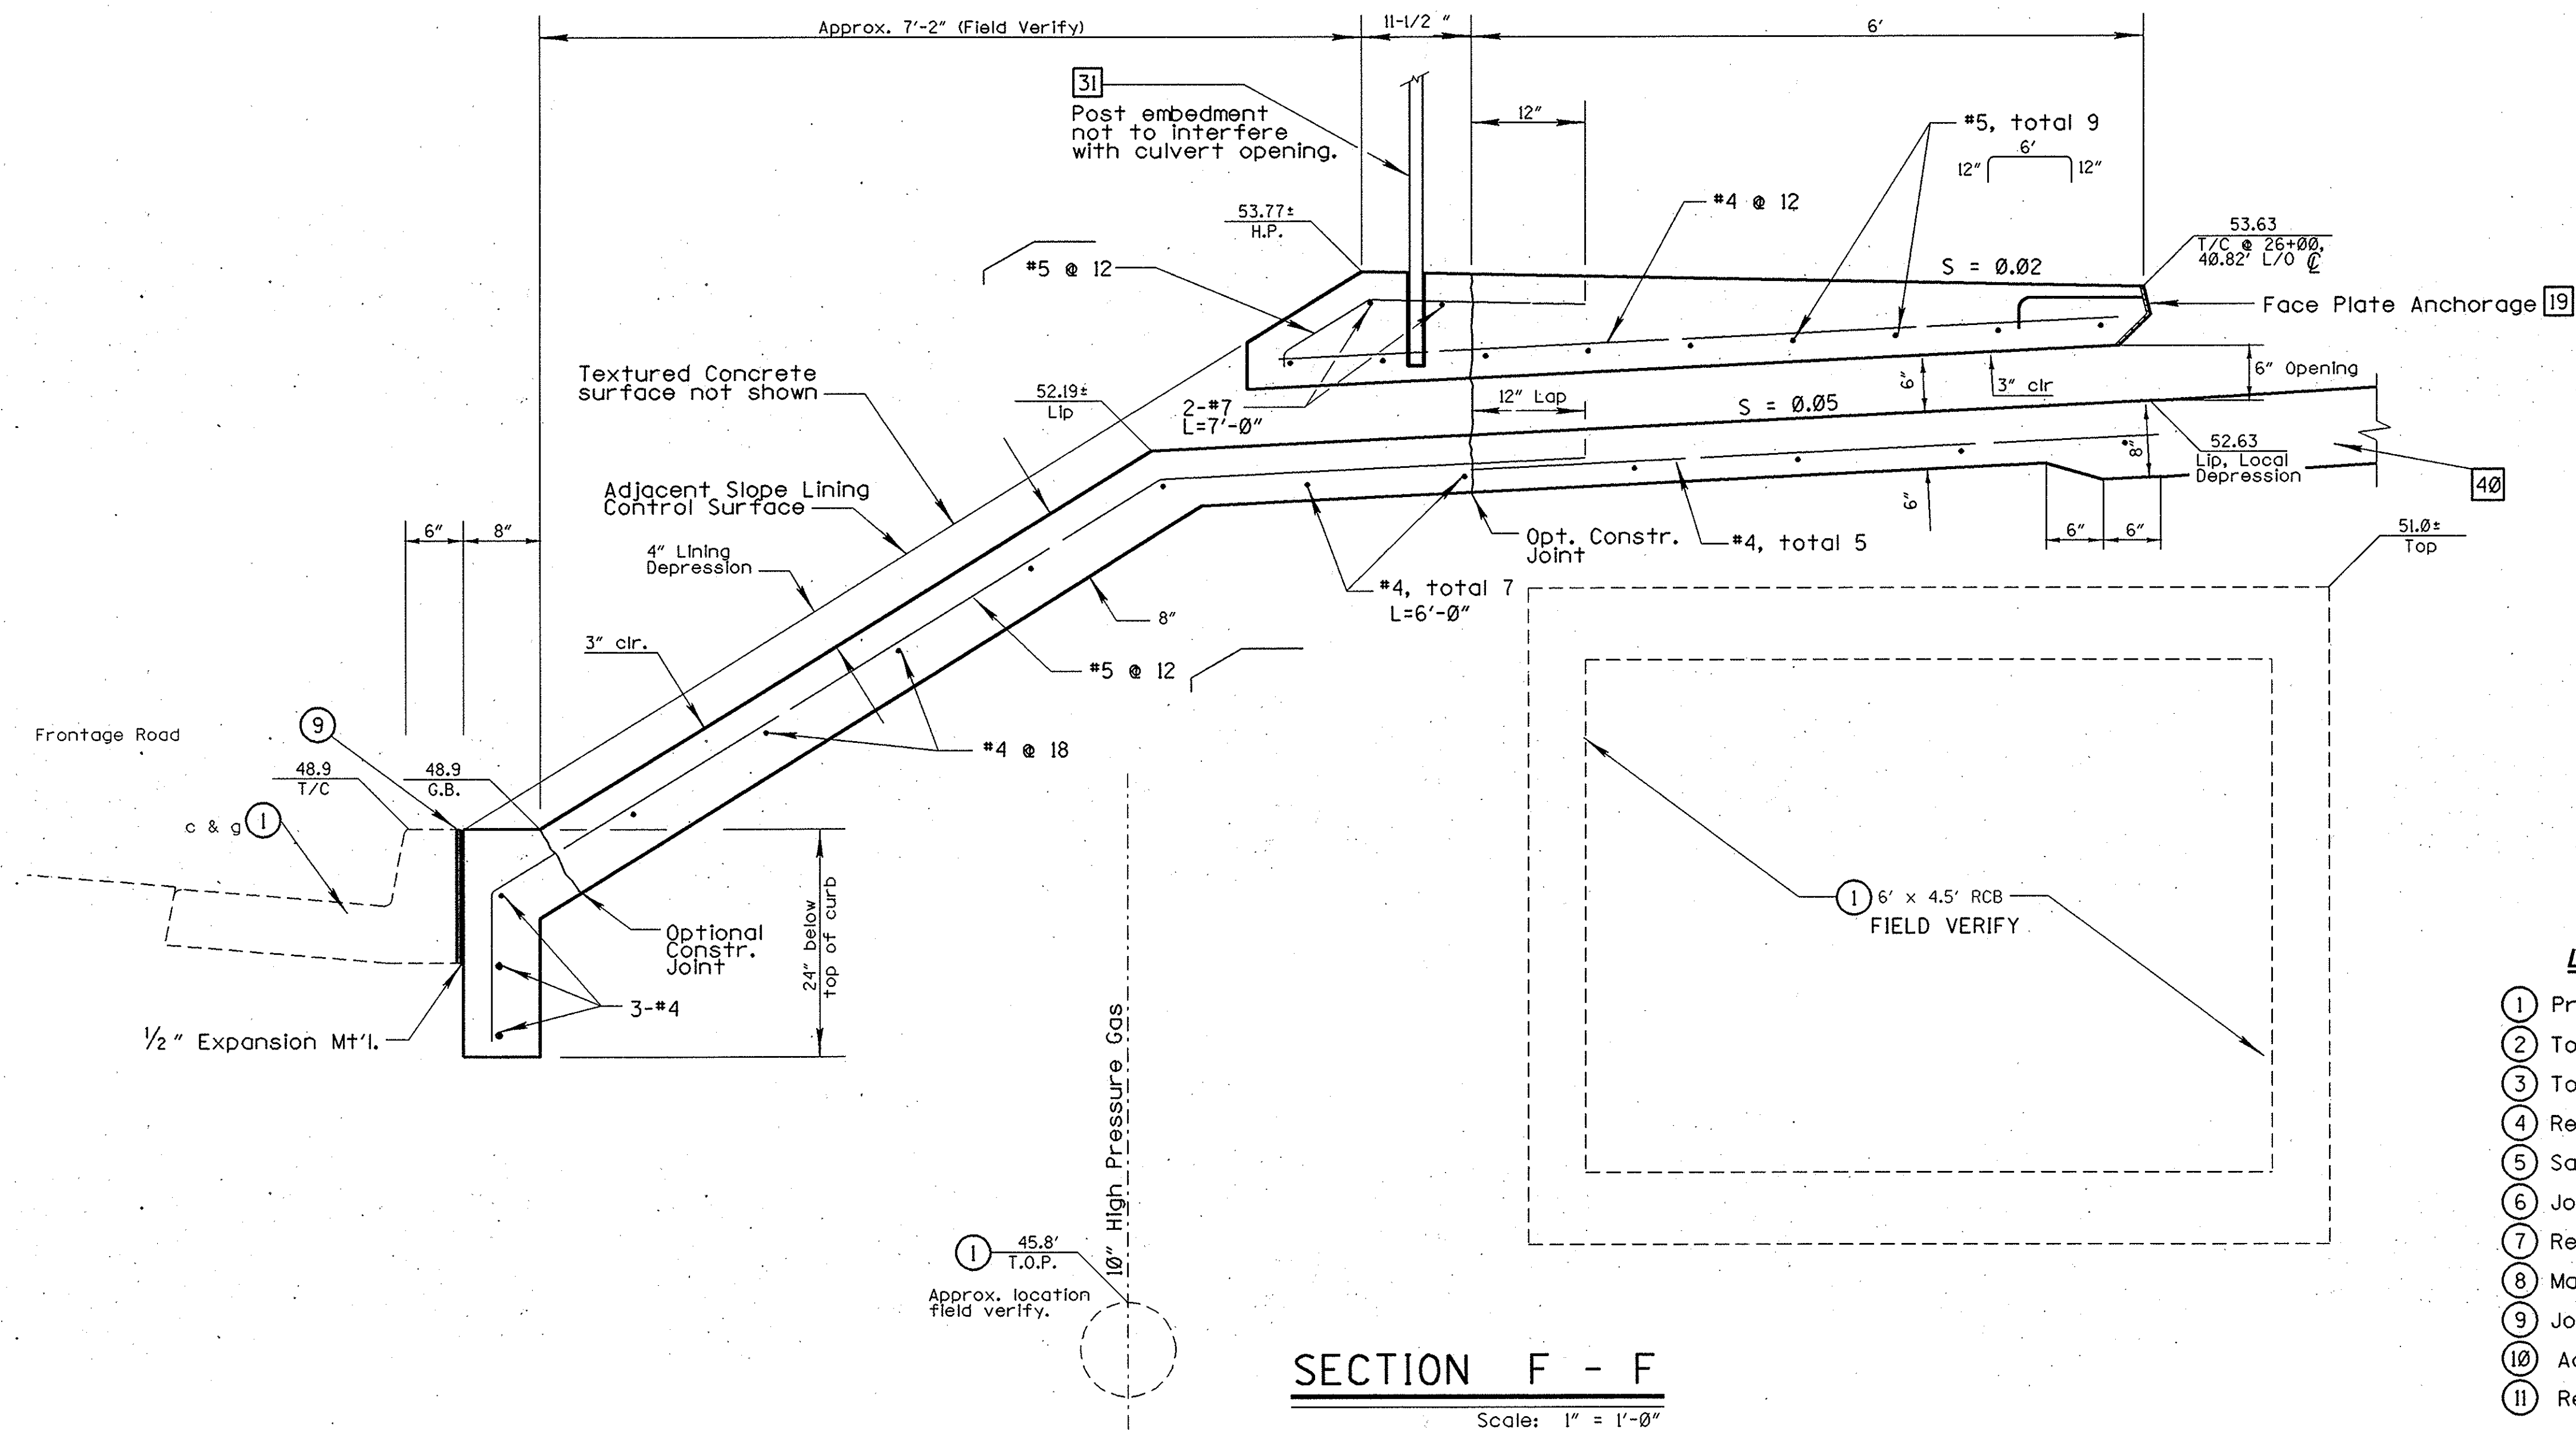

CONSTRUCTION NOTES

- 19 Construct Curb Inlet per Ema Std. Plan No. 1306, type "Detail A".
- 31 Construct metal hand railing, Type B, per APWA Std. Plan No. 606-0-0C, post spacing 8' C.C. max.
- 40 Construct Local Depression per EMA Std. Plan No. 1308.

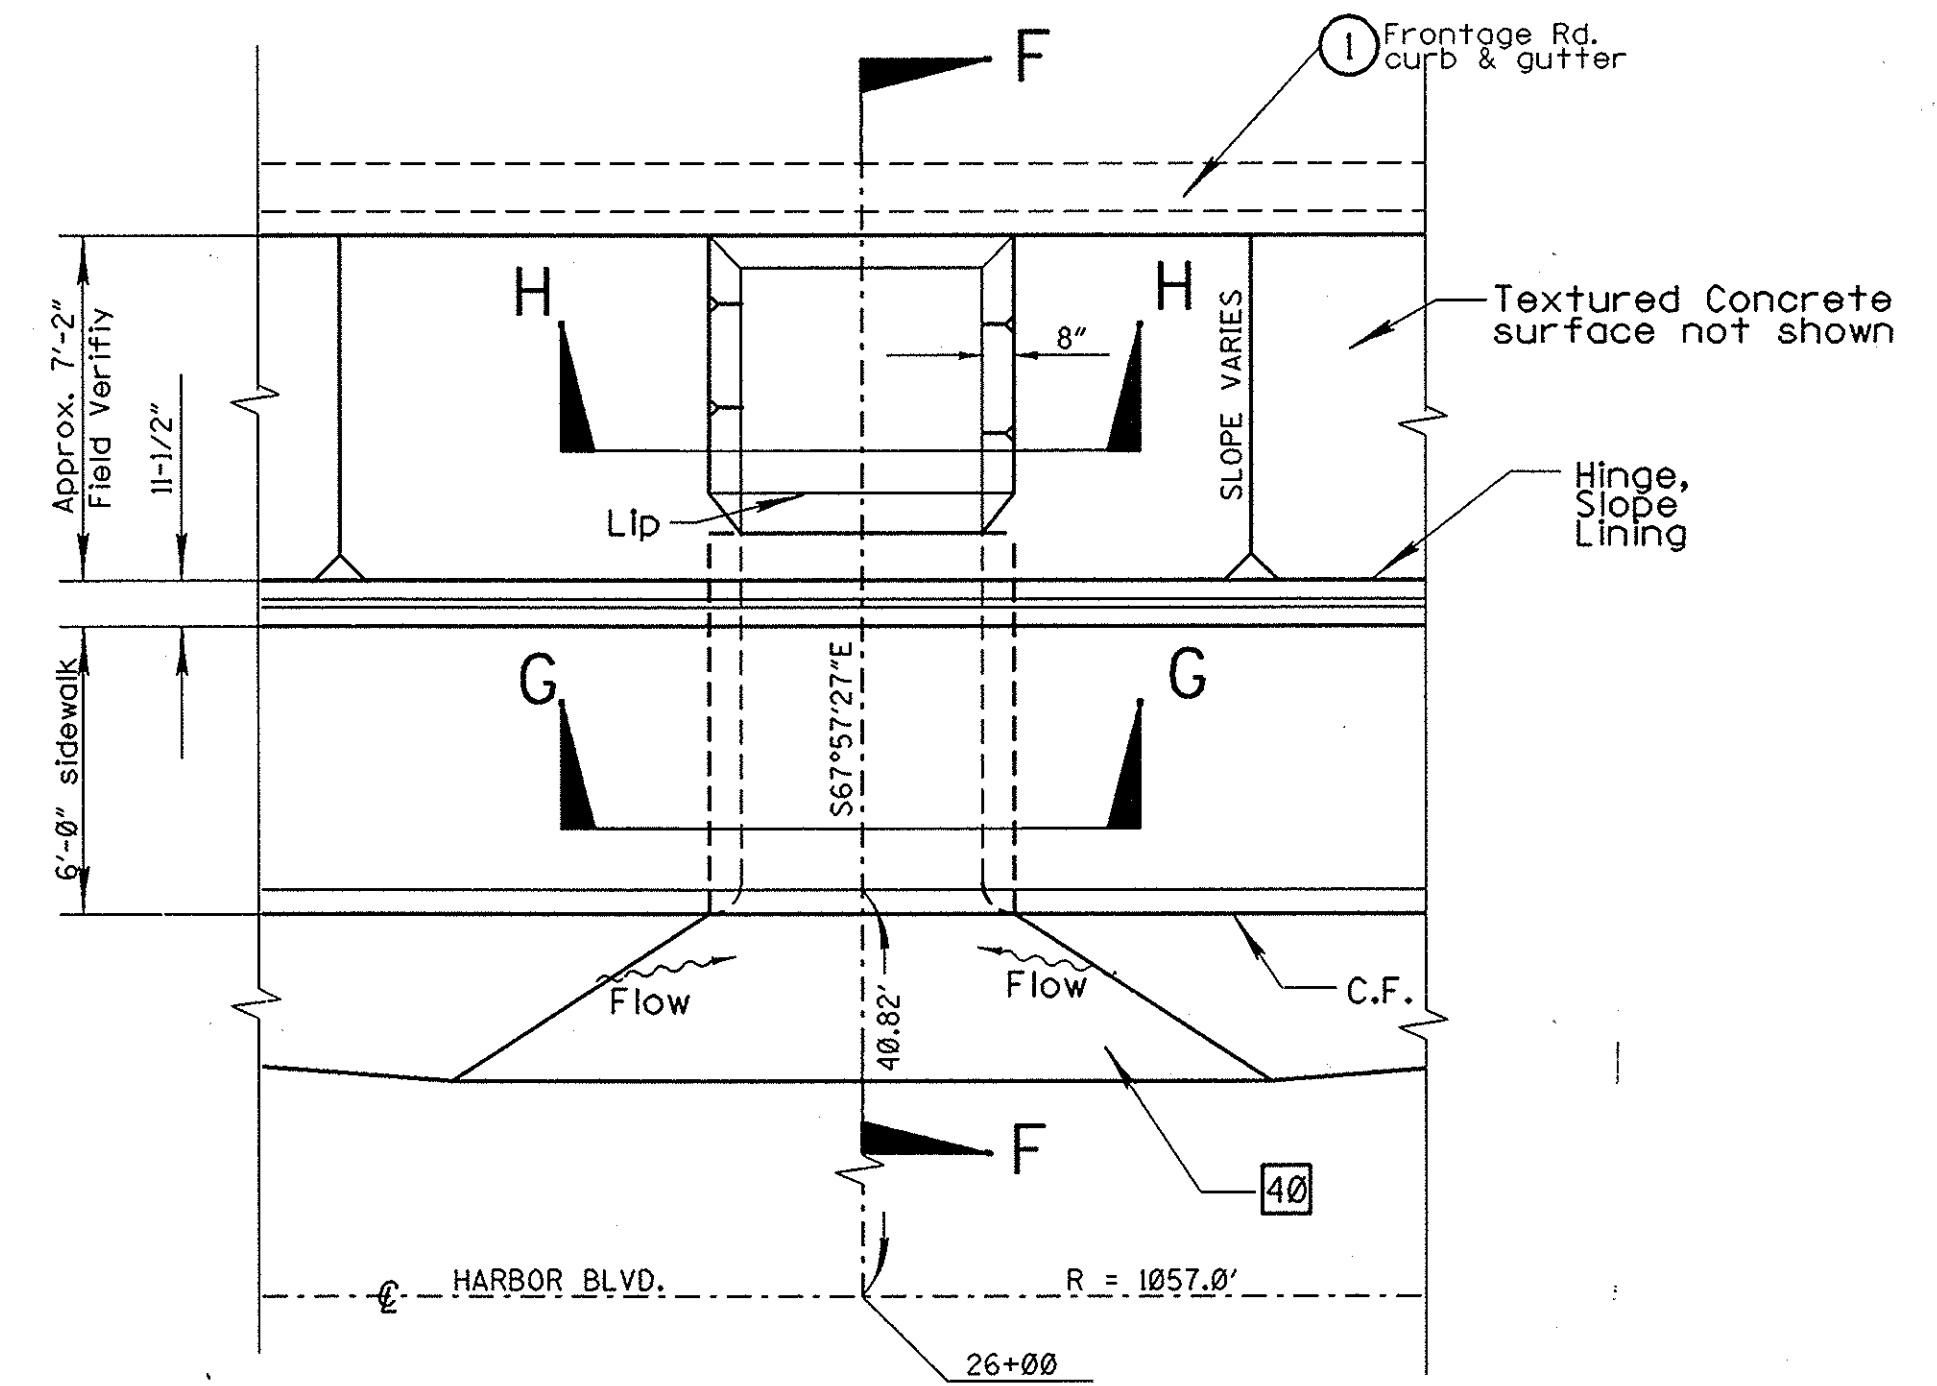

LEGEND

- 1 Protect in place
- 2 To be removed
- 3 To be relocated by others
- 4 Remove and salvage
- 5 Sawcut
- 6 Join existing and feather to satisfaction of Engineer.
- 7 Remove interfering portions.
- 8 Match exist. edge of pavement.
- 9 Join existing
- 10 Adjust to grade
- 11 Relocate

RECORD DRAWING

CAUTION: A 10" HIGH PRESSURE GAS LINE RUNS PARALLEL AND BENEATH HARBOR BLVD. CONTRACTOR TO USE EXTREME CARE WHEN WORKING IN VICINITY OF THIS UTILITY.

1 1/2 0 1 2
3 inches on original drawing

ORANGE COUNTY ENVIRONMENTAL MANAGEMENT AGENCY	
HARBOR BLVD. IMPROVEMENTS	
LOCAL DRAINAGE	
Sidewalk Culvert @ 26+00	
DESIGNED TCR	CHECKED RAH
DRAWN SG	DATE
SCALE AS SHOWN	DATE MAR '93
DATE 3/4/93	DRAWING NO. 16
TED RIGONI RCE 48526 (exp. 06-30-96)	DATE