


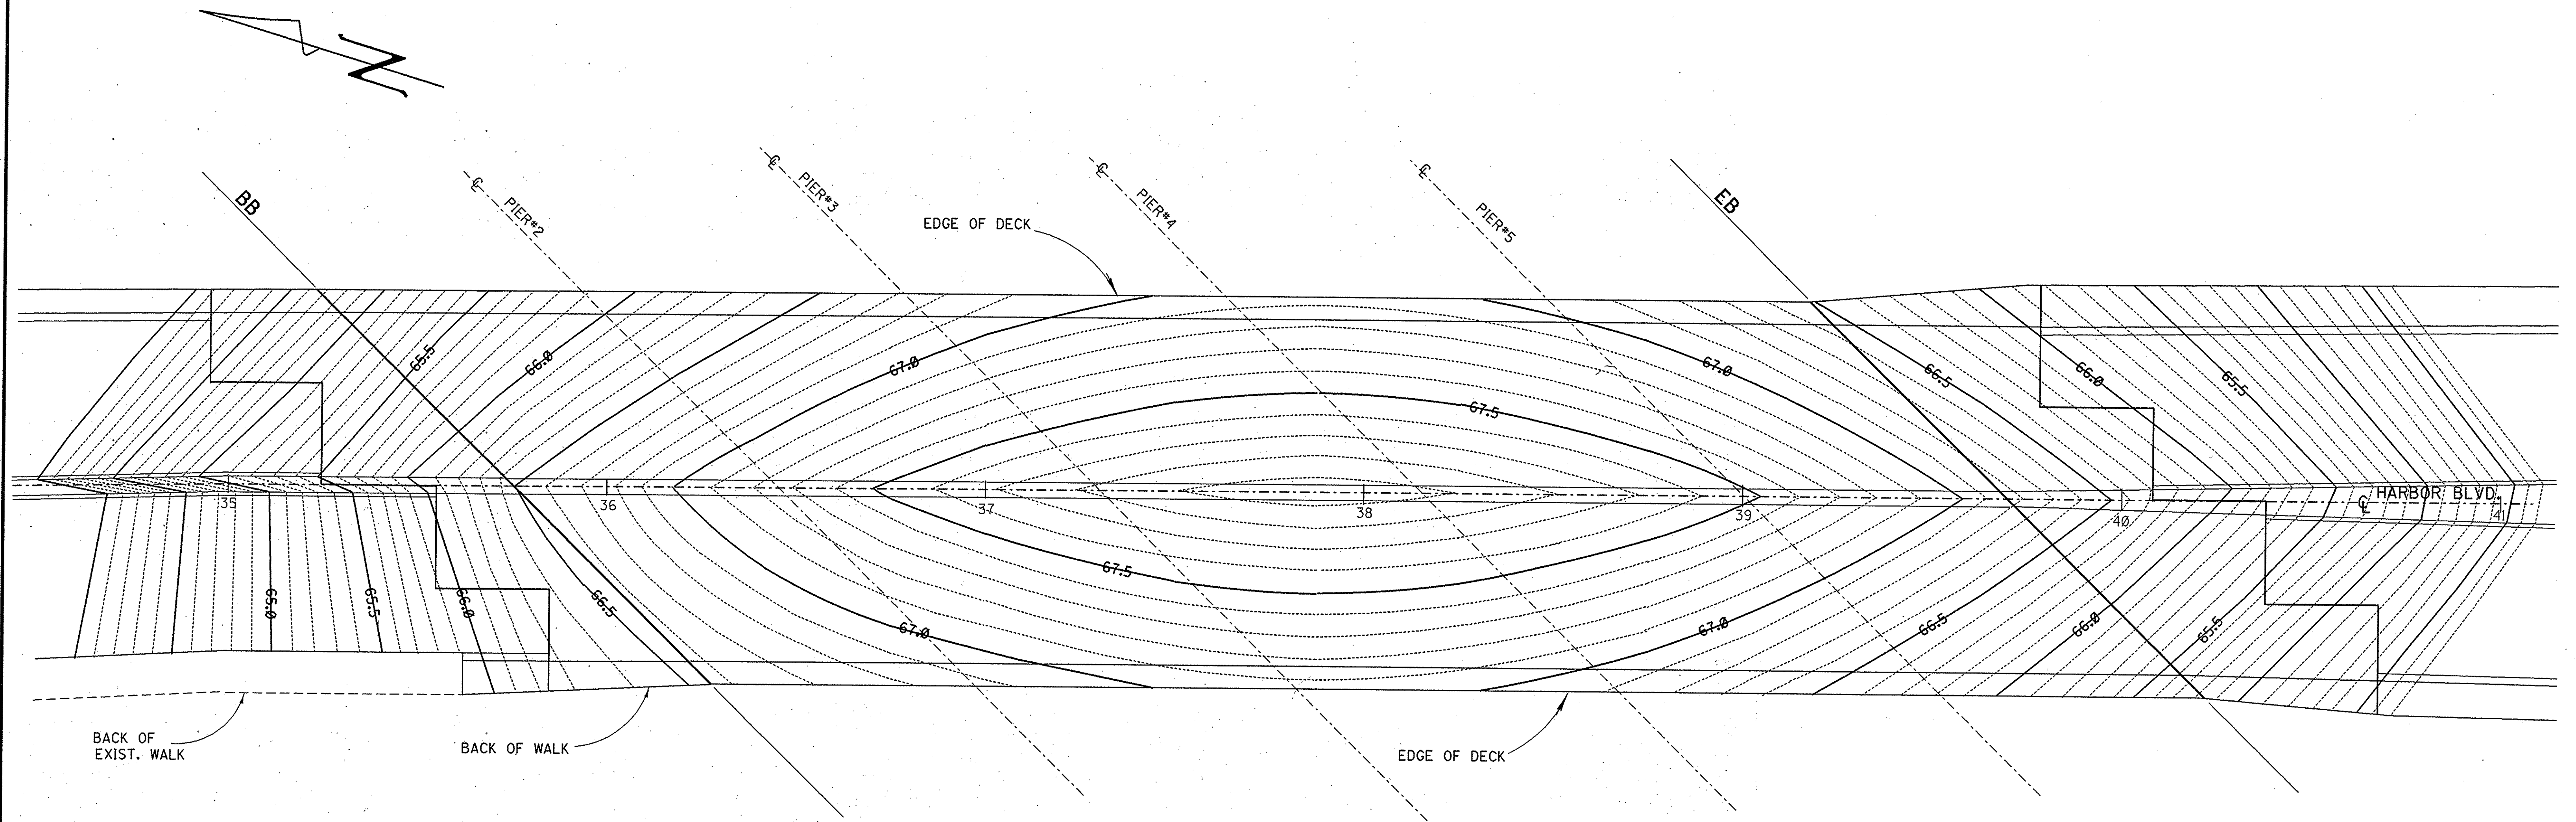


SCALE : 1" = 20'-0"

NOTE : ALL ELEV. REPRESENT
THEORETICAL FINISH SURFACE
OF DECK AFTER LONG TERM
DEFLECTION .

RECORD DRAWING

1 1/2 0 1 2
3 inches on original drawing

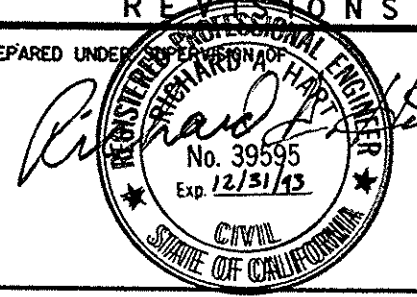ORANGE COUNTY ENVIRONMENTAL MANAGEMENT AGENCY	
HARBOR BLVD. IMPROVEMENTS BRIDGE	
DECK CONTOUR	
DESIGNED - RB	SHEET 18 OF
DRAWN - HP	CHECKED - RAH
SCALE AS SHOWN	DATE DRAWING NO.
PREPARED UNDER  RICHARD A. HART RCE 39595 (exp 12-31-93)	