



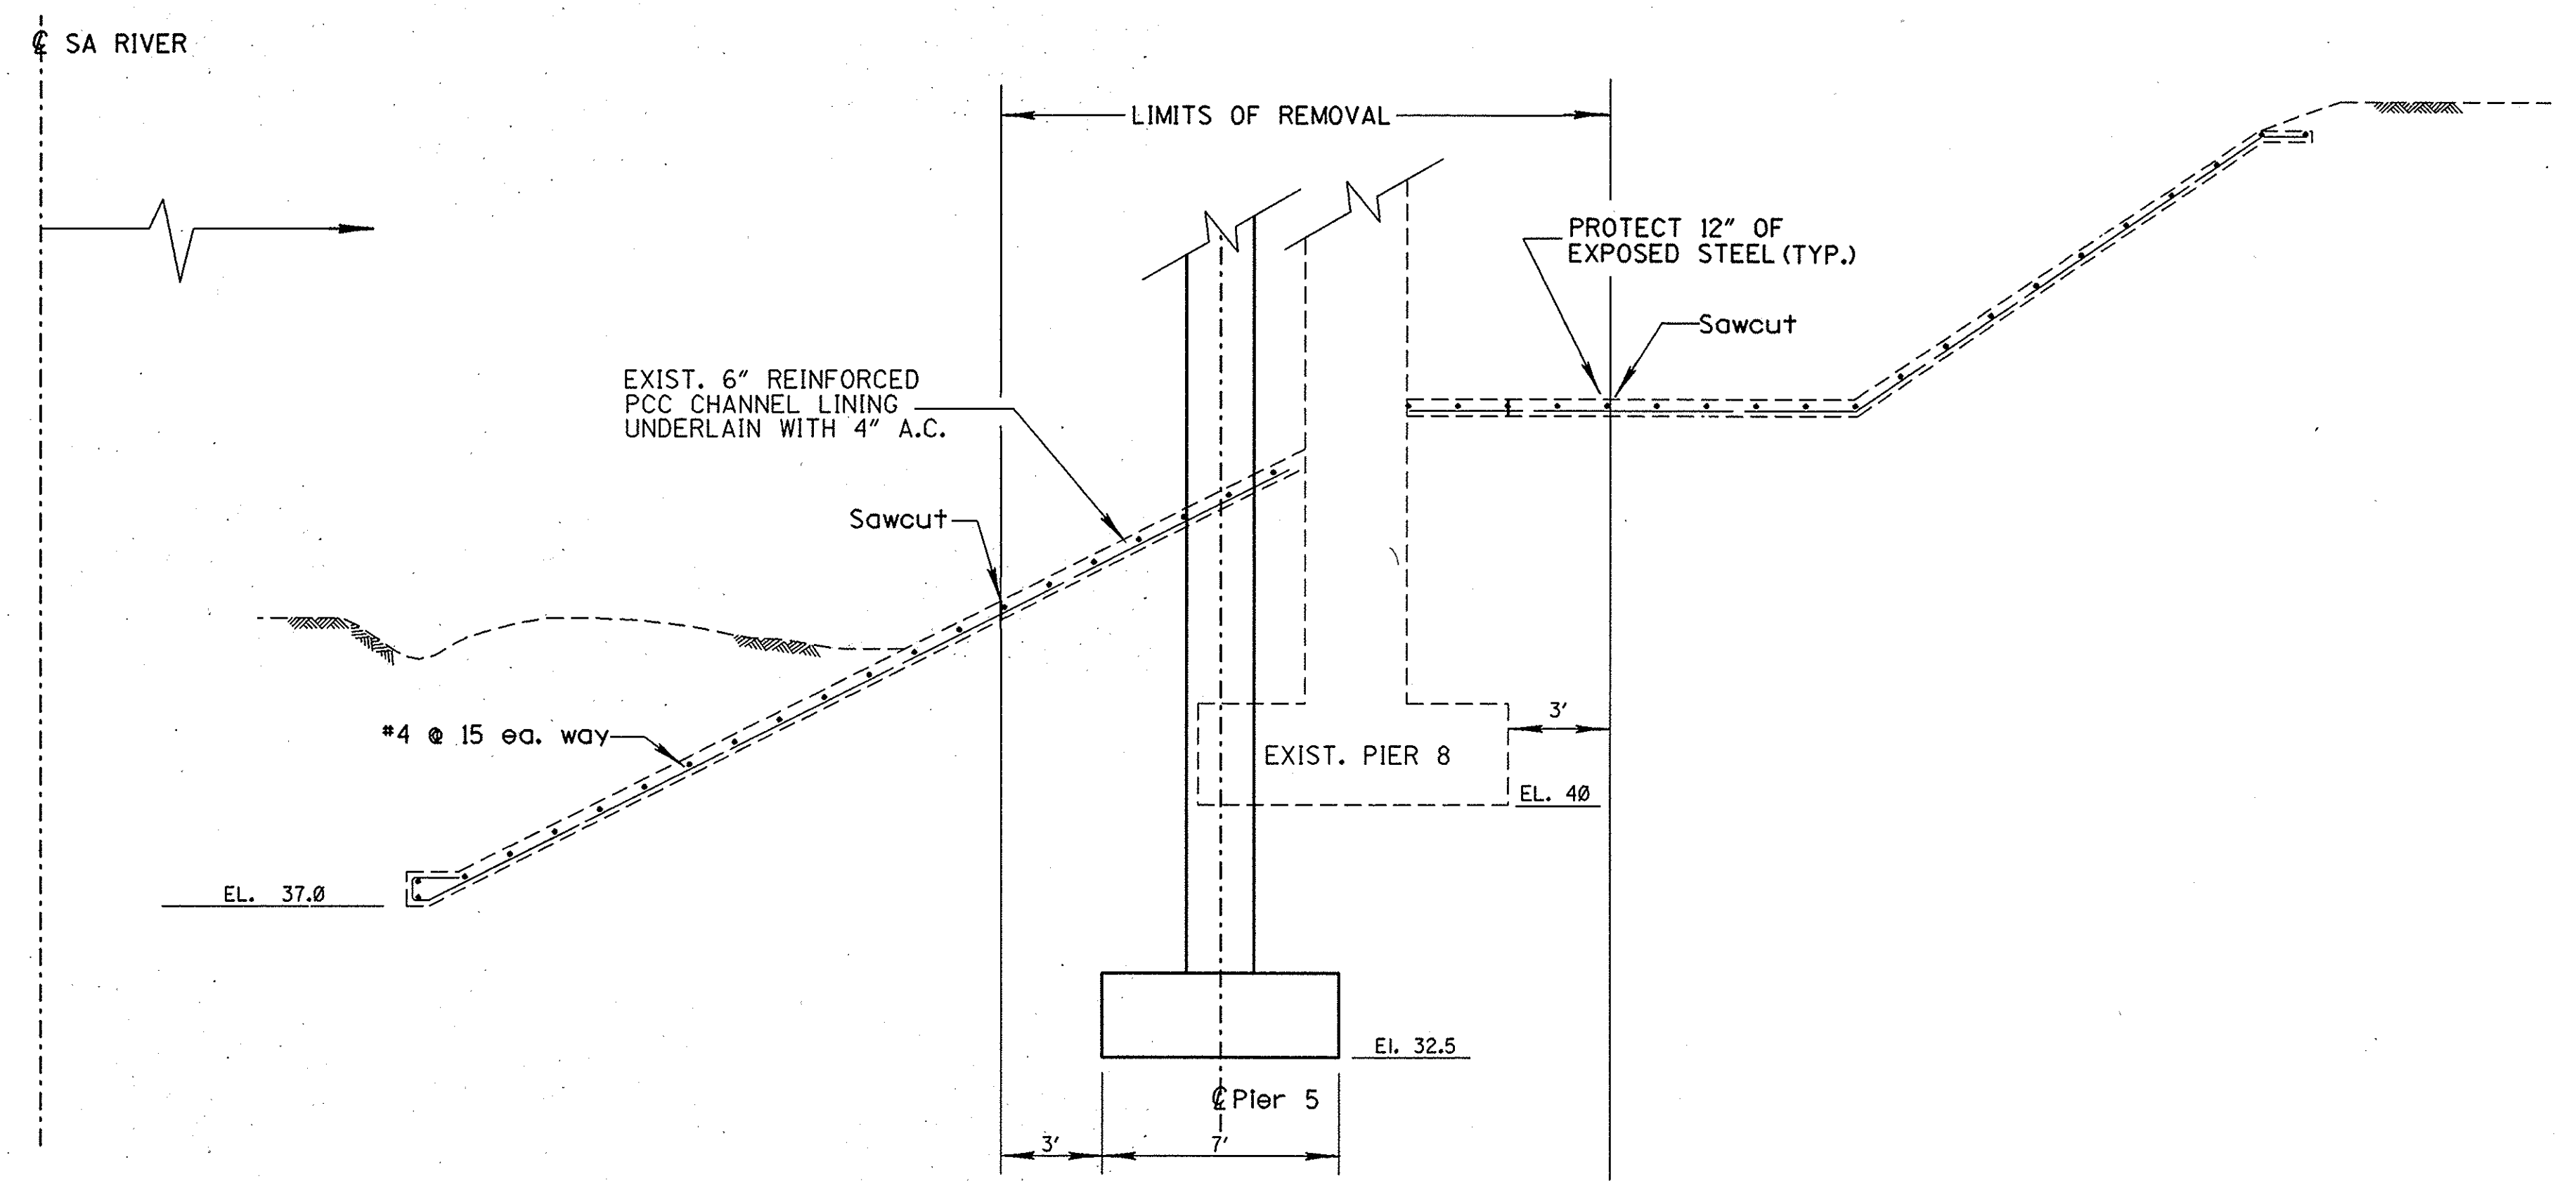

**LIMITS OF CHANNEL LINING REMOVAL**

Scale: 1/4" = 1'

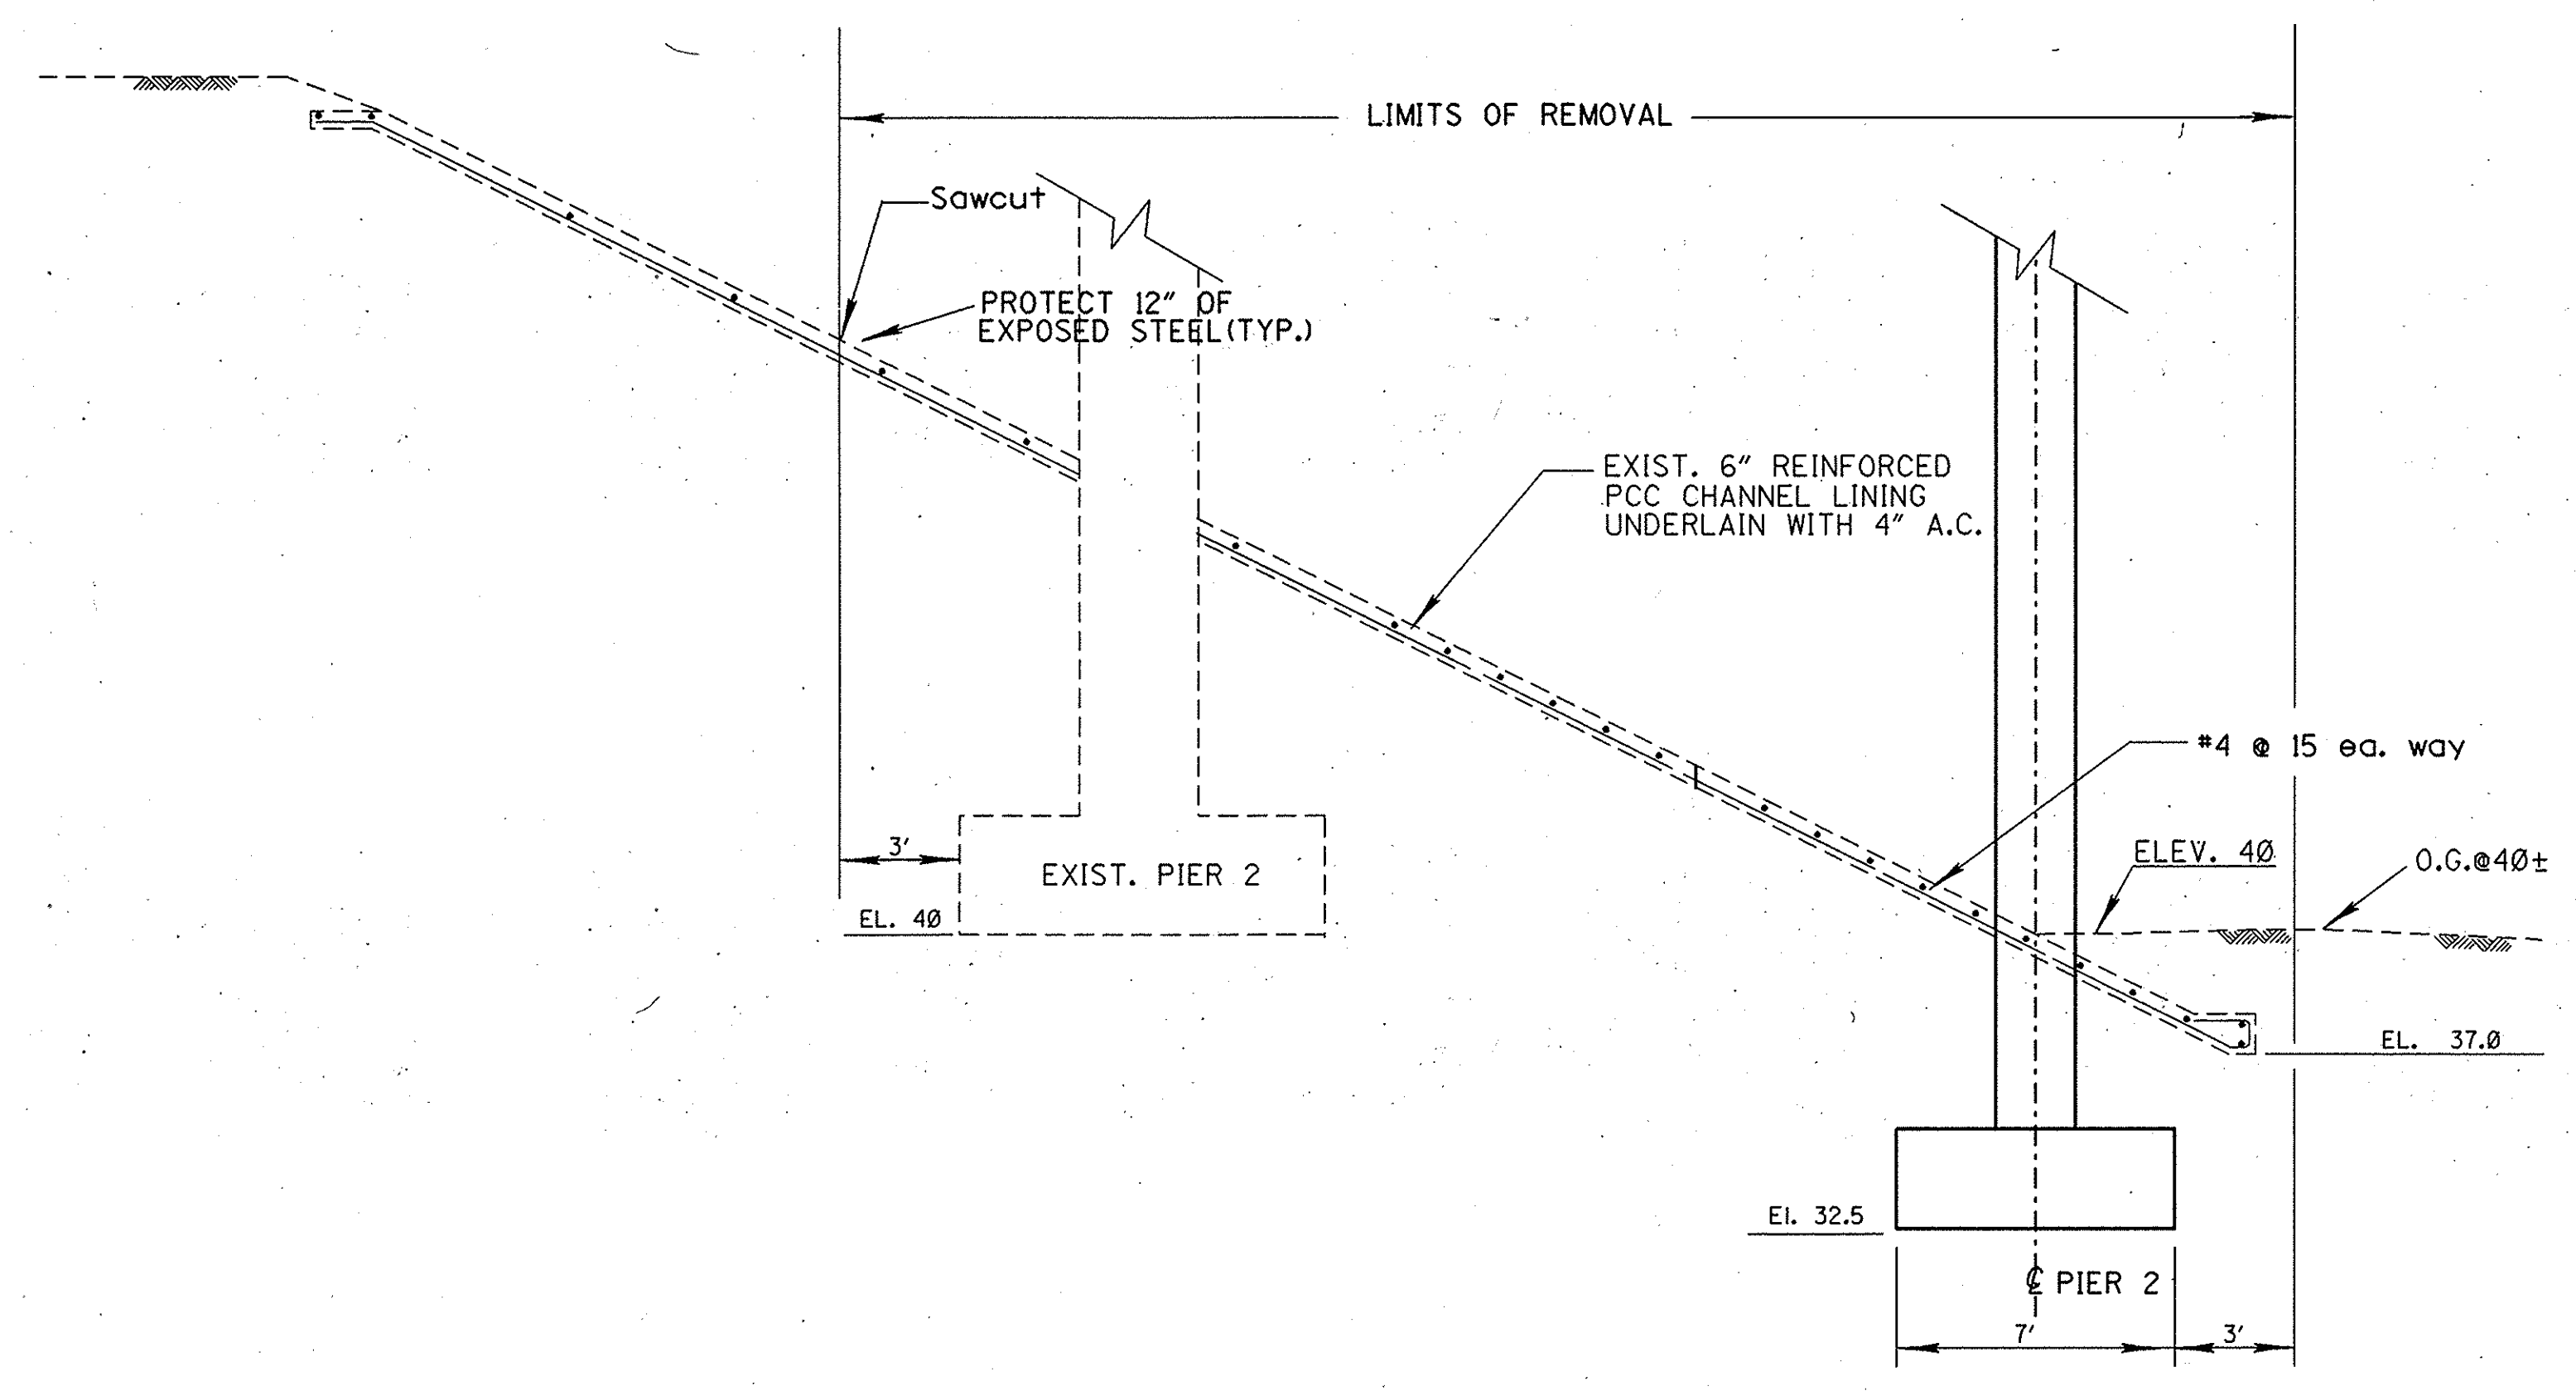

**LIMITS OF CHANNEL LINING REMOVAL**

Scale: 1/4" = 1'

**NOTE:**

- All dimensions subject to approval of the Contractor's Shoring Plan by the Engineer.
- Replace all concrete channel lining with 6" thick PCC with #4's @ 15 each way. Lap splice to existing.
- Limits shown are for bidding purposes only.

**RECORD DRAWING**

1/2" = 0' 2"  
3 inches on original drawing

|                                                  |                 |
|--------------------------------------------------|-----------------|
| ORANGE COUNTY<br>ENVIRONMENTAL MANAGEMENT AGENCY |                 |
| HARBOR BLVD. IMPROVEMENTS<br>BRIDGE              |                 |
| CHANNEL LINING<br>DETAILS                        |                 |
| DESIGNED: RH                                     | CHECKED: RH     |
| DRAWN: SG/HP                                     | DATE: 3/4/93    |
| SCALE: AS SHOWN                                  | DRAWING NO. 19A |
| DATE: 3/93                                       |                 |
| SHEET 19A OF 60                                  |                 |