




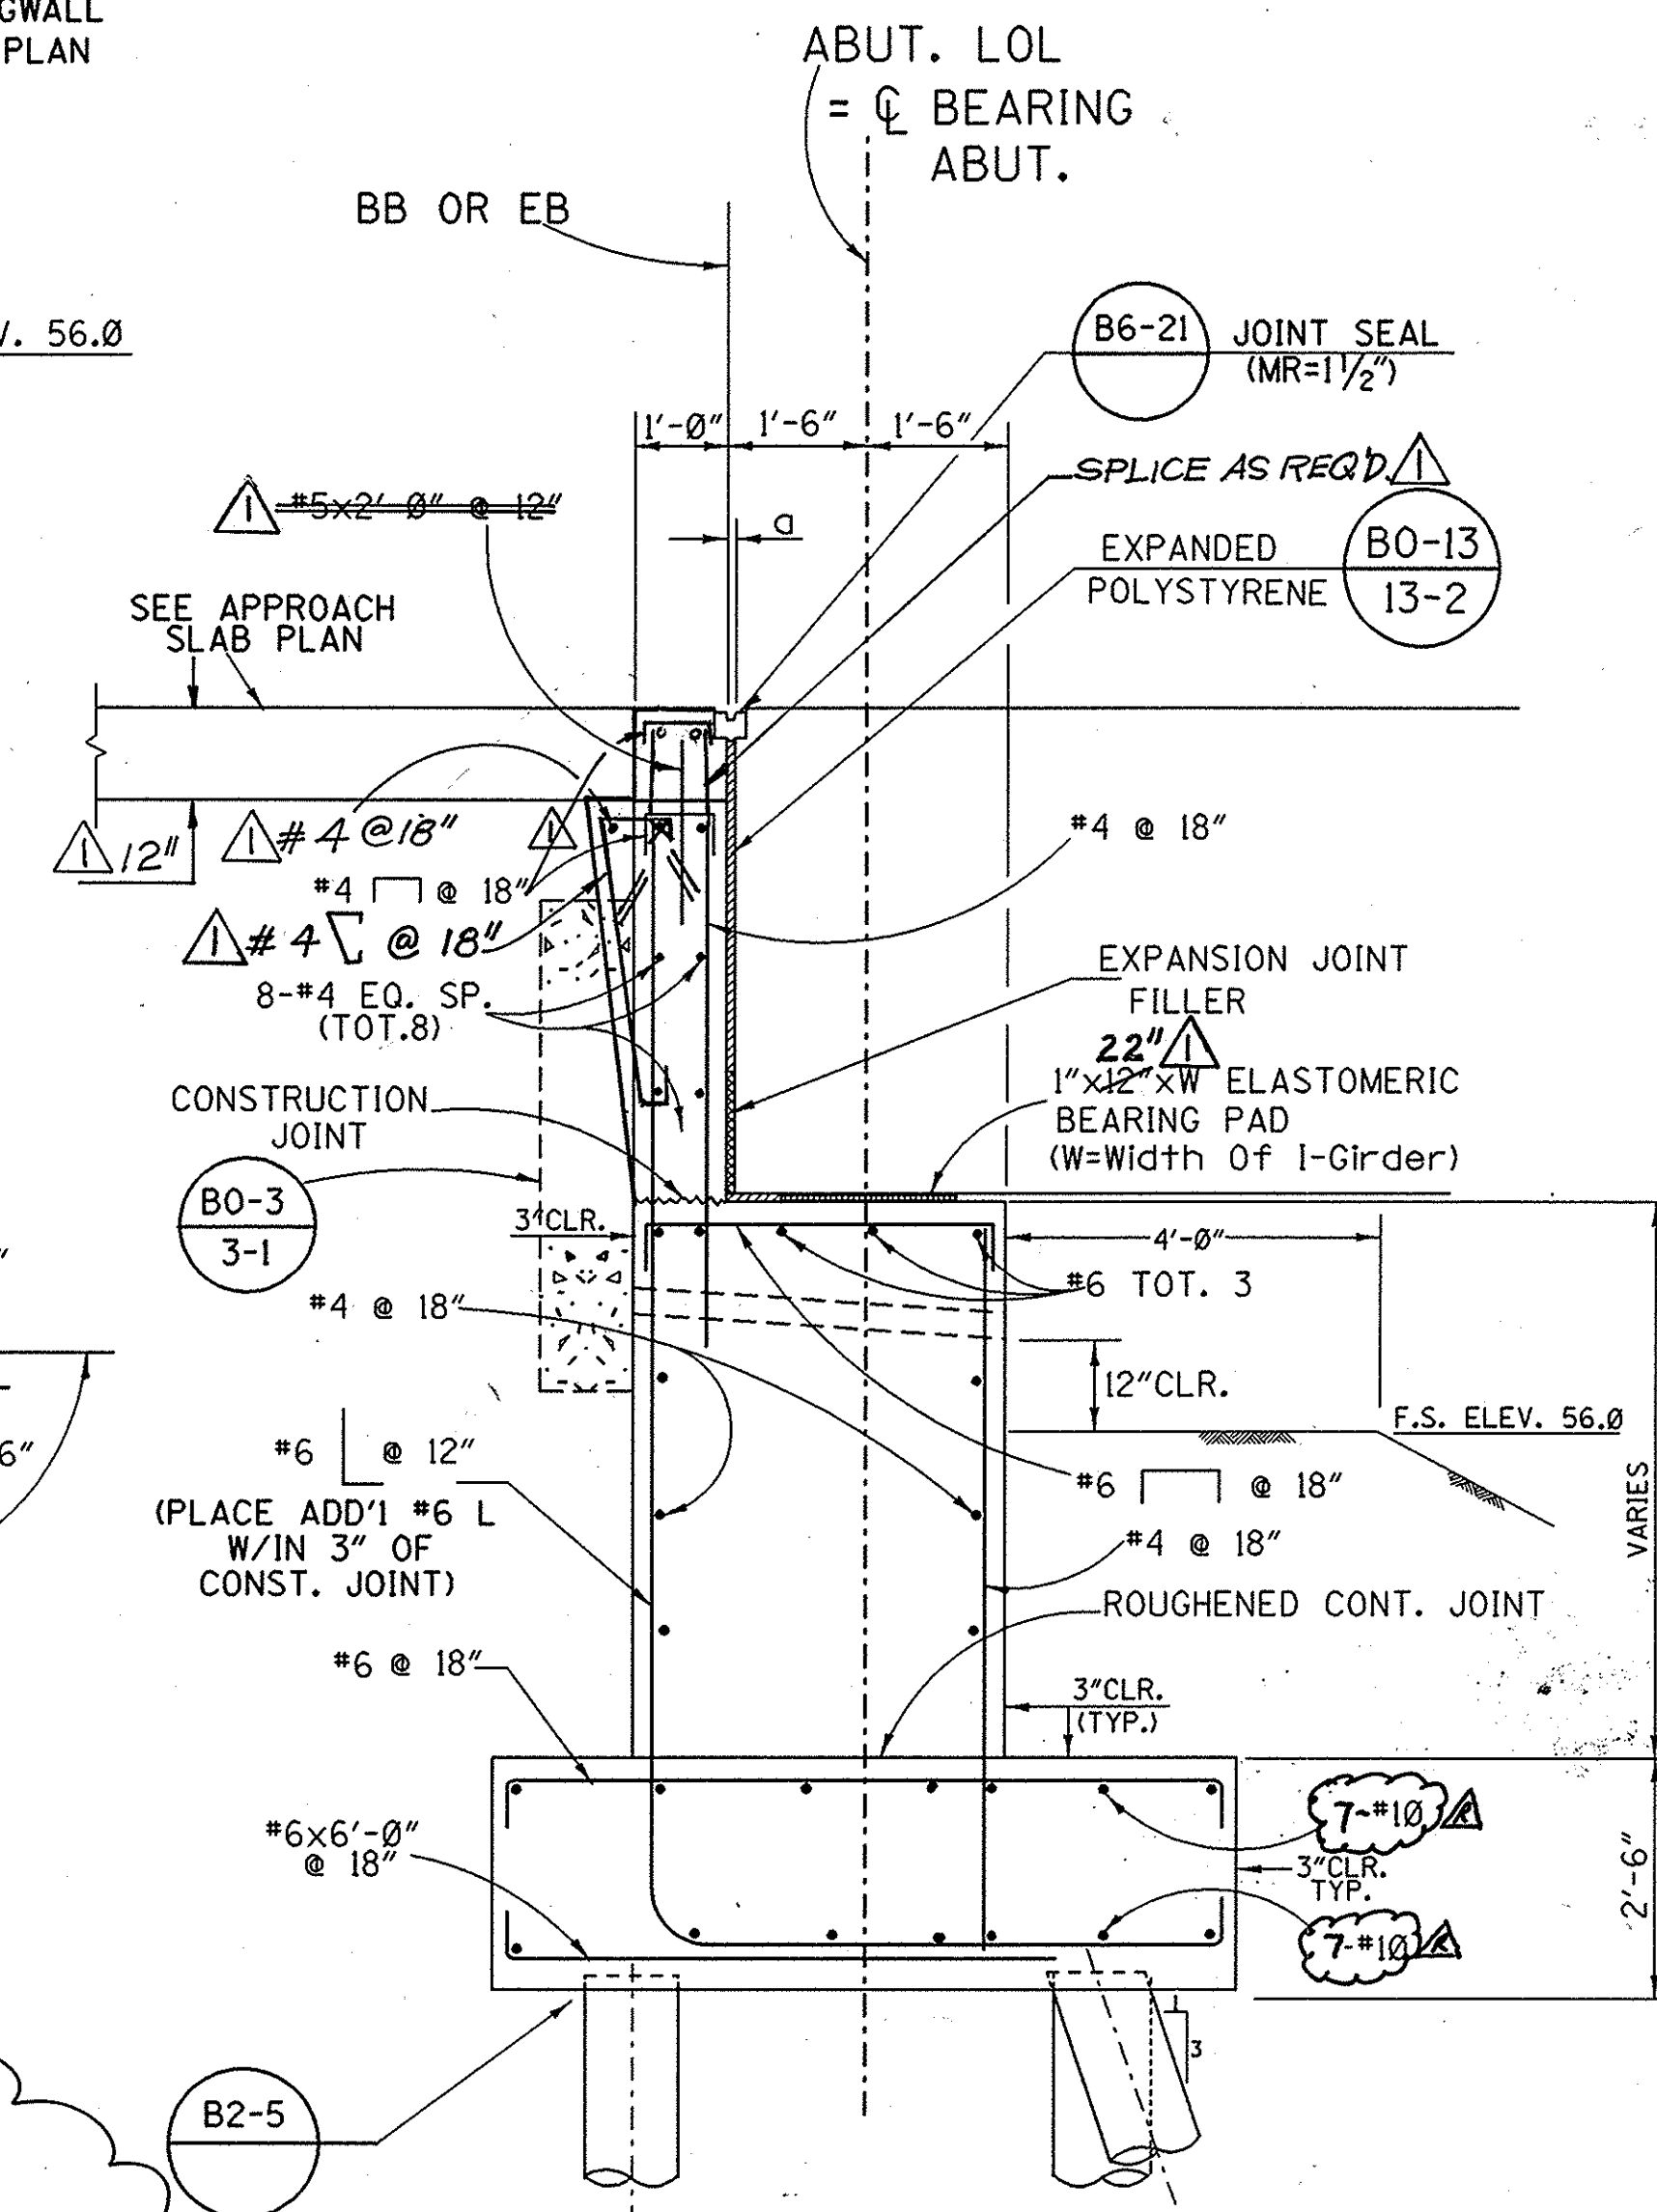


SECTION
SCALE : $\frac{1}{2}'' = 1'-0''$

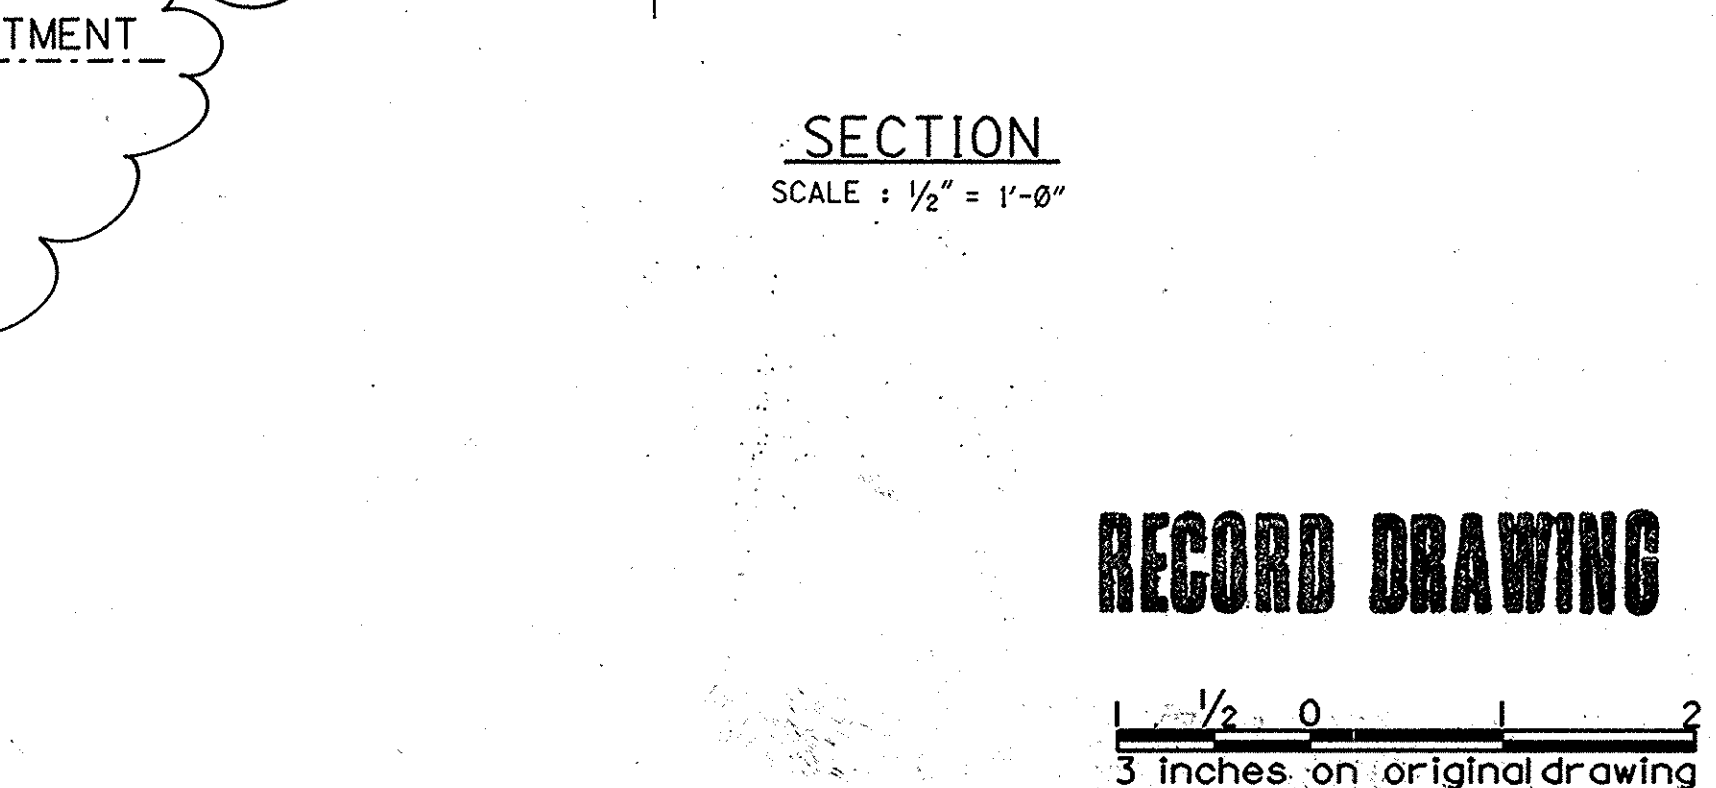

RECORD DRAWING

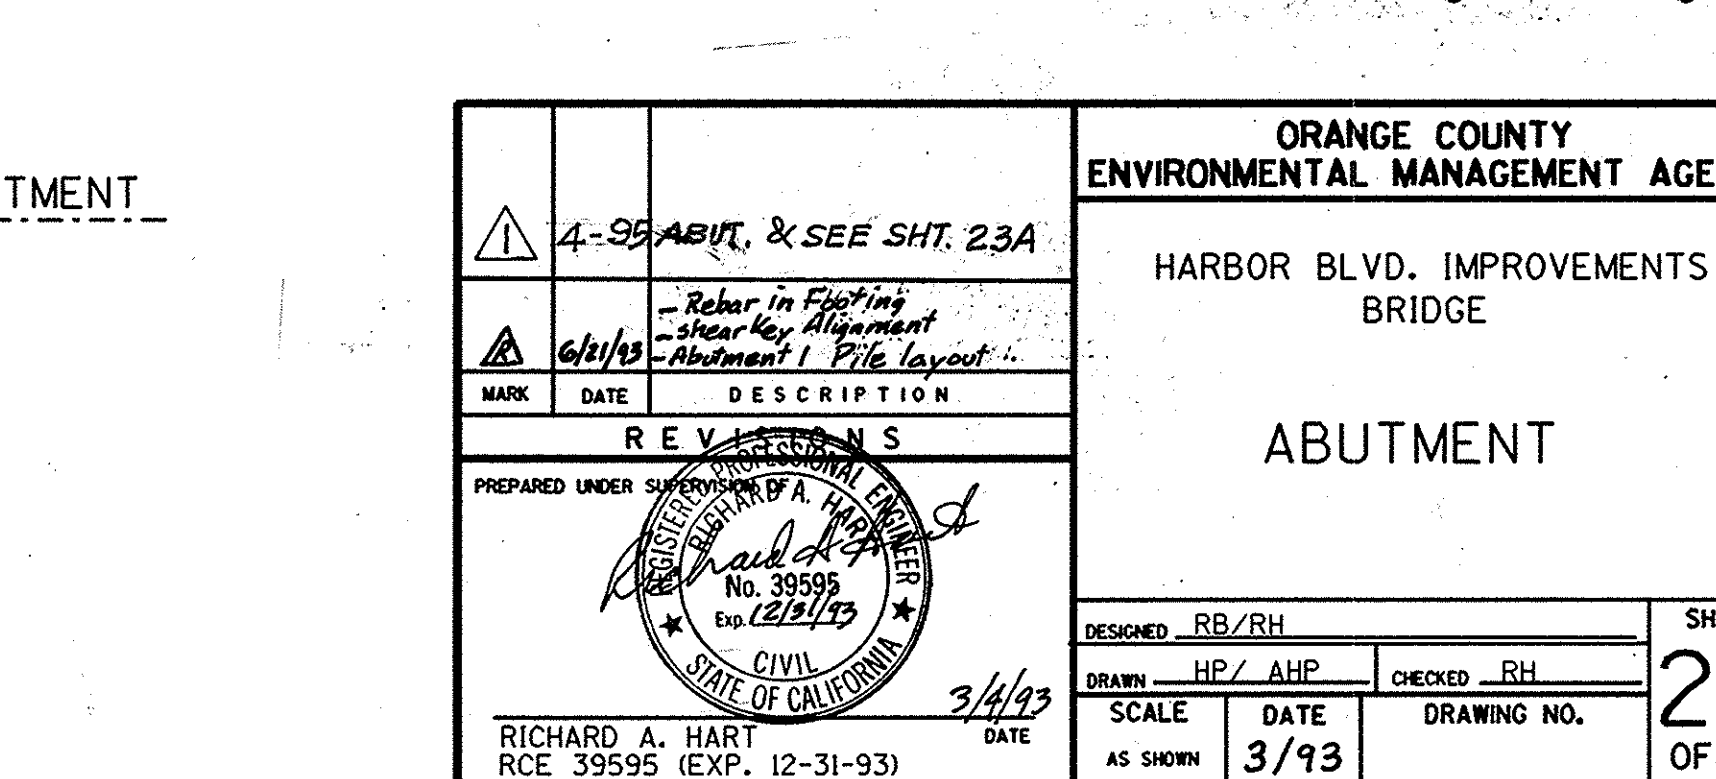


ORANGE COUNTY
ENVIRONMENTAL MANAGEMENT AGENCY

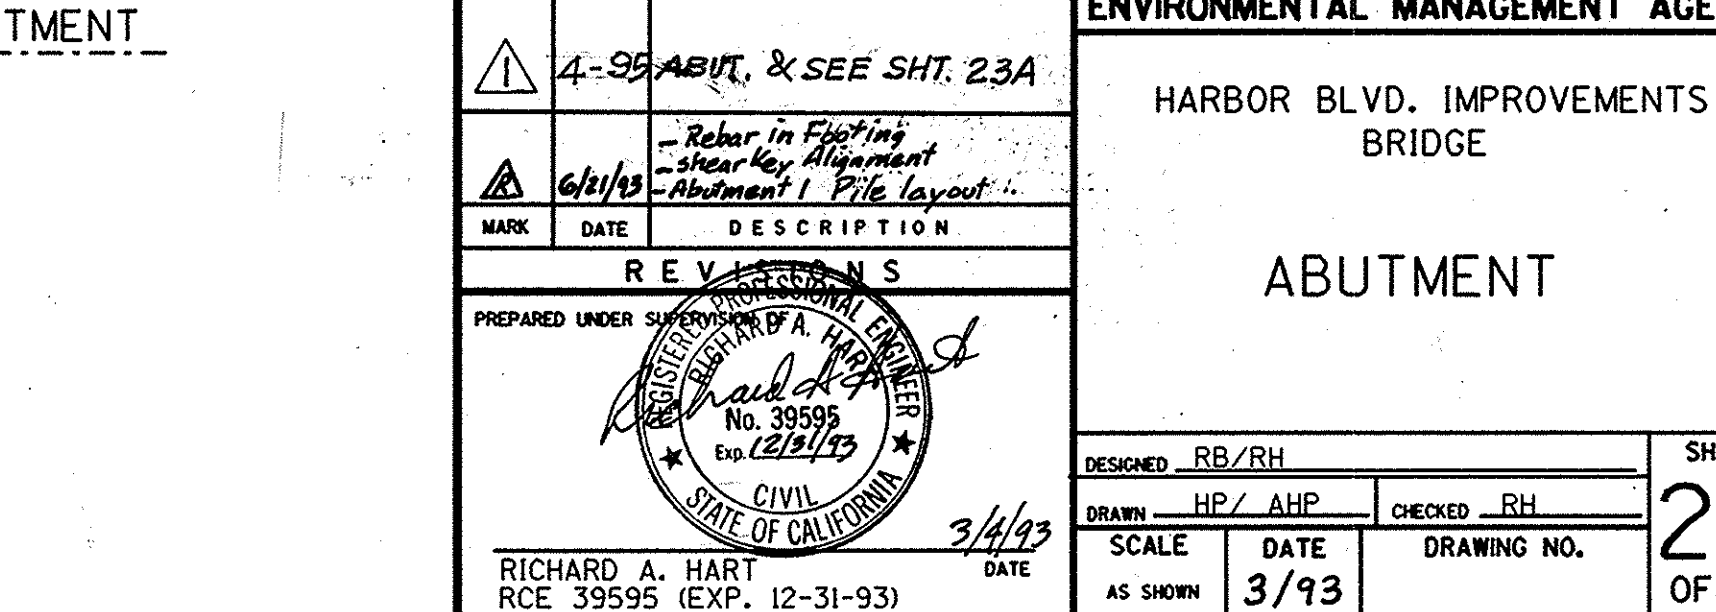

HARBOR BLVD. IMPROVEMENTS
BRIDGE

ABUTMENT

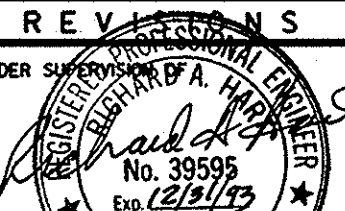					ORANGE COUNTY ENVIRONMENTAL MANAGEMENT AGENCY
	4-95	ABUT. & SEE SHT. 23A			HARBOR BLVD. IMPROVEMENTS BRIDGE
	6/21/93	- Repair in Flushing - Clear Key Alignment - Abutment 1 Pile Layout			
MARK	DATE	DESCRIPTION			
REVISED					ABUTMENT
PREPARED UNDER SUPERVISION					
 RICHARD A. HART RCE, 39595 (EXP. 12-31-93) CIVIL STATE OF CALIFORNIA					
DATE					DESIGNED <u>RB/RH</u> DRAWN <u>HP / AHP</u> CHECKED <u>RH</u> SCALE AS SHOWN DATE <u>3/93</u> DRAWING NO.
					SHEET 20 OF 60