



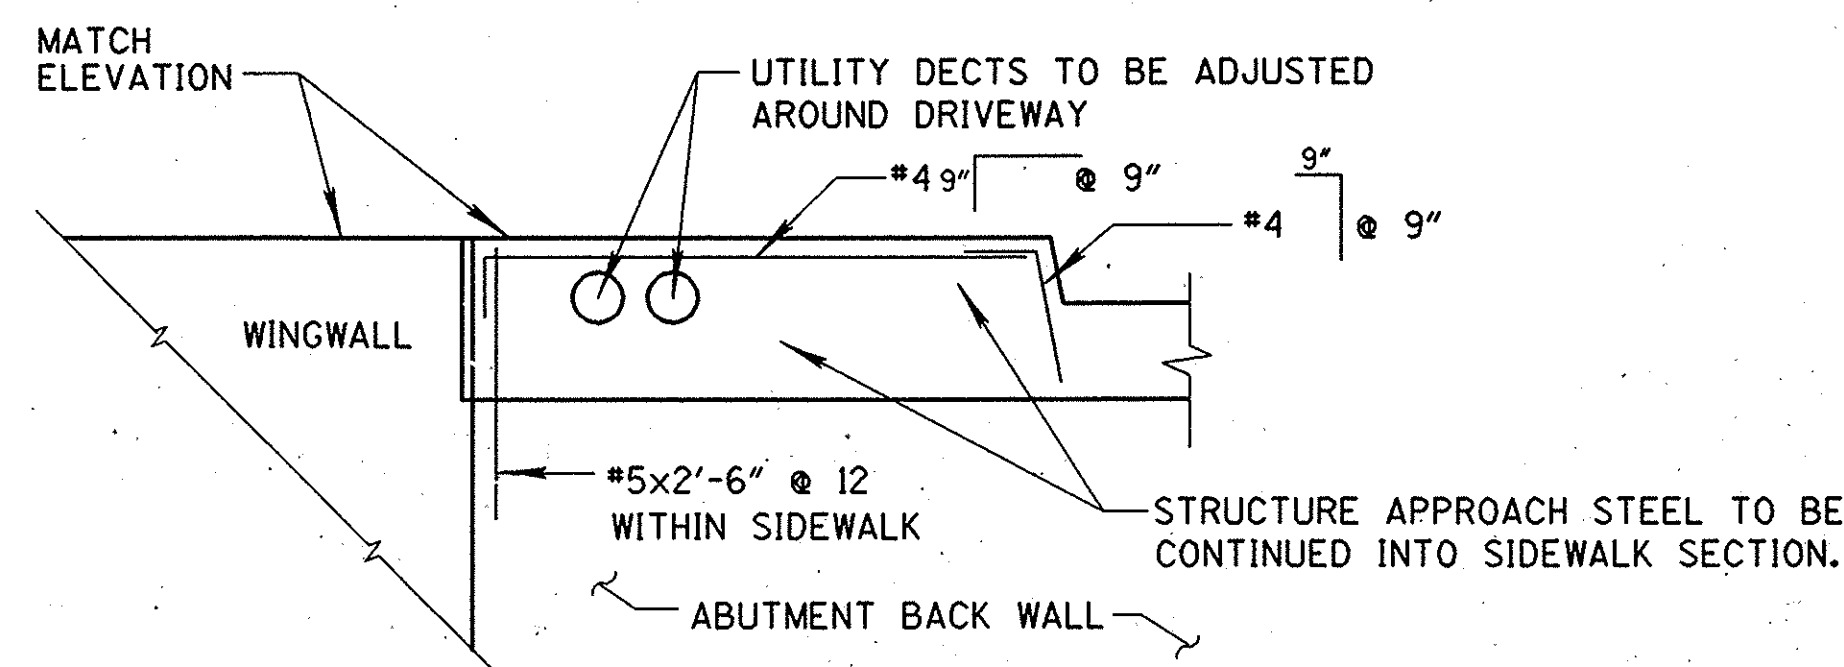


SECTION J - J

Scale: 1/2" = 1'-0"

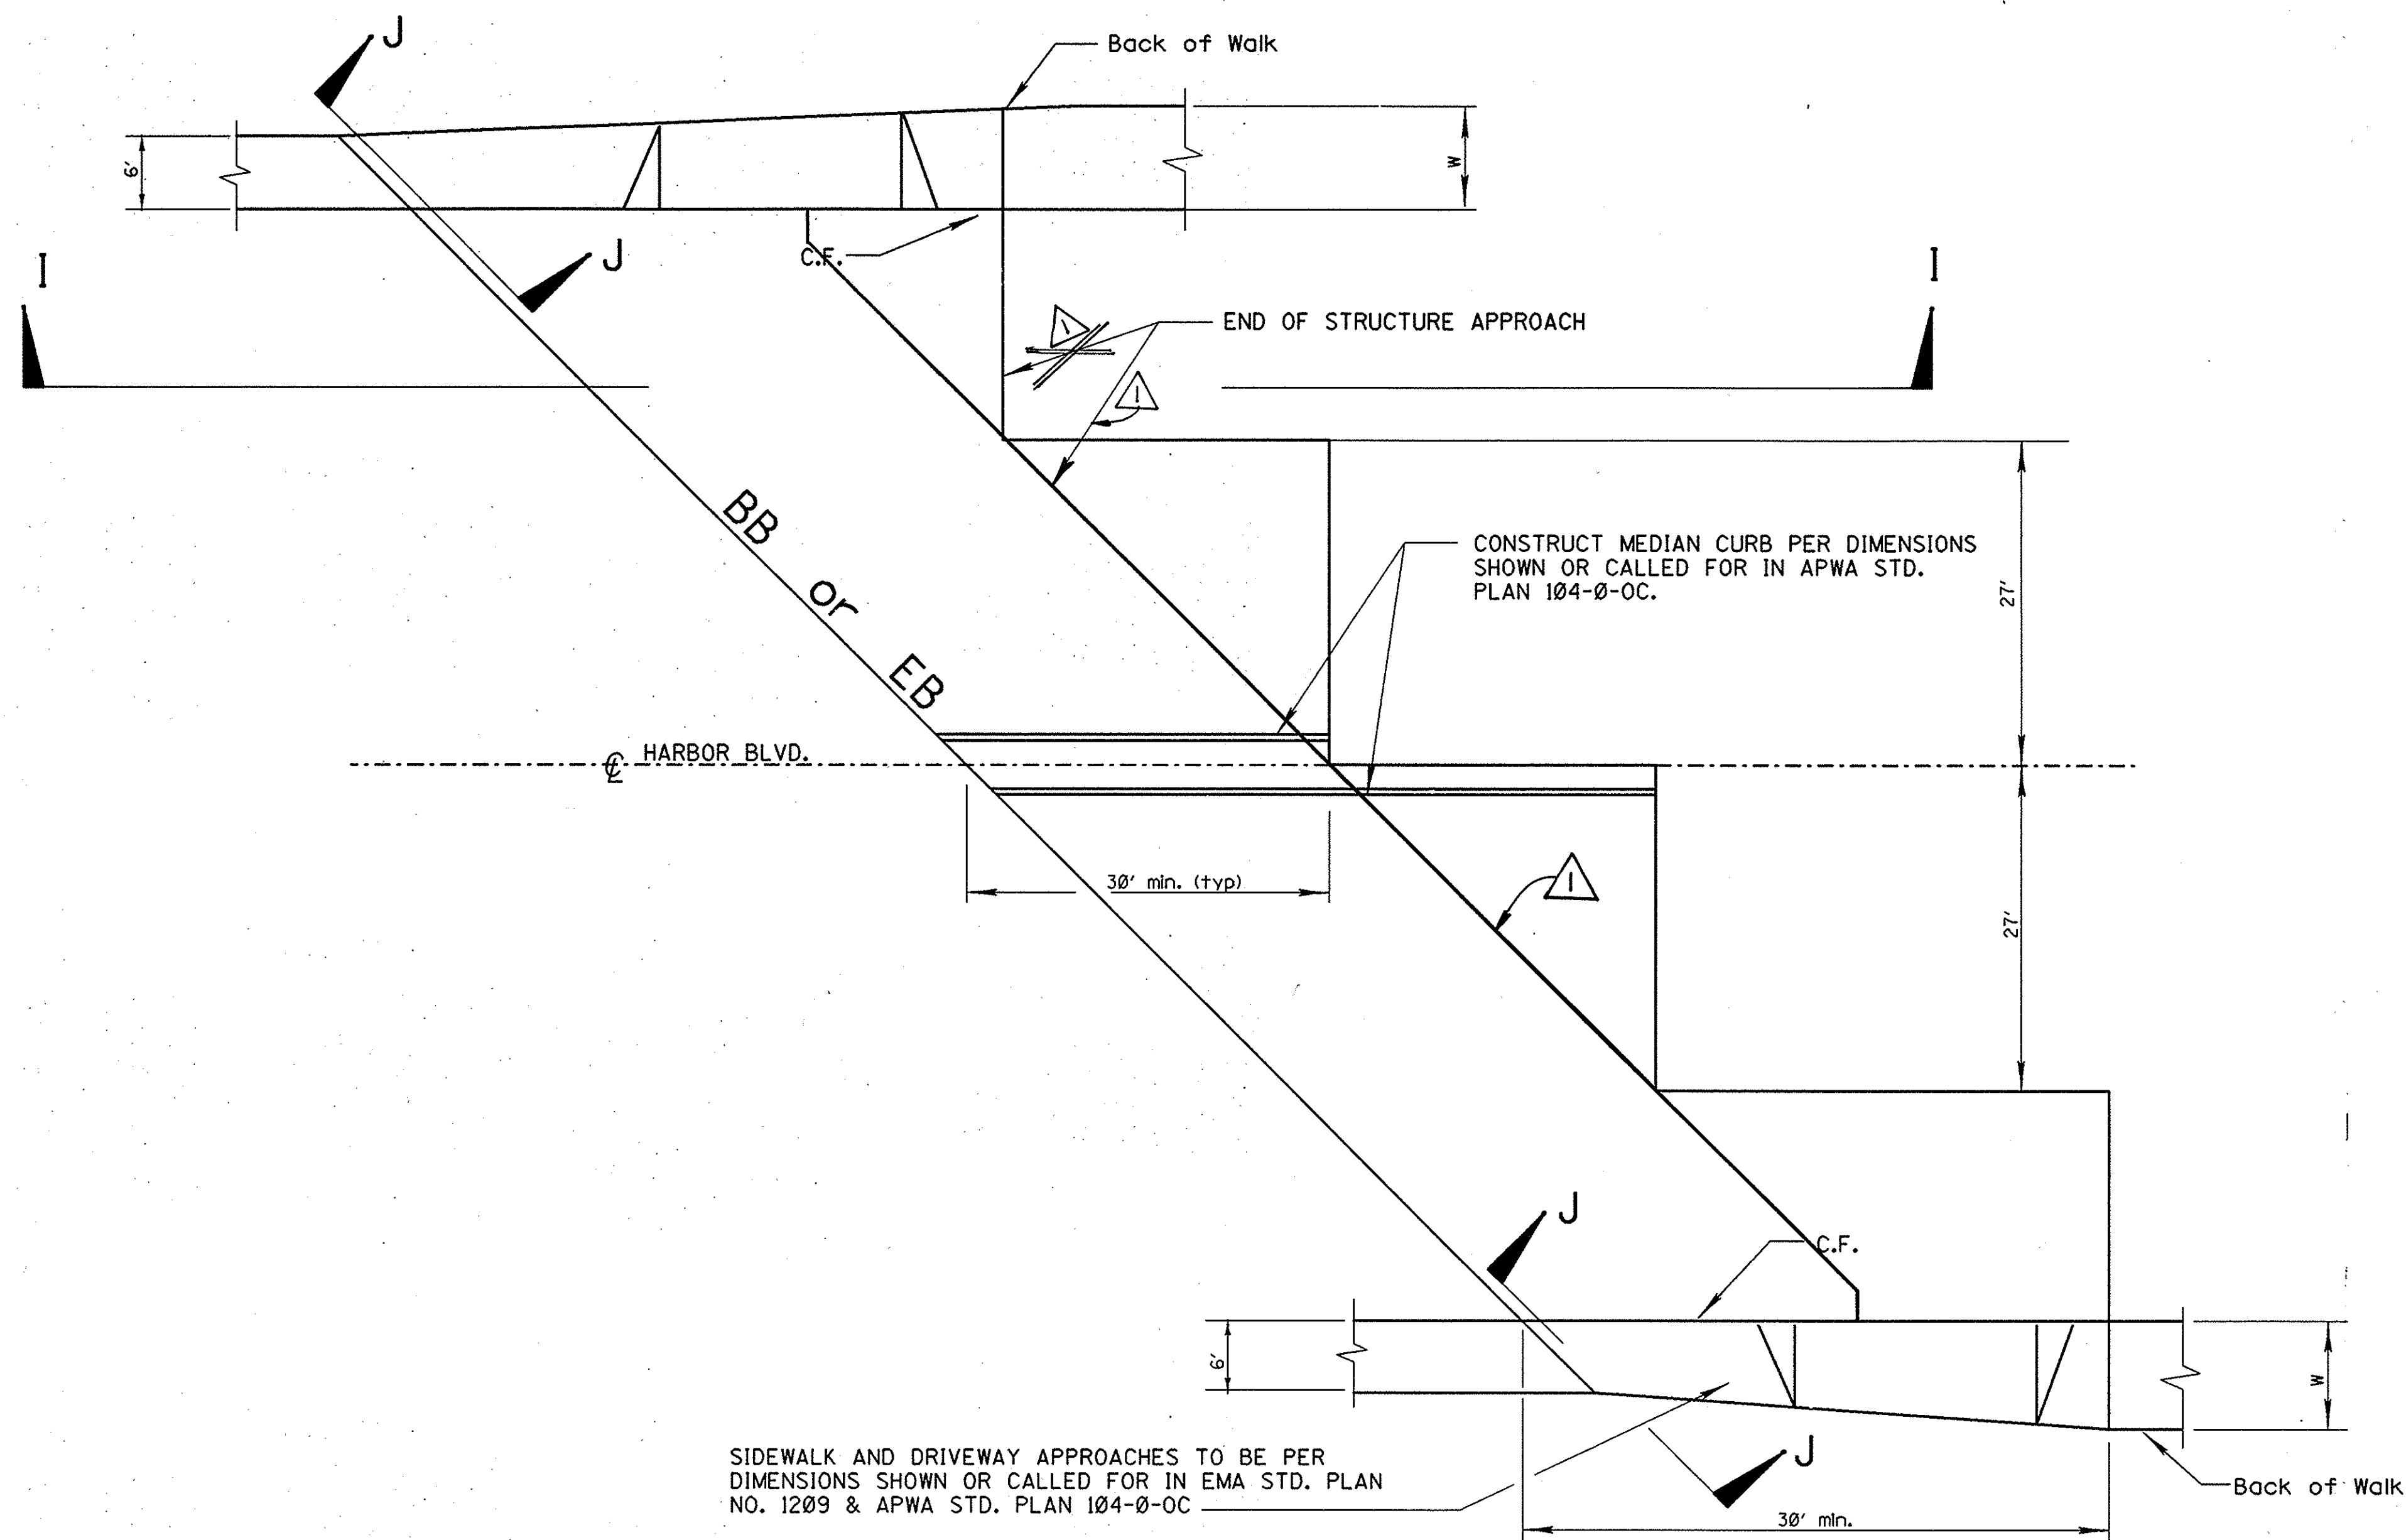


STRUCTURE APPROACH - END STAGGER DETAIL

SCALE: 1" = 10'-0"

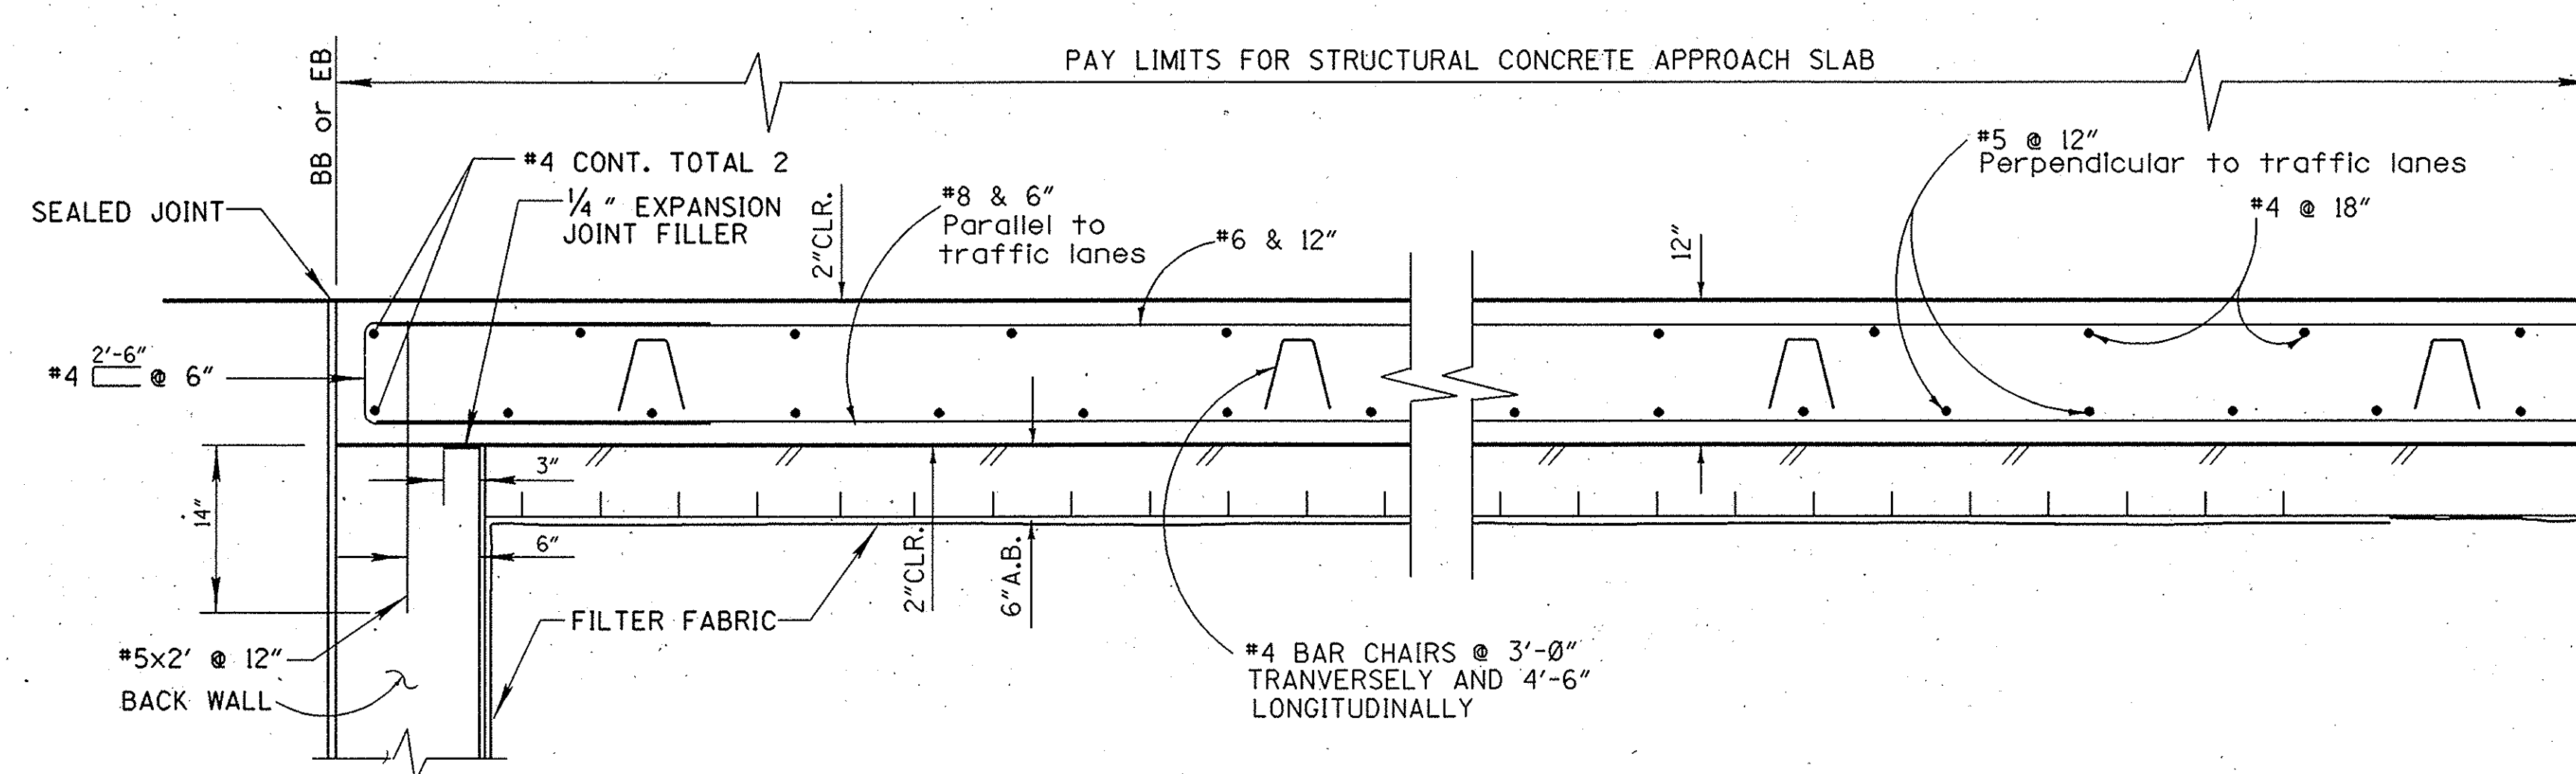

SECTION I - I

SCALE: 1" = 1'-0"

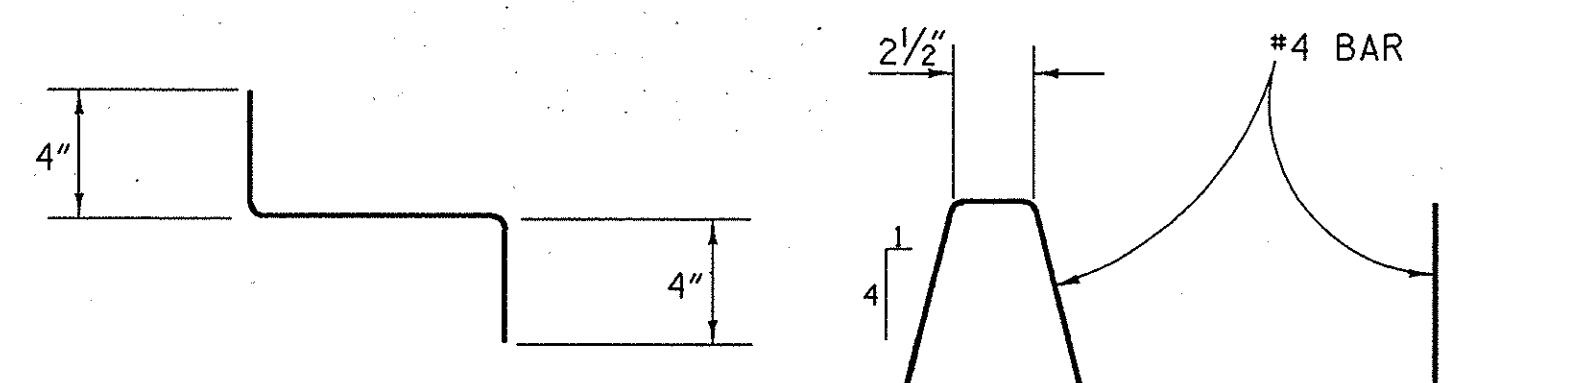

BAR CHAIR DETAIL

Scale: 2" = 1'-0"

RECORD DRAWING

1/2" = 0' 1" 2"
3 inches on original drawing

ORANGE COUNTY ENVIRONMENTAL MANAGEMENT AGENCY	
HARBOR BLVD. IMPROVEMENTS BRIDGE	
APPROACH SLAB	
DESIGNED RB/RH	SHEET 22 OF 60
DRAWN HP/SG	CHECKED RAH
SCALE AS SHOWN	DATE 3/93
DRAWING NO.	

REVISIONS

MARK	DATE	DESCRIPTION
4/95	REVISE END OF STRUCTURE APPROACH	

PREPARED UNDER SUPERVISION OF

RICHARD A. HART
RCE 39595 (exp. 12-31-93)

DATE 3/4/93