
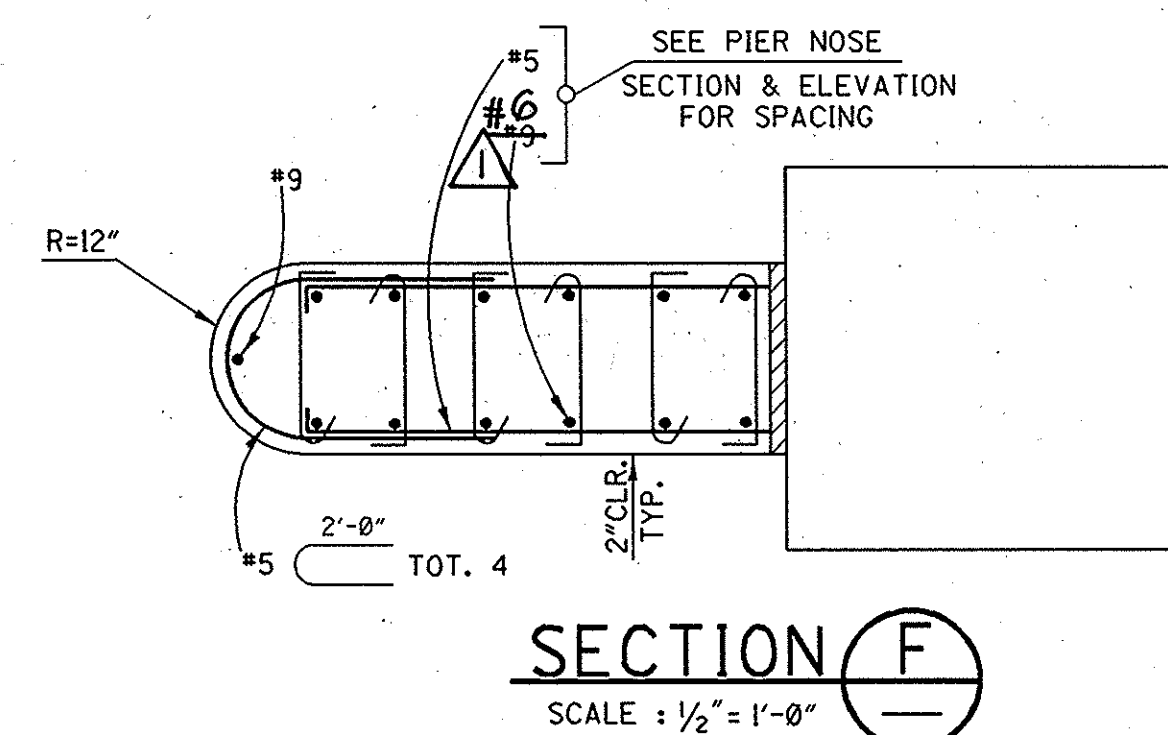
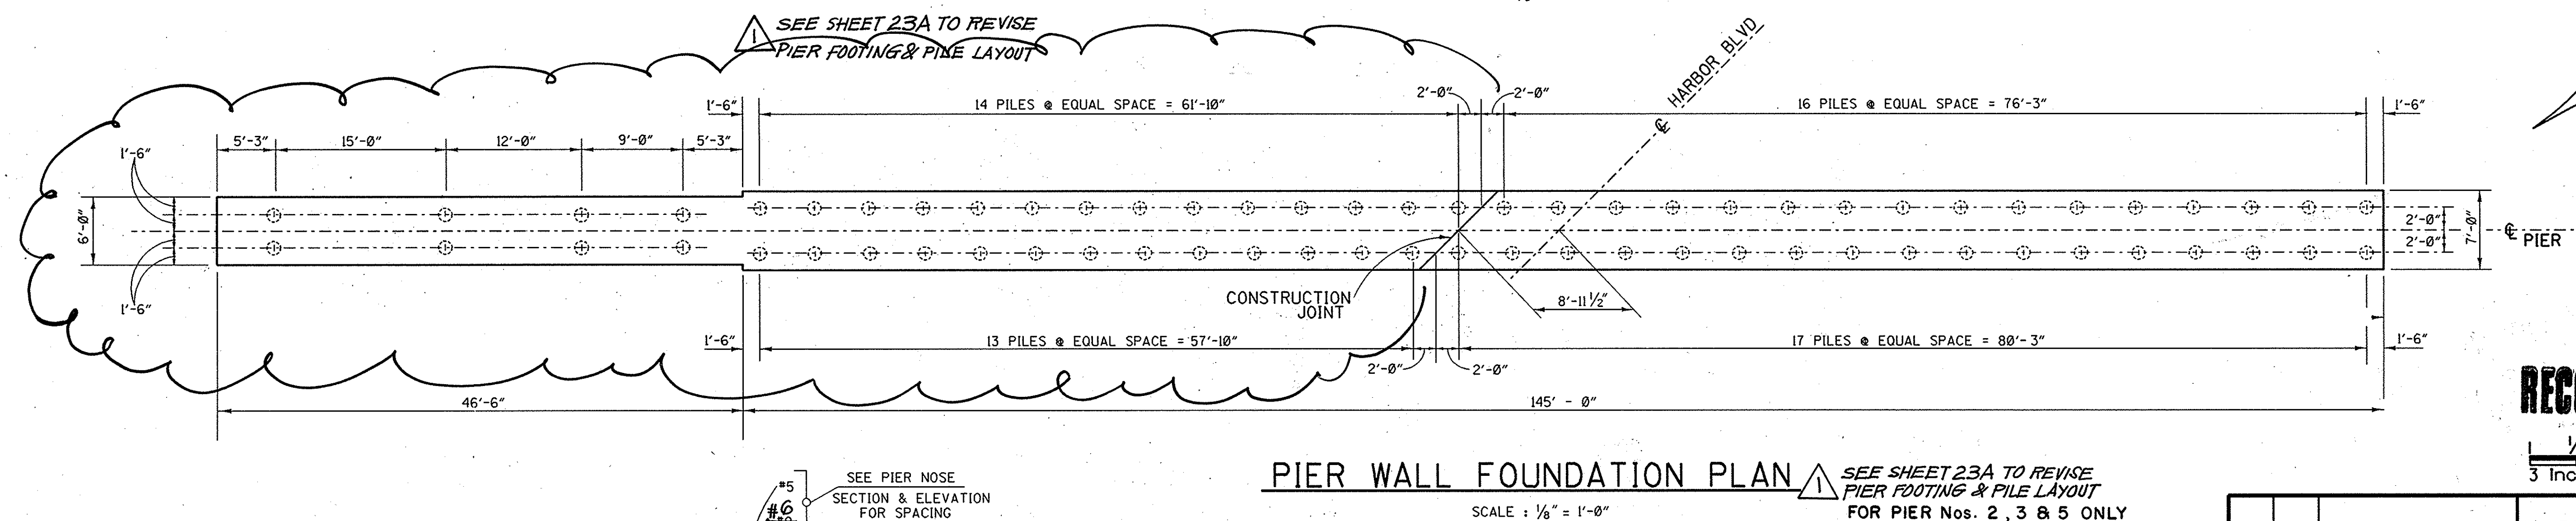
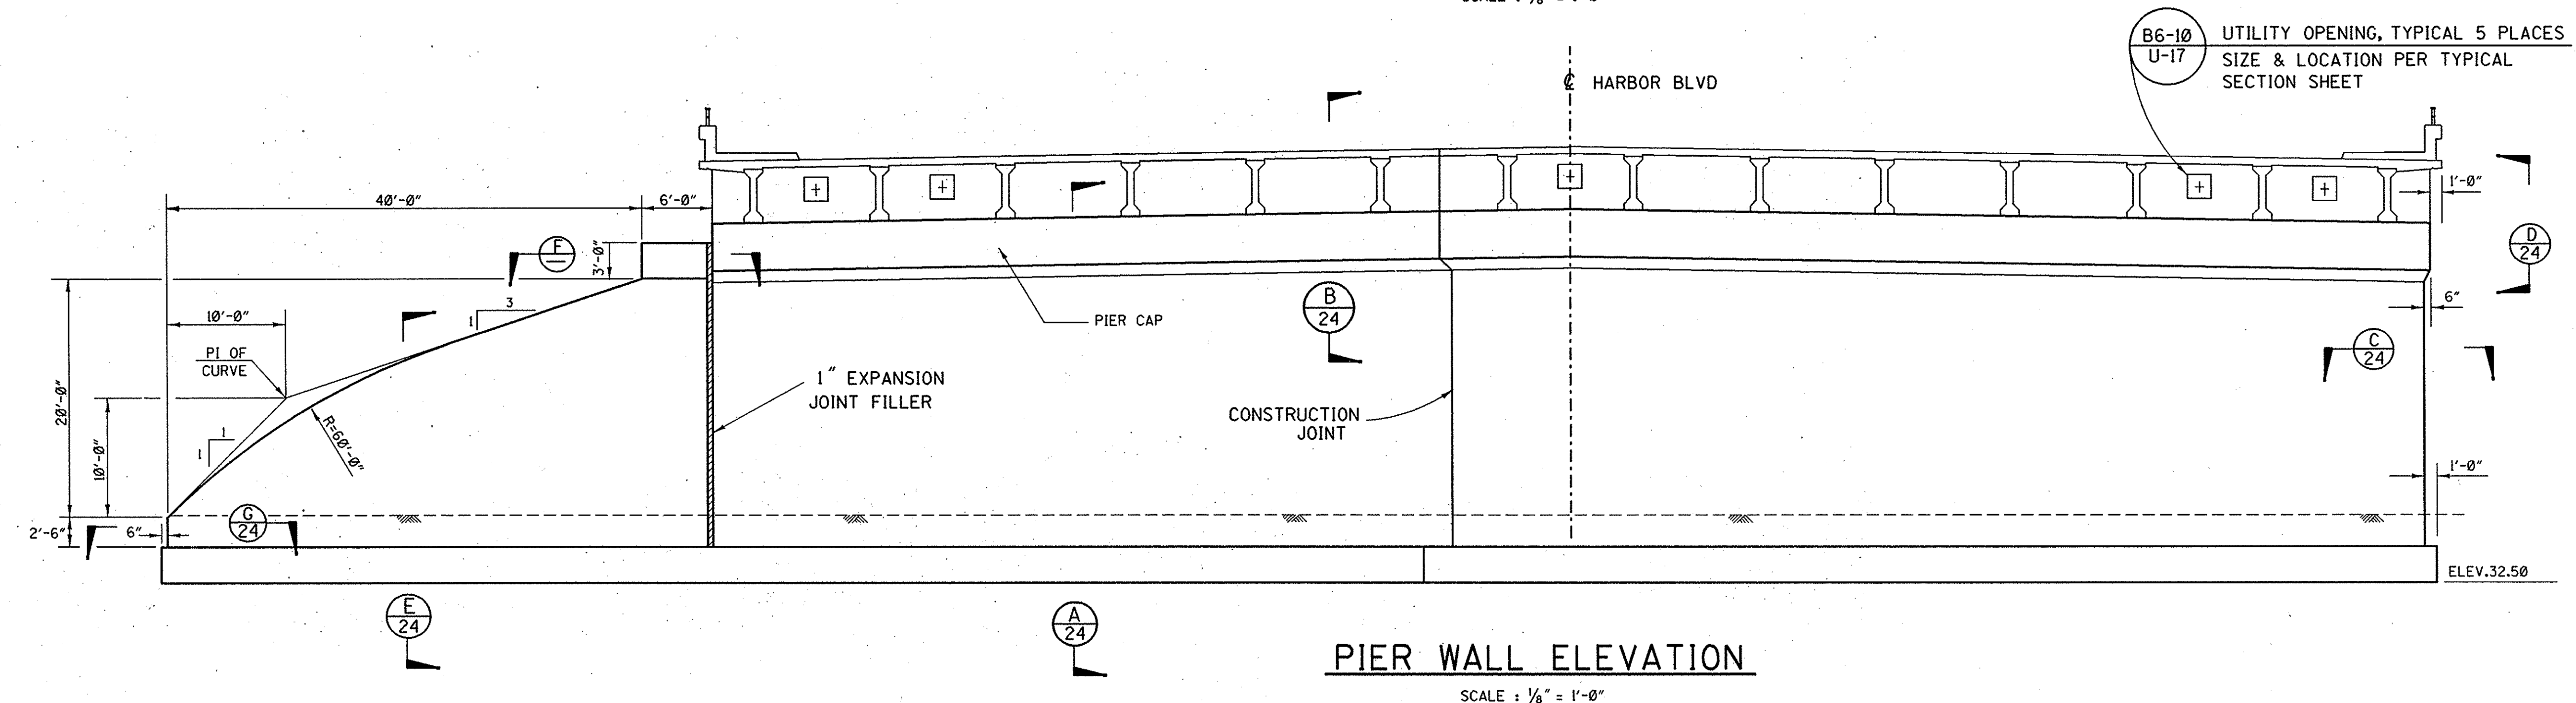


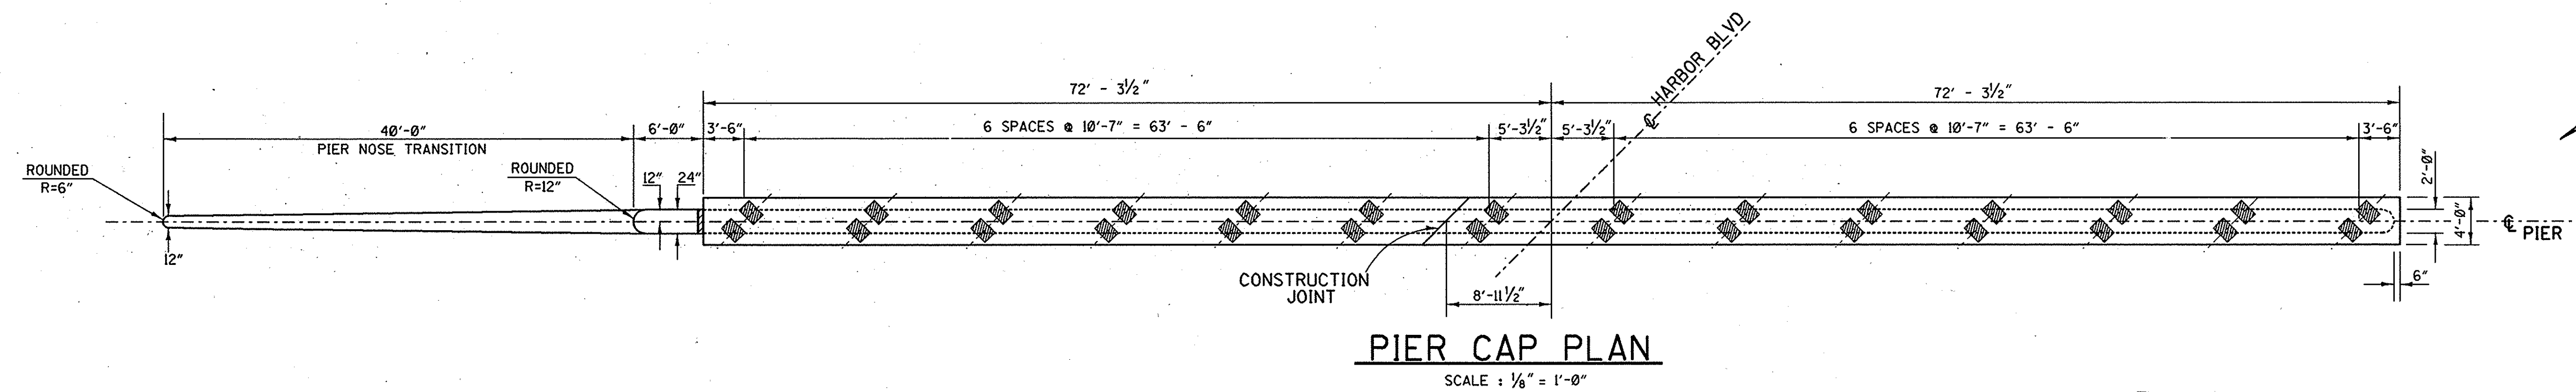

RECORD DRAWING

3 Inches on original drawing

				ORANGE COUNTY ENVIRONMENTAL MANAGEMENT AGENCY	
		9/95 PIER FOOTING, PILE LAYOUT & SEE SHT. 23A		HARBOR BLVD. IMPROVEMENTS BRIDGE	
MARK	DATE	DESCRIPTION			
REVISIONS					
PREPARED UNDER:  3/4/43 DATE					
RICHARD RCE 39595 (EX-101-31-93)		DESIGNED RB/RH		SHEET	
		DRAWN HP	CHECKED RH		
		SCALE	DATE	DRAWING NO.	
		AS SHOWN	3/93	23 OF 60	