



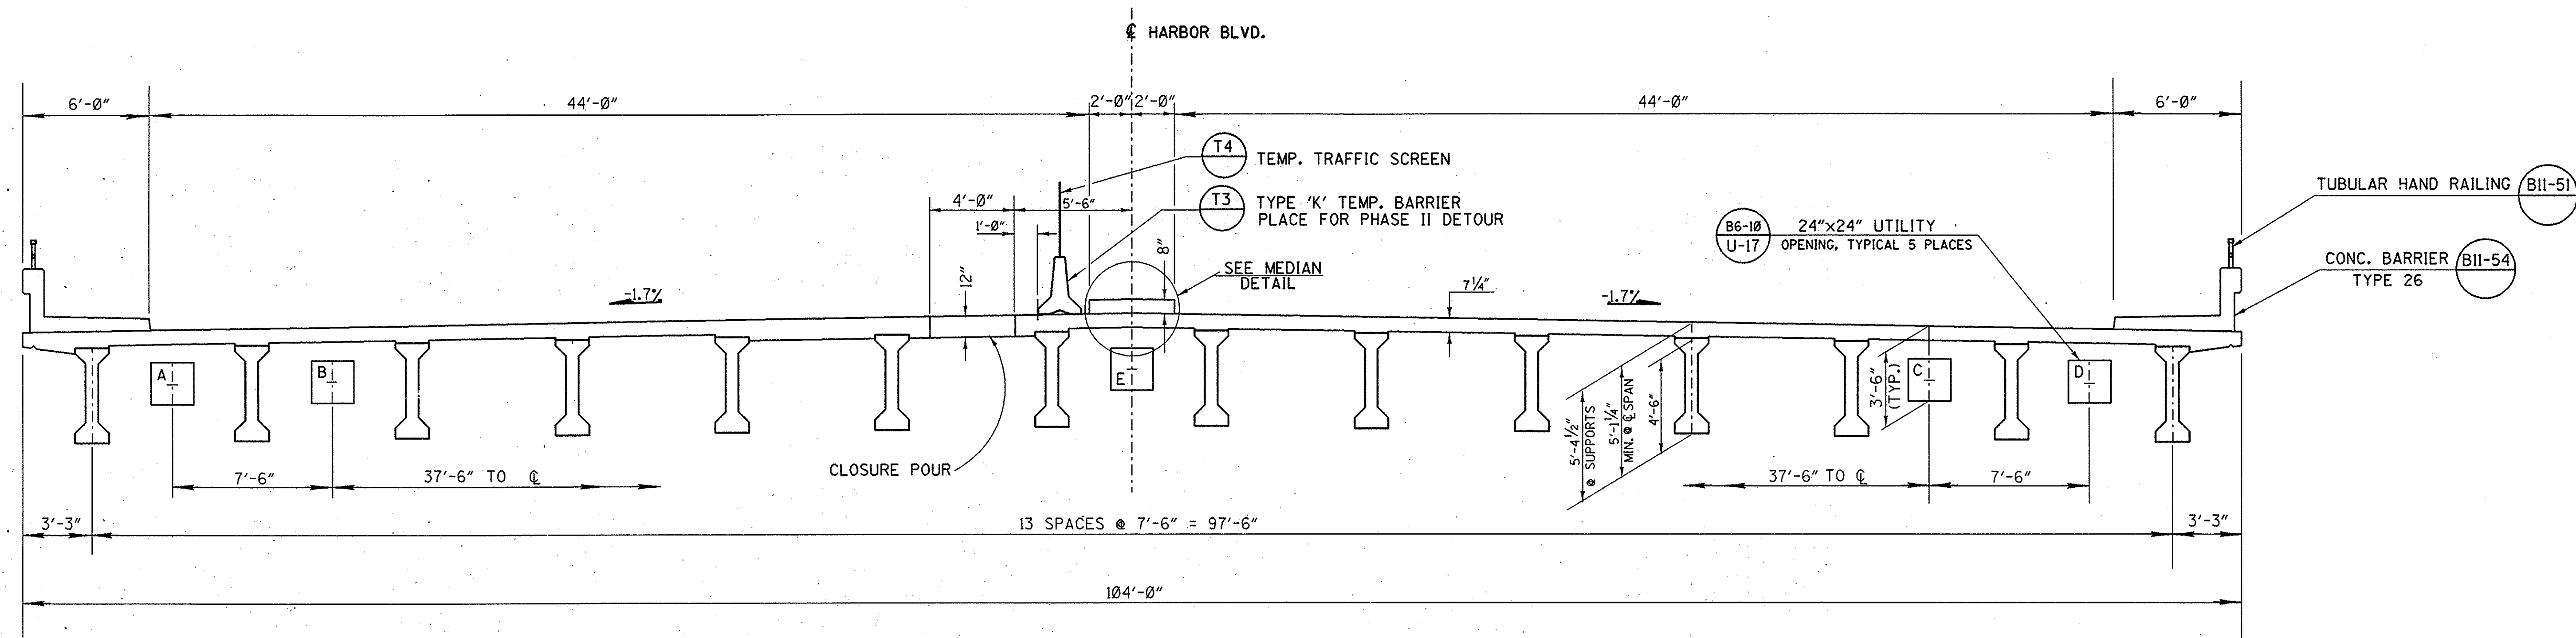


TYPICAL SECTION

SCALE : 1/4" = 1' - 0"

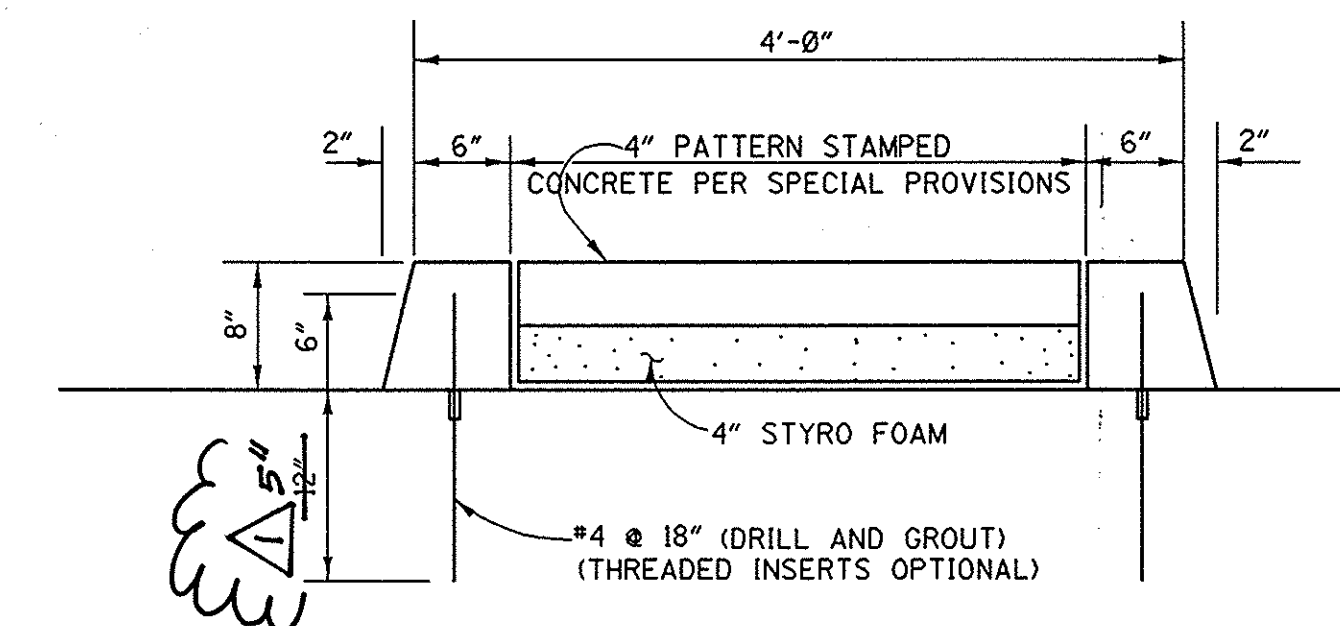

MEDIAN DETAIL

SCALE : 1" = 1'-0"

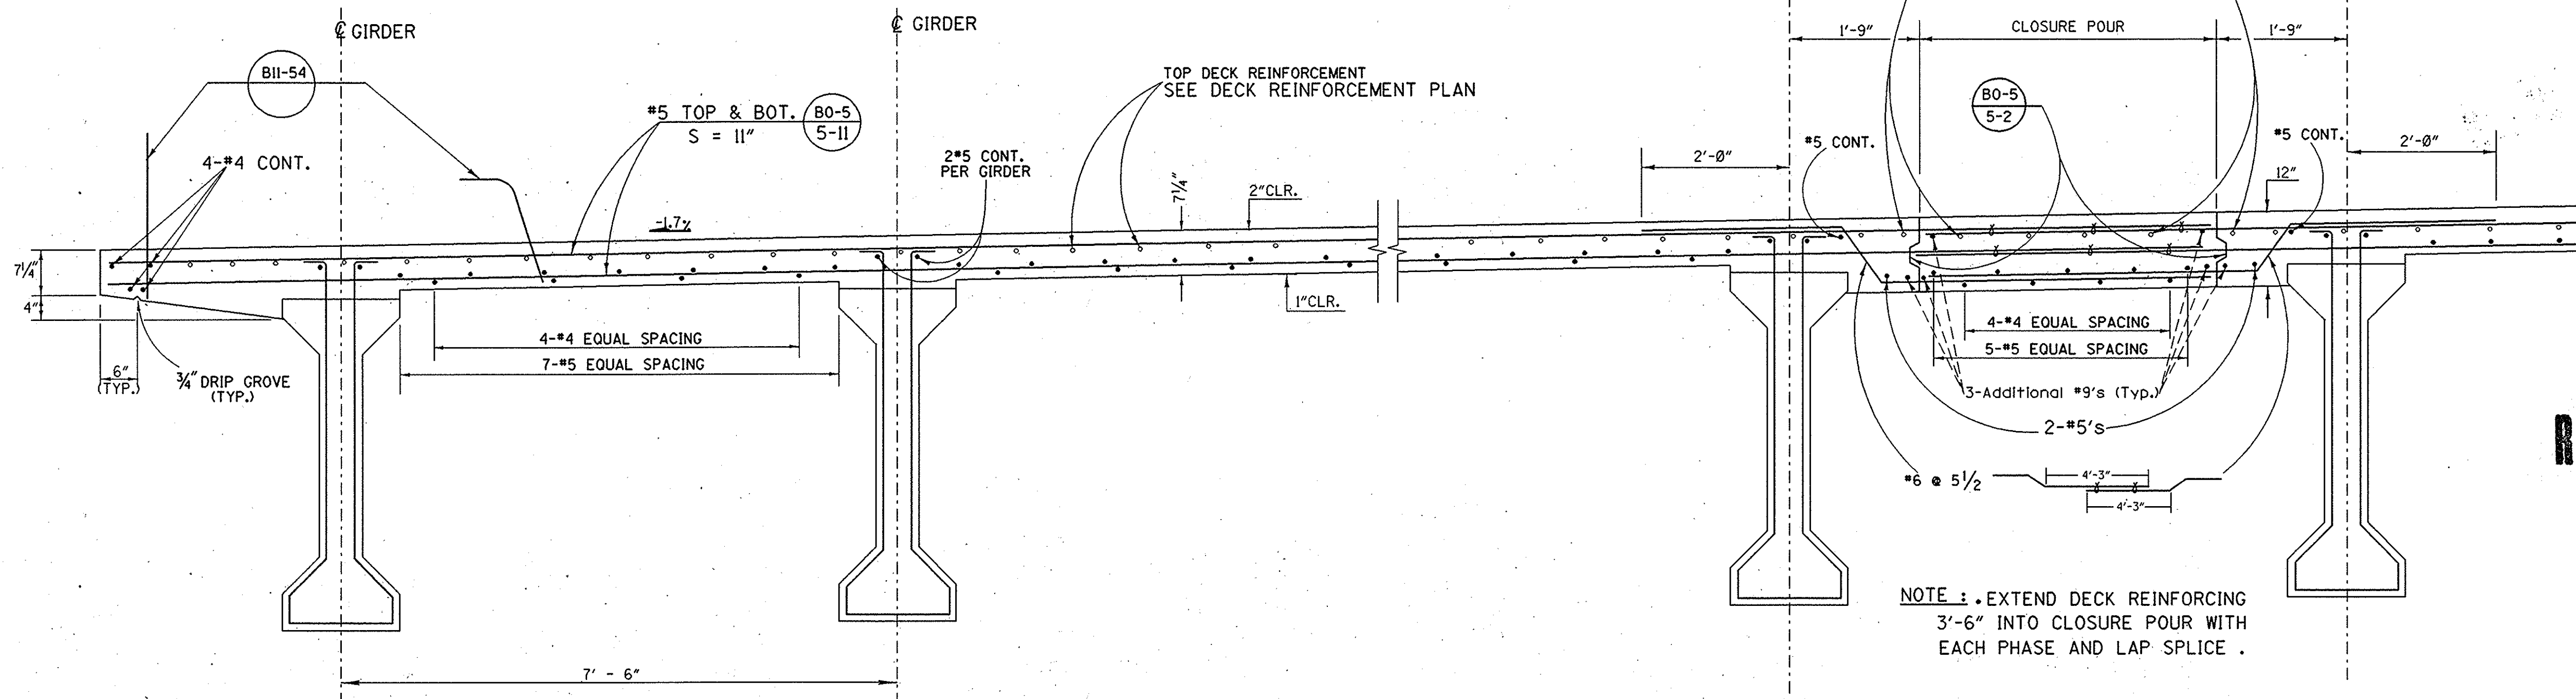

PART TYPICAL SECTION

SCALE : 3/4" = 1' - 0"

UTILITY INFORMATION

- A- FUTURE UTILITY OPENING - SO. CALIFORNIA GAS COMPANY
- B- FUTURE UTILITY OPENING - ABANDON SCE DUCTS
- C- FUTURE UTILITY OPENING - PACIFIC BELL SCE
- D- FUTURE UTILITY OPENING - SCE
- E- FUTURE UTILITY OPENING - SCE

RECORD DRAWING

1/2 0 2
3 inches on original drawing

		ORANGE COUNTY ENVIRONMENTAL MANAGEMENT AGENCY	
4/95 UTILITY INFORMATION & AS SHOWN MARK DATE DESCRIPTION		HARBOR BLVD. IMPROVEMENTS BRIDGE	
REVISIONS		TYPICAL SECTION	
DESIGNED	RB/RH	CHECKED	RH
DRAWN	HP	DATE	3/93
SCALE	AS SHOWN	DRAWING NO.	
RICHARD A. HART RCE 39595 (EXP. 12-31-93)		SHEET 25 OF 60	