
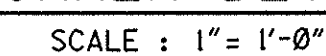


W = WIDTH OF I-GIRDER

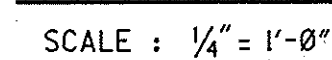

* CUT BARS TO MAINTAIN
2" C-C .

OF 60