


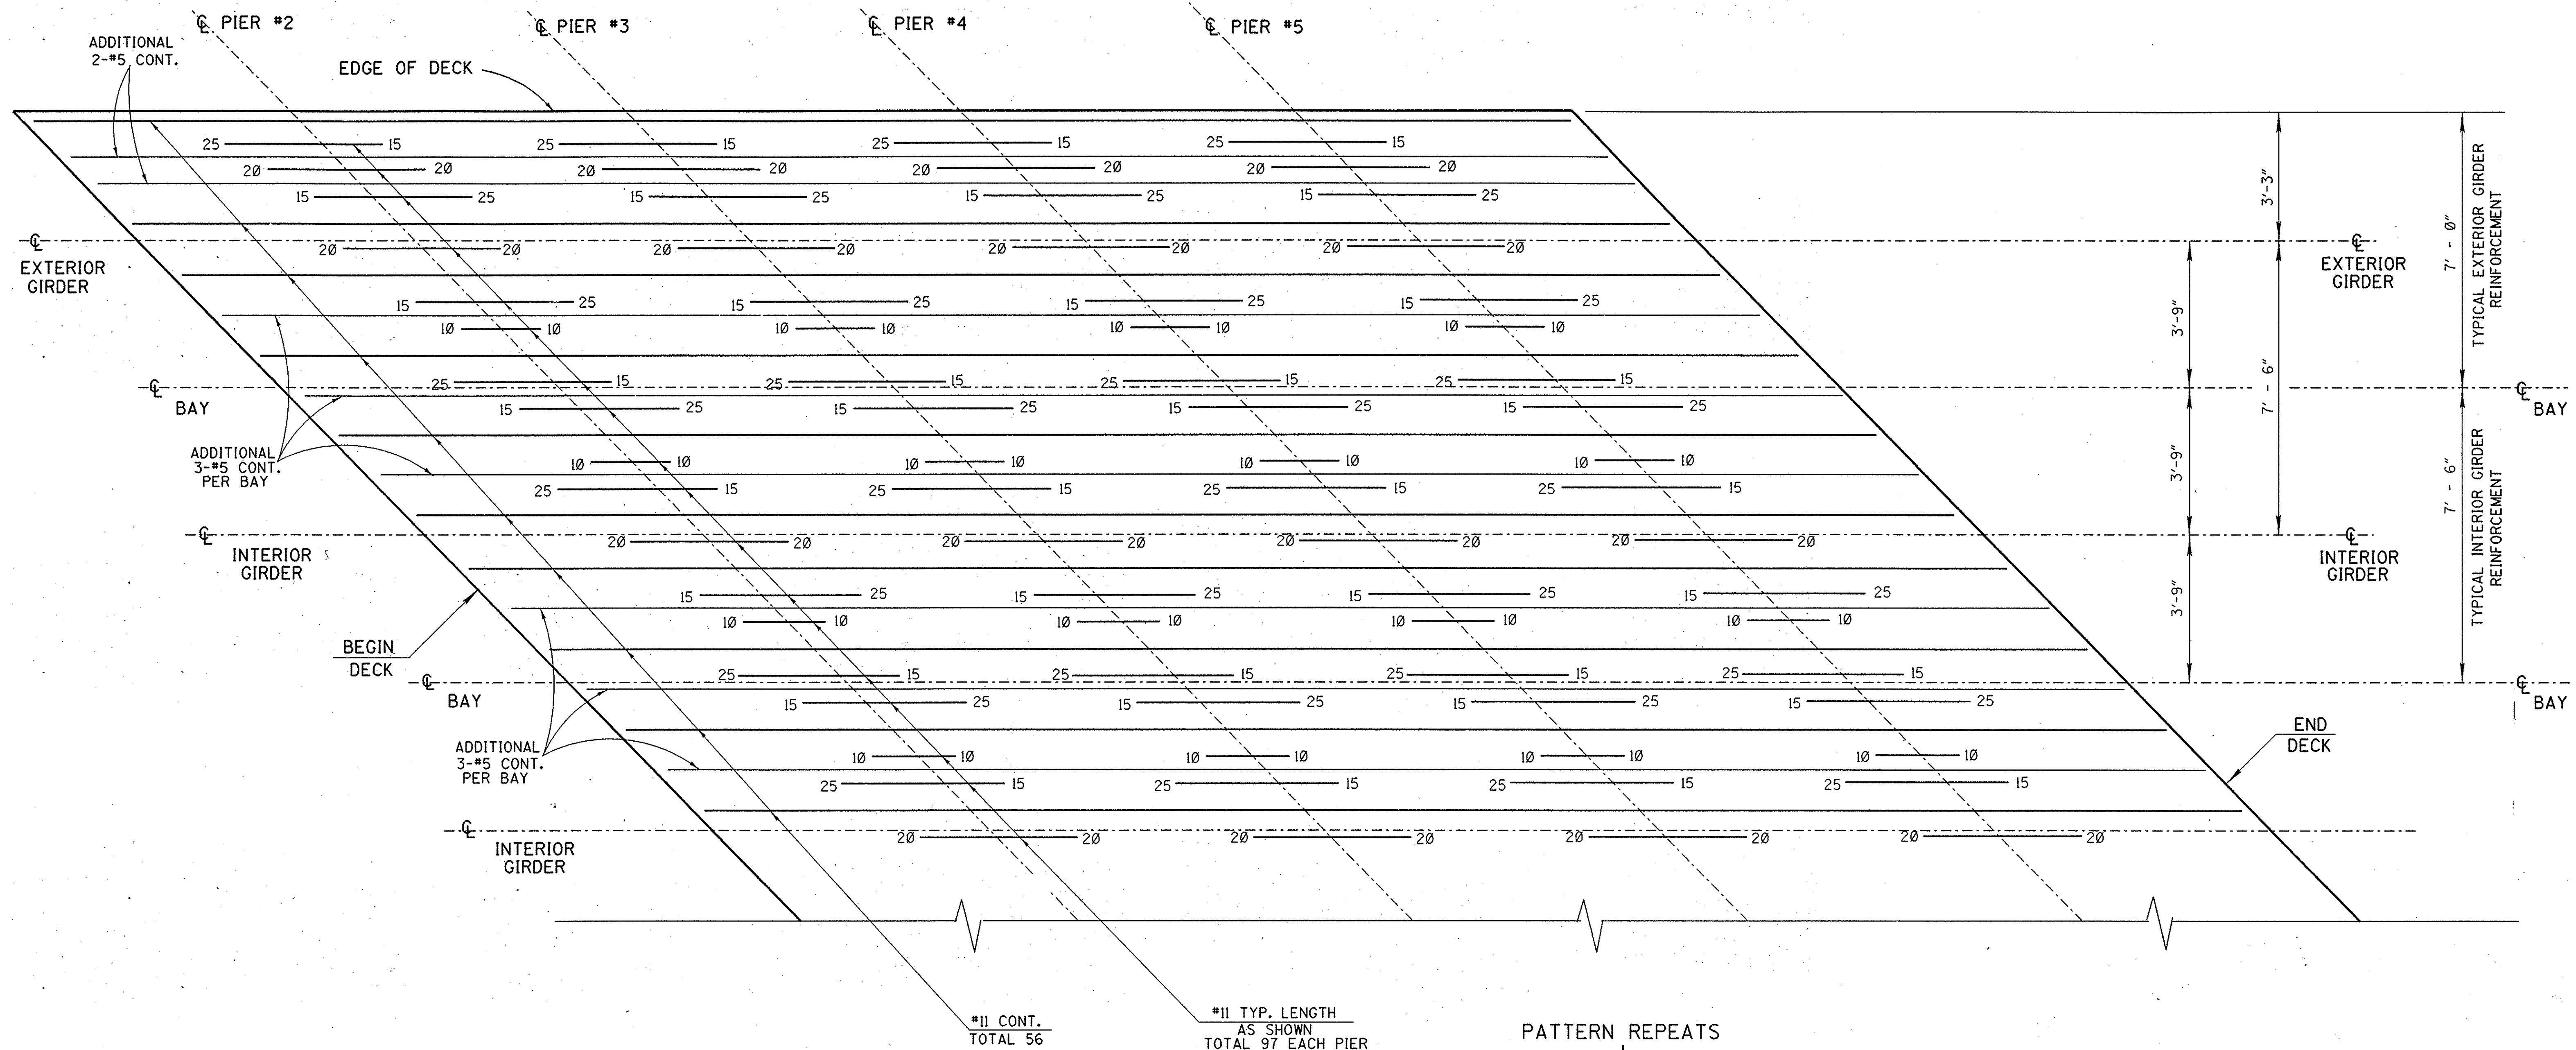

NOTE :

- ALL #11's TO BE EQUAL SPACE
- ADDITIONAL #5's TO BE CENTERED BETWEEN #11's
- NO SPLICING WITHIN 1/3 SPAN LENGTH OF PIER
- #11 BARS ADJACENT TO EACH SIDE OF CLOSURE POUR TO BE CONTINUOUS.

LONGITUDINAL TOP DECK REINFORCEMENT

SCALE H : 1"=20'-0"  
V : 1"=2'-0"

RECORD DRAWING

1/2 0 1 2  
3 inches on original drawing

|                                                  |                      |
|--------------------------------------------------|----------------------|
| ORANGE COUNTY<br>ENVIRONMENTAL MANAGEMENT AGENCY |                      |
| HARBOR BLVD. IMPROVEMENTS<br>BRIDGE              |                      |
| DECK REINFORCEMENT                               |                      |
| DESIGNED RB/RH                                   | CHECKED RH           |
| DRAWN HP                                         | DATE 3/93            |
| SCALE AS SHOWN                                   | DRAWING NO. 27 OF 60 |

REVISIONS

PREPARED UNDER

RICHARD A. HART  
RCE 39595 (EXP. 12-31-93)

3/4/93