




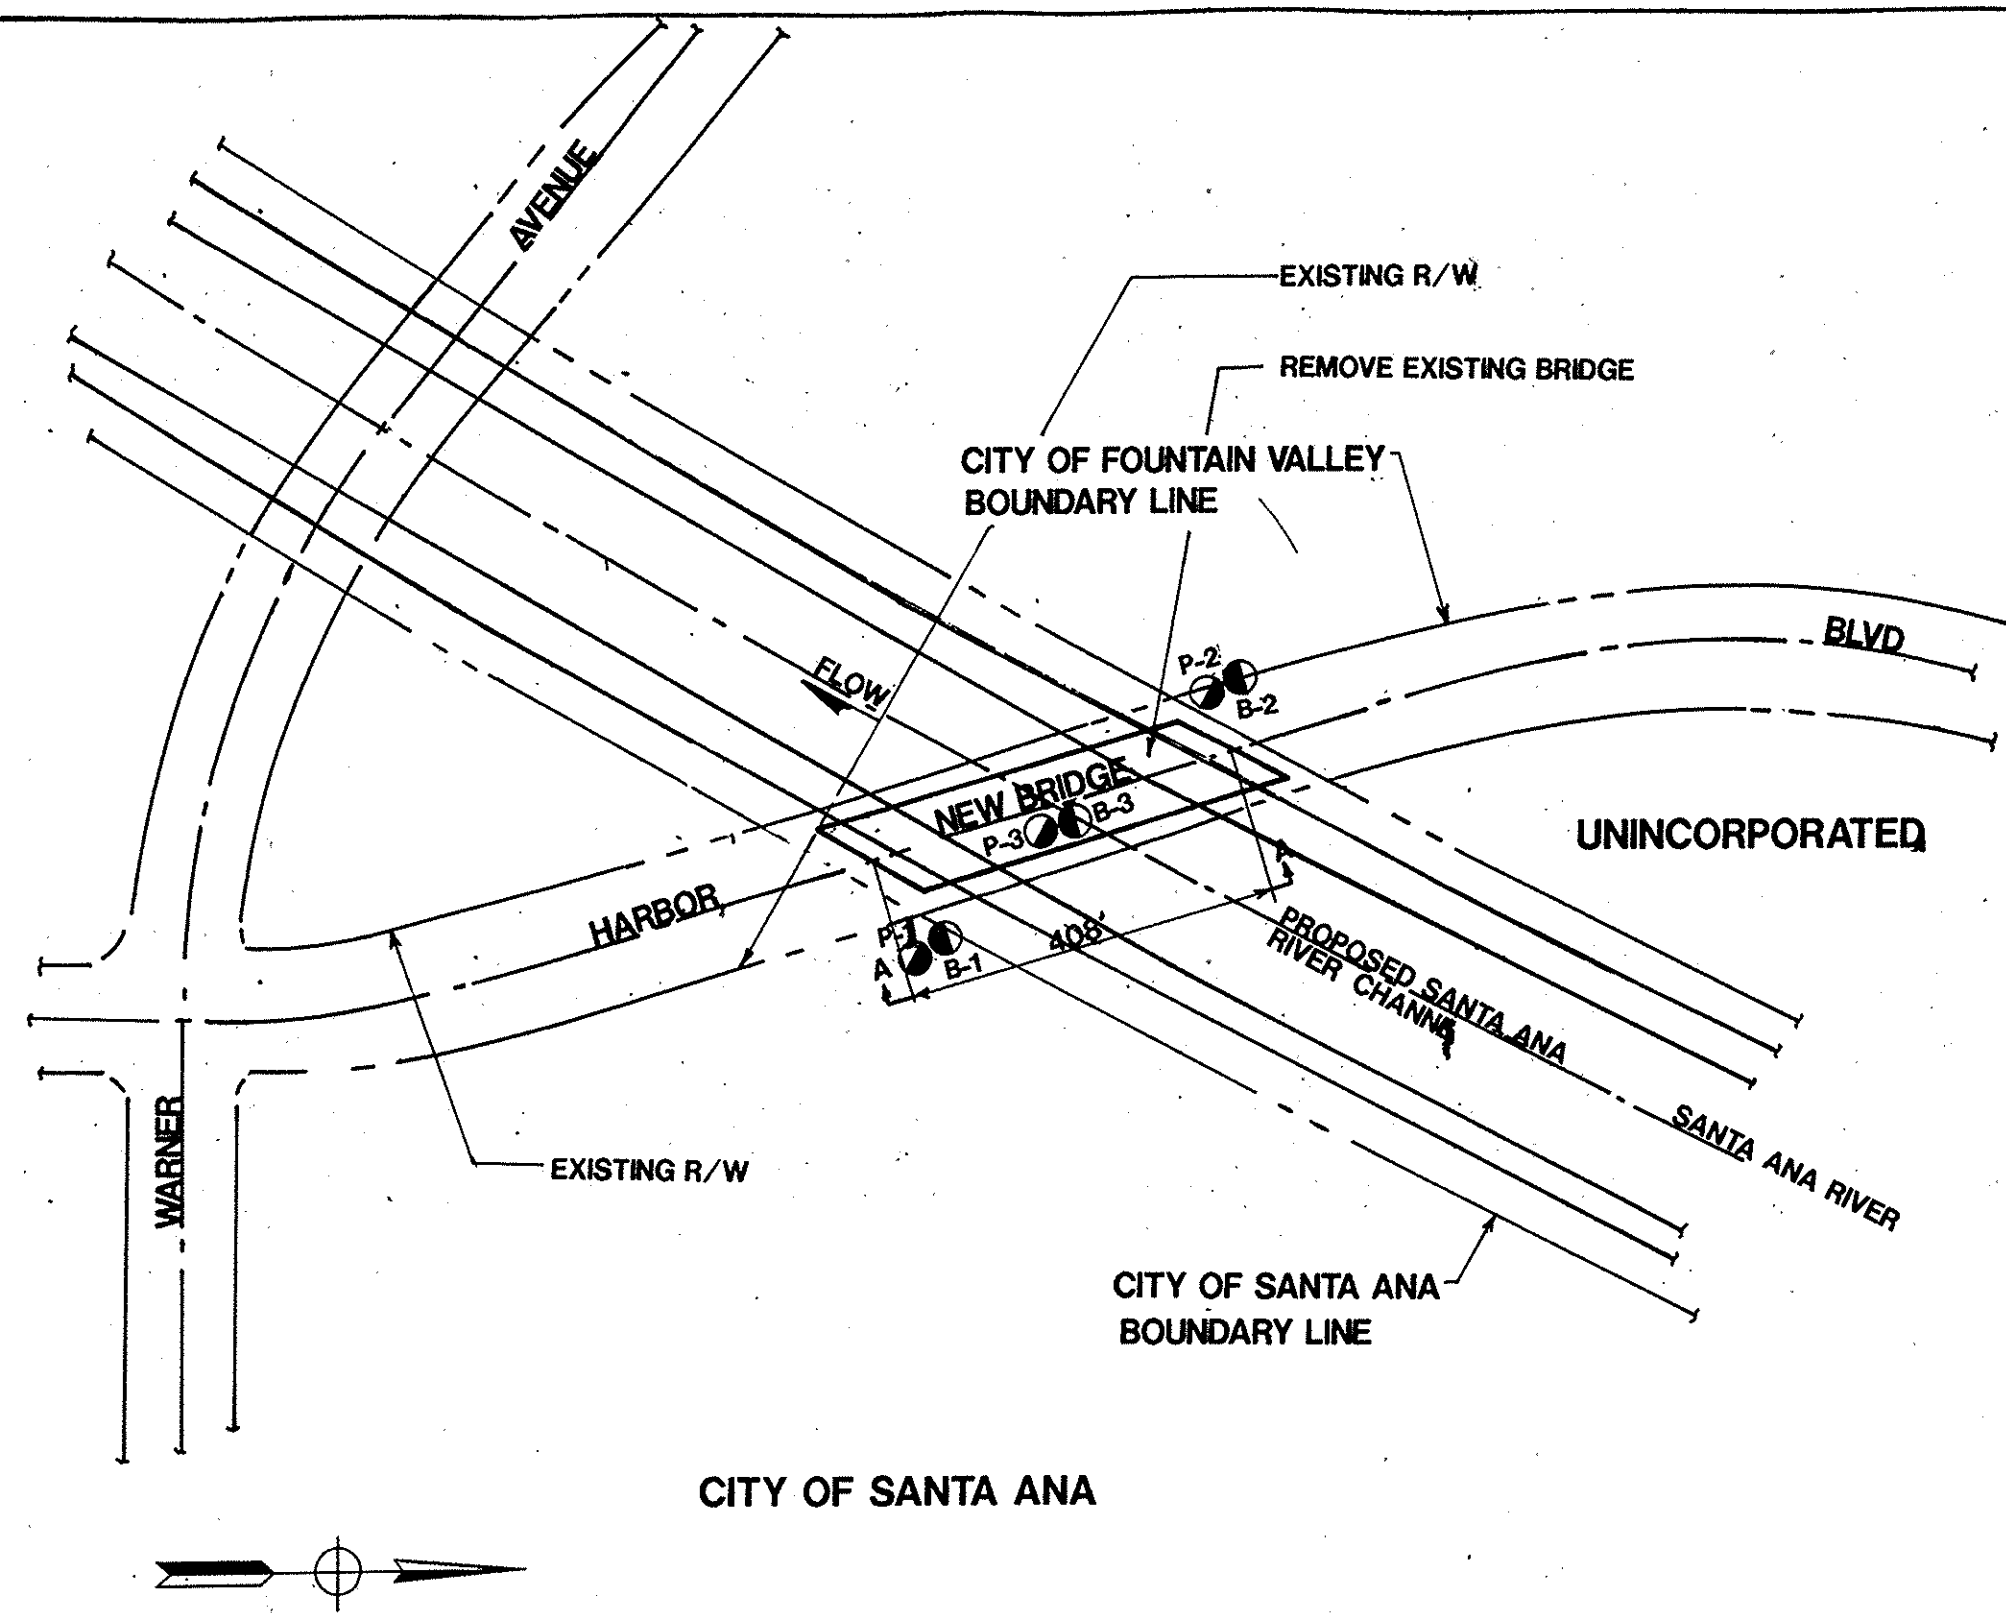


PLAN
N.T.S.

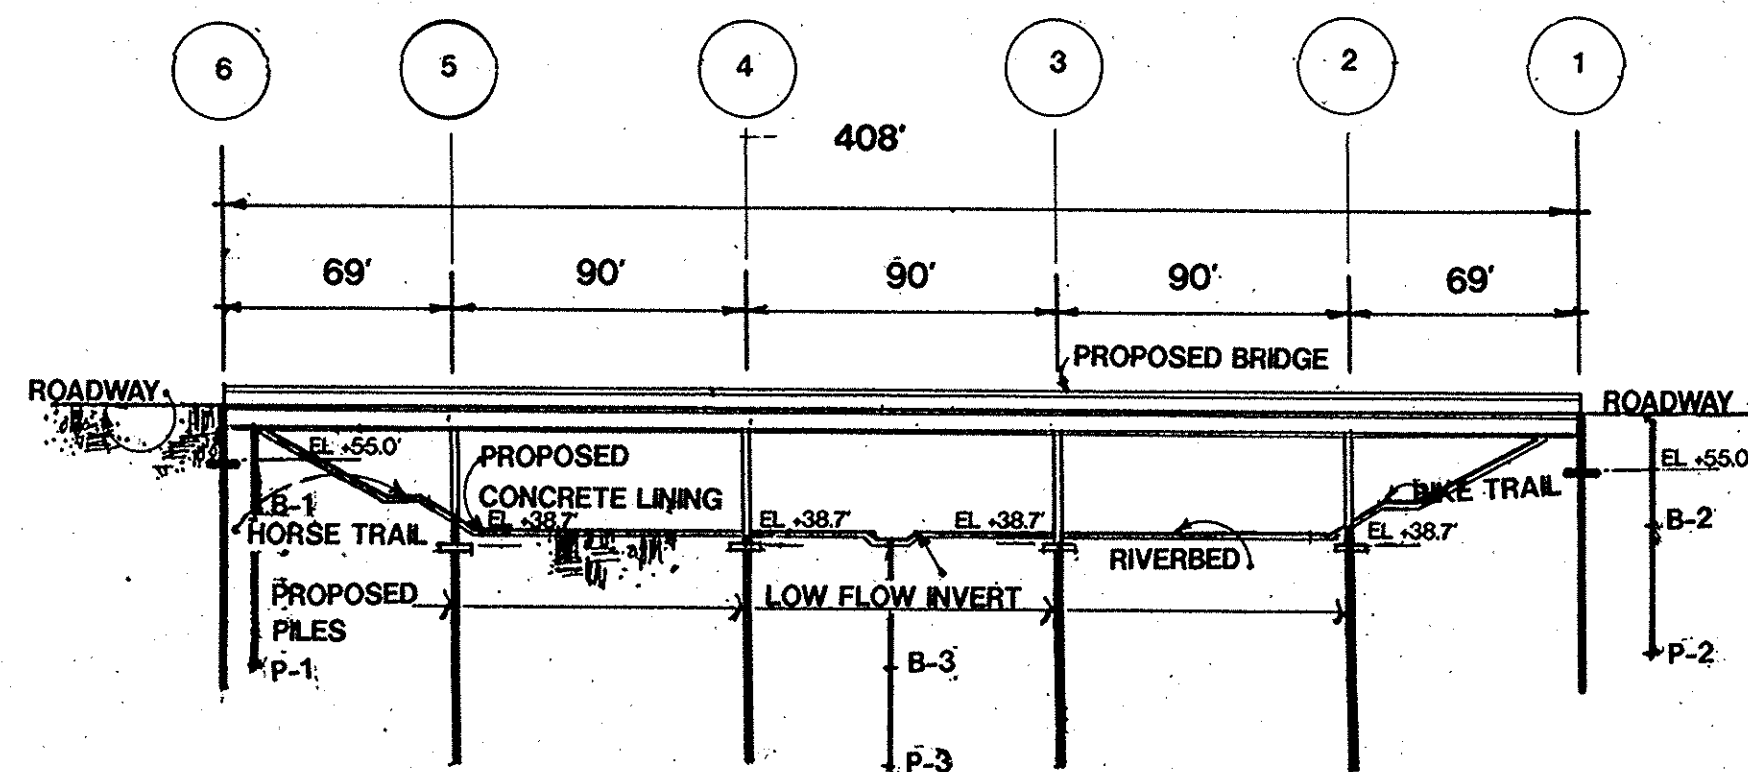

SECTION A-A
N.T.S.

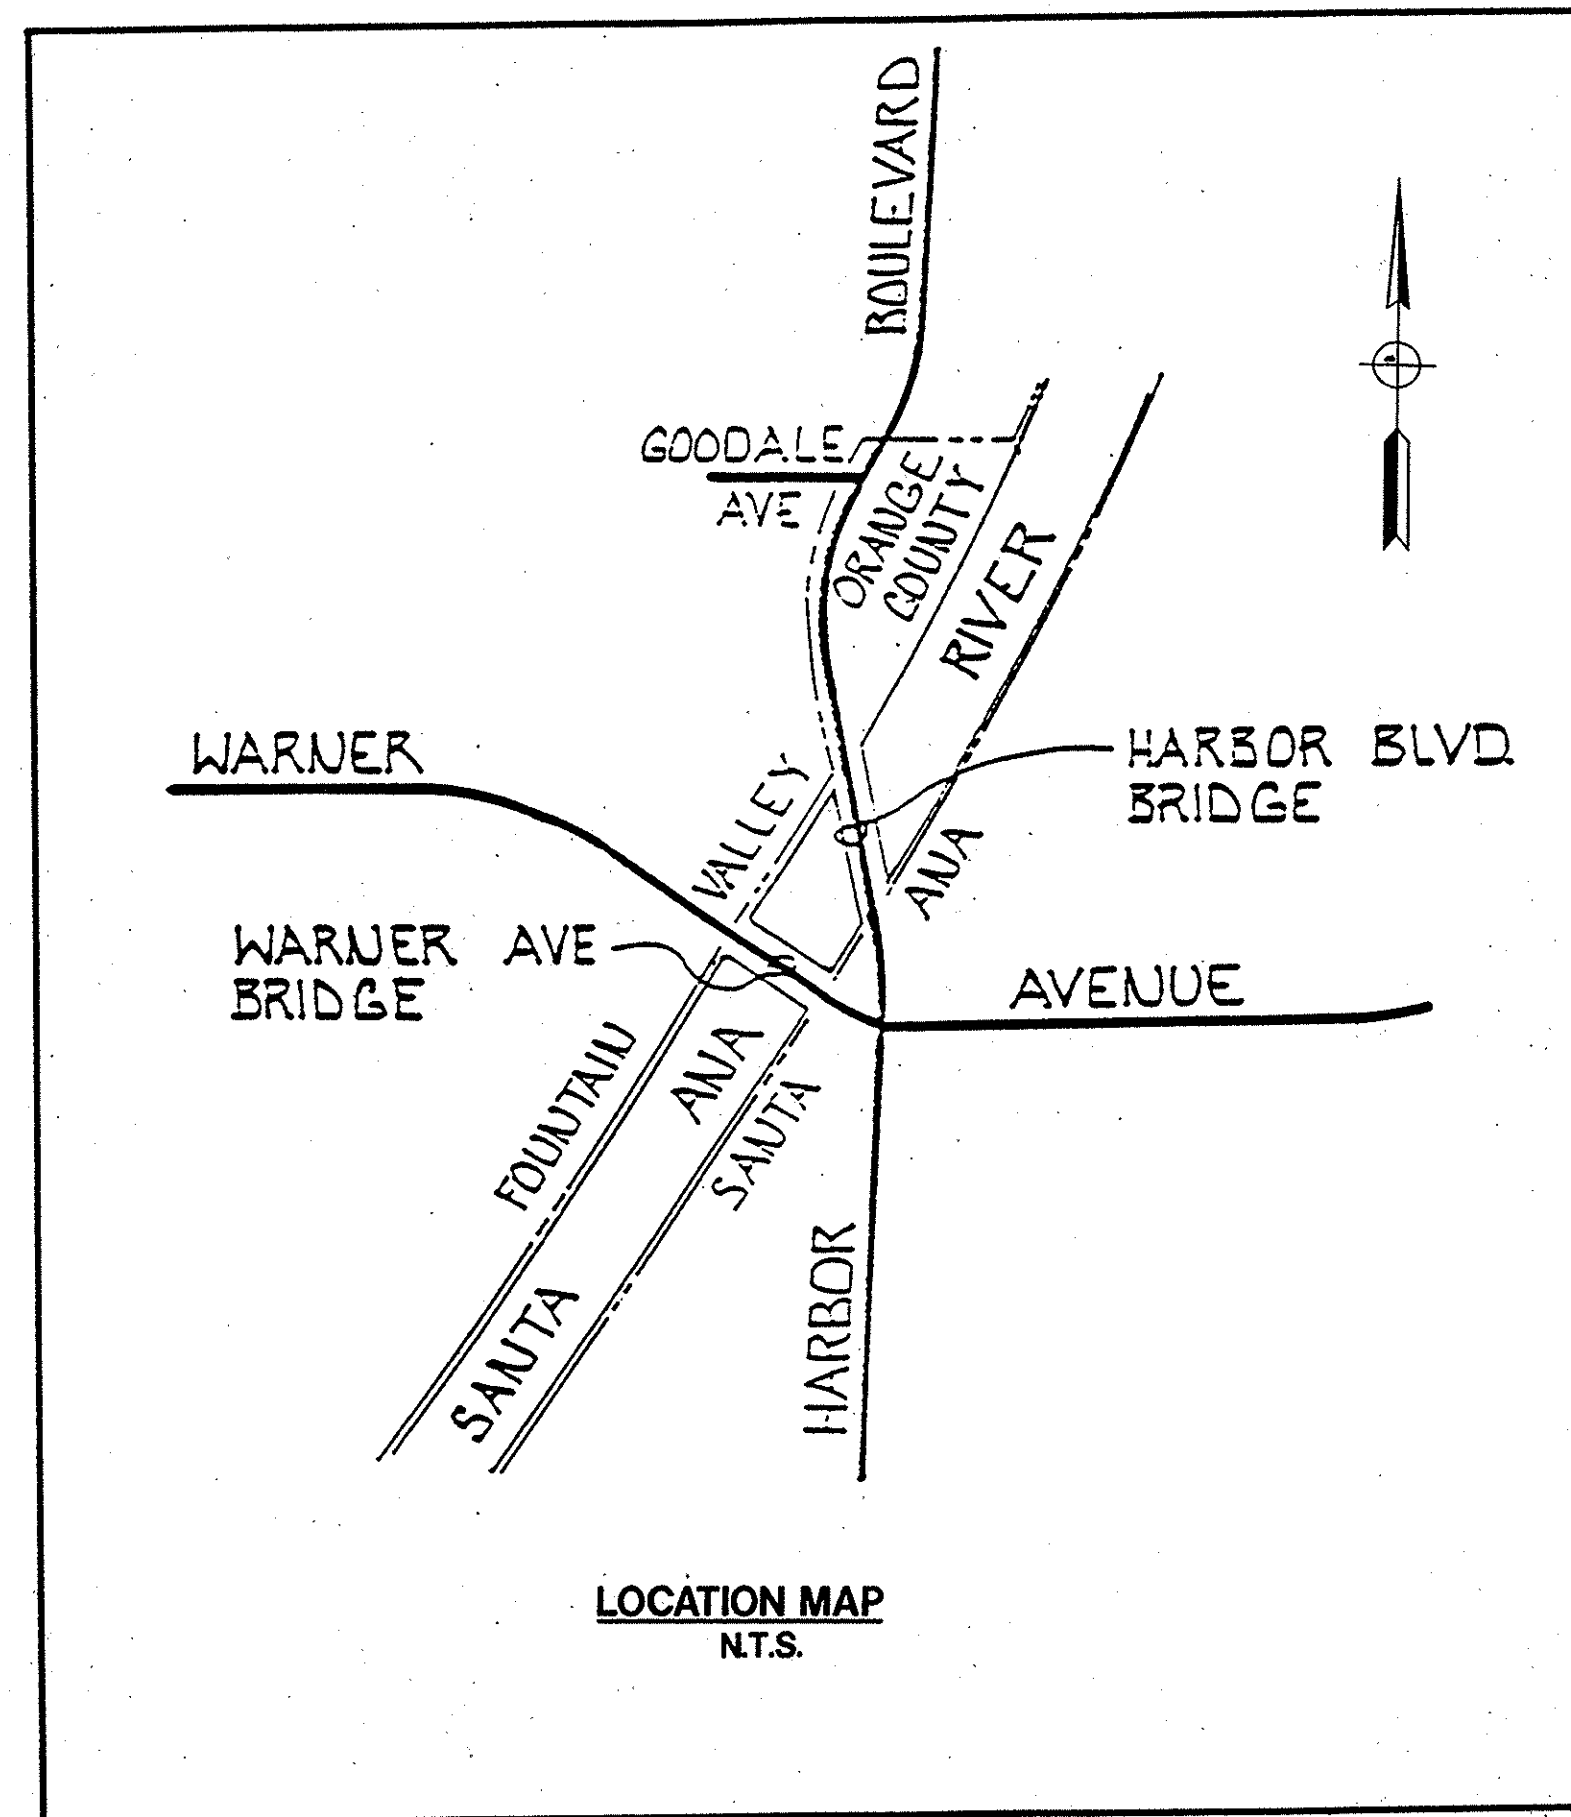



LOCATION MAP
N.T.S.

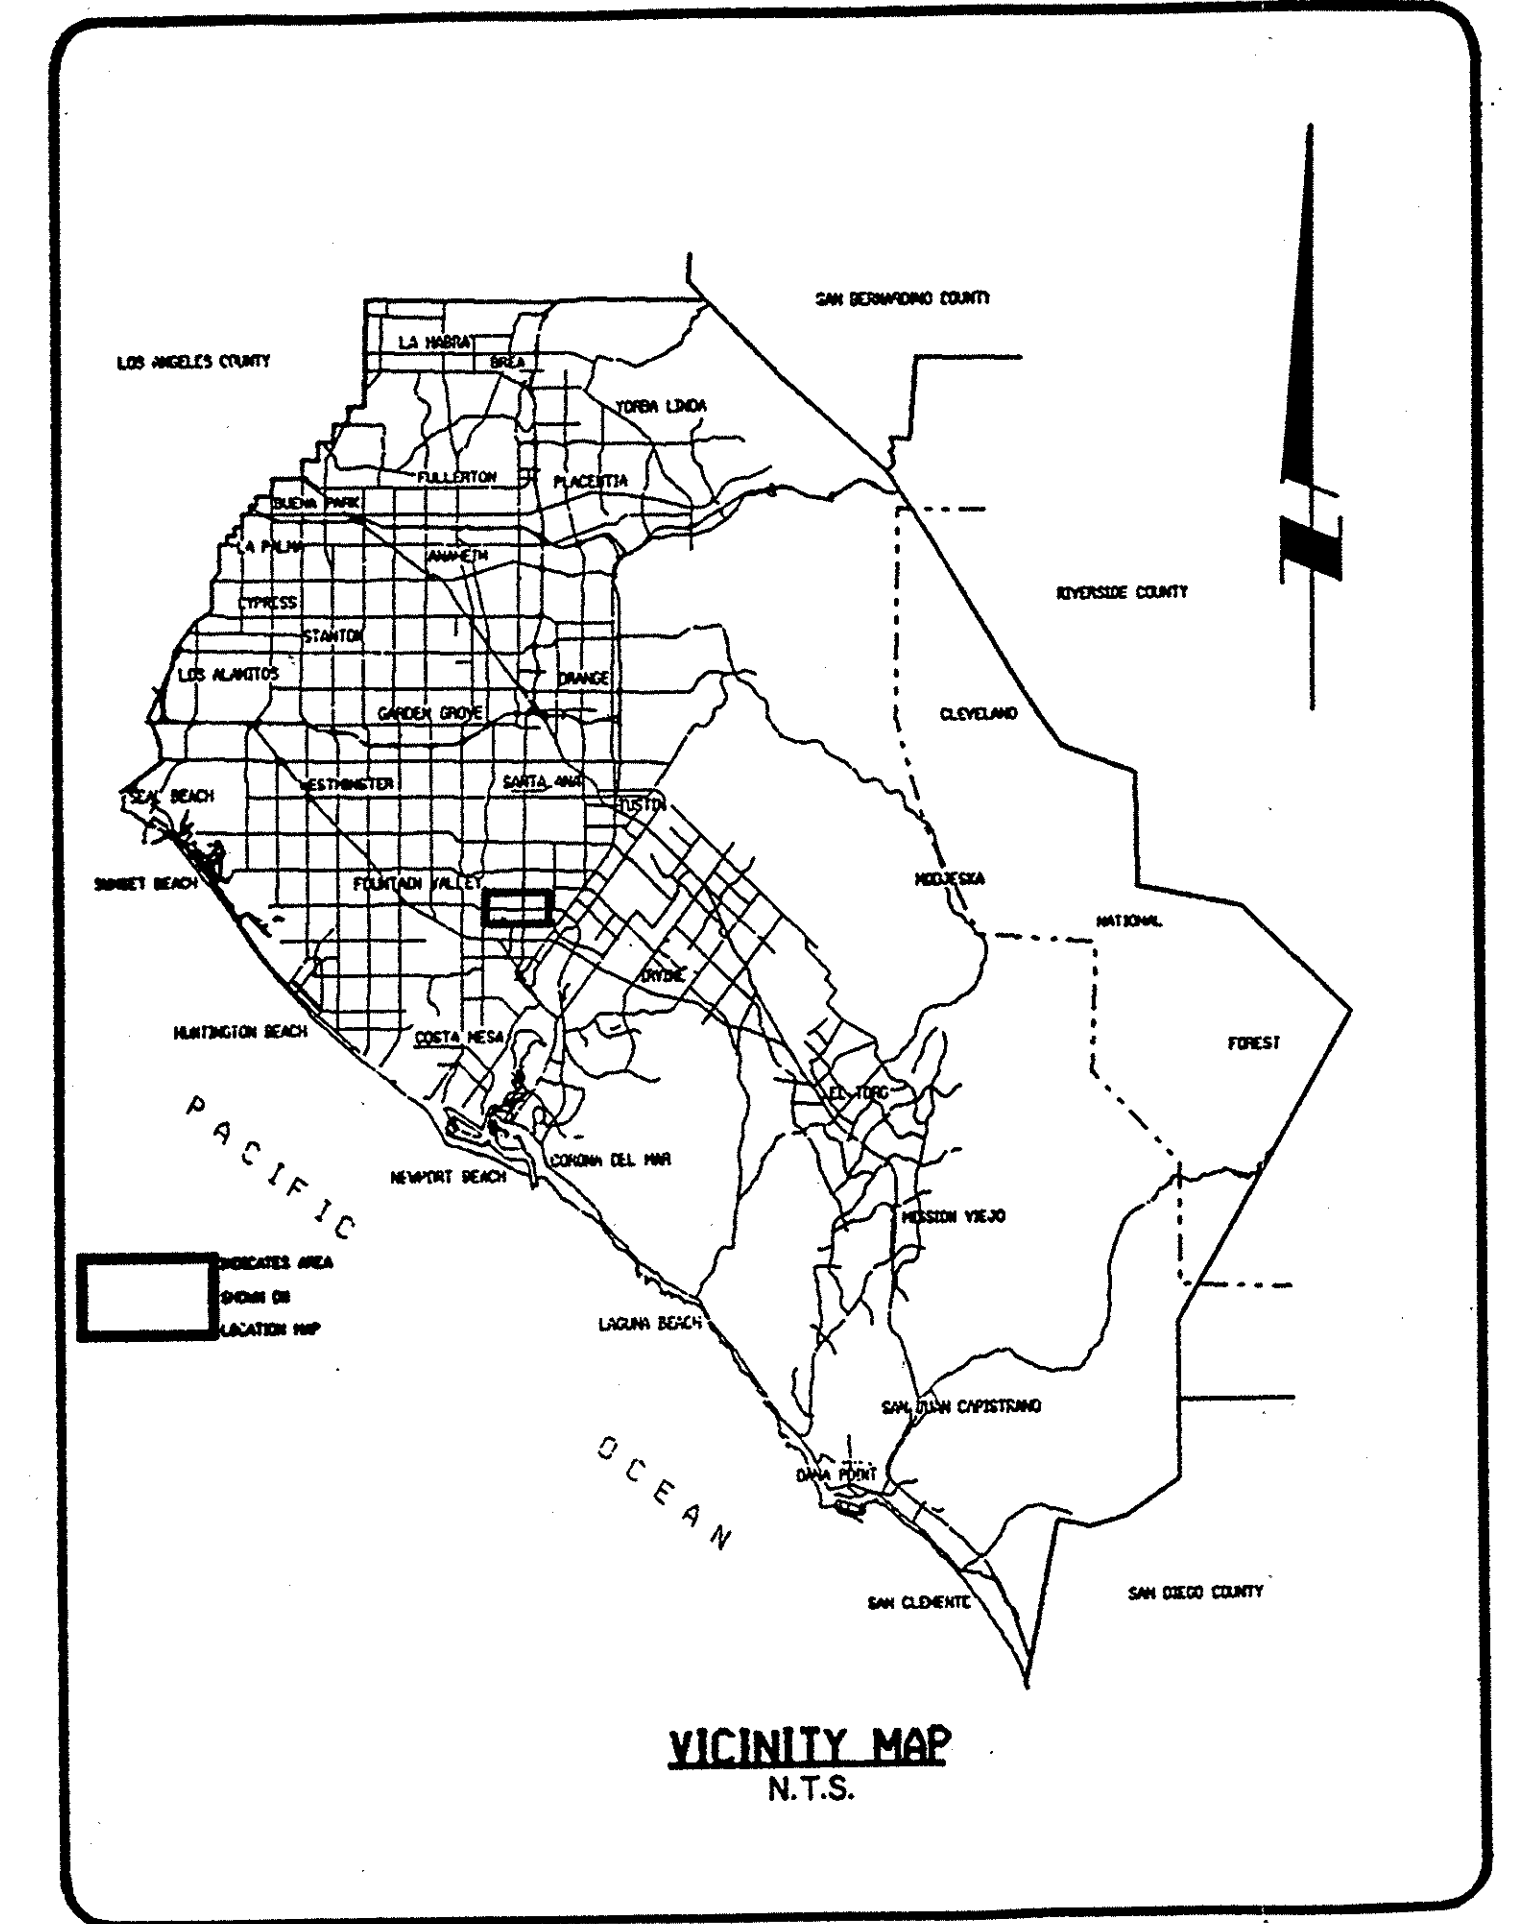

VICINITY MAP
N.T.S.

RECORD DRAWING

1 1/2 0 1 2
3 inches on original drawing

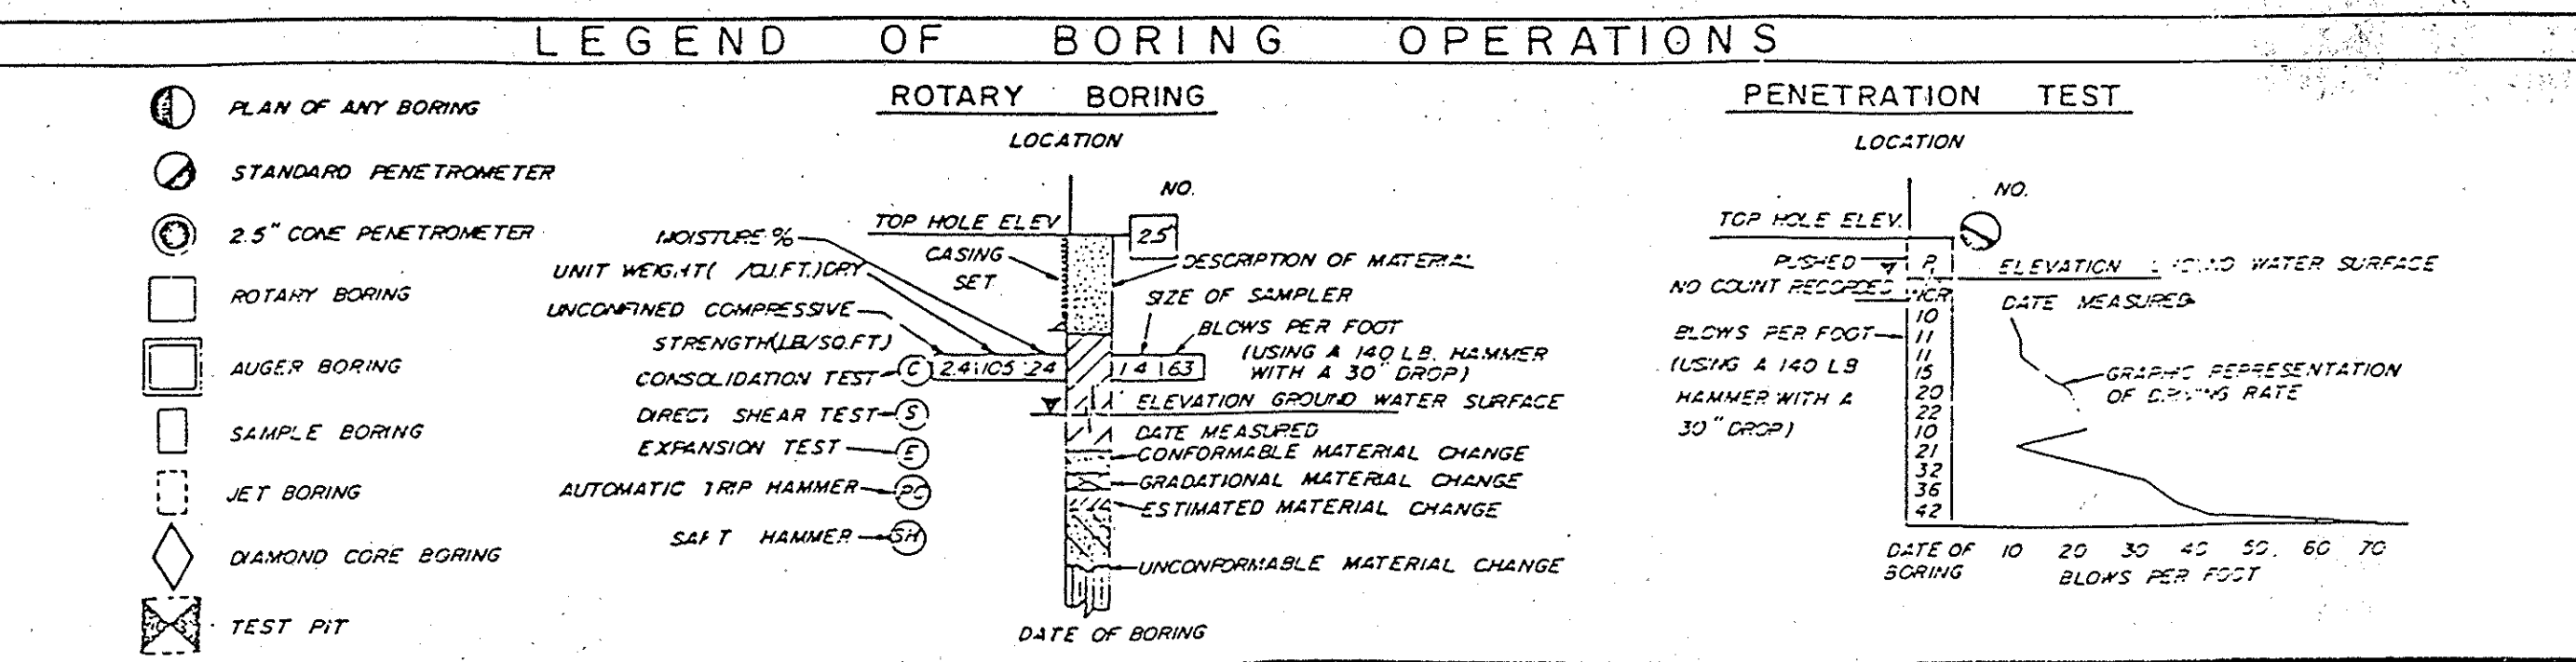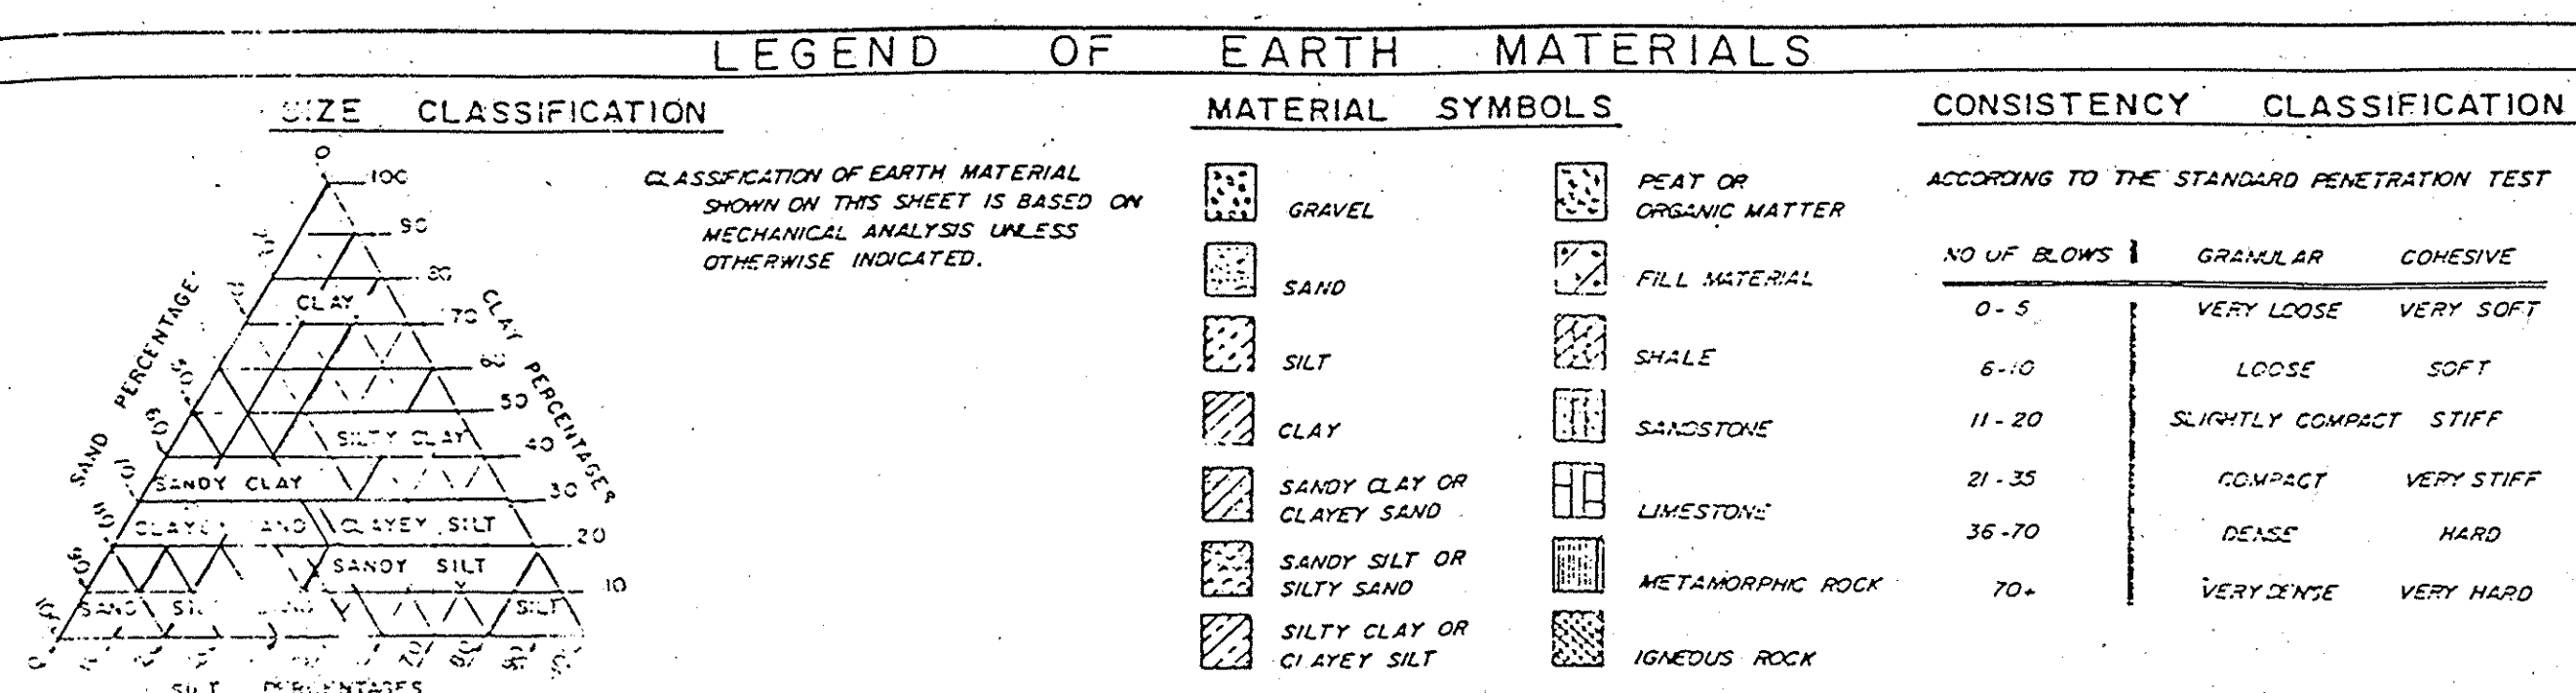

ORANGE COUNTY ENVIRONMENTAL MANAGEMENT AGENCY			
HARBOR BLVD BRIDGE AT SANTA ANA RIVER SOIL INVESTIGATION			
MARK	DATE	DESCRIPTION	PREPARED UNDER SUPERVISION OF
DESIGNED	BY	REVISIONS	DATE
DRAWN	BY	CHECKED	AS SHOWN
SCALE			DATE
DWG. NO.			30 OF 60