
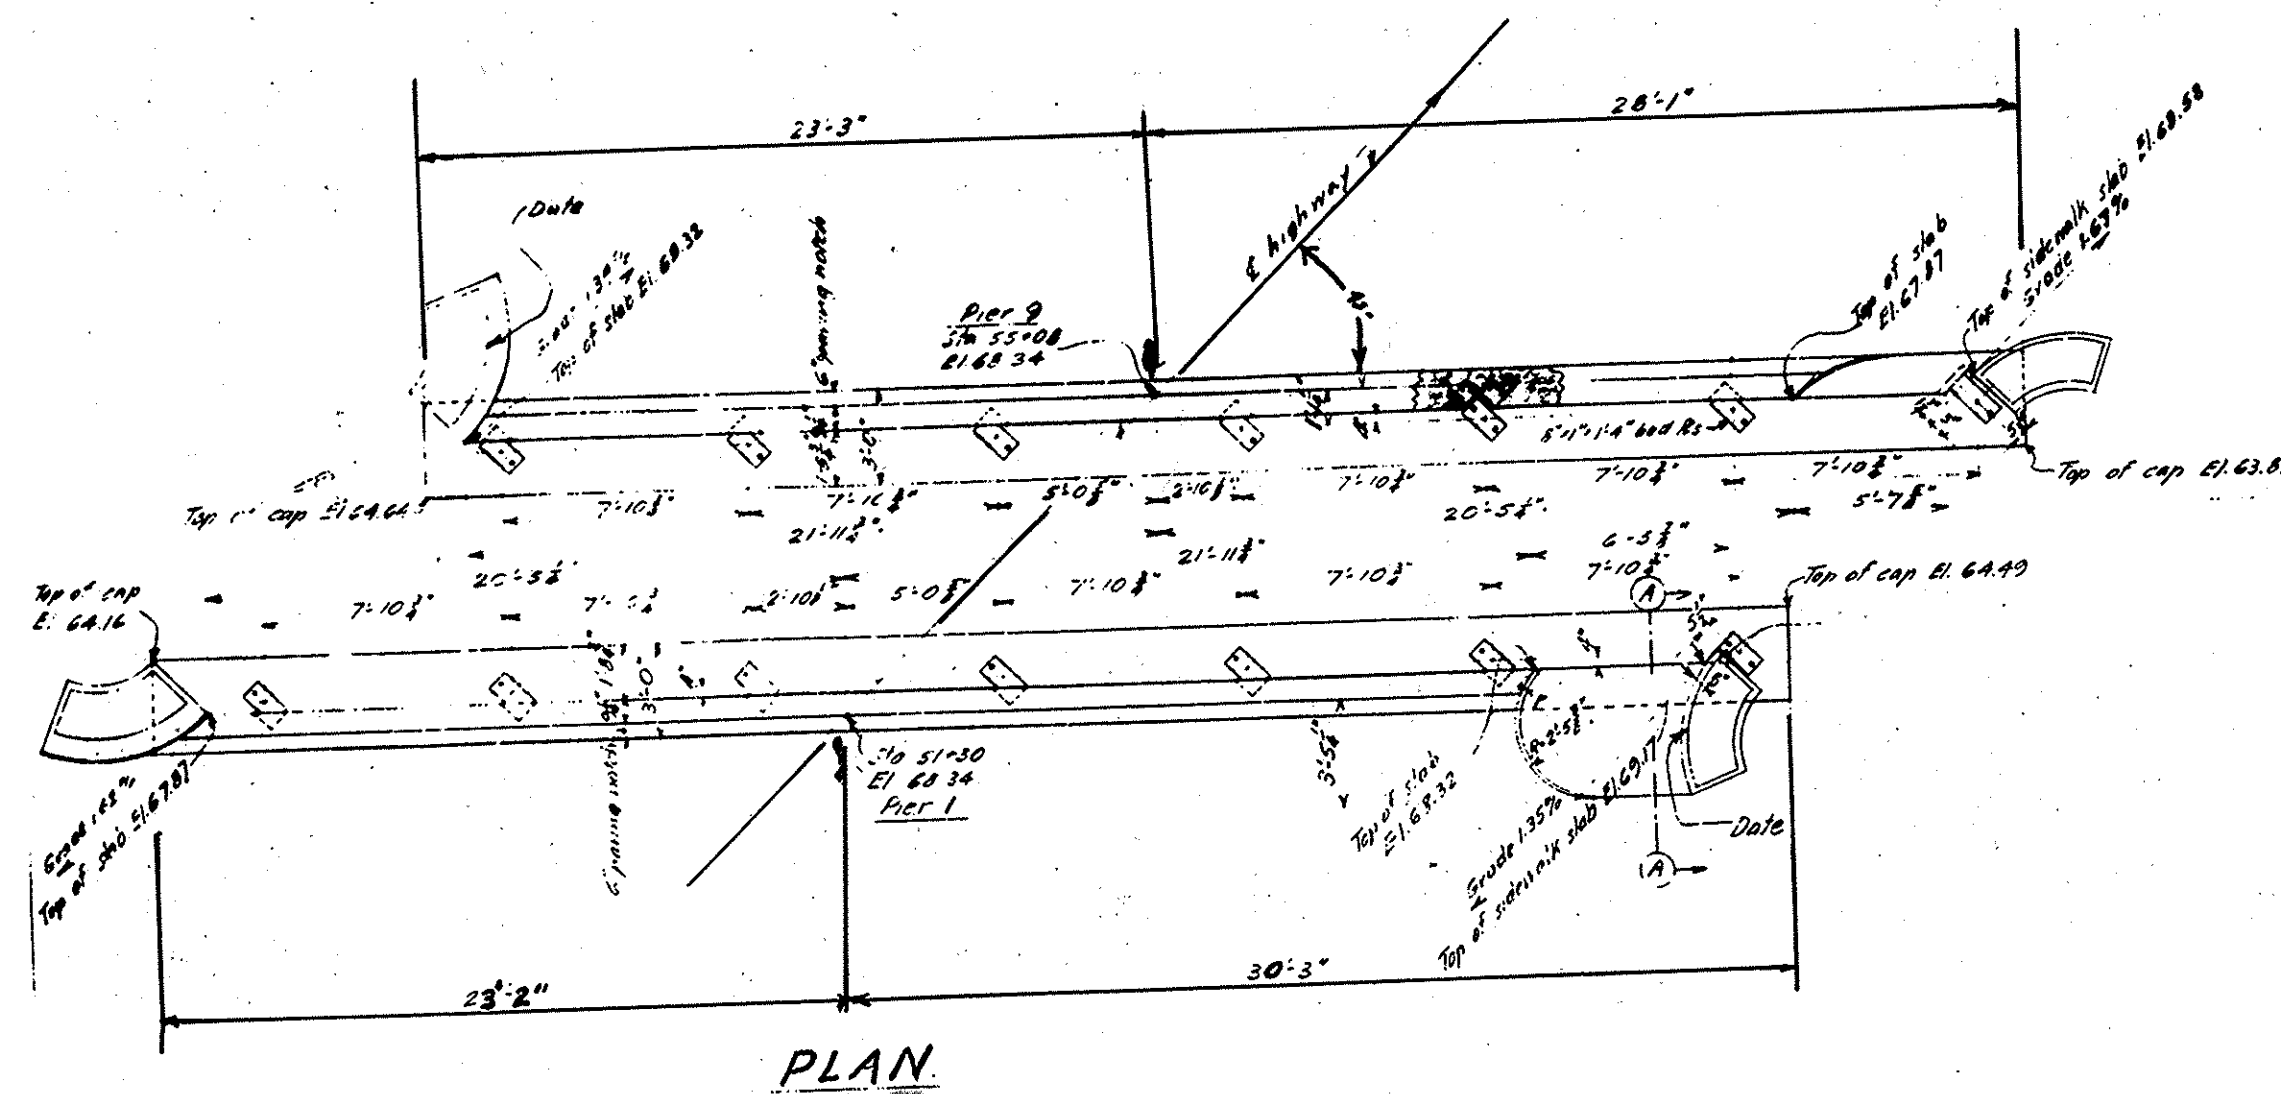
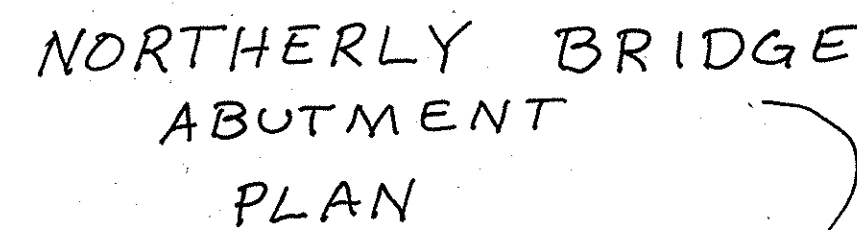
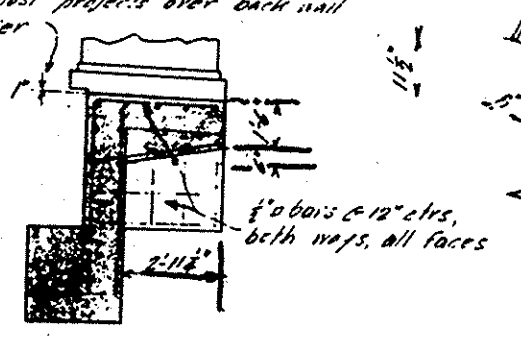
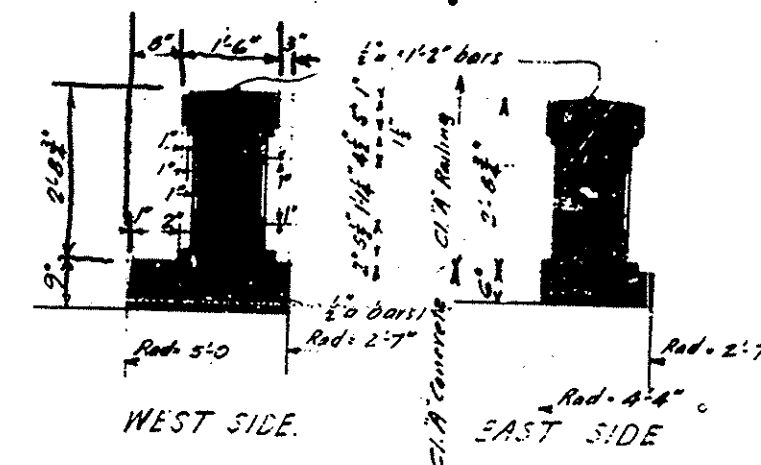
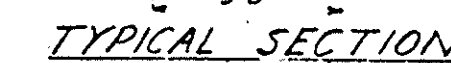
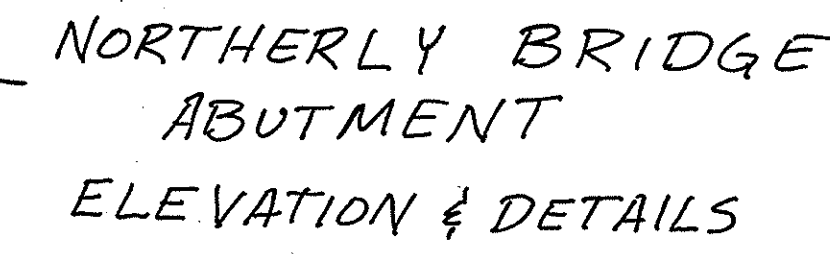


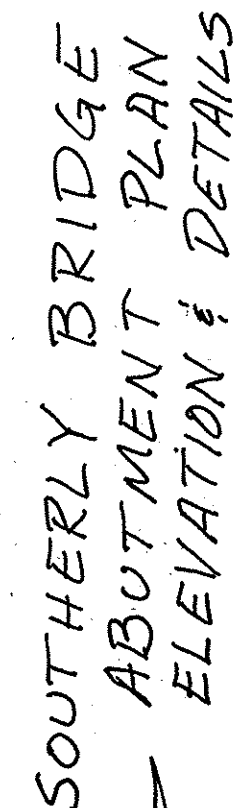

PLAN

- REMOVE ENTIRE BRIDGE ABUTMENTS, FOOTINGS, WINGWALLS, END POSTS, AND PILING DOWN TO ELEV. 48.
- THIS PLAN DEPICTS THE EXISTING BRIDGE ABUTMENTS AS REPRODUCED FROM THE MICROFILMED RECORD DRAWINGS.
- SEE SPECIAL PROVISIONS FOR PHASING OF DEMOLITION.

RECORD DRAWING

- NOT TO SCALE -



		ORANGE COUNTY ENVIRONMENTAL MANAGEMENT AGENCY	
		HARBOR BLVD. IMPROVEMENTS BRIDGE DEMOLITION PLAN	
MARK	DATE	DESCRIPTION	PREPARED UNDER SUPERVISION OF <i>RCE</i> 3/93
REVISIONS			SHEET 33 OF 60
DESIGN	SCALE	DATE	EXP. <i>Richard A. H...</i> No. 39595 DATE 3/93 STATE OF CALIFORNIA DMWAL
DRAWN	CHECKED	AS SHOWN	