


DETAIL H

RAISED MEDIAN MARKING

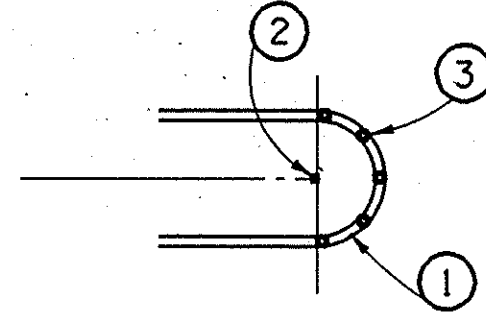

NOTES - DETAIL H


- 1 PAINT MEDIAN NOSE WITH HIGHLY REFLECTIVE PREMIXED WHITE TRAFFIC PAINT WITH GLASS BEADS.
- 2 INSTALL FLEXIBLE VERTICAL TYPE K MARKER, R7, R10 OR TYPE N1 ON TELESAR POST AS INDICATED ON PLAN.
- 3 INSTALL YELLOW REFLECTIVE PAVEMENT MARKERS ON TOP SURFACE OF MEDIAN CURB NOSE AT 2' C.C. SPACING (MINIMUM 5 MARKERS), PLACE REFLECTIVE SURFACE OF MARKERS PARALLEL TO C OF ROADWAY.

STRIPING NOTES:

- 1 PAINT
- 2 SANDBLAST MARKING AND/OR REMOVE R.P.M.'s
- 3 INSTALL
- 4 STENCIL
- 5 REMOVE
- 6 RELOCATE
- 7 PROTECT IN PLACE
- 1 4" DASH WHITE PER DETAIL 12 CALTRANS STANDARD PLANS.
- 3 4" DOUBLE YELLOW PER DETAIL 29 CALTRANS STANDARD PLANS.
- 8 8" SOLID WHITE PER DETAIL 38 CALTRANS STANDARD PLANS.
- 9 6" SOLID OR DASHED WHITE PER PLANS.
- 10 MEDIAN MARKING PER DETAIL H, SHEET 36.
- 11 12" SOLID WHITE PER PLANS.
- 13 TYPE H RPM PER DETAIL 26 CALTRANS STD. PLANS. (2" AWAY FROM WALL, ONEWAY YELLOW REFLECTIVE ON PAVEMENT) BOTH SIDES

NOTE:

Any conflicting striping or markings shall be removed by contractor.

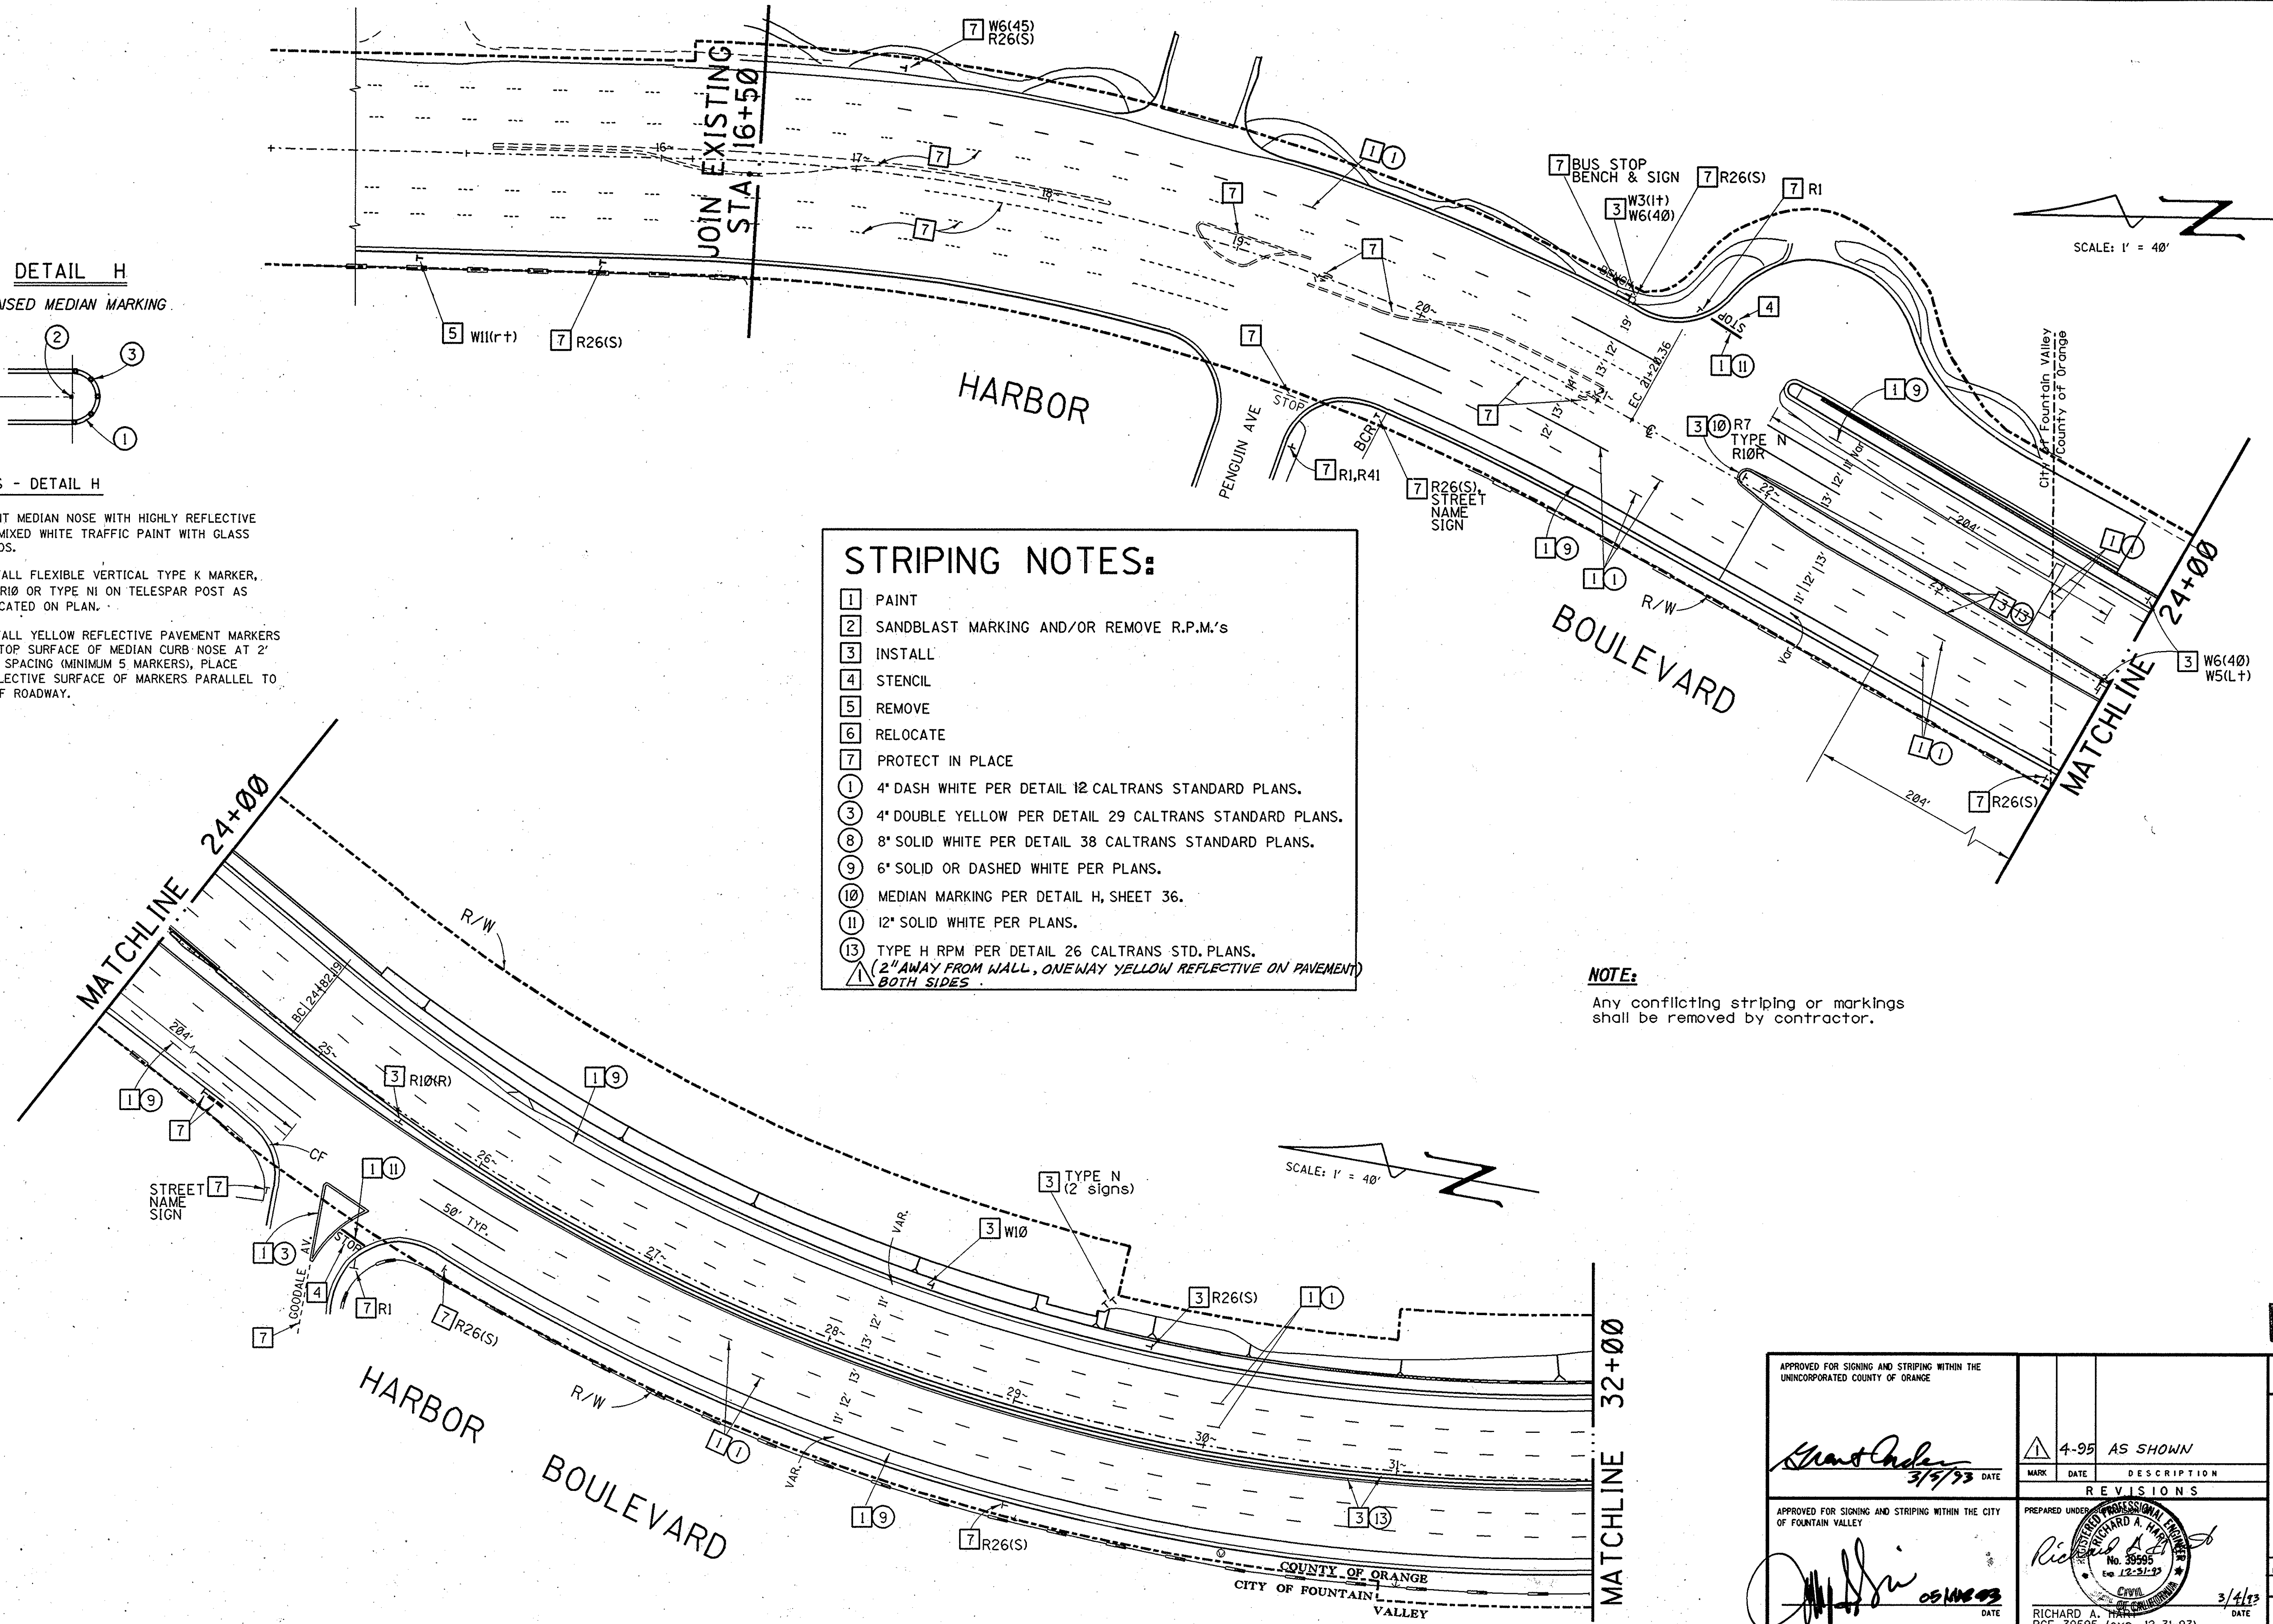

RECORD DRAWING

APPROVED FOR SIGNING AND STRIPING WITHIN THE UNINCORPORATED COUNTY OF ORANGE		 3/5/93 DATE		4-95 AS SHOWN MARK DATE DESCRIPTION	
APPROVED FOR SIGNING AND STRIPING WITHIN THE CITY OF FOUNTAIN VALLEY		 3/4/93 DATE		PREPARED UNDER RICHARD A. HART RCE 39595 (exp. 12-31-93)	
ORANGE COUNTY ENVIRONMENTAL MANAGEMENT AGENCY HARBOR BLVD. IMPROVEMENTS SIGNING AND STRIPING STA. 16+50 to STA. 32+00				DESIGNED R. HART DRAWN NMM SCALE AS SHOWN DATE MAR '93	
SHEET 36 OF 60				CHECKED GOA DRAWING NO.	