


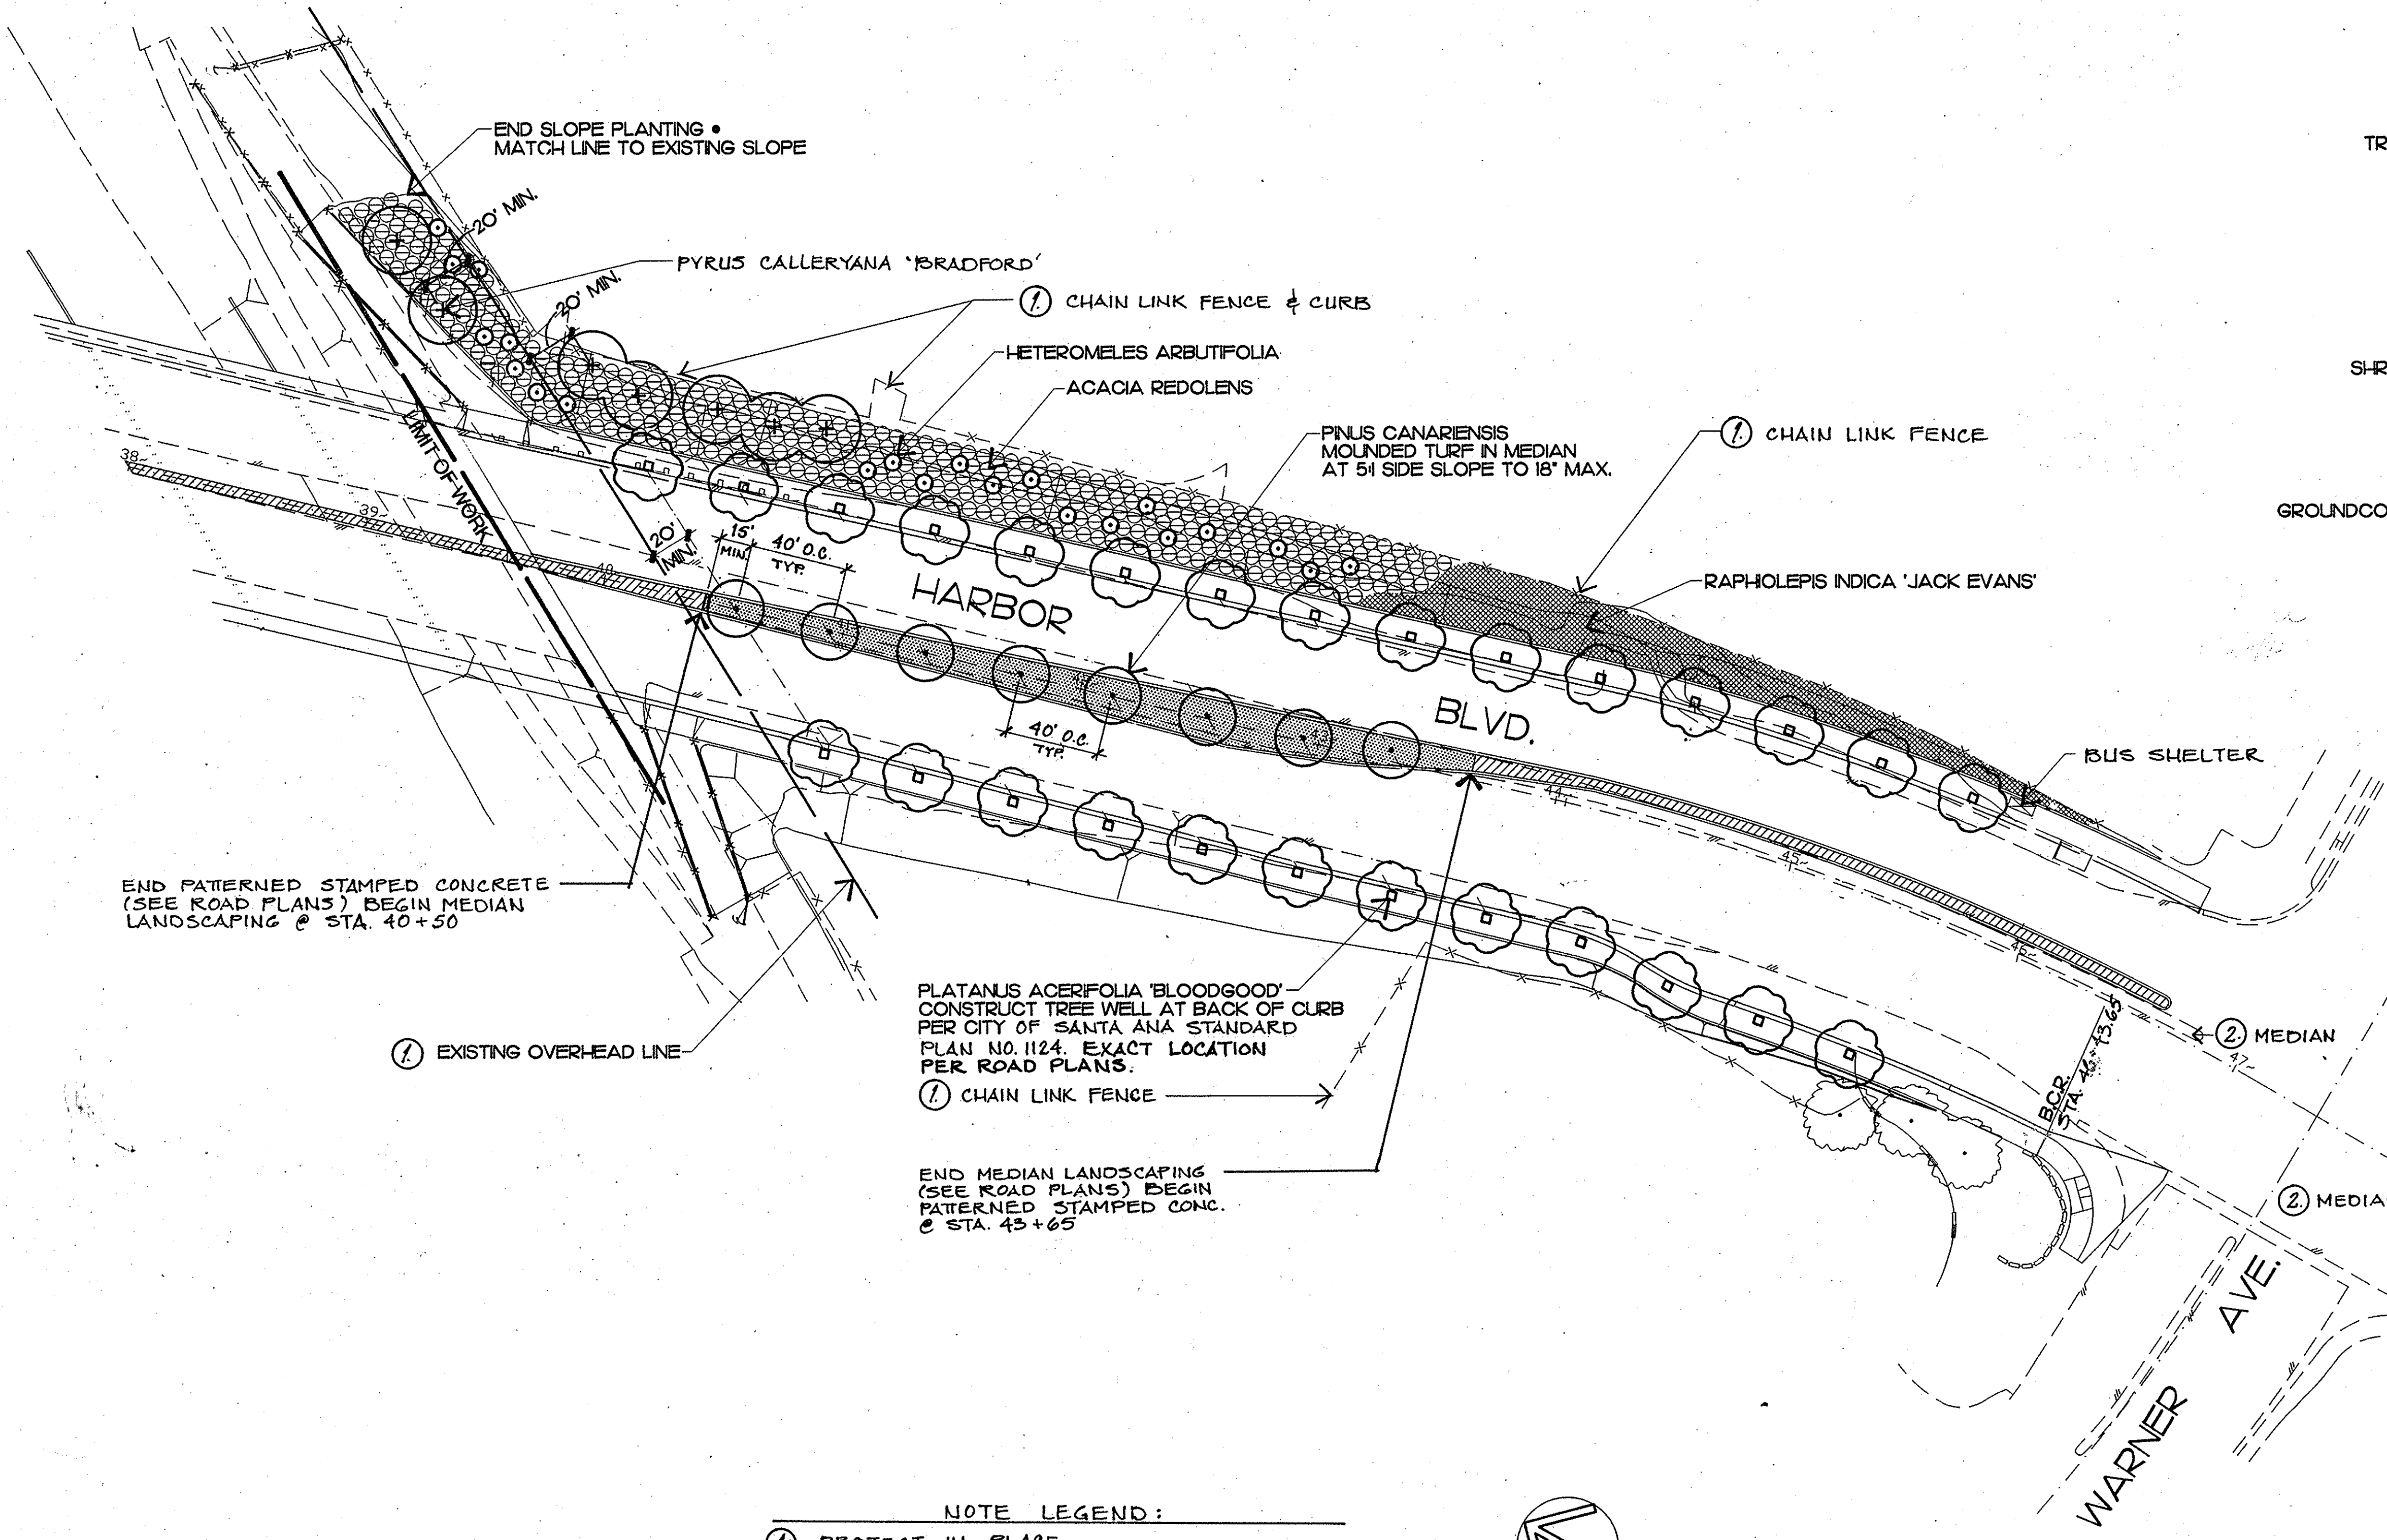

PLANT LEGEND:				
SYMBOL	BOTANICAL	COMMON	SIZE	COMMENTS
TREES	PINUS CANARIENSIS	CANARY ISLAND PINE	24" BOX	
	PYRUS CALLERYANA 'BRADFORD'	BRADFORD PEAR	15 GAL	
	PLATANUS ACERIFOLIA 'BLOODGOOD'	LONDON PLANE TREE	24" BOX	MATCHED STANDARDS
SHRUBS	ACACIA REDOLENS	NCN.	1 GAL	6'-0" O.C. (TRIANGULAR SPACING)
	HETEROMELES ARBUTIFOLIA	TOYON	5 GAL	
	RAPHOLEPIS INDICA 'JACK EVANS'	INDIA HAWTHORN	5 GAL	
GROUND COVER	FESTUCA ARUNDINACEAE 'MARATHON II'	HYBRID FESCUE		SOD
	HYDROSEED MIX			

MINIMUM PURITY/GERMINATION	MINIMUM LBS/AC	SPECIES/COMMON NAME
95	55	5.0
95	60	5.0


GAZANIA DWARF WHITE
WHITE PINE DWARF GAZANIA
ALYSSUM MARITIMA DWARF PURPLE
ROYAL CARPET ALYSSUM

TOTAL 10 LBS/AC

NOTE: MINIMUM 1% OF PURITY / GERMINATION TO SHOW LABORATORY RATE. APPLICATION RATE TO VARY WITH QUALITY OF SEED, SOIL CONDITION, WEATHERS, CAUTION DURING INSTALLATION PERIOD, AND MAINTENANCE PROGRAM.

HYDROSEED ALL SLOPES AND SHRUB AREAS

- NOTE LEGEND:
- 1 PROTECT IN PLACE
 - 2 TO BE REMOVED (SEE ROAD PLANS)

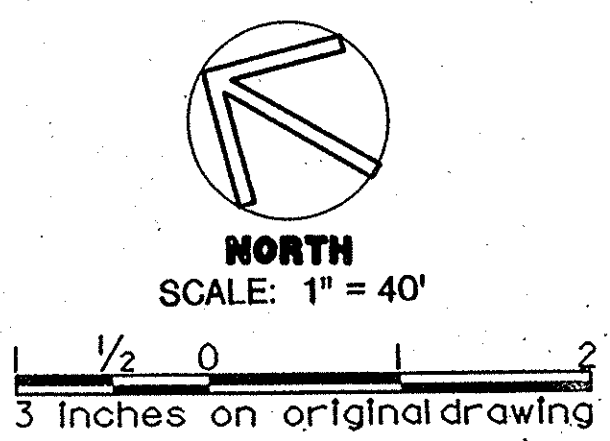

RECORD DRAWING

REVISIONS									
NUMBER	DATE	INITIALS	DESCRIPTIONS	APPRVD	NUMBER	DATE	INITIALS	DESCRIPTIONS	APPRVD

REFERENCES		PREPARED UNDER THE SUPERVISION OF	DATE
		GARY DYE	2/19/93
DESIGNED G.B.		3544 R.L.A. #12	
R/W APPROVED		DRAWN J.B./S.M.H.	
RECOMMENDED		CHECKED	
APPROVED		2/22/93	
CITY ENGINEER		4/2/93	
		R.C.E. NO. 25/61	

HARBOR BLVD. IMPROVEMENTS		PROJECT NO. 92035.00
PLANTING PLAN		
TREES, GROUND COVER & SHRUBS		
PUBLIC WORKS AGENCY		
CITY OF SANTA ANA		
SHEET 39 OF 60		
BASE-1.DWG		