


NORTH
SCALE: 1" = 40'

1 1/2 0 1 2
3 inches on original drawing

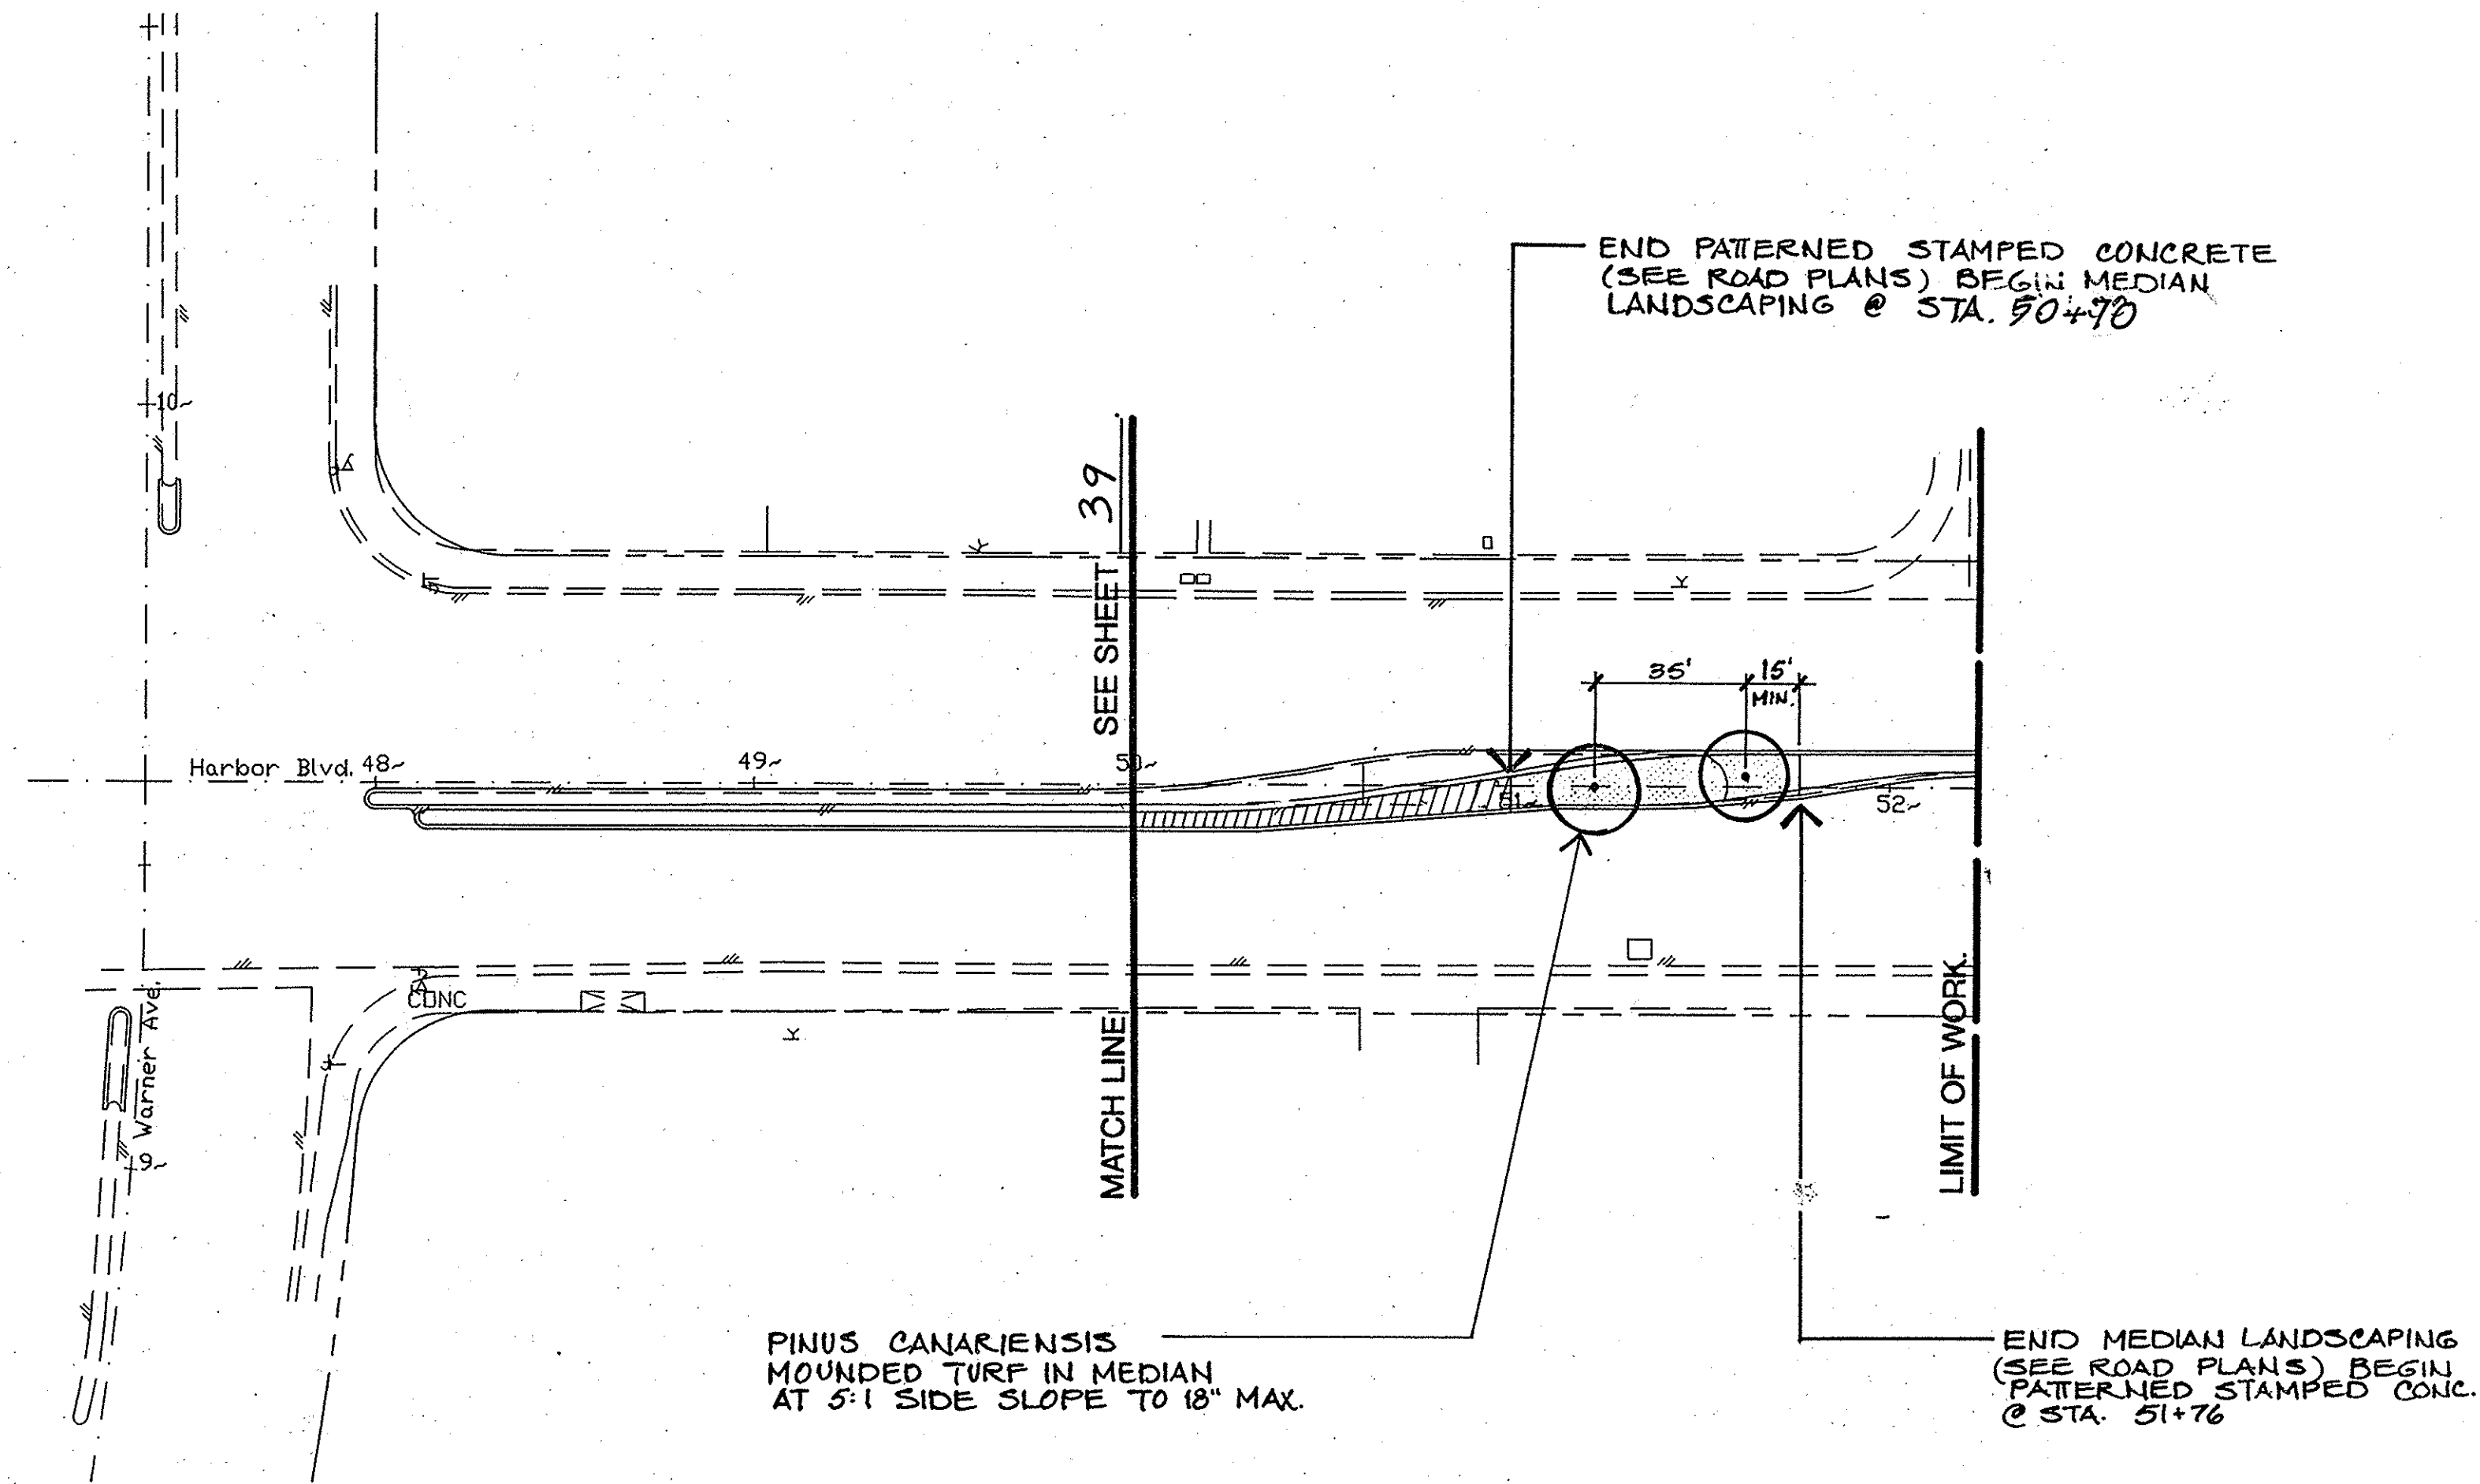

RECORD DRAWING

FILE NO.	REVISIONS										REFERENCES	PREPARED UNDER THE SUPERVISION OF		DATE	HARBOR BLVD IMPROVEMENTS PLANTING PLAN TREES, GROUNDCOVER & SHRUBS
	NUMBER	DATE	INITIALS	DESCRIPTIONS	APPRVD	NUMBER	DATE	INITIALS	DESCRIPTIONS	APPRVD		GARY B YE 3544 R.L.A. NO	2/19/93		
												DESIGNED G.B.	DRAWN J.C./S.M.		
												R/W APPROVED	CHECKED BB		
												RECOMMENDED J. J. J.		2/22/93	
												APPROVED			
													Benj. Whay CITY ENGINEER	R.C.E. NO. 25761	
PUBLIC WORKS AGENCY CITY OF SANTA ANA															SHEET 40 OF 60

PUBLIC WORKS AGENCY
CITY OF SANTA ANA

SHEET 40 of 60
BASE-1.DWG