


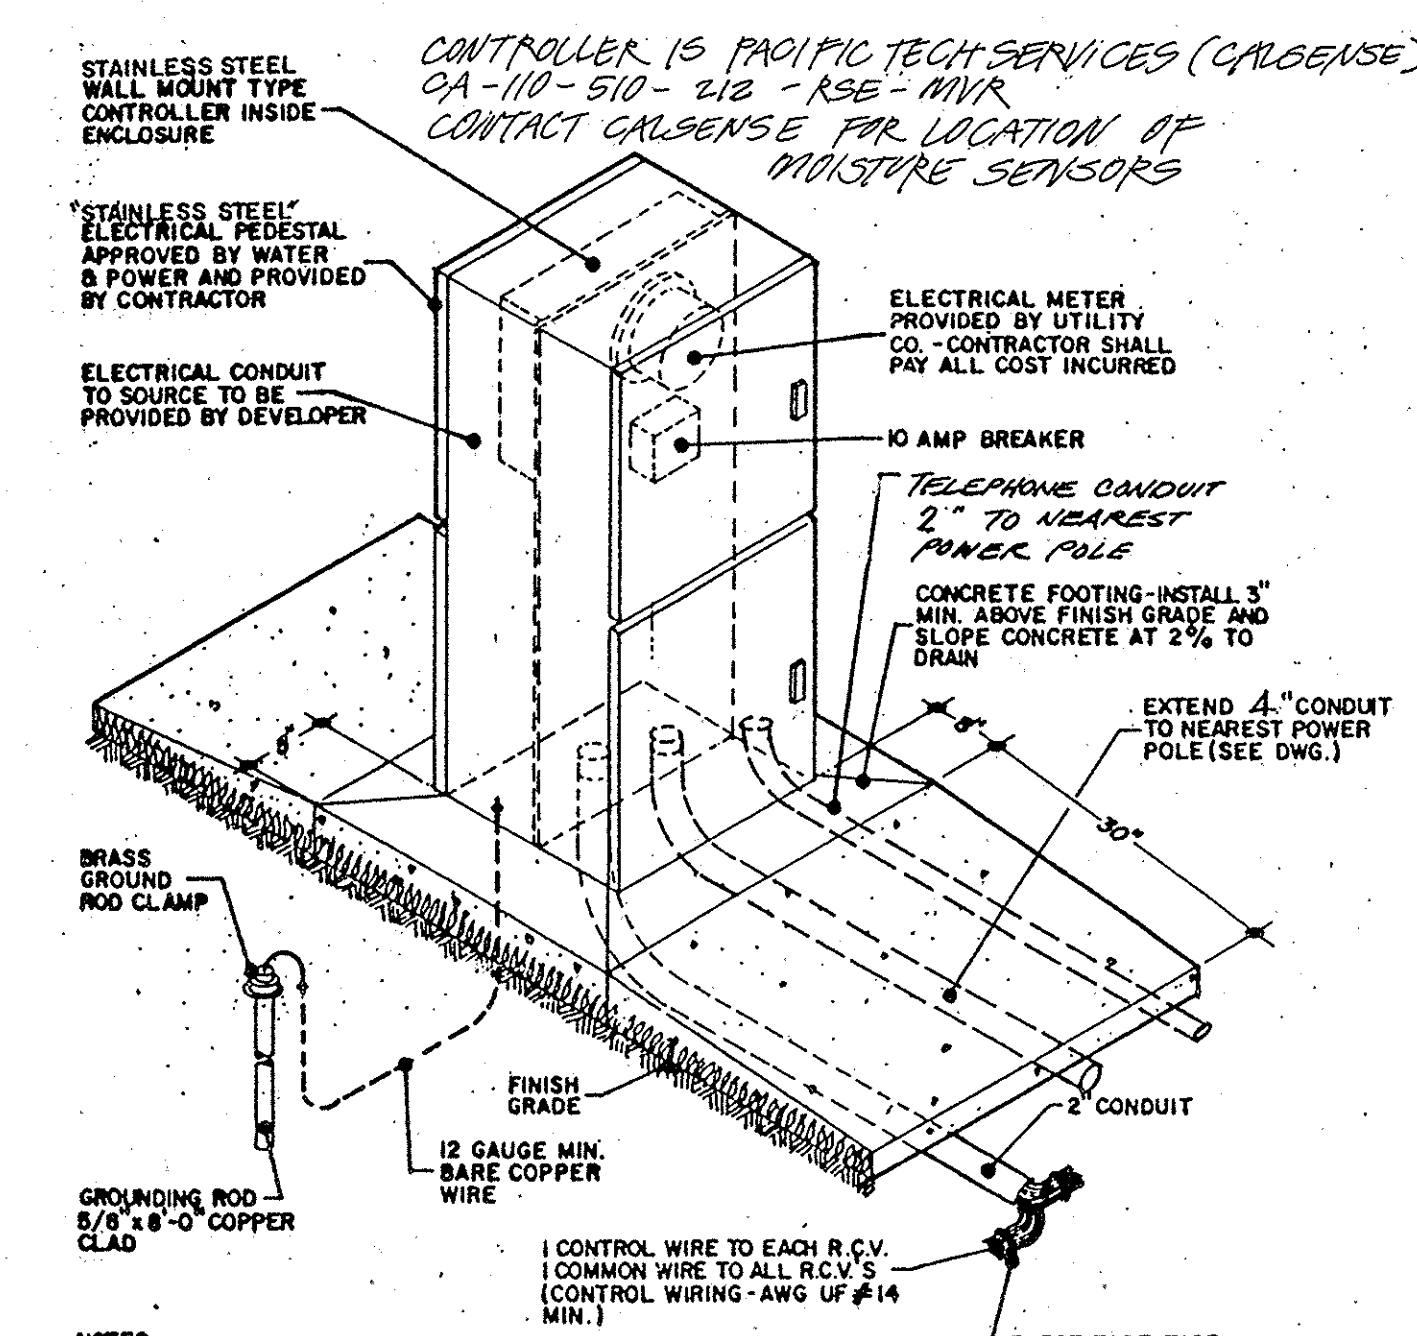


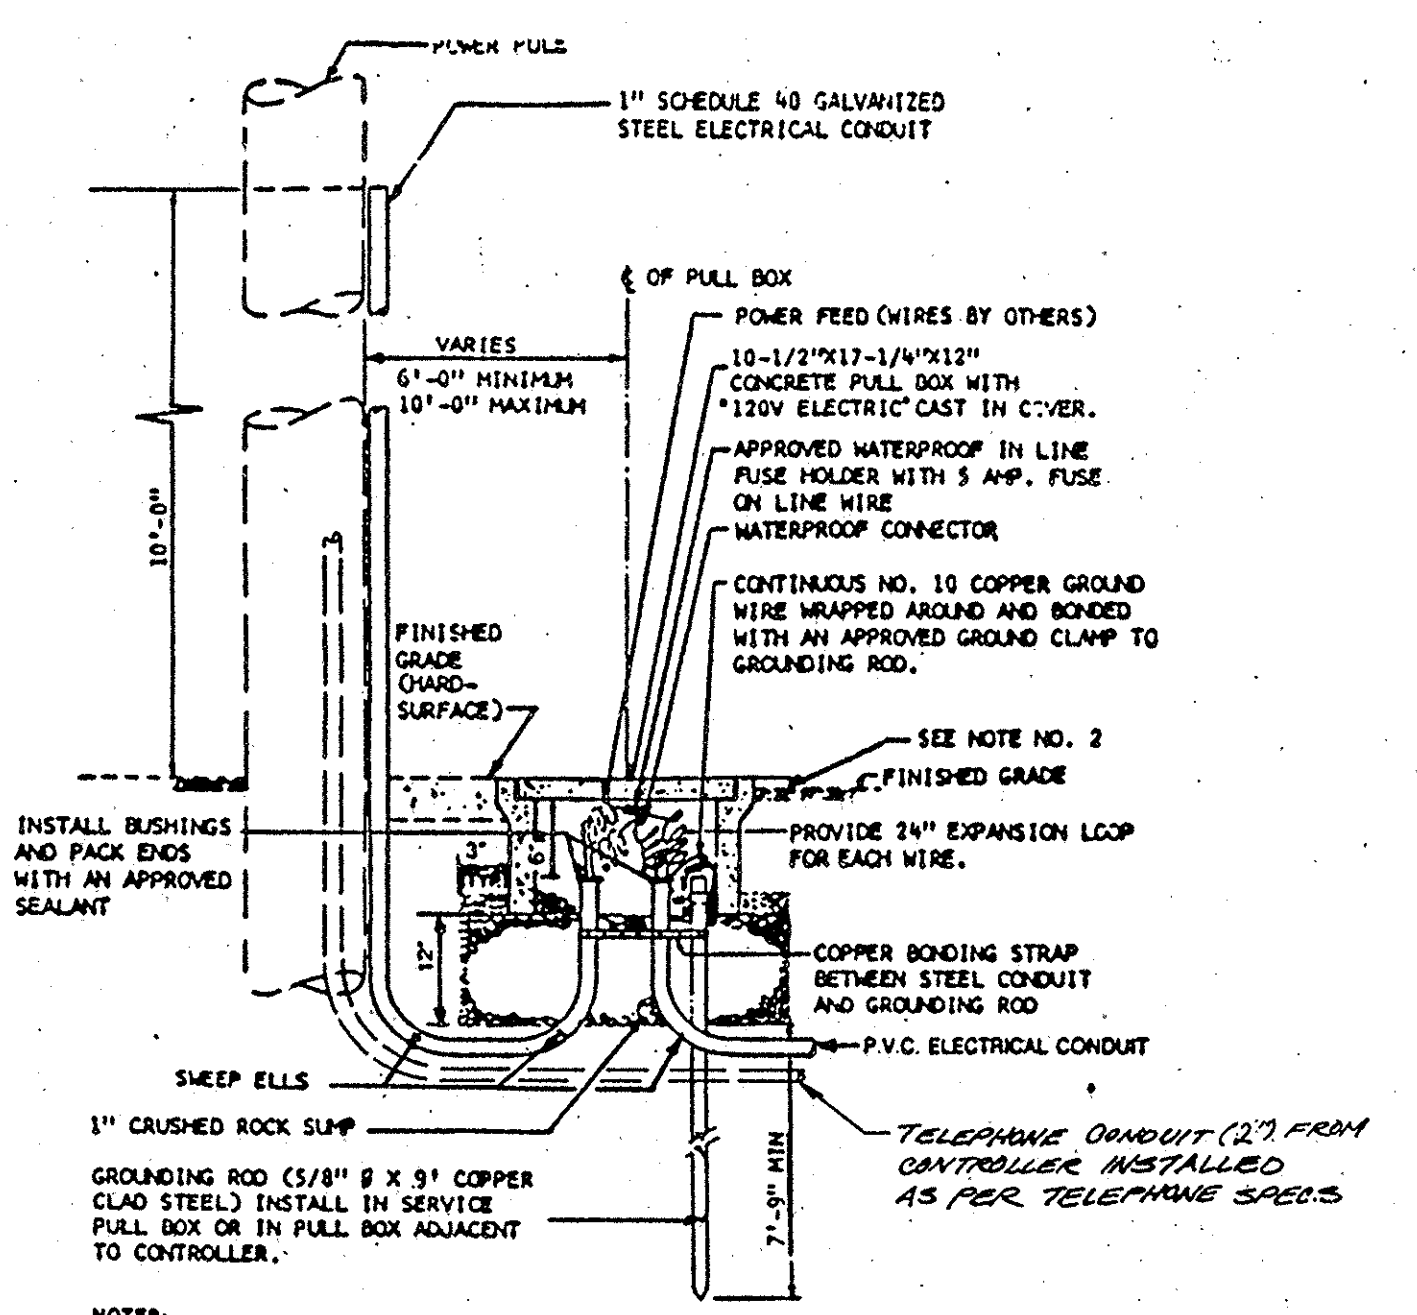


1 TYPICAL ELECTRICAL METER & CONTROLLER ASSEMBLY
NO SCALE

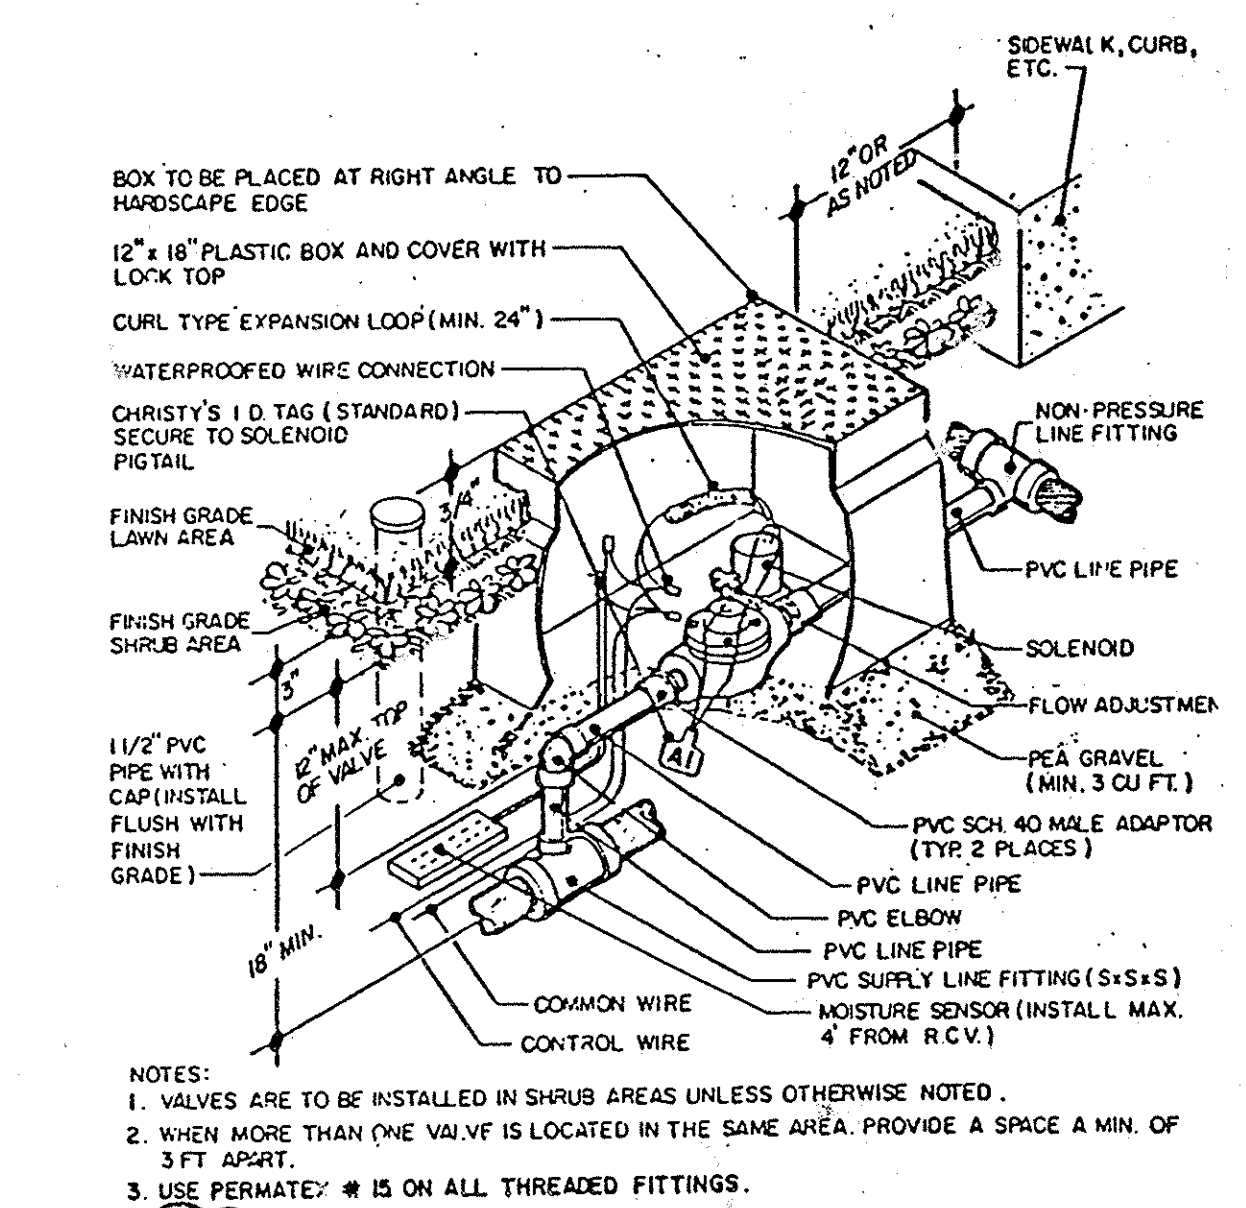

2 TYPICAL ELECTRICAL SERVICE ASSEMBLY
NO SCALE

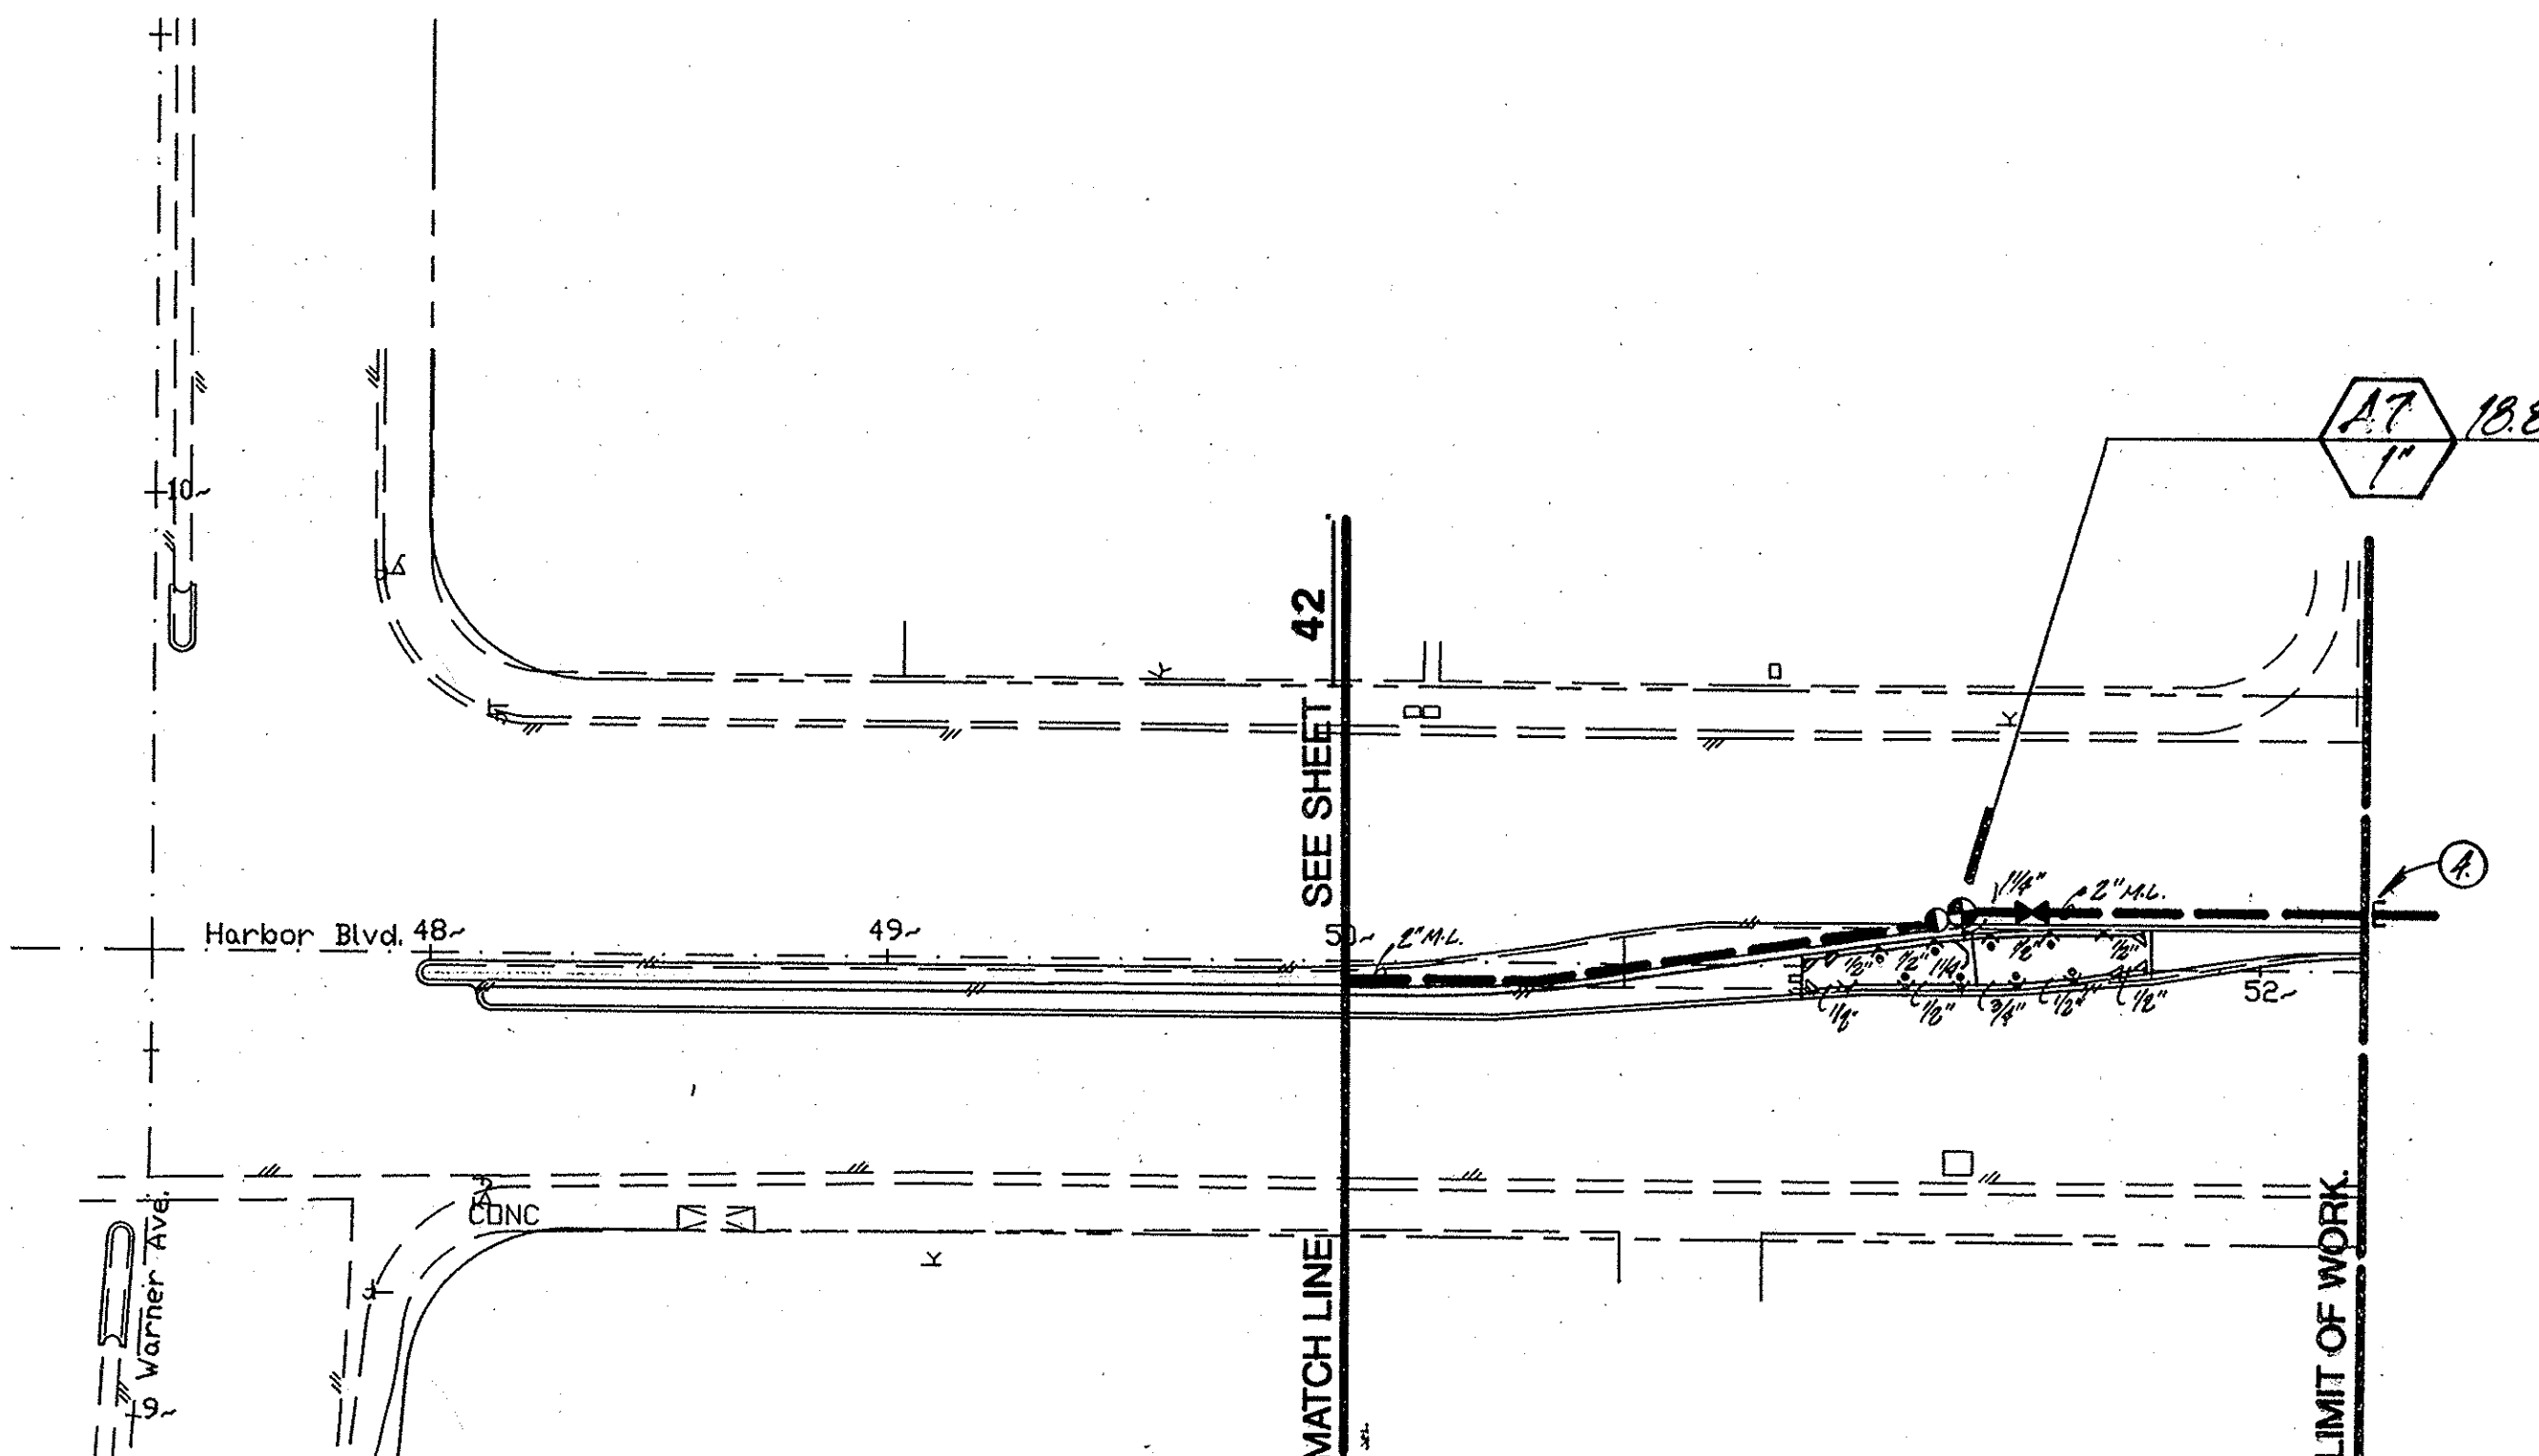

3 TYPICAL REMOTE CONTROL VALVE ASSEMBLY
NO SCALE (STRAIGHT TYPE) (VALVES ON SLOPE ONLY) (R-15)

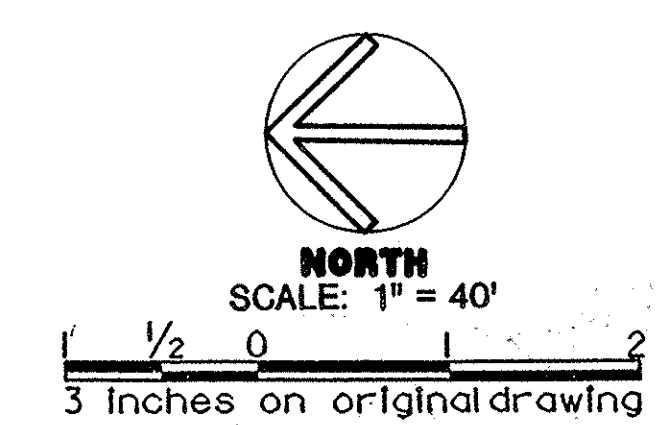

RECORD DRAWING

FILE NO.				REVISIONS				REFERENCES				PROJECT NO. 92035.00			
NUMBER	DATE	INITIALS	DESCRIPTIONS	APPRVD	NUMBER	DATE	INITIALS	DESCRIPTIONS	APPRVD	PREPARED UNDER THE SUPERVISION OF	DATE	HARBOR BLVD. IMPROVEMENTS			
1	10/15/93	GLP	IRRIGATION OF EAST SIDE AND WARNER W/A SEPARATE CONTROLLER, WATER SUPPLY BY CITY OF SANTA ANA	GLP						GARY L. BYE	2/19/93	IRRIGATION PLAN			
										DESIGNED G.B./S.M.M. DRAWN J.C./S.M.M.		PUBLIC WORKS AGENCY			
										R/W APPROVED CHECKED BP	2/22/93	CITY OF SANTA ANA			
										RECOMMENDED BY J. Wong	2/22/93	43 60			
										APPROVED	2/22/93	SHEET OF			
										GARY L. BYE	2/22/93	BASE-1.DWG			
										CITY ENGINEER	R.C.E. NO. 85161				